

APPLICATION

A 31.87

SEWAGE DISPOSAL TESTING

STATE OF MARYLAND - DEPARTMENT OF HEALTH AND MENTAL HYGIENE

HOWARD COUNTY HEALTH DEPARTMENT
ENVIRONMENTAL HEALTH SERVICES
P. O. BOX 476, ELLICOTT CITY, MARYLAND 21043
TELEPHONE 465-5000, EXT. 356

DISTRICT 6

DATE 2-28-75

TO: THE COUNTY HEALTH OFFICER
ELLICOTT CITY, MARYLAND

I, HEREBY, APPLY FOR THE NECESSARY TEST IN ORDER TO CONSTRUCT (OR RECONSTRUCT) A SEWAGE DISPOSAL SYSTEM.

PROPERTY OWNER William J. Dustin Jr.

ADDRESS 525 Seysville, Md. 21784, Klu Mill Park PHONE 795-4330

PROPERTY LOCATION

SUBDIVISION Howard Co LOT NO. 3

ROAD AND DESCRIPTION Old Columbia Road Scoggsville md.

SIZE OF LOT ~~1/2~~ 0.576 ac TYPE BLDG. 3 BR House
NUMBER OF BEDROOMS

IF NOT SINGLE RESIDENCE DESCRIBE _____

THE SYSTEM INSTALLED UNDER THIS APPLICATION IS ACCEPTABLE ONLY UNTIL PUBLIC FACILITIES BECOME AVAILABLE.

SIGNATURE OF APPLICANT William J. Dustin Jr.

APPROVED BY _____ FOR _____ DATE _____


REJECTED BY David J. Hunt FOR Any DATE 2/4/75
(KIND OF SYSTEM)

HOLD PENDING FURTHER TESTS _____ DATE _____

REASONS FOR REJECTION OR HOLDING _____

THIS IS NOT A PERMIT

Old Columbia Rd.

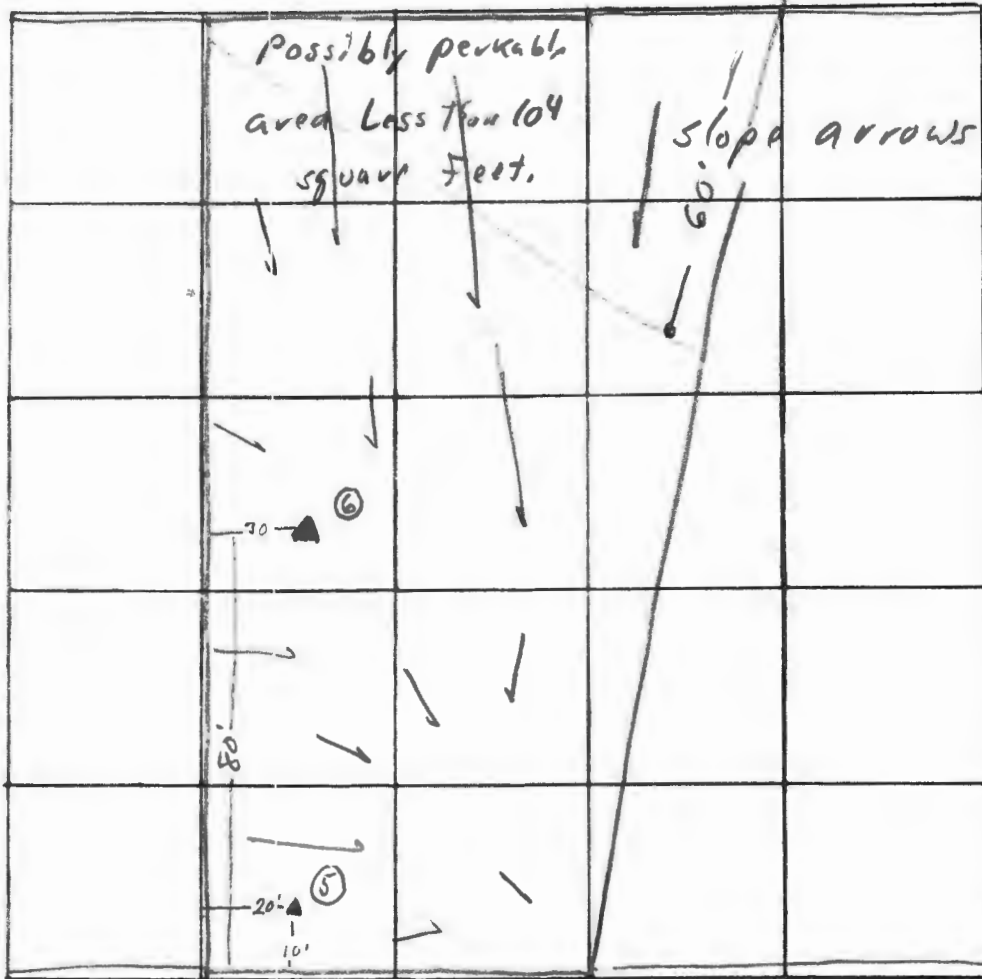

INDICATE NORTH. - NAME ADJOINING ROADWAY AS BASE LINE

At 29

DATE	TEST NO.	DEPTH	PRE-WET		TEST - 1" DROP		TIME
			START	STOP	START	STOP	
	65	2'	—	—	See sheet 107 2.		20
	6d	7 1/2'	water	—	—	—	—
	55	3'	Over time	—	1/2" in	20 min	
	5d.	10'	water	—	—	—	

REMARKS Insufficient area Free of water

TYPE OF SOIL Clay loam - Sandy loam

TESTED BY D. J. O'Neill ALSO PRESENT: Um Dunston
Calvin Miles

Boundary print must be submitted.

APPLICATION

A 31187

Fill out in triplicate.
Make \$20.00 check payable:
Howard County Health Dept. - Sanitation

SEWAGE DISPOSAL TESTING

D _____

Preliminary

STATE OF MARYLAND - DEPARTMENT OF HEALTH AND MENTAL HYGIENE

DISTRICT 6

HOWARD COUNTY HEALTH DEPARTMENT
ENVIRONMENTAL HEALTH SERVICES
P. O. BOX 478, ELLICOTT CITY, MARYLAND 21043
TELEPHONE 465-5000, EXT. 356

DATE 2-28-75

TO: THE COUNTY HEALTH OFFICER
ELLICOTT CITY, MARYLAND

I, HEREBY, APPLY FOR THE NECESSARY TEST IN ORDER TO CONSTRUCT (OR RECONSTRUCT) A SEWAGE DISPOSAL SYSTEM.

✓ PROPERTY OWNER William J. Dustin Jr.

✓ ADDRESS 575 Sykesville rd 21784 PHONE 795-4330

PROPERTY LOCATION:

✓ SUBDIVISION Howard Co LOT NO. 3

ROAD AND DESCRIPTION Old Columbia Road, Scoggsville, md.

✓ SIZE OF LOT 0.576 a.c. TYPE BLDG. 3-BR House
NUMBER OF BEDROOMS _____

IF NOT SINGLE RESIDENCE DESCRIBE _____

THE SYSTEM INSTALLED UNDER THIS APPLICATION IS ACCEPTABLE ONLY UNTIL PUBLIC FACILITIES BECOME AVAILABLE.

✓ SIGNATURE OF APPLICANT William J. Dustin Jr.

APPROVED BY _____ FOR _____ DATE _____
(KIND OF SYSTEM)

REJECTED BY _____ FOR _____ DATE _____
(KIND OF SYSTEM)

HOLD PENDING FURTHER TESTS _____ DATE _____

REASONS FOR REJECTION OR HOLDING _____

THIS IS NOT A PERMIT

