

*Recorded
No plat needed*

APPLICATION

A 26784

SEWAGE DISPOSAL TESTING

P _____

STATE OF MARYLAND - DEPARTMENT OF HEALTH AND MENTAL HYGIENE

*9/9/77
9:30 A.M.*

HOWARD COUNTY HEALTH DEPARTMENT 3BR
ENVIRONMENTAL HEALTH SERVICES

DISTRICT 3rd How. Co.

P. O. BOX 476, ELLICOTT CITY, MARYLAND 21043 S.T. 1000 gal
TELEPHONE: 465-5000, EXT. 356

DATE 8/22/77

The inor will enter the D.W. @ 4' below o.g., with a max depth of the D.W. not to exceed 11' below o.g. The system will have 225¢ of absorbant sidewall per bedroom for a total of 675¢. Begin the trench 5' from the edge of the D.W. and follow the contour of the land. The trench will be 2' wide, 11' deep, and contain 7' of #2 stone. Locate the D.W. — ft from the right side line as seen from the road, and — ft from the road.

TO: THE COUNTY HEALTH OFFICER
ELLICOTT CITY, MARYLAND

**2 inspections on trench*

*9 Sept 77
Rm.*

I, HEREBY, APPLY FOR THE NECESSARY TEST IN ORDER TO CONSTRUCT (OR RECONSTRUCT) A SEWAGE DISPOSAL SYSTEM.

PROPERTY OWNER Russell Lee & Hester S. Williams

ADDRESS ✓ 3212 Burleith Ave Balto, Md 21215 PHONE ✓ 523-0076

PROPERTY LOCATION: Rt 99 + Old Fredrick Road, Harriottsville Post Office

SUBDIVISION ✓ LOT NO. ✓

ROAD AND DESCRIPTION Rt 99 (Old Fredrick Rd.) Harriottsville Post Office
Behind existing house. - John Pretlyman
on right hand side going west

SIZE OF LOT ✓ 2 Acres + TYPE BLDG. 3
3 of Bedrooms Existing House

IF NOT SINGLE RESIDENCE DESCRIBE _____

THE SYSTEM INSTALLED UNDER THIS APPLICATION IS ACCEPTABLE ONLY UNTIL PUBLIC FACILITIES BECOME AVAILABLE.

SIGNATURE OF APPLICANT Russell L. Williams

APPROVED BY Moorefield FOR DW Trench DATE _____
(KIND OF SYSTEM)


REJECTED BY _____ FOR _____ DATE _____
(KIND OF SYSTEM)

HOLD PENDING FURTHER TESTS _____ DATE _____

REASONS FOR REJECTION OR HOLDING Hold pending certified test Locations
Rm.

THIS IS NOT A PERMIT

N
4

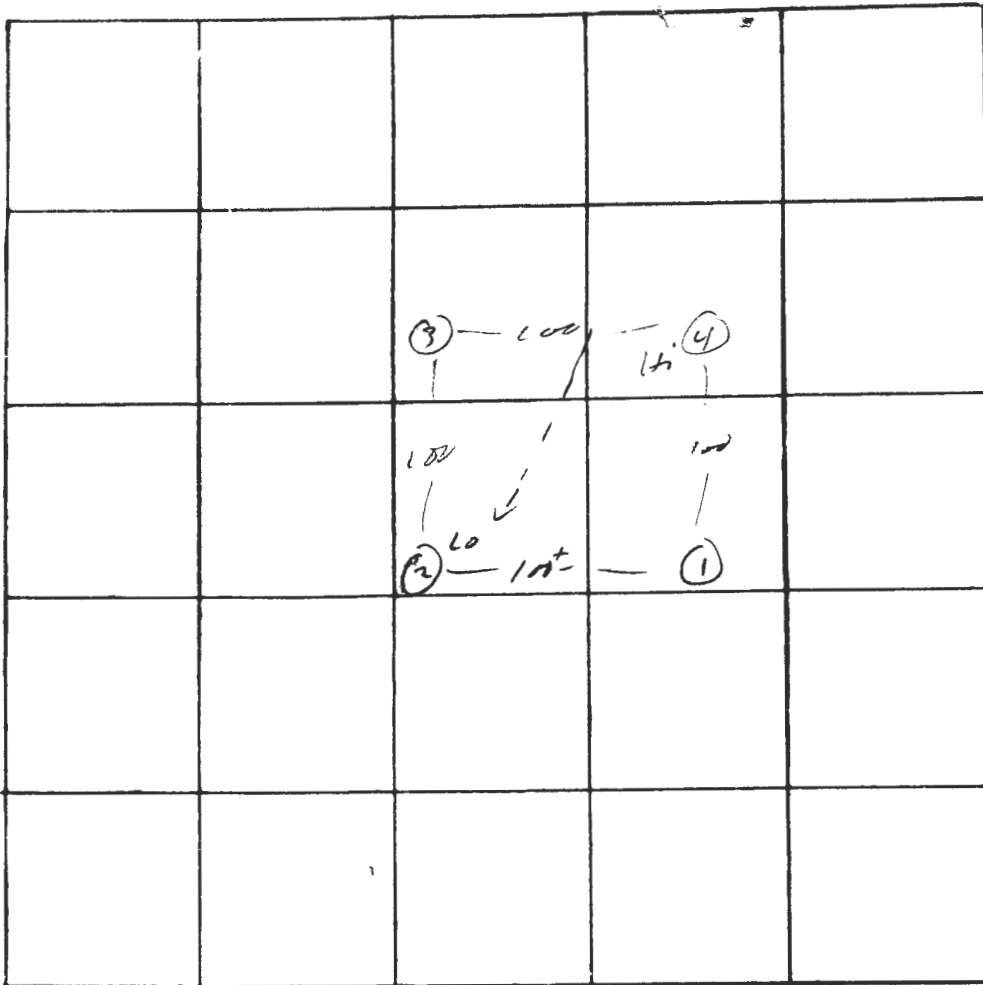

①
0 clay-loam
6
sandy
14
②
sim. to #1,
less clay
3, 4
0 sandy clay
4
14 sandy loam

INDICATE NORTH - NAME ADJOINING ROADWAY AS BASE LINE

← Rt 99 →

DATE	TEST NO.	DEPTH	PRE-WET		TEST - 1" DROP		TIME
			START	STOP	START	STOP	
9 May 77	1	14 1/2	10 ²⁷	10 ²⁹	10 ²⁹	10 ³²	3
		5	"	11 ⁰⁵	11 ⁰⁵		>30
	2	4	10 ³³	10 ⁴¹	10 ⁴¹	11 ⁰¹	20
		14	"	10 ³⁵	10 ³⁵	10 ⁴⁰	5
	3	13	v/s	dry	sandy	loam	
	4	4	10 ²⁰	10 ²⁸	10 ²⁹	11 ⁵⁵	26
		14 1/2	"	10 ²²	10 ²²	10 ²⁵	3
	10	6	11 ⁴⁰	11 ⁵⁷	11 ⁵⁷	12 ²⁵	28



REMARKS ① (raining off & on) ② surveyors arrived late
TYPE OF SOIL ③ certify test hole locations

TESTED BY M ALSO PRESENT: Brittingham

Russell L. Williams

512/424

SCALE 1" = 100'

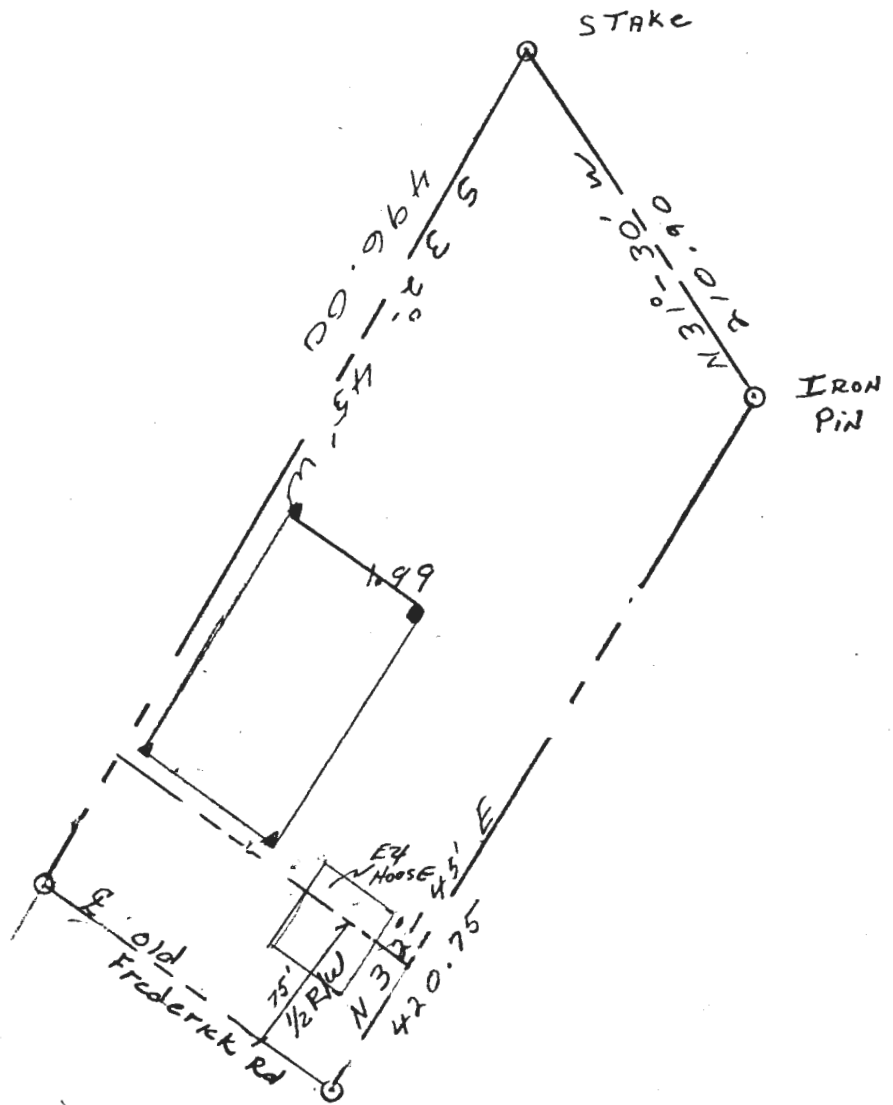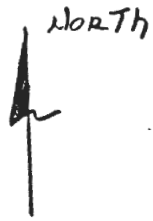

PERK TEST
RUSSELL L. WILLIAMS