

2-12' holes 50 ft. apart per F.F.

*Retest*

*See plat attached to Wilson perc test a 08944 (failed) 9/1/64*

# APPLICATION

A 20640

P \_\_\_\_\_

## SEWAGE DISPOSAL TESTING

STATE OF MARYLAND - DEPARTMENT OF HEALTH AND MENTAL HYGIENE

9/25/74  
9:30 A.M.

HOWARD COUNTY HEALTH DEPARTMENT  
ENVIRONMENTAL HEALTH SERVICES  
P. O. BOX 476, ELLICOTT CITY, MARYLAND 21043  
TELEPHONE: 465-5000, EXT. 356

DISTRICT 5th

DATE 9/9/74

TO: THE COUNTY HEALTH OFFICER  
ELLICOTT CITY, MARYLAND

I, HEREBY, APPLY FOR THE NECESSARY TEST IN ORDER TO CONSTRUCT (OR RECONSTRUCT) A SEWAGE DISPOSAL SYSTEM.

PROPERTY OWNER Woodard Jones property (Contract Purchaser - Harry & Pat Van Der Vossen)

ADDRESS 4616 Olympia Avenue, Beltsville, Md. PHONE 937-7692

PROPERTY LOCATION:

SUBDIVISION \_\_\_\_\_ LOT NO. \_\_\_\_\_

ROAD AND DESCRIPTION Nichols Drive - off Brighton Dam Road - 1/4 mile back from

intersection of above mentioned road on ~~the~~ left hand side of road. Lot is on right side of Nichols Drive.

SIZE OF LOT 1.513 acres ± TYPE BLDG. 3 or 4 bedrooms  
NUMBER OF BEDROOMS

IF NOT SINGLE RESIDENCE DESCRIBE \_\_\_\_\_

THE SYSTEM INSTALLED UNDER THIS APPLICATION IS ACCEPTABLE ONLY UNTIL PUBLIC FACILITIES BECOME AVAILABLE.

SIGNATURE OF APPLICANT /s/ Pat Van Der Vossen

APPROVED BY \_\_\_\_\_ FOR \_\_\_\_\_ DATE \_\_\_\_\_  
(KIND OF SYSTEM)


REJECTED BY *Dr. Harney* FOR *any* DATE 9-16-74  
(KIND OF SYSTEM)

HOLD PENDING FURTHER TESTS \_\_\_\_\_ DATE \_\_\_\_\_

REASONS FOR REJECTION OR HOLDING 9/30/74 - inadequate perc -  
*perc soil down*

# THIS IS NOT A PERMIT

Old  
Empty  
Manhole  
235'

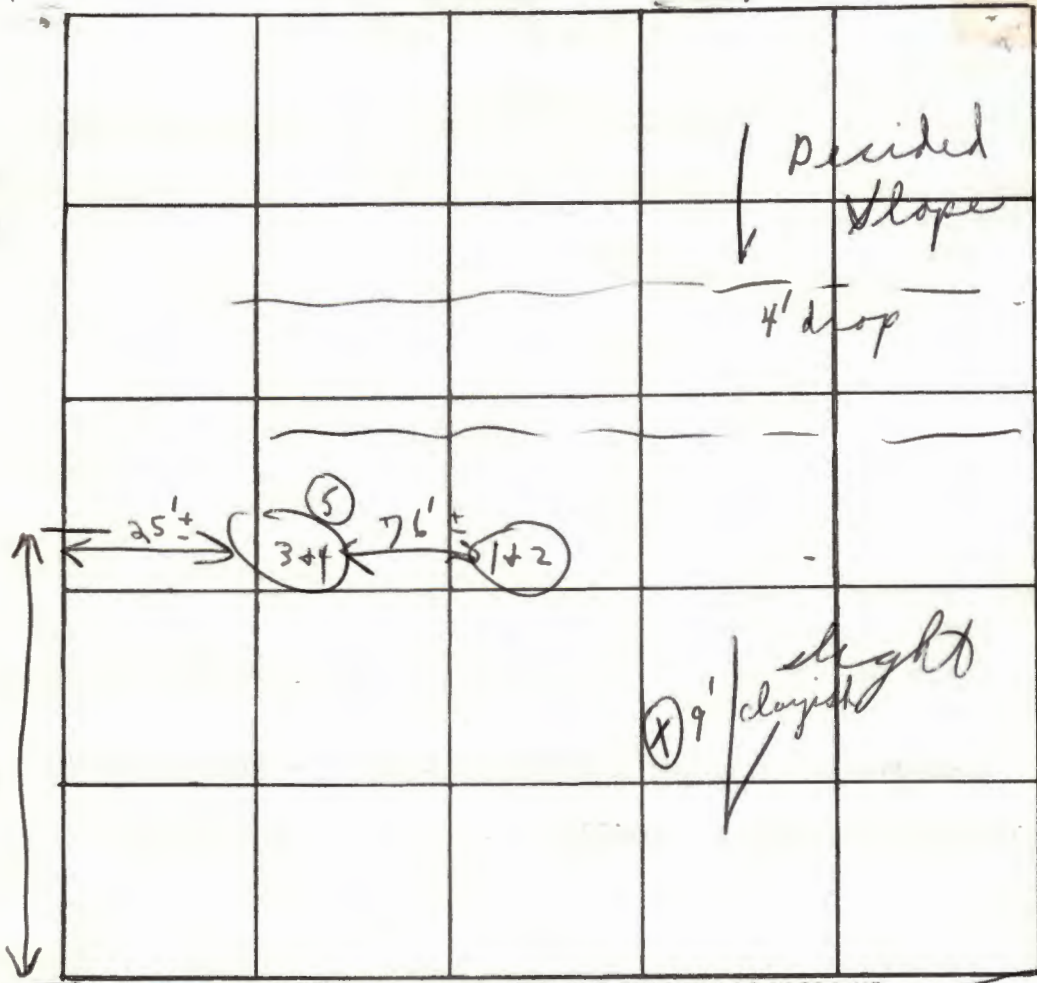

INDICATE NORTH. NAME ADJOINING ROADWAY AS BASE LINE

Nichols Dr.

DATE	TEST NO.	DEPTH	PRE-WET		TEST - 1" DROP		TIME
			START	STOP	START	STOP	
9/25/74	1	6' s	9:58	← →	No perc		
Water at 11' clayish about 3'	2	12' d	9:58	10:02	10:02	10:10	8 min
	3	5' s	10:13	10:18	10:18	10:28	10 min
	4	11' d	{ Water at 11' }		{ No perc }		
	5	1 1/2'	10:11	{ No perc }		clayish	
			=				

REMARKS Did not pass perc test hold for supervisor!!  
 TYPE OF SOIL Clayish + mucous  
 TESTED BY E. B. 9/25/74 ALSO PRESENT: Ray + assistant from Fyock Company Des Vossen  
Bill Van