



Howard County Health Department

To: File -

This property not built -

Parcel 217

Lot 9

Section C

Heritage Heights

From: ALM

Date: 12/16/97

HD-170

# APPLICATION

NOT BUILT

A 005  
P \_\_\_\_\_

SEWAGE DISPOSAL TESTING

MARYLAND STATE DEPARTMENT OF HEALTH

HOWARD COUNTY

ELLICOTT CITY

DISTRICT 5

DATE 2-24-59

TO: THE COUNTY HEALTH OFFICER  
ELLICOTT CITY, MARYLAND

I, HEREBY, APPLY FOR THE NECESSARY TESTS IN ORDER TO CONSTRUCT (OR RECONSTRUCT) A SEWAGE DISPOSAL SYSTEM.

PROPERTY OWNER W. M. Robbins  
ADDRESS 101 Thompson Dr. Clarksville PHONE Atlas 6-2433

PROPERTY LOCATION:  
SUBDIVISION Heritage Heights LOT NO. Pcl 217 9C  
ROAD AND DESCRIPTION Thompson Dr.

OCCUPANT \_\_\_\_\_ PHONE \_\_\_\_\_

PERSON TO CONSTRUCT SYSTEM \_\_\_\_\_  
ADDRESS \_\_\_\_\_ PHONE \_\_\_\_\_

SIZE OF LOT 100 X 200 TYPE BLDG. 3  
NUMBER OF BEDROOMS \_\_\_\_\_

IF NOT SINGLE RESIDENCE DESCRIBE \_\_\_\_\_

SIGNATURE OF APPLICANT W.M. Robbins

APPROVED BY \_\_\_\_\_ FOR \_\_\_\_\_ DATE \_\_\_\_\_  
(KIND OF SYSTEM)


REJECTED BY \_\_\_\_\_ FOR \_\_\_\_\_ DATE \_\_\_\_\_  
(KIND OF SYSTEM)

HOLD PENDING FURTHER TESTS by owner only DATE 6/24/59

REASONS FOR REJECTION OR HOLDING owner to test for leaching bed in area 20' x 30'

A 00506

# THIS IS NOT A PERMIT

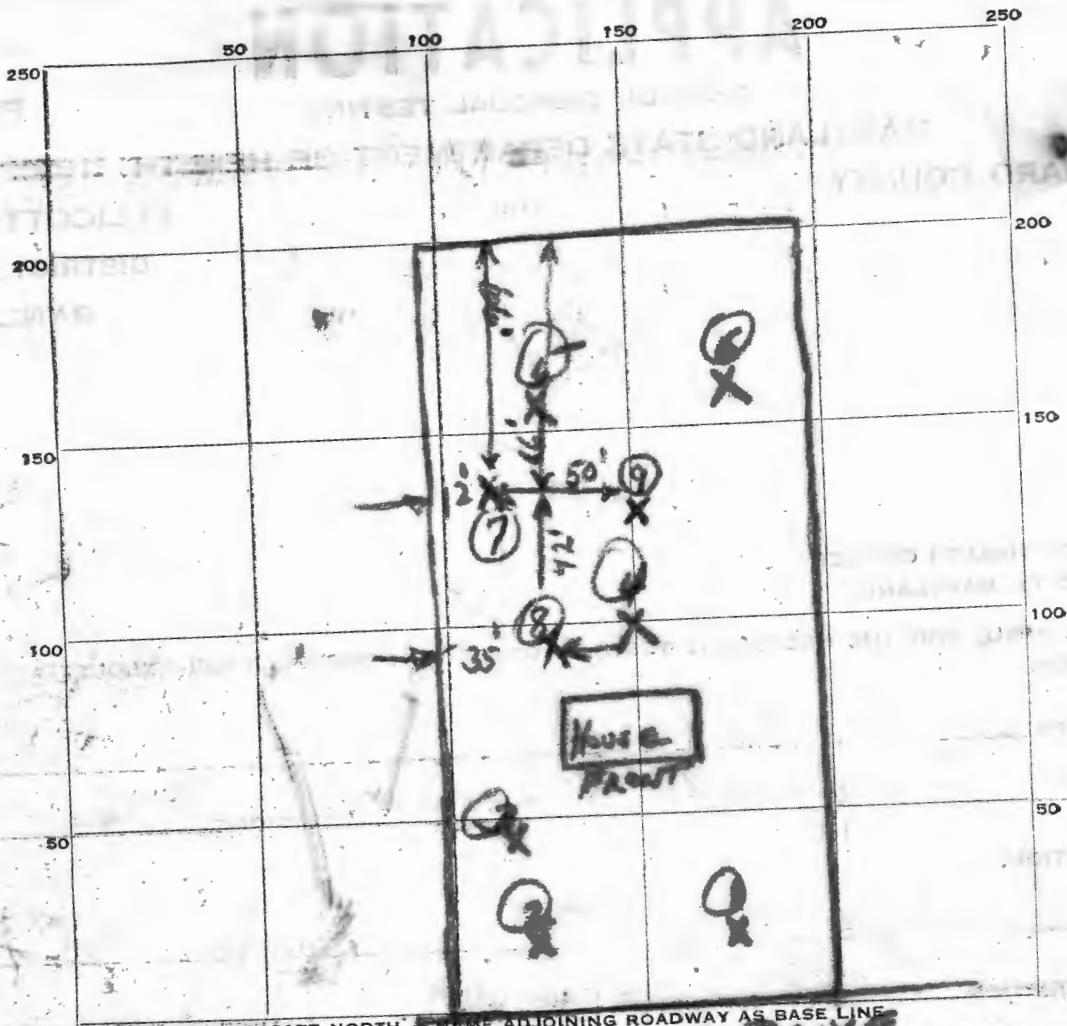

DATE	TEST NO.	DEPTH	PRE-WET		TEST - 1" DROP		TIME
			START	STOP	START	STOP	
3-26-59	1	3ft	9:39	10:24	10:24	Release.	
	2		9:41	10:25	10:25	" "	
	3		9:42	10:12	10:12	10:42	30 minutes
-5-59	5						
6-24-59	6		2:23	2:57	2:57	minutes	Pre-Wet
	8		2:36	2:45	2:45	minutes	Pre-Wet
	9	3FT	2:44	2:59	2:59	minutes	Pre-Wet

SOIL AUGER FINDING \_\_\_\_\_

TESTED BY J. Henningan

REMARKS Clay + Loam thru out

PERSON PRESENT Builder A.M. Pollock

*fail*

*fail*

December 5, 1974

TO WHOM IT MAY CONCERN:

This is to certify that a standard percolation test failed  
in Heritage Heights, Lot 9, Blk. C, Thompson Drive, Clarksville,  
Maryland on June 24, 1959.

Very truly yours,

Palmer F. Wine, Director  
Environmental Health

PFW:jr

CC: Mr. Eugene Liverette  
6112 Thompson Drive  
Clarksville, Maryland

286-2389

# APPLICATION

A 00506

SEWAGE DISPOSAL TESTING

P \_\_\_\_\_

MARYLAND STATE DEPARTMENT OF HEALTH

HOWARD COUNTY

ELLICOTT CITY

DISTRICT 5

DATE 2-24-59

*6/24/59  
1:00*

*Hold for further tests J. Hennigan 2-24-59*

TO: THE COUNTY HEALTH OFFICER  
ELLICOTT CITY, MARYLAND

I, HEREBY, APPLY FOR THE NECESSARY TESTS IN ORDER TO CONSTRUCT (OR RECONSTRUCT) A SEWAGE DISPOSAL SYSTEM.

PROPERTY OWNER W. M. Robbins

ADDRESS 101 Thompson Dr. Clarksville PHONE Atlas 6-2433

PROPERTY LOCATION:

SUBDIVISION Heritage Heights LOT NO. 9C

ROAD AND DESCRIPTION Thompson Dr.

OCCUPANT \_\_\_\_\_ PHONE \_\_\_\_\_

PERSON TO CONSTRUCT SYSTEM \_\_\_\_\_ PHONE \_\_\_\_\_

ADDRESS \_\_\_\_\_ PHONE \_\_\_\_\_

SIZE OF LOT 100 X 200 TYPE BLDG. 2 NUMBER OF BEDROOMS 3

IF NOT SINGLE RESIDENCE DESCRIBE \_\_\_\_\_

SIGNATURE OF APPLICANT W. M. Robbins, Atlas 6-2433

APPROVED BY \_\_\_\_\_ FOR \_\_\_\_\_ DATE \_\_\_\_\_  
(KIND OF SYSTEM)


REJECTED BY \_\_\_\_\_ FOR \_\_\_\_\_ DATE \_\_\_\_\_  
(KIND OF SYSTEM)

HOLD PENDING FURTHER TESTS by owner only DATE 6/24/59

REASONS FOR REJECTION OR HOLDING No Protection manifesting. Owner to test for leaching bed in area 20' x 30'.

# THIS IS NOT A PERMIT

A 00506

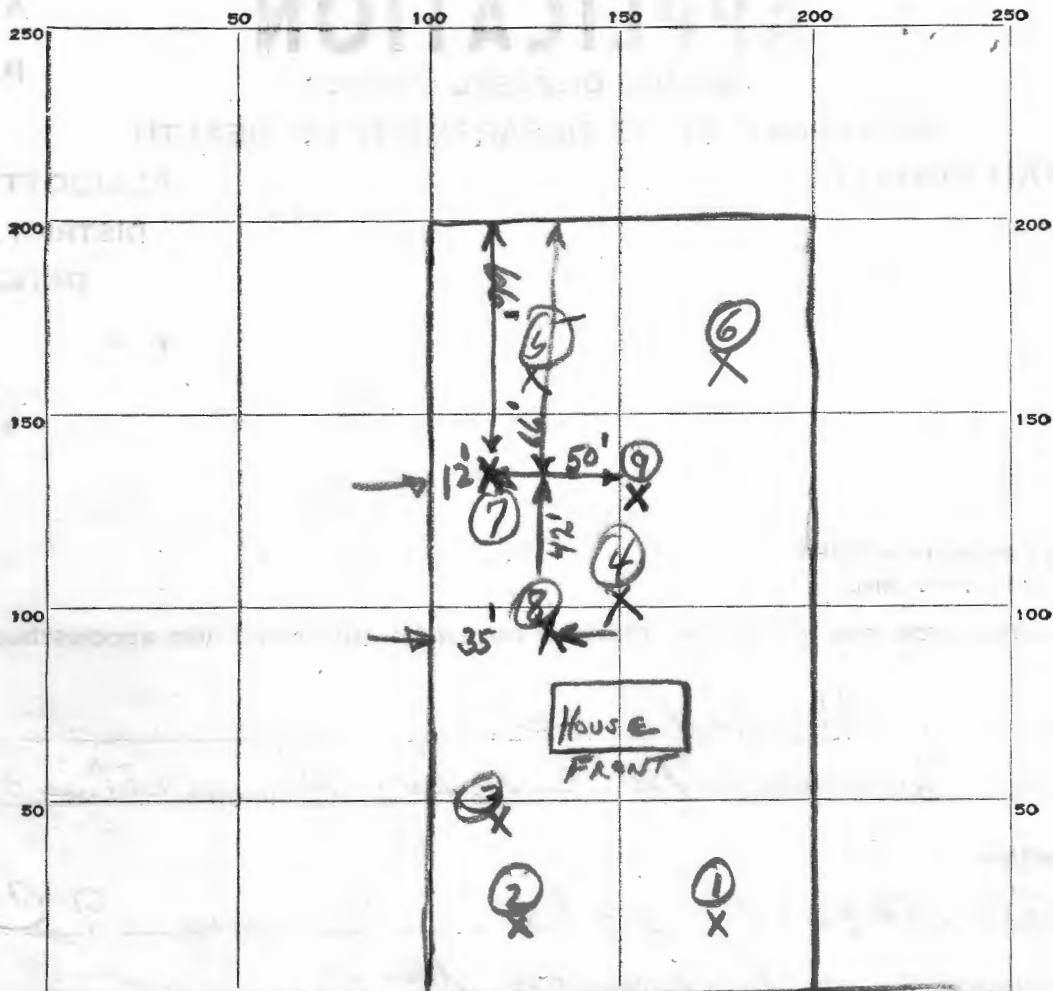

INDICATE NORTH. - NAME ADJOINING ROADWAY AS BASE LINE.

T. Thompson DRIVE

DATE	TEST NO.	DEPTH	PRE-WET		TEST - 1" DROP		TIME
			START	STOP	START	STOP	
2-26-59	1	3ft	9:39	10:24	10:24	None	
	2		9:41	10:25	10:25	" "	
	3		9:42	10:12	10:12	10:42	30 minutes
3-5-59	4		9:39	11:03	1 inch Pre-Wet		
	5		9:43	11:48	1 inch Pre-Wet		
	6		Ground water in test hole				
6-24-59	7		2:23	1/2"	57 minutes Pre-Wet		
	8		2:36	1/8"	45 minutes Pre-Wet		
	9		3FT	2:44	1/2"	35 minutes Pre-Wet	

SOIL AUGER FINDING

TESTED BY

*J. Henningan*

REMARKS

*Clay + 10mm thru-out*

ALSO PRESENT

*Builder A.M. Pollock*

LOT NO.