

APPLICATION

A 193721

Preliminary

SEWAGE DISPOSAL TESTING

P _____

STATE OF MARYLAND - DEPARTMENT OF HEALTH AND MENTAL HYGIENE

HOWARD COUNTY HEALTH DEPARTMENT
ENVIRONMENTAL HEALTH SERVICES
P. O. BOX 476, ELLICOTT CITY, MARYLAND 21043
TELEPHONE: 465-5000, EXT. 356

DISTRICT 5th
DATE Oct. 30, 1973

TO: THE COUNTY HEALTH OFFICER
ELLICOTT CITY, MARYLAND

I, HEREBY, APPLY FOR THE NECESSARY TEST IN ORDER TO CONSTRUCT (OR RECONSTRUCT) A SEWAGE DISPOSAL SYSTEM.

PROPERTY OWNER Lacy A. Canterbury Est. Robert H. Simpson
ADDRESS 7538 Greenwood Dr. Highland Md 20772 PHONE 774-7590

PROPERTY LOCATION:

Proposed SUBDIVISION CANTERBURY-SIMPSON Parcel 66 LOT NO. 6

ROAD AND DESCRIPTION Proposed St. off Pindell School Road as per Vicinity Map on Preliminary Sketch Plan by Richard P. Bewwe Assoc.

SIZE OF LOT 44,500 SF TYPE BLDG. Four
NUMBER OF BEDROOMS _____

IF NOT SINGLE RESIDENCE DESCRIBE _____

THE SYSTEM INSTALLED UNDER THIS APPLICATION IS ACCEPTABLE ONLY UNTIL PUBLIC FACILITIES BECOME AVAILABLE.

SIGNATURE OF APPLICANT _____

APPROVED BY _____ FOR _____ DATE _____
(KIND OF SYSTEM)

REJECTED BY _____ FOR _____ DATE _____
(KIND OF SYSTEM)

HOLD PENDING FURTHER TESTS _____ DATE _____

REASONS FOR REJECTION OR HOLDING _____

THIS IS NOT A PERMIT

0.150, 0.25

Indicate North. - Name adjoining roadway as base line.

INDICATE NORTH. - NAME ADJOINING ROADWAY AS BASE LINE.

DATE	TEST NO.	DEPTH	PRE-WET		TEST - 1" DROP		TIME
			START	STOP	START	STOP	

REMARKS _____

TYPE OF SOIL _____

~~4/26/74~~
~~9/30~~

Any questions ask
The Moorefield - especially
lot 8

11/7/74

Lot 9 - Not to be tested until wet
season ; OK for drainfield test then
RM/DWM

Lot 8 - Need 2 more holes (#5 & #6)

Lot 7 - Must show where house & well are
to go before lot can be
approved ; lot may need to be
opened up during wet season

RM/DWM
RM/DWM

4/26/76
Lot 7 needed
4 more holes
R.M.

5/3/76
1:30 - Moorefield
appt.

Mon., 4/26/76 1:30 P.M.

Appointment in office

with DWM & RM

APPLICATION

A 19373

SEWAGE DISPOSAL TESTING

P _____

STATE OF MARYLAND - DEPARTMENT OF HEALTH AND MENTAL HYGIENE

HOWARD COUNTY HEALTH DEPARTMENT
ENVIRONMENTAL HEALTH SERVICES
P. O. BOX 476, ELLICOTT CITY, MARYLAND 21043
TELEPHONE: 465-3000, EXT. 386

DISTRICT 5th

DATE Oct. 30, 1973

Preliminary

*5/21/76 - Mr. Covatta will
1:30 to Law / approval
of Lohm*

TO: THE COUNTY HEALTH OFFICER
ELLICOTT CITY, MARYLAND

I, HEREBY, APPLY FOR THE NECESSARY TEST IN ORDER TO CONSTRUCT (OR RECONSTRUCT) A SEWAGE DISPOSAL SYSTEM.

PROPERTY OWNER LACY A. CANTERBURY EST. & ROBERT H. SIMPSON

ADDRESS 7538 GREENWOOD DR. HIGHLAND MD. 20777 PHONE 774-7590

PROPERTY LOCATION:

Proposed SUBDIVISION CANTERBURY-SIMPSON PARCEL 66 LOT NO. 7

ROAD AND DESCRIPTION Proposed St. OFF PINDALL SCHOOL ROAD AS PER VICINITY
MAP ON PRELIMINARY SKETCH PLAN BY RICHARD P. BROWNE ASSOC.

SIZE OF LOT 41,000 sq ft TYPE BLDG. FOUR
NUMBER OF BEDROOMS _____

IF NOT SINGLE RESIDENCE DESCRIBE _____

THE SYSTEM INSTALLED UNDER THIS APPLICATION IS ACCEPTABLE ONLY UNTIL PUBLIC FACILITIES BECOME AVAILABLE.

SIGNATURE OF APPLICANT _____

APPROVED BY _____ FOR _____ DATE _____
(KIND OF SYSTEM)

REJECTED BY _____ FOR _____ DATE _____
(KIND OF SYSTEM)

HOLD PENDING FURTHER TESTS _____ DATE _____

REASONS FOR REJECTION OR HOLDING _____

THIS IS NOT A PERMIT

APPLICATION

A 19373

SEWAGE DISPOSAL TESTING

P _____

STATE OF MARYLAND - DEPARTMENT OF HEALTH AND MENTAL HYGIENE

HOWARD COUNTY HEALTH DEPARTMENT
ENVIRONMENTAL HEALTH SERVICES
P. O. BOX 476, ELLICOTT CITY, MARYLAND 21043
TELEPHONE: 465-8000, EXT. 356

DISTRICT 5th

DATE Oct. 30, 1973

TO: THE COUNTY HEALTH OFFICER
ELLICOTT CITY, MARYLAND

I, HEREBY, APPLY FOR THE NECESSARY TEST IN ORDER TO CONSTRUCT (OR RECONSTRUCT) A SEWAGE DISPOSAL SYSTEM.

PROPERTY OWNER LACY A. CANTERBURY EST. & ROBERT H. SIMPSON ⁴⁷⁴⁻⁸⁹³³

ADDRESS 7538 GREENWOOD DR. HIGHLAND MD. 20777 PHONE 774-7590

PROPERTY LOCATION:

^{Proposed} SUBDIVISION CANTERBURY - SIMPSON PARCEL 66 LOT NO. 7

ROAD AND DESCRIPTION Proposed st. off PINDELL SCHOOL ROAD AS PER VICINITY MAP ON PRELIMINARY SKETCH PLAN BY RICHARD P. BROWNE ASSOC.

SIZE OF LOT 41,000 ± TYPE BLDG. FOUR
NUMBER OF BEDROOMS _____

IF NOT SINGLE RESIDENCE DESCRIBE _____

THE SYSTEM INSTALLED UNDER THIS APPLICATION IS ACCEPTABLE ONLY UNTIL PUBLIC FACILITIES BECOME AVAILABLE.

SIGNATURE OF APPLICANT _____

APPROVED BY _____ FOR _____ DATE _____
(KIND OF SYSTEM)

REJECTED BY _____ FOR _____ DATE _____
(KIND OF SYSTEM)

HOLD PENDING FURTHER TESTS _____ DATE _____

REASONS FOR REJECTION OR HOLDING _____

THIS IS NOT A PERMIT

APPLICATION

A 19374

P _____

SEWAGE DISPOSAL TESTING

STATE OF MARYLAND - DEPARTMENT OF HEALTH AND MENTAL HYGIENE

HOWARD COUNTY HEALTH DEPARTMENT
ENVIRONMENTAL HEALTH SERVICES
P. O. BOX 476, ELLICOTT CITY, MARYLAND 21043
TELEPHONE: 465-5000, EXT. 356

DISTRICT 5th
DATE Oct. 30, 1973

Preliminary

TO: THE COUNTY HEALTH OFFICER
ELLICOTT CITY, MARYLAND

I, HEREBY, APPLY FOR THE NECESSARY TEST IN ORDER TO CONSTRUCT (OR RECONSTRUCT) A SEWAGE DISPOSAL SYSTEM.

PROPERTY OWNER LACY A. CAUTERBURY EST. & ROBERT H. SIMPSON
ADDRESS 7538 GREENWOOD DR. HIGHLAND MD, 20777 PHONE 774-7590

PROPERTY LOCATION:

Proposed SUBDIVISION CAUTERBURY-SIMPSON PARCELS 66 LOT NO. 8

ROAD AND DESCRIPTION PROPOSED ST. OFF PINDELL SCHOOL ROAD AS PER VICINITY MAP ON PRELIMINARY SKETCH PLAN BY RICHARD P. BROWNE ASSOC.

SIZE OF LOT 43,500 FT ± TYPE BLDG. FOUR
NUMBER OF BEDROOMS _____

IF NOT SINGLE RESIDENCE DESCRIBE _____

THE SYSTEM INSTALLED UNDER THIS APPLICATION IS ACCEPTABLE ONLY UNTIL PUBLIC FACILITIES BECOME AVAILABLE.

SIGNATURE OF APPLICANT _____

APPROVED BY _____ FOR _____ DATE _____
(KIND OF SYSTEM)

REJECTED BY _____ FOR _____ DATE _____
(KIND OF SYSTEM)

HOLD PENDING FURTHER TESTS _____ DATE _____

REASONS FOR REJECTION OR HOLDING _____

THIS IS NOT A PERMIT

INDICATE NORTH. - NAME ADJOINING ROADWAY AS BASE LINE

DATE	TEST NO.	DEPTH	PRE-WET		TEST - 1" DROP		TIME
			START	STOP	START	STOP	
11/7	6	5	2 ¹⁶	2 ¹⁸	2 ¹⁸	2 ²⁰	2
	6A	12	2 ¹⁶	2 ¹⁸	2 ¹⁸	2 ²²	4
	7	12	Vis	—	same	dry	—
4/20/76	8	11	water @ 8 1/2'				
	A	3	2:01	2:11	2:11	2:31	20
	B	3	2:05	NO	Δ 1/2 hr		>30
	C	3	2:06	NO	Δ 1/2 hr		>30
	D	3	2:02	NO	Δ 1/2 hr		>30
	E	3	2:13	NO	Δ 1/2 hr		>30
	2B	3	2:47	3:03	NO Δ		>30

REMARKS _____

TYPE OF SOIL _____

INDICATE NORTH. - NAME ADJOINING ROADWAY AS BASE LINE

DATE	TEST NO.	DEPTH	PRE-WET		TEST - 1" DROP		TIME
			START	STOP	START	STOP	
11/13/74	3C	6 1/2	2 ⁵⁵	3 ⁰⁵	3 ²⁵	3 ³⁰	15
11/14/74	5	11'	1033	1105	N/A		>30
	6B	6	2 ⁰²	2 ³⁰	N/A		>30
	6A	5	1044	1115	N/A		>30
	6A	12	1045	1049	1049	1056	7
	5A	4	1037	1105	N/A		>30
	2A	5	1155	1202	1202	1212	10
	6C	7	2 ³⁴	2 ⁴⁶	2 ⁴⁶	3 ⁰⁴	
	6D	12 1/2	vis		dry		
4/20/76	6E	water	@	12'			

→ deep 1/2 in/sar

REMARKS _____

TYPE OF SOIL _____

Rm 4 DO

APPLICATION

A 1937F

SEWAGE DISPOSAL TESTING

P _____

STATE OF MARYLAND - DEPARTMENT OF HEALTH AND MENTAL HYGIENE

HOWARD COUNTY HEALTH DEPARTMENT
ENVIRONMENTAL HEALTH SERVICES
P. O. BOX 476, ELLICOTT CITY, MARYLAND 21043
TELEPHONE: 465-8000, EXT. 356

DISTRICT 5th
DATE Oct. 30, 1973

TO: THE COUNTY HEALTH OFFICER
ELLICOTT CITY, MARYLAND

I, HEREBY, APPLY FOR THE NECESSARY TEST IN ORDER TO CONSTRUCT (OR RECONSTRUCT) A SEWAGE DISPOSAL SYSTEM.

PROPERTY OWNER Lacy A. Canterbury Est. & Robert H. Simpson
ADDRESS 7538 Greenwood Dr. Highland Md 20777 PHONE 774-7590

PROPERTY LOCATION:

Proposed SUBDIVISION Canterbury-Simpson Parcel 66 LOT NO. 8

ROAD AND DESCRIPTION Proposed St. off Pindell School Road as per Vicinity Map on Preliminary Sketch Plan by Richard P. Browne Assoc.

SIZE OF LOT 43,500 ± TYPE BLDG. Four
NUMBER OF BEDROOMS _____

IF NOT SINGLE RESIDENCE DESCRIBE _____

THE SYSTEM INSTALLED UNDER THIS APPLICATION IS ACCEPTABLE ONLY UNTIL PUBLIC FACILITIES BECOME AVAILABLE.

SIGNATURE OF APPLICANT _____


APPROVED BY _____ FOR _____ DATE _____
(KIND OF SYSTEM)

REJECTED BY _____ FOR _____ DATE _____
(KIND OF SYSTEM)

HOLD PENDING FURTHER TESTS _____ DATE _____

REASONS FOR REJECTION OR HOLDING _____

THIS IS NOT A PERMIT

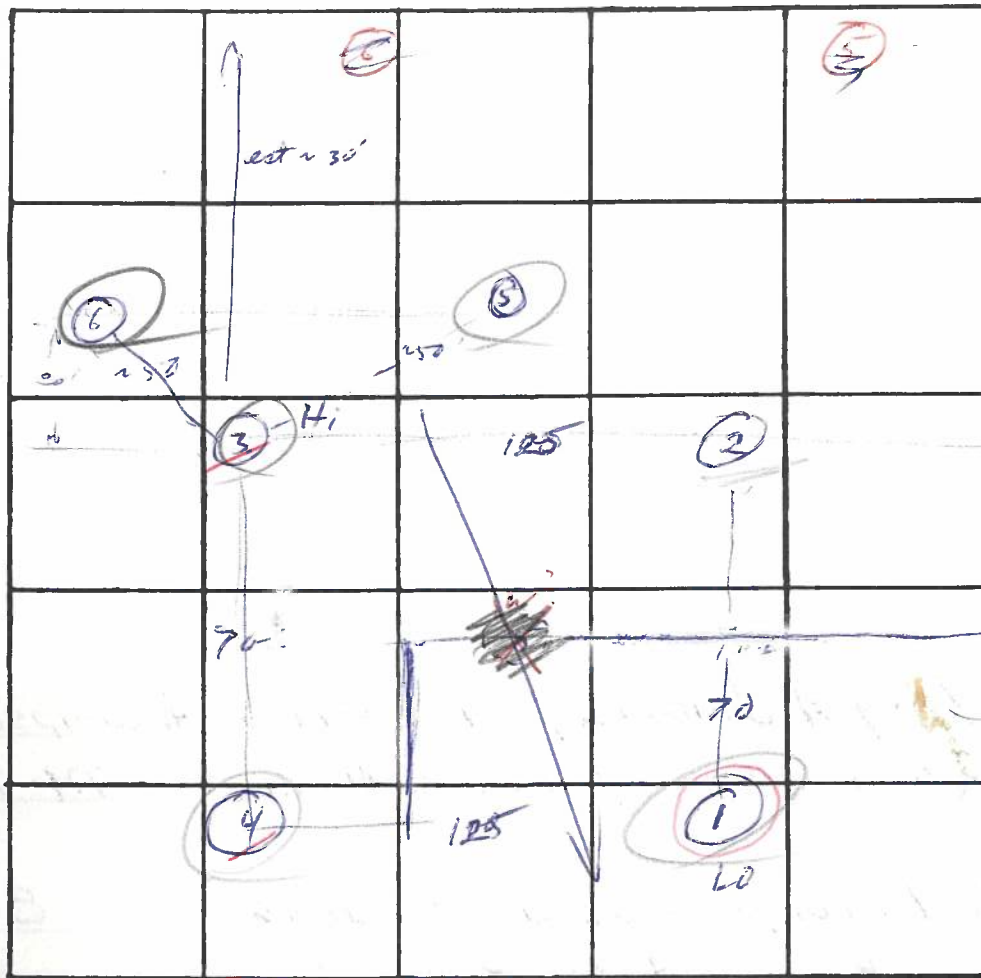

Lot 8

INDICATE NORTH. - NAME ADJOINING ROADWAY AS BASE LINE.

— RW —

DATE	TEST NO.	DEPTH	PRE-WET		TEST - 1" DROP		TIME
			START	STOP	START	STOP	
11/7	①	3	10 ²⁹	10 ⁴³	10 ⁴³	no change	>30
	①A	12	10 ³⁹	1/4" in	32	min	>30
	2	12	Vis	brown	loam		
	③	5	10 ⁴⁰	28 min	for 1" inch		>30
	3A	12 1/2	10 ⁴⁰	10 ⁴⁴	10 ⁴⁴	10 ⁴⁶	②
	4	12	11 ¹⁴	11 ¹²	11 ¹²	11 ¹²	1
	④A	12.5	11 ¹¹	no	Δ		>30
	4B	13	Vis	same		dry	
	4C	6	2 ⁵⁸	3 ⁰⁵	3 ⁰⁵	3 ¹⁸	13
	3B	13	Vis	same		dry	

Moist clay →
Loam & clay
Micaceous }
Loam. }
@ 2 ft }
clay →
loam →

REMARKS Certify all holes retest in wet season; to be gray @ 2-7'

TYPE OF SOIL Clay, some loam R.M.

APPLICATION

A 19375

SEWAGE DISPOSAL TESTING

P _____

STATE OF MARYLAND - DEPARTMENT OF HEALTH AND MENTAL HYGIENE

HOWARD COUNTY HEALTH DEPARTMENT
ENVIRONMENTAL HEALTH SERVICES
P. O. BOX 476, ELLICOTT CITY, MARYLAND 21043
TELEPHONE: 465-5000, EXT. 386

DISTRICT 5th
DATE Oct. 30, 1973

TO: THE COUNTY HEALTH OFFICER
ELLICOTT CITY, MARYLAND

I, HEREBY, APPLY FOR THE NECESSARY TEST IN ORDER TO CONSTRUCT (OR RECONSTRUCT) A SEWAGE DISPOSAL SYSTEM.

PROPERTY OWNER LACY A. CAUTERBURY EST. & ROBERT H. SIMPSON

ADDRESS 7538 GREENWOOD DR HIGHLAND MD 21077 PHONE 774-7590

PROPERTY LOCATION:

Proposed SUBDIVISION CAUTERBURY-SIMPSON PARCELS 66 LOT NO. 9

ROAD AND DESCRIPTION PROPOSED ST. OFF PINDELL SCHOOL ROAD AS PER VICINITY MAP ON PRELIMINARY SKETCH PLAN BY RICHARD P. BROWNE ASSOC.

SIZE OF LOT 40,000 sq ft TYPE BLDG. FOUR
NUMBER OF BEDROOMS _____

IF NOT SINGLE RESIDENCE DESCRIBE _____

THE SYSTEM INSTALLED UNDER THIS APPLICATION IS ACCEPTABLE ONLY UNTIL PUBLIC FACILITIES BECOME AVAILABLE.

SIGNATURE OF APPLICANT _____

APPROVED BY _____ FOR _____ DATE _____
(KIND OF SYSTEM)

REJECTED BY _____ FOR _____ DATE _____
(KIND OF SYSTEM)

HOLD PENDING FURTHER TESTS _____ DATE _____

REASONS FOR REJECTION OR HOLDING _____

THIS IS NOT A PERMIT

APPLICATION

A 19375

SEWAGE DISPOSAL TESTING

P _____

STATE OF MARYLAND - DEPARTMENT OF HEALTH AND MENTAL HYGIENE

HOWARD COUNTY HEALTH DEPARTMENT
ENVIRONMENTAL HEALTH SERVICES
P. O. BOX 476, ELLICOTT CITY, MARYLAND 21043
TELEPHONE: 465-8000, EXT. 356

DISTRICT 5th
DATE Oct. 30, 1973

*11/14/74
9:30*

TO: THE COUNTY HEALTH OFFICER
ELLICOTT CITY, MARYLAND

I, HEREBY, APPLY FOR THE NECESSARY TEST IN ORDER TO CONSTRUCT (OR RECONSTRUCT) A SEWAGE DISPOSAL SYSTEM.

PROPERTY OWNER LACY A. CANTERBURY EST. & ROBERT H. SIMPSON

ADDRESS 7538 GREENWOOD DR. HIGHLAND MD. 20777 PHONE 274-7590

PROPERTY LOCATION:

Proposed SUBDIVISION CANTERBURY-SIMPSON PARCEL 66 LOT NO. 9

ROAD AND DESCRIPTION Proposed St. OFF PINDELL SCHOOL ROAD AS per vicinity MAP ON PRELIMINARY SKETCH PLAN BY RICHARD P. BROWNE ASSOC.

SIZE OF LOT 40,000 sq ft TYPE BLDG. FOUR
NUMBER OF BEDROOMS _____

IF NOT SINGLE RESIDENCE DESCRIBE _____

THE SYSTEM INSTALLED UNDER THIS APPLICATION IS ACCEPTABLE ONLY UNTIL PUBLIC FACILITIES BECOME AVAILABLE.

SIGNATURE OF APPLICANT _____

APPROVED BY _____ FOR _____ DATE _____
(KIND OF SYSTEM)

REJECTED BY _____ FOR _____ DATE _____
(KIND OF SYSTEM)

HOLD PENDING FURTHER TESTS _____ DATE _____

REASONS FOR REJECTION OR HOLDING _____

THIS IS NOT A PERMIT

INDICATE NORTH. - NAME ADJOINING ROADWAY AS BASE LINE

DATE	TEST NO.	DEPTH	PRE-WET		TEST - 1" DROP		TIME
			START	STOP	START	STOP	
11/14	3A	4	11:56	1/4 inch in	25 min	3:30	
	1A	4	11:58	12:15	N/A		3:30
	4A	4	3:15	3:17	3:17	3:21	4 min
	4B	9 1/2	3:15	3:22	3:22	3:30	8 min

REMARKS _____

TYPE OF SOIL _____