

1/3/73  
9:30 AM

Ap. 2-3109  
Sam  
Fiducia  
3207 It. 2<sup>nd</sup> Lane, Falls Md. 21207

# APPLICATION

A 17783  
P

## SEWAGE DISPOSAL TESTING

### MARYLAND STATE DEPARTMENT OF HEALTH

HOWARD COUNTY SPECIFICATIONS FOR BOTH HOMES ELLICOTT CITY

SEPTIC TANK - 3 bedrooms - 1000 gal.  
                  4 "                  - 1250 gal.  
DISTRICT 4th

DATE 12/13/72

DRY WELL - 120 sq. ft. of absorbent sidewall area per bedroom  
to begin below the first 4 1/2 ft of non porous soil.  
Maximum depth permitted for dry wells is 11 1/2 ft.  
Locate one dry well 440 ft. from front property line and  
45 ft. from left side line as seen from Forsythe Rd. Locate the  
other dry well 420 ft. from front property line and 87 ft.  
from right side line as seen from Forsythe Rd.

TO: THE COUNTY HEALTH OFFICER  
ELLICOTT CITY, MARYLAND

I, HEREBY, APPLY FOR THE NECESSARY TESTS IN ORDER TO CONSTRUCT (OR RECONSTRUCT) A SEWAGE DISPOSAL SYSTEM.

PROPERTY OWNER Robert R. Levick Giovanni Greco

ADDRESS Cooksville, Maryland Any questions call Mrs. Radhe,  
PHONE Skirven Realty -465-6767

PROPERTY LOCATION:

SUBDIVISION \_\_\_\_\_ LOT NO. 7

ROAD AND DESCRIPTION Forsythe Road and Old Frederick Road

OCCUPANT \_\_\_\_\_ PHONE \_\_\_\_\_

PERSON TO CONSTRUCT SYSTEM \_\_\_\_\_

ADDRESS \_\_\_\_\_ PHONE \_\_\_\_\_

SIZE OF LOT 5.509 acres TYPE BLDG. 3 or 4 bedrooms  
NUMBER OF BEDROOMS 4

IF NOT SINGLE RESIDENCE DESCRIBE \_\_\_\_\_

SIGNATURE OF APPLICANT Robert Levick per P. Radhe, agent


APPROVED BY Robert V. Tame FOR Dry Well DATE 2/7/73  
(KIND OF SYSTEM)

REJECTED BY \_\_\_\_\_ FOR \_\_\_\_\_ DATE \_\_\_\_\_  
(KIND OF SYSTEM)

HOLD PENDING FURTHER TESTS \_\_\_\_\_ DATE \_\_\_\_\_

REASONS FOR REJECTION OR HOLDING \_\_\_\_\_

# THIS IS NOT A PERMIT

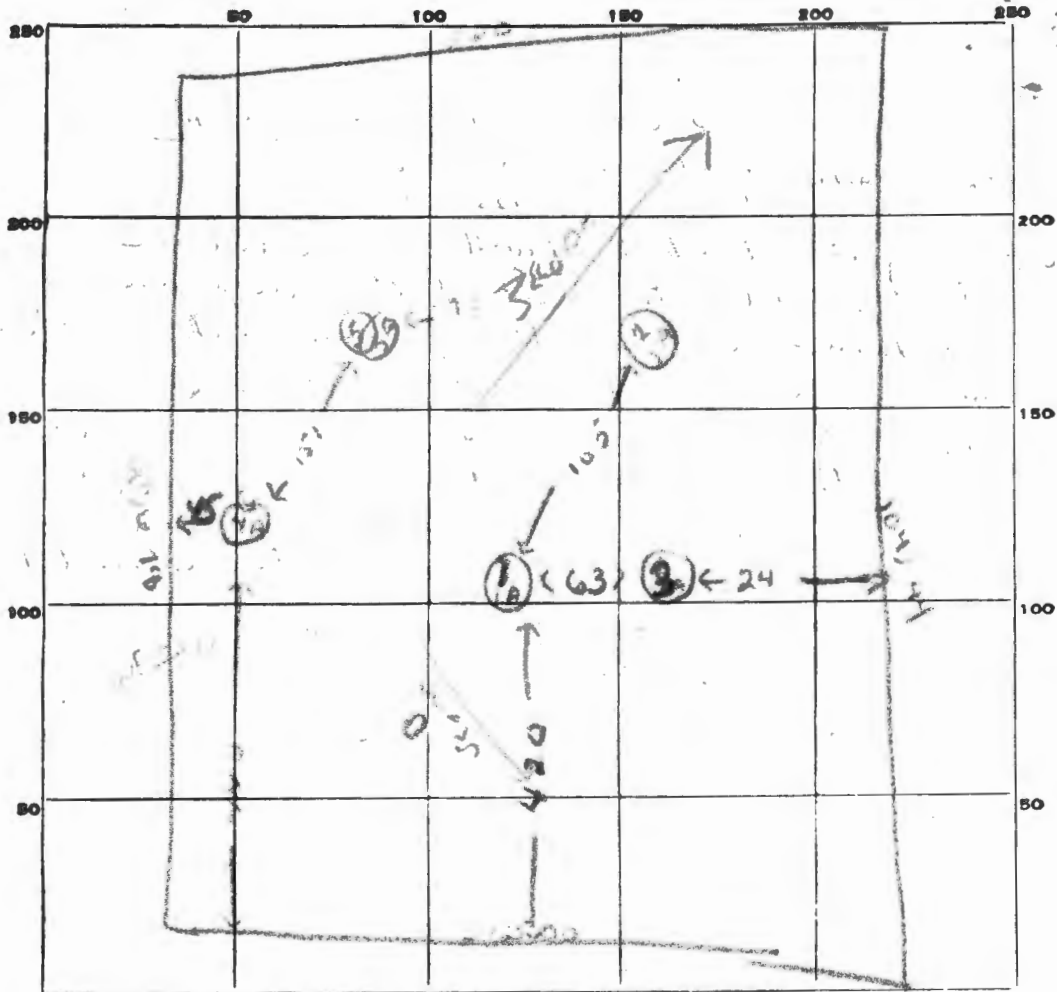

INDICATE NORTH. - NAME ADJOINING ROADWAY AS BASE LINE.

DATE	TEST NO.	DEPTH	PRE-WET		TEST - 1" DROP		TIME
			START	STOP	START	STOP	
11/5/13	1	11 1/2 ft	11 44	11 46	11 46	11 47	
	1A	5 1/2 ft	11 45	11 47	11 47	11 49	
	2	10 ft	11 48			11 51	
	2A	3 1/2 ft	11 48			11 51	
	3	11 ft	11 52				
	4	11 1/2 ft	12 13			12 16	
	4A	2 1/2 ft	12 13			12 16	
	5	10 1/2 ft	12 27		12 27	12 32	
	5A	4 1/2 ft	12 27	12 32	12 32	12 37	
		10 ft					

SOIL AUGER FINDING \_\_\_\_\_

TESTED BY \_\_\_\_\_

REMARKS \_\_\_\_\_

R. Turner

# APPLICATION

17833

A \_\_\_\_\_

P \_\_\_\_\_

SEWAGE DISPOSAL TESTING  
STATE OF MARYLAND - DEPARTMENT OF HEALTH AND MENTAL HYGIENE

4th

HOWARD COUNTY HEALTH DEPARTMENT  
ENVIRONMENTAL HEALTH SERVICES  
P. O. BOX 476, ELLICOTT CITY, MARYLAND 21043  
TELEPHONE: 465-5000, EXT. 356

DISTRICT \_\_\_\_\_

DATE 12/28/72

TO: THE COUNTY HEALTH OFFICER  
ELLICOTT CITY, MARYLAND

I, HEREBY, APPLY FOR THE NECESSARY TEST IN ORDER TO CONSTRUCT (OR RECONSTRUCT) A SEWAGE DISPOSAL SYSTEM.

PROPERTY OWNER Robert R. Levick (Contract Purchaser - Mr. Grecco)  
Cooksville, Maryland Any questions call Mrs. Hall, Skirven  
ADDRESS \_\_\_\_\_ PHONE Realty, 465-6767

PROPERTY LOCATION:

SUBDIVISION \_\_\_\_\_ LOT NO. 7

ROAD AND DESCRIPTION Forsythe Road and Old Frederick Road

SIZE OF LOT 5 + acres TYPE BLDG. 3 or 4 bedrooms  
NUMBER OF BEDROOMS

IF NOT SINGLE RESIDENCE DESCRIBE \_\_\_\_\_

THE SYSTEM INSTALLED UNDER THIS APPLICATION IS ACCEPTABLE ONLY UNTIL PUBLIC FACILITIES BECOME AVAILABLE.

SIGNATURE OF APPLICANT [Signature]


APPROVED BY \_\_\_\_\_ FOR \_\_\_\_\_ DATE \_\_\_\_\_  
(KIND OF SYSTEM)

REJECTED BY \_\_\_\_\_ FOR \_\_\_\_\_ DATE \_\_\_\_\_  
(KIND OF SYSTEM)

HOLD PENDING FURTHER TESTS \_\_\_\_\_ DATE \_\_\_\_\_

REASONS FOR REJECTION OR HOLDING \_\_\_\_\_

# THIS IS NOT A PERMIT

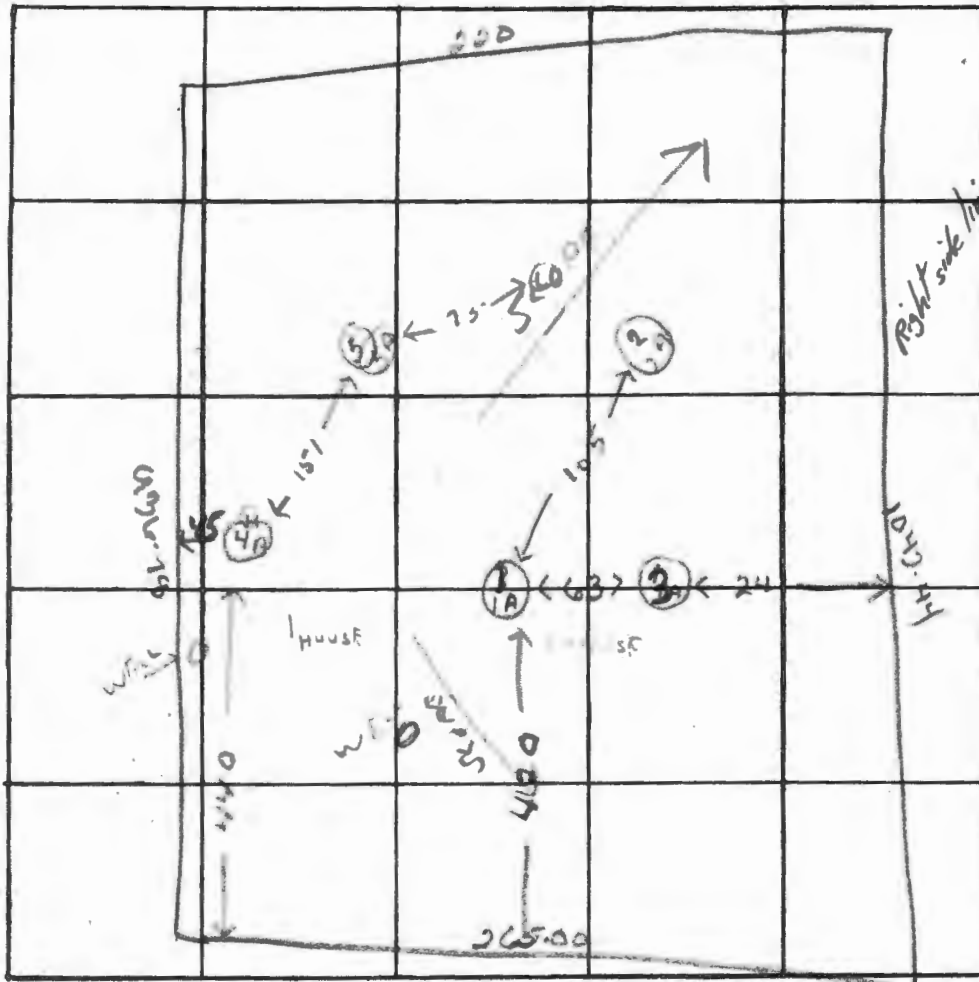

INDICATE NORTH. - NAME ADJOINING ROADWAY AS BASE LINE.  
70 ASYTHE

DATE	TEST NO.	DEPTH	PRE-WET		TEST - 1" DROP		TIME
			START	STOP	START	STOP	
11/25/73	1	11 1/2 ft	11 44	11 46	11 46	11 48	2
	1A	5 1/2 ft	11 45	11 47	11 47	11 49	2
	2	12 ft	11 55			11 57	2
	2A	3 1/2 ft				11 59	4
	3	11 ft	Some soil	end	but some soil		
	4	11 1/2 ft	12 13			12 15	3
	4A	3 1/2 ft	12 13			12 15	2
	5	10 1/2 ft	12 27		12 27	12 30	5
	5A	4 1/2 ft	12 27	12 32	12 30	12 32	11
	6	Some soil	11 ft				

REMARKS \_\_\_\_\_

TYPE OF SOIL \_\_\_\_\_

TESTED BY A. T. W. ALSO PRESENT: \_\_\_\_\_

# APPLICATION

A 17833

P \_\_\_\_\_

## SEWAGE DISPOSAL TESTING

STATE OF MARYLAND - DEPARTMENT OF HEALTH AND MENTAL HYGIENE

HOWARD COUNTY HEALTH DEPARTMENT  
ENVIRONMENTAL HEALTH SERVICES  
P. O. BOX 476, ELLICOTT CITY, MARYLAND 21043  
TELEPHONE: 465-5000, EXT. 356

DISTRICT 4th

DATE 12/28/72

TO: THE COUNTY HEALTH OFFICER  
ELLICOTT CITY, MARYLAND

I, HEREBY, APPLY FOR THE NECESSARY TEST IN ORDER TO CONSTRUCT (OR RECONSTRUCT) A SEWAGE DISPOSAL SYSTEM.

PROPERTY OWNER Robert R. Levick (Contract Purchaser - Mr. Grecco)

ADDRESS Cooksville, Maryland Any questions call Mrs. Hall, Skirven  
PHONE Realty, 465-6767

PROPERTY LOCATION:

SUBDIVISION \_\_\_\_\_ LOT NO. 7

ROAD AND DESCRIPTION Forsythe Road and Old Frederick Road

SIZE OF LOT 5 + acres TYPE BLDG. 3 or 4 bedrooms  
NUMBER OF BEDROOMS

IF NOT SINGLE RESIDENCE DESCRIBE \_\_\_\_\_

THE SYSTEM INSTALLED UNDER THIS APPLICATION IS ACCEPTABLE ONLY UNTIL PUBLIC FACILITIES BECOME AVAILABLE.

SIGNATURE OF APPLICANT: Jimmie Hall Agent Chesapeake Home Bldg. Co.

APPROVED BY \_\_\_\_\_ FOR \_\_\_\_\_ DATE \_\_\_\_\_  
(KIND OF SYSTEM)

REJECTED BY \_\_\_\_\_ FOR \_\_\_\_\_ DATE \_\_\_\_\_  
(KIND OF SYSTEM)

HOLD PENDING FURTHER TESTS \_\_\_\_\_ DATE \_\_\_\_\_

REASONS FOR REJECTION OR HOLDING \_\_\_\_\_

# THIS IS NOT A PERMIT

# APPLICATION

A 17783

## SEWAGE DISPOSAL TESTING

P \_\_\_\_\_

STATE OF MARYLAND - DEPARTMENT OF HEALTH AND MENTAL HYGIENE

HOWARD COUNTY HEALTH DEPARTMENT  
ENVIRONMENTAL HEALTH SERVICES

SPECIFICATIONS FOR DRY WELLS

DISTRICT 4th

P. O. BOX 476, ELLICOTT CITY, MARYLAND 21043

DATE 12/13/72

TELEPHONE: 465-5000, EXT. 356

DRY WELL - 188 sq ft of absorbent sidewall area per bedroom  
 To begin below the first 4 1/2 ft of non porous soil.  
 Maximum depth permitted for dry wells is 11 1/2 ft.  
 Locate one dry well 440 ft from front property line and 45 ft from left side line as seen from Forsythe Rd / locate the other dry well 420 ft from front property line and 87 ft from right side line as seen from Forsythe Rd.  
 (Two permits are needed)

TO: THE COUNTY HEALTH OFFICER  
ELLICOTT CITY, MARYLAND

I, HEREBY, APPLY FOR THE NECESSARY TEST IN ORDER TO CONSTRUCT (OR RECONSTRUCT) A SEWAGE DISPOSAL SYSTEM.

PROPERTY OWNER Robert R. Levick Silvadora Fiduccia

Any questions call Mrs. Radhe,  
PHONE Skirven Realty - 465-7457  
465-6767

ADDRESS Cooksville, Maryland

PROPERTY LOCATION:

SUBDIVISION \_\_\_\_\_ LOT NO. 7

ROAD AND DESCRIPTION Forsythe Road and Old Fræderick Road

SIZE OF LOT 5.509 acres TYPE BLDG. 3 or 4 bedrooms  
NUMBER OF BEDROOMS

IF NOT SINGLE RESIDENCE DESCRIBE \_\_\_\_\_

THE SYSTEM INSTALLED UNDER THIS APPLICATION IS ACCEPTABLE ONLY UNTIL PUBLIC FACILITIES BECOME AVAILABLE.

SIGNATURE OF APPLICANT /s/ Robert Levick per P. Radhe, Agent


✓ APPROVED BY Robert V. Tone FOR Dry Well DATE 2/2/73  
(KIND OF SYSTEM)

REJECTED BY \_\_\_\_\_ FOR \_\_\_\_\_ DATE \_\_\_\_\_  
(KIND OF SYSTEM)

HOLD PENDING FURTHER TESTS \_\_\_\_\_ DATE \_\_\_\_\_


REASONS FOR REJECTION OR HOLDING \_\_\_\_\_

# THIS IS NOT A PERMIT


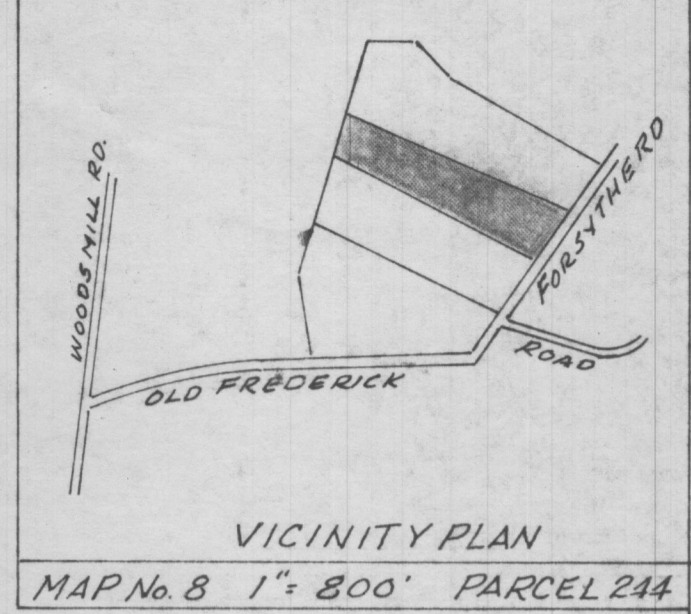


\* COORDINATES ON ASSUMED DATUM - Pipe fd.

COORDINATES		
1	10,000.000	10,000.000
2	9,907.355	9,912.958
3	9,806.860	9,818.540
4	10,363.550	9,031.800
5	10,459.074	9,075.390
6	10,563.700	9,123.130
7	10,009.617	9,985.041
8	9,915.304	9,905.107
9	10,084.825	9,636.897
10	10,129.350	9,579.180
11	10,248.400	9,410.930
12	9,913.526	9,903.359
13	9,815.231	9,806.728

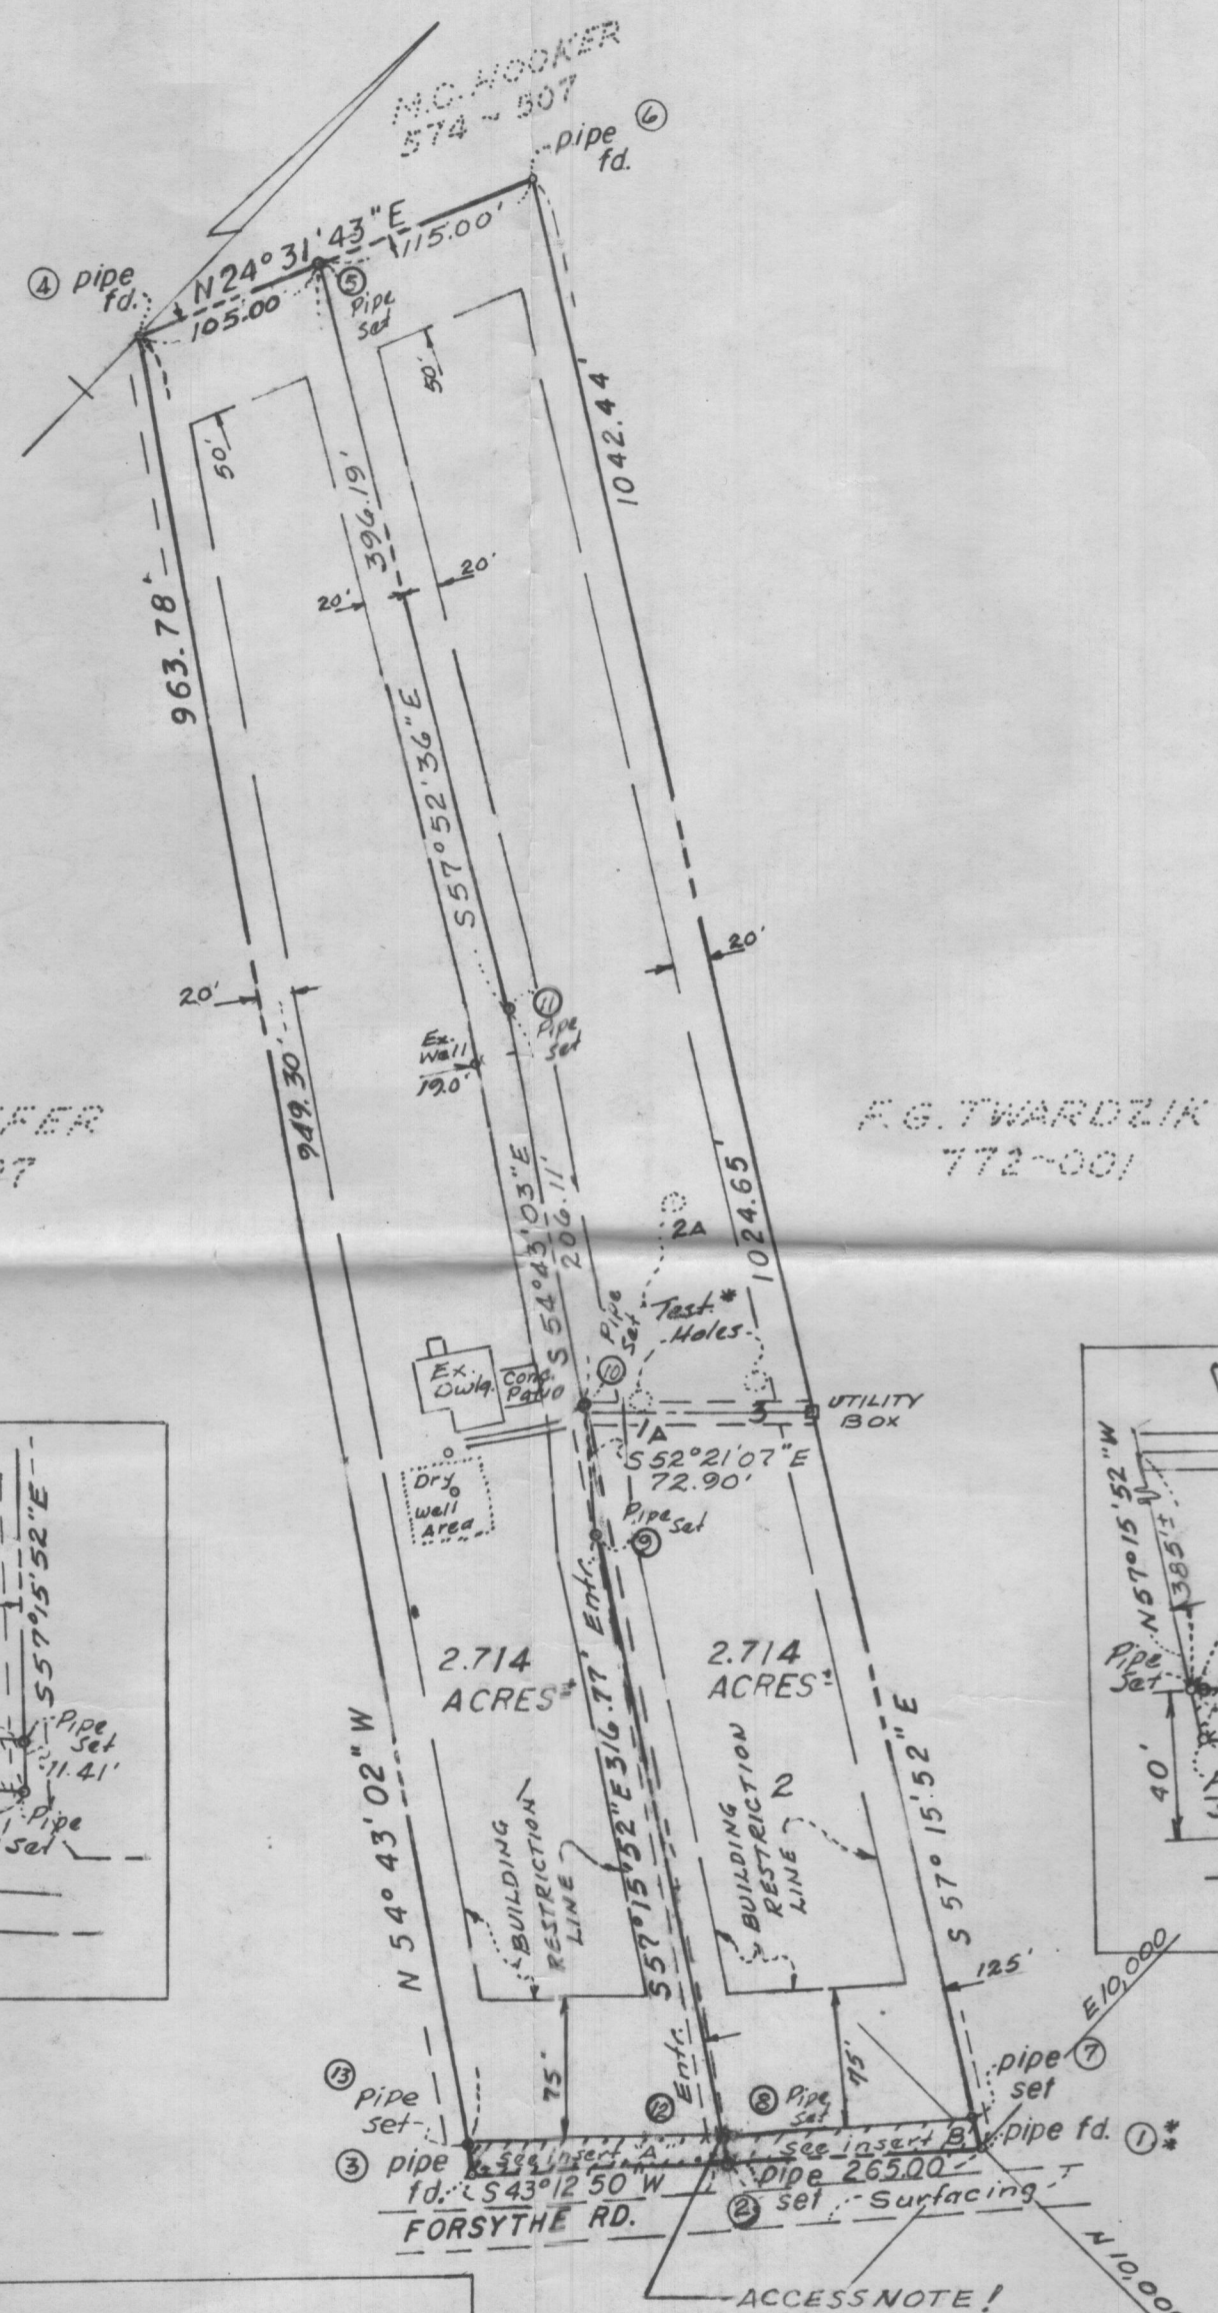

RECORDED PLAT 3859  
ON 10/14/77 AMONG THE LAND RECORDS OF  
HOWARD COUNTY, MD.

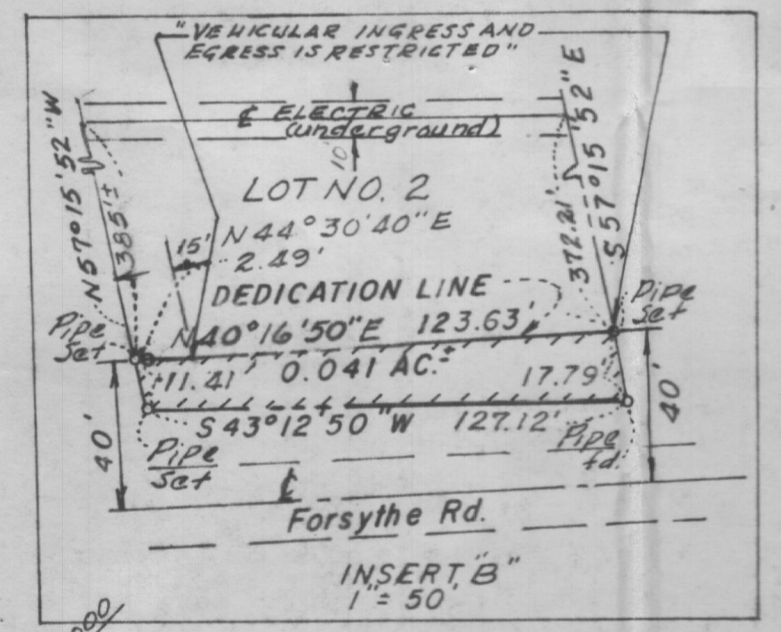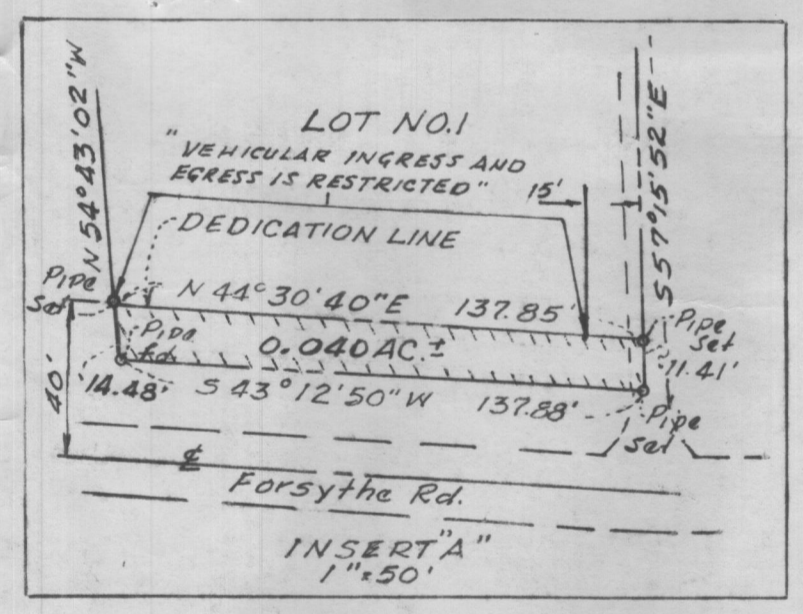

\* NOTE: PERCOLATION TEST HOLES 1A, 2A & 3 TESTED 1-25-73

NOTE: The lots shown hereon comply with the minimum ownership width and lot areas as required by the Maryland State Department of Health and Mental Hygiene.

Total number of lots ----- 2  
Total area of lots ----- 5.428 ACRES ±  
Total area of roadway including widening strip ----- 0.081 ACRES ±  
Total Area of subdivision ----- 5.509 ACRES ±

**OWNERS DEDICATION**

We Giovanni Greco, and Francesca Greco owners, of the property shown and described hereon, hereby adopt this plan of subdivision, and in consideration of the approval of this Final Plat by the Office of Planning and Zoning, establish the minimum building restriction lines and grant unto Howard County, Maryland, its successors and assigns, (1) the right to lay, construct and maintain sewers, drains, water pipes and other municipal utilities and services, in and under all roads and street right-of-ways and the specific easement areas shown hereon; (2) dedicate to public use the beds of the streets and/or roads and floodplains and open space where applicable, and for One Dollar (\$1.00) consideration, hereby grant the right and option to Howard County to acquire the fee simple title to the beds of the streets and/or roads and floodplains and open space where applicable; (3) that no building or similar structure of any kind shall be erected on or over the said easements and right-of-ways; and (4) it is further agreed that maintenance of all waterways, drainage easements and/or floodplains shown hereon are the responsibility of the property owner or its successors and assigns.

Witness my/our hands this 14th day of July, 1977

**SURVEYOR'S CERTIFICATE**

I hereby certify that the Final Plat shown hereon is correct; that it is a subdivision of ALL OF the lands conveyed. By ARTHUR PINCUS to GIOVANNI GRECO & FRANCESCA GRECO

deed dated 13 MARCH 1973, and recorded in the Land Records of Howard County, in Liber 628 Folio 711, and that all monuments are in place as shown, in accordance with the Annotated Code of Maryland, as amended.

(Date) 7/1/77 (Property Line Surveyor)

**OWNERS and DEVELOPERS**

GIOVANNI and FRANCESCA GRECO  
SYKESVILLE 14236 Forsythe Rd.  
HOWARD COUNTY, MARYLAND 21784

**"GRECO'S DIVISION"**

FOURTH ELECTION DISTRICT HOWARD COUNTY, MD.  
JULY 1, 1977 SCALE 1"=100'

PREPARED BY:  
S.J. DIPIETRO - PROPERTY LINE SURVEYOR NO. 72  
RT. 1 Box 572D CHESTER, MD. 21619



APPROVED: For private water and private sewerage systems.  
Howard County Health Department  
County Health Officer *[Signature]* Date 10-12-77

APPROVED: Howard County Office of Planning and Zoning  
Director *[Signature]* Date 10-13-77

APPROVED: For storm drainage systems and public roads  
Howard County Department of Public Works  
Director *[Signature]* Date 10-13-77

F-78-64