

# APPLICATION

A 20221

SEWAGE DISPOSAL TESTING

P \_\_\_\_\_

STATE OF MARYLAND - DEPARTMENT OF HEALTH AND MENTAL HYGIENE

HOWARD COUNTY HEALTH DEPARTMENT  
ENVIRONMENTAL HEALTH SERVICES

DISTRICT 3

P. O. BOX 476, ELLICOTT CITY, MARYLAND 21043  
TELEPHONE: 465-5000, EXT. 356

DATE 6/25/74

*#-12' Loked  
or to 000 ft.  
Recorded 2 yrs.  
ago.*

*7/18/74  
9:30*

TO: THE COUNTY HEALTH OFFICER  
ELLICOTT CITY, MARYLAND

*see book sheet.*

I, HEREBY, APPLY FOR THE NECESSARY TEST IN ORDER TO CONSTRUCT (OR RECONSTRUCT) A SEWAGE DISPOSAL SYSTEM.

PROPERTY OWNER Lawrence King

ADDRESS 2821 W. Cold Spring Lane, Baltimore, Md. PHONE 542-5023  
21215

PROPERTY LOCATION:

SUBDIVISION \_\_\_\_\_ LOT NO. \_\_\_\_\_

ROAD AND DESCRIPTION Henryton Rd. - 1 1/4 miles in at foot of hill from Rt. 99  
(little wooden garage on right)

SIZE OF LOT 1.000 acres TYPE BLDG. 3  
NUMBER OF BEDROOMS  
(Single Fmly. Dwllg.)

IF NOT SINGLE RESIDENCE DESCRIBE \_\_\_\_\_

THE SYSTEM INSTALLED UNDER THIS APPLICATION IS ACCEPTABLE ONLY UNTIL PUBLIC FACILITIES BECOME AVAILABLE.

SIGNATURE OF APPLICANT /s/ Lawrence King

APPROVED BY Robert V. Tamm FOR Ony Well DATE 7/18/74  
(KIND OF SYSTEM)

REJECTED BY \_\_\_\_\_ FOR \_\_\_\_\_ DATE \_\_\_\_\_  
(KIND OF SYSTEM)

HOLD PENDING FURTHER TESTS \_\_\_\_\_ DATE \_\_\_\_\_

REASONS FOR REJECTION OR HOLDING \_\_\_\_\_

# THIS IS NOT A PERMIT


INDICATE NORTH. - NAME ADJOINING ROADWAY AS BASE LINE

DATE	TEST NO.	DEPTH	PRE-WET		TEST - 1" DROP		TIME
			START	STOP	START	STOP	

REMARKS \_\_\_\_\_

TYPE OF SOIL \_\_\_\_\_

TESTED BY \_\_\_\_\_ ALSO PRESENT: \_\_\_\_\_

# APPLICATION

A 20221

## SEWAGE DISPOSAL TESTING

P \_\_\_\_\_

STATE OF MARYLAND - DEPARTMENT OF HEALTH AND MENTAL HYGIENE

HOWARD COUNTY HEALTH DEPARTMENT Septic Tank - 1000 gal. DISTRICT 3  
ENVIRONMENTAL HEALTH SERVICES

P. O. BOX 476, ELLICOTT CITY, MARYLAND 21043 Dry Well - 400 sq. ft. DATE 6/25/74  
TELEPHONE: 465-5000, EXT. 356

*absorbent sidewalk area to begin below the first 5 ft. ft. of non porous soil. Maximum depth is 12 ft. Locate dry well 127 ft from front lot line and 95 ft. from left side line as seen from Henryton Rd.*

TO: THE COUNTY HEALTH OFFICER  
ELLICOTT CITY, MARYLAND

I, HEREBY, APPLY FOR THE NECESSARY TEST IN ORDER TO CONSTRUCT (OR RECONSTRUCT) A SEWAGE DISPOSAL SYSTEM.

PROPERTY OWNER Lawrence King

ADDRESS 2821 W. Cold Spring Lane, Baltimore, Md. PHONE 542-5023  
21215

PROPERTY LOCATION:

SUBDIVISION \_\_\_\_\_ LOT NO. \_\_\_\_\_

ROAD AND DESCRIPTION Henryton Rd. - 1/4 miles in at foot of hill from Rt. 99  
(little wooden garage on right)

SIZE OF LOT 1.000 acres TYPE BLDG. 3  
NUMBER OF BEDROOMS  
(Single Fmly. Dwlg.)

IF NOT SINGLE RESIDENCE DESCRIBE \_\_\_\_\_

THE SYSTEM INSTALLED UNDER THIS APPLICATION IS ACCEPTABLE ONLY UNTIL PUBLIC FACILITIES BECOME AVAILABLE.

SIGNATURE OF APPLICANT /s/ Lawrence King


APPROVED BY Robert V. Tane FOR Dry Well DATE 7/22/74  
(KIND OF SYSTEM)

REJECTED BY \_\_\_\_\_ FOR \_\_\_\_\_ DATE \_\_\_\_\_  
(KIND OF SYSTEM)

HOLD PENDING FURTHER TESTS \_\_\_\_\_ DATE \_\_\_\_\_

REASONS FOR REJECTION OR HOLDING \_\_\_\_\_

# THIS IS NOT A PERMIT

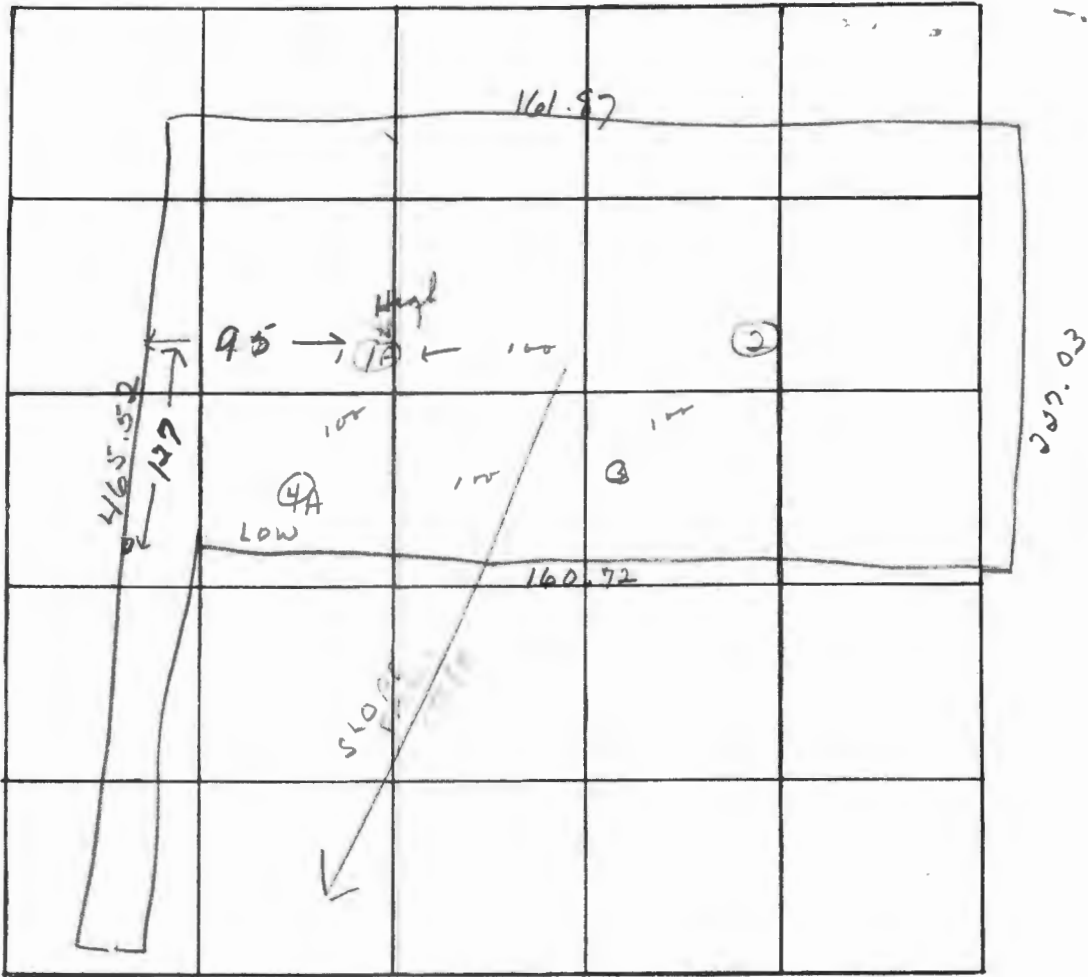

INDICATE NORTH. - NAME ADJOINING ROADWAY AS BASE LINE.

Henry Lee Rd.


DATE	TEST NO.	DEPTH	PRE-WET		TEST - 1" DROP		TIME
			START	STOP	START	STOP	
7/18/74	1	12 ft	9 50	9 52	9 52	9 56	4 min
	1A	4 ft	9 50	9 55	9 55	10 08	13 min
	2	12 ft	Same Soil	Same Soil	Some rock in	bottom	-"
	3	11 ft	10 32	10 34	10 34	10 37	3 min
	4	12 ft	10 50	—	—	10 55	5 min
	4A	4 ft	10 50	—	—	10 55	5 min

REMARKS Sandy loam type - Good soil seen 2 ft.

TYPE OF SOIL One to slope start in 1' at 5 ft.

TESTED BY R. T. ... ALSO PRESENT: \_\_\_\_\_

*1/2 mile in its foot of line (little wooden gages on right) from Rt. 99*

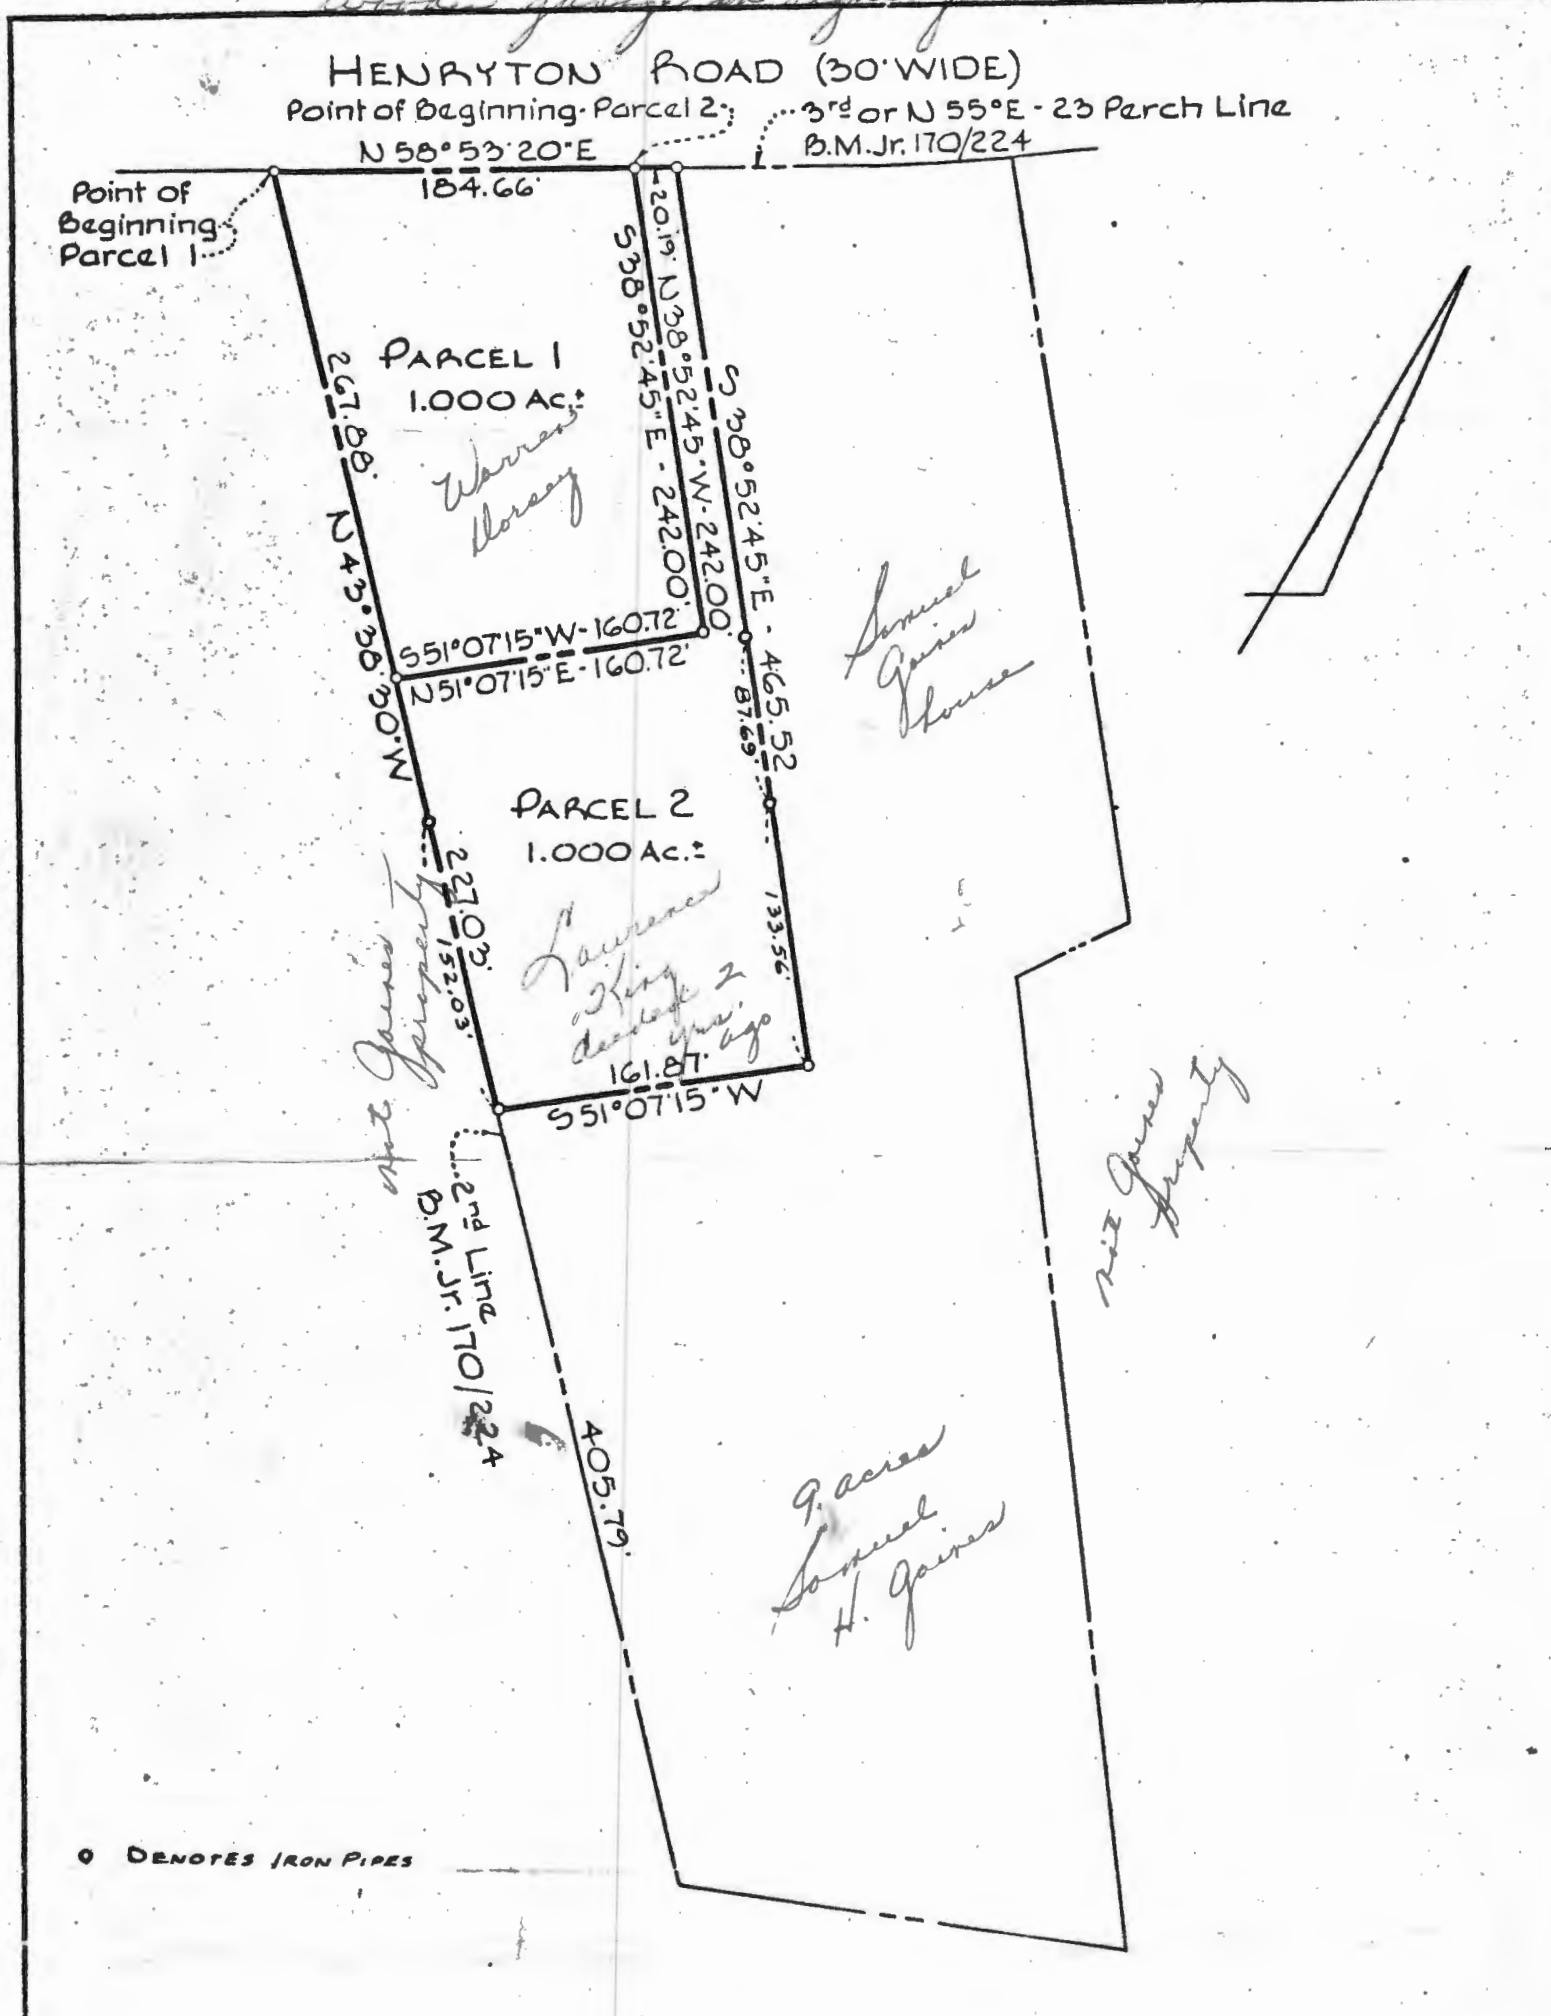

○ DENOTES IRON PIPES

PURDUM AND JESCHKE  
 ENGINEERS AND LAND SURVEYORS  
 24 PARK AVE.  
 ELLICOTT CITY, MARYLAND 21043

PARCELS TO BE CONVEYED BY  
**SAMUEL H. GAINES, ET UX.**  
 3RD ELECTION DISTRICT - HOWARD COUNTY, MD.  
 MARCH 8, 1972  
 SCALE: 1" = 100'

*Laurence King*  
*2821 W. Cold Spring Bend*  
*Balts. 21215 - 574-0023*  
*3 bedrooms*  
 7/18/74  
 9:30  
 pt. cost