

APPLICATION

SEWAGE DISPOSAL TESTING

STATE OF MARYLAND - DEPARTMENT OF HEALTH AND MENTAL HYGIENE

HOWARD COUNTY HEALTH DEPARTMENT
ENVIRONMENTAL HEALTH SERVICES

P. O. BOX 476 ELLICOTT CITY, MARYLAND 21043
TELEPHONE: 992-2330

A 33722

P _____

DISTRICT 6

DATE 3/26/84

Prep.
5/22/84
9:30 A.M. NOT FIND COULD SITE RH

with soil

6/22/84 P.M.
1:30

TO: THE COUNTY HEALTH OFFICER
ELLICOTT CITY, MARYLAND

I HEREBY APPLY FOR THE NECESSARY TEST IN ORDER TO CONSTRUCT (OR RECONSTRUCT) A SEWAGE DISPOSAL SYSTEM.

PROPERTY OWNER Thomas E. Callahan & Ester Callahan

ADDRESS 7004 Marmick Drive / Laurel, MD. 20810 PHONE (301) 953-7363

PROPERTY LOCATION:

SUBDIVISION _____ LOT NO. Block E / Lots 4-11
Block A / Lots 3-17

ROAD AND DESCRIPTION End of Hilda Ave. Old Annapolis Junction, MD.

2nd ~~Postoff~~ driveway past Postoffice on right side

SIZE OF LOT 1.89 Acre TYPE BLDG. WAREHOUSE
12 Employer (NUMBER OF BEDROOMS)

THE SYSTEM INSTALLED UNDER THIS APPLICATION IS ACCEPTABLE ONLY UNTIL PUBLIC FACILITIES BECOME AVAILABLE. I FULLY UNDERSTAND THE

FEE CONNECTED WITH THE FILING OF THIS PERC TEST APPLICATION IS NON-REFUNDABLE UNDER ANY CIRCUMSTANCES. I ALSO AGREE TO COMPLY

WITH ALL M.O.S.H.A. REQUIREMENTS IN TESTING THIS LOT. Joseph W. Albert
(SIGNATURE OF APPLICANT)

APPROVED BY _____ FOR _____ DATE _____

REJECTED BY _____ FOR _____ DATE _____

HOLD PENDING FURTHER TESTS _____ DATE _____

REASONS FOR REJECTION OR HOLDING 6/24/84 Perc slow & underground water. Some part of lot too heavy woods for backhoe (RH)

THIS IS NOT A PERMIT

SOIL PROFILE

0'

INDICATE NORTH - NAME ADJOINING ROADWAY AS BASE LINE.


DATE	TEST NO.	DEPTH	PRE-WET		TEST - 1" DROP		TIME
			START	STOP	START	STOP	

REMARKS _____

TYPE OF SOIL _____

TESTED BY _____ ALSO PRESENT _____

ANKA LOTS 3,4,5,6,7,18,8,9,10,11,12,13,14,15,16,17

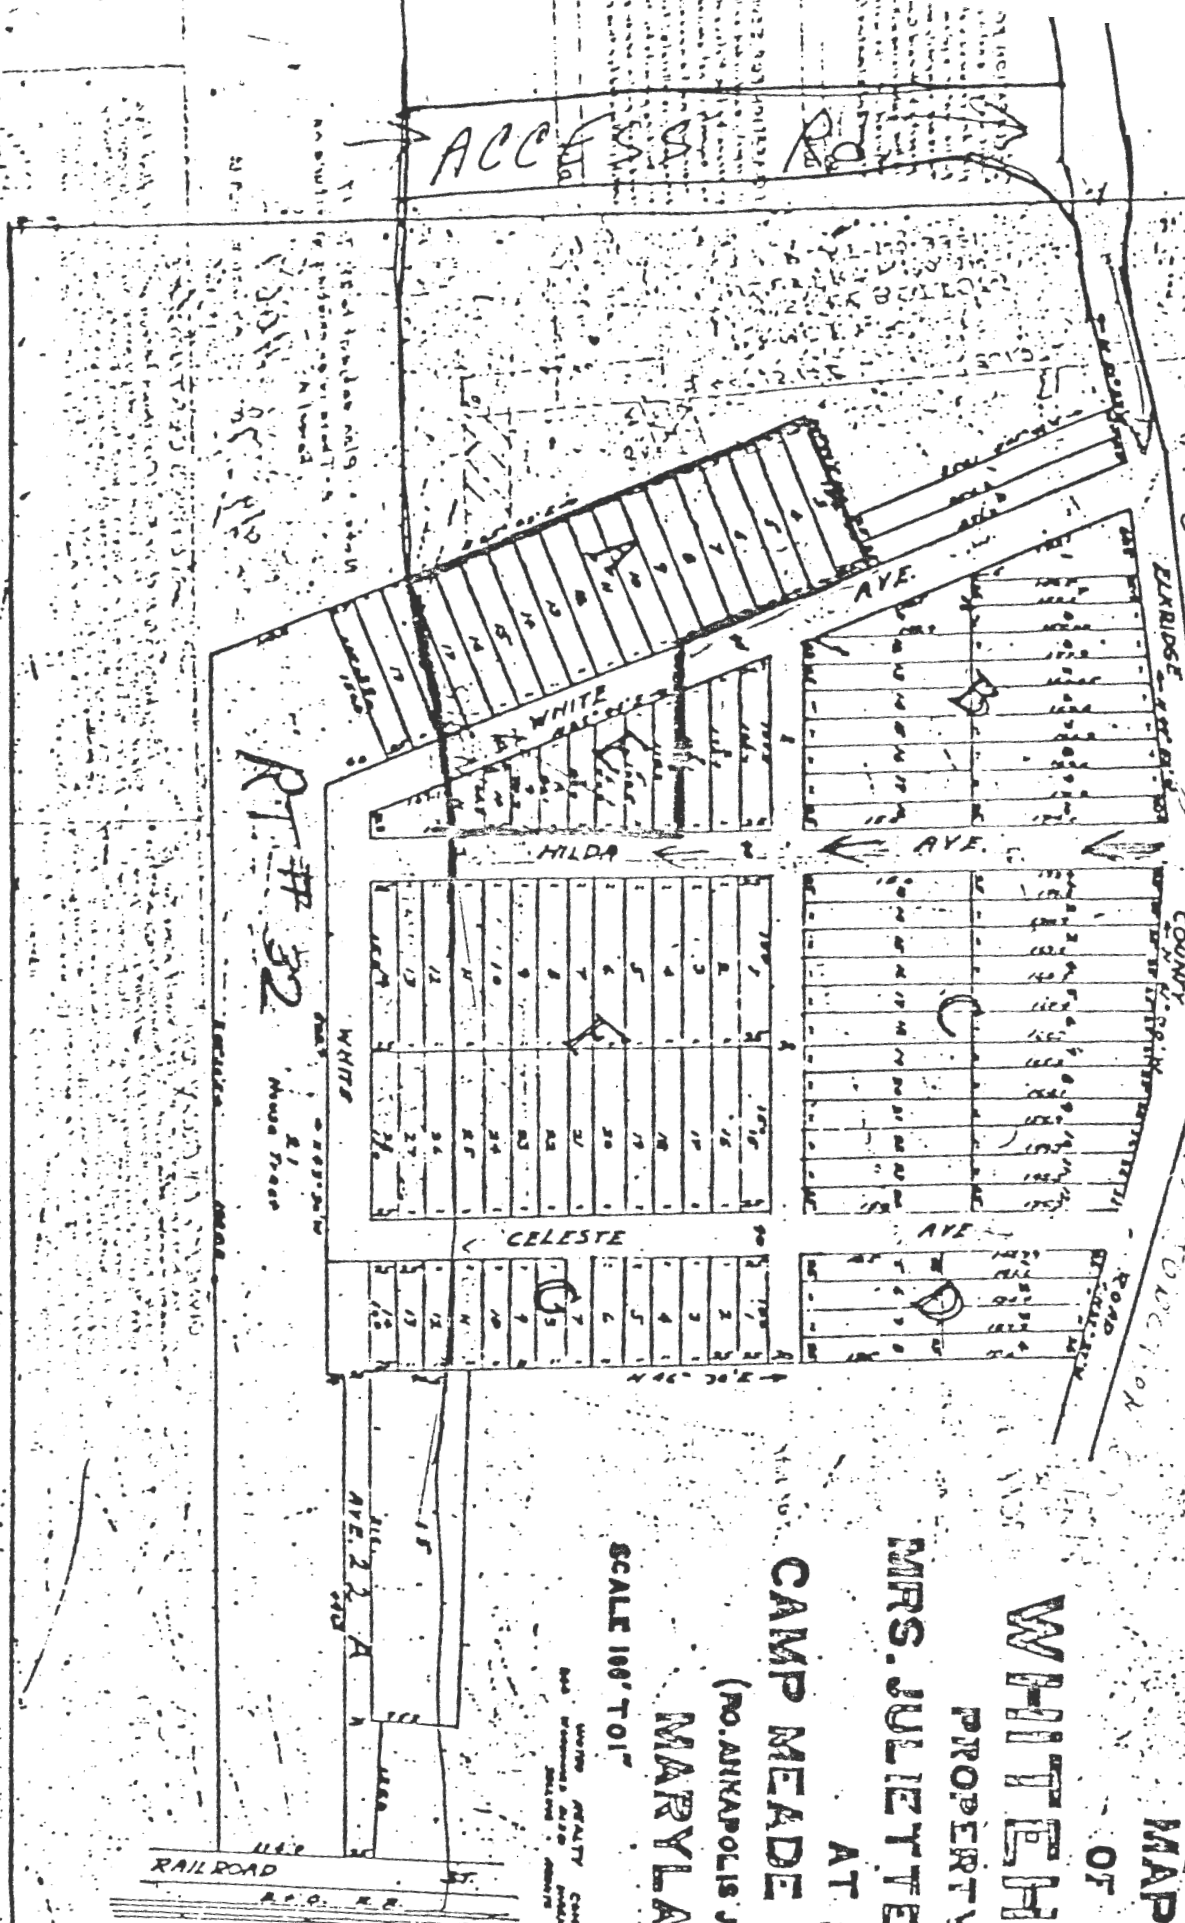

OLD ROUTE #32 ANKAPOLIS

MAP OF

WHITEHURS

PROPERTY OF

MRS. JULIETTE M. WH

AT

CAMP MEADE JUNCT

(NO. ANKAPOLIS JUNCTION)

MARYLAND

SCALE 100' TO 1"

NOV 1911

W. H. WATSON, REALTY COMPANY, INC. ANKAPOLIS, M. D.

W. H. WATSON, REALTY COMPANY, INC. ANKAPOLIS, M. D.

free

APPLICATION

A 33722

SEWAGE DISPOSAL TESTING

STATE OF MARYLAND - DEPARTMENT OF HEALTH AND MENTAL HYGIENE

P _____

HOWARD COUNTY HEALTH DEPARTMENT
ENVIRONMENTAL HEALTH SERVICES

DISTRICT 6

P. O. BOX 476 ELLICOTT CITY, MARYLAND 21043
TELEPHONE: 992-2330

DATE 3/26/84

TO: THE COUNTY HEALTH OFFICER
ELLICOTT CITY, MARYLAND

I, HEREBY, APPLY FOR THE NECESSARY TEST IN ORDER TO CONSTRUCT (OR RECONSTRUCT) A SEWAGE DISPOSAL SYSTEM.

*PROPERTY OWNER Thomas E. Callahan & Esther Callahan

ADDRESS 7004 Marmick Drive / Laurel, MD. 20810 PHONE (301) 953-7363

PROPERTY LOCATION:

SUBDIVISION _____ LOT NO. Block E / lots 4-11
Block A / lots 3-17
ROAD AND DESCRIPTION End of Hilda Ave. Old Annapolis Junction, MD.

SIZE OF LOT 1.89 Acre TYPE BLDG. _____
(NUMBER OF BEDROOMS)

THE SYSTEM INSTALLED UNDER THIS APPLICATION IS ACCEPTABLE ONLY UNTIL PUBLIC FACILITIES BECOME AVAILABLE. I FULLY UNDERSTAND THE

FEE CONNECTED WITH THE FILING OF THIS PERC TEST APPLICATION IS NOT REFUNDABLE UNDER ANY CIRCUMSTANCES. I ALSO AGREE TO COMPLY

WITH ALL M.O.S.H.A. REQUIREMENTS IN TESTING THIS LOT. Joseph W. Albert
(SIGNATURE OF APPLICANT)



APPROVED BY _____ FOR _____ DATE _____

REJECTED BY _____ FOR _____ DATE _____

HOLD PENDING FURTHER TESTS _____ DATE _____

REASONS FOR REJECTION OR HOLDING _____

THIS IS NOT A PERMIT

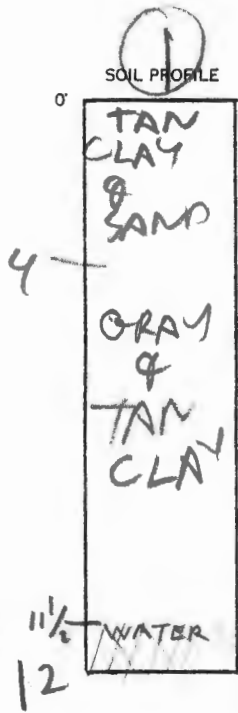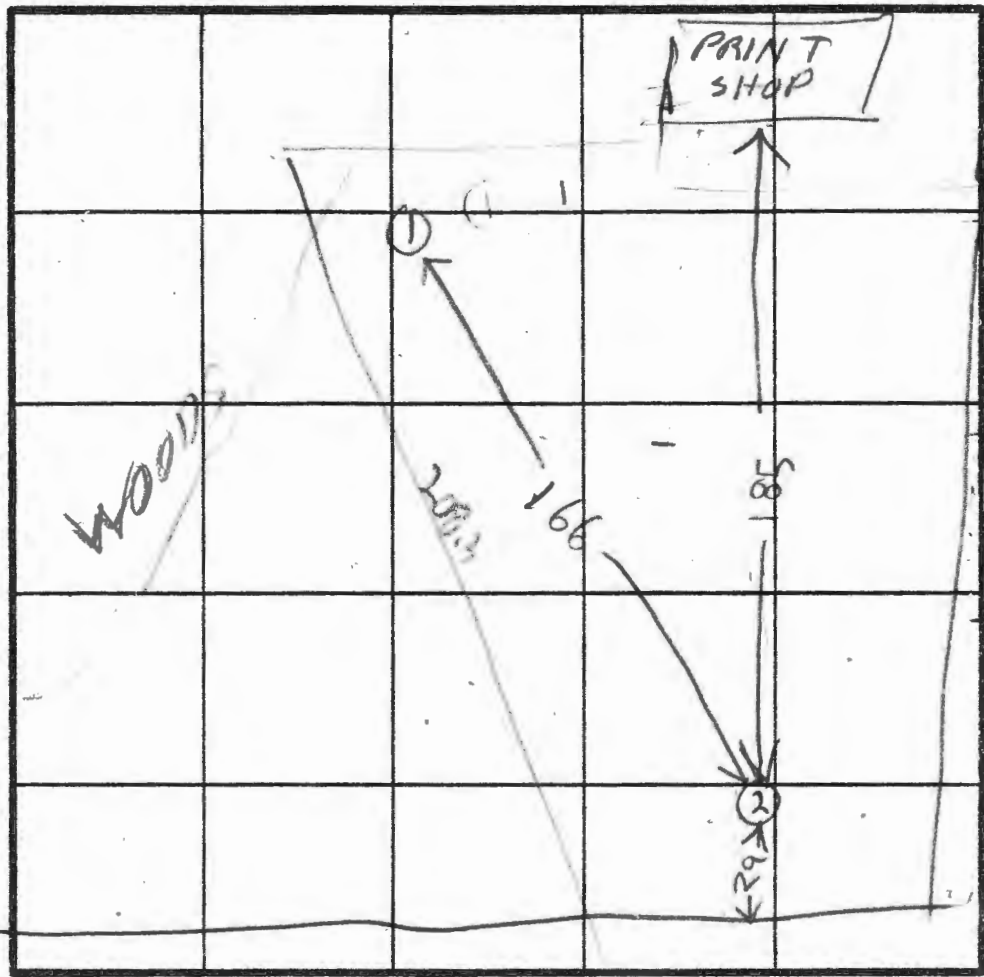

INDICATE NORTH - NAME ADJOINING ROADWAY AS BASE LINE.
ROUTE NEW 32

DATE	TEST NO.	DEPTH	PRE-WET		TEST - 1" DROP		TIME
			START	STOP	START	STOP	
6/20/84	15	3 1/2	114	155	little per		
	10	9	114	155	little per		
6/22/84	14	12	WATER		11 1/2		

REMARKS Part of lot heavy woods Could not get Backhoe on site

TYPE OF SOIL FYDCIC CO SKIP & WATNE

TESTED BY R HODGES ALSO PRESENT LARRY ALBERT

FILE MISSED APPOINTMENT

DATE REPORTED 5/?/84 AND AGAIN 5/29/84

PROPERTY OWNER SHARON ALBERT

PHONE NO. 792-4991

P.O. ADDRESS RE: THOMAS CALHOUN PROP - HILDA AVE.

DIRECTIONS TO PROPERTY SEE BELOW

INFORMANT MS. ALBERT -

COMPLAINED THAT COUNTY WAS NEGLIGENT IN NOT HAVING AN INSPECTOR APPEAR FOR HER SCHEDULED PERC TEST ON MAY 22.

CONDITION FOUND: I CHECKED WITH MR HODGES AND CONFIRMED THRU NOTES IN HIS LOG THAT HE ATTEMPTED TO KEEP THE APPOINTMENT BUT COULD NOT LOCATE THE PROPERTY. HE CALLED THE OFFICE FOR ADDITIONAL DIRECTIONS - SO HE LOOKED FOR THE PROPERTY AGAIN BUT WAS STILL UNABLE TO LOCATE IT.


ACTION TAKEN: I CALLED MS ALBERT AND EXPLAINED THAT WE HAD MADE AN HONEST ATTEMPT BUT COULD NOT FIND THE PROPERTY.

SHE SEEMED SATISFIED AND SAID HER CONTRACTOR WOULD CALL TO SET UP ANOTHER APPOINTMENT.

SHE GAVE THE FOLLOWING DIRECTIONS TO HELP LOCATE PROPERTY:

FINAL DISPOSITION: "COME IN ON HILDA AVE. (NO STREET SIGN). TURN ON SECOND DRIVEWAY PAST ANNAPOLIS JUNCTION POST OFFICE, ^{HD-76} LOT BACKS ON NEW ROUTE 32. LOOK FOR SIGN THAT SAYS 'JOHNSON HYDROSEEDING'."

5/31/84 CWilliams

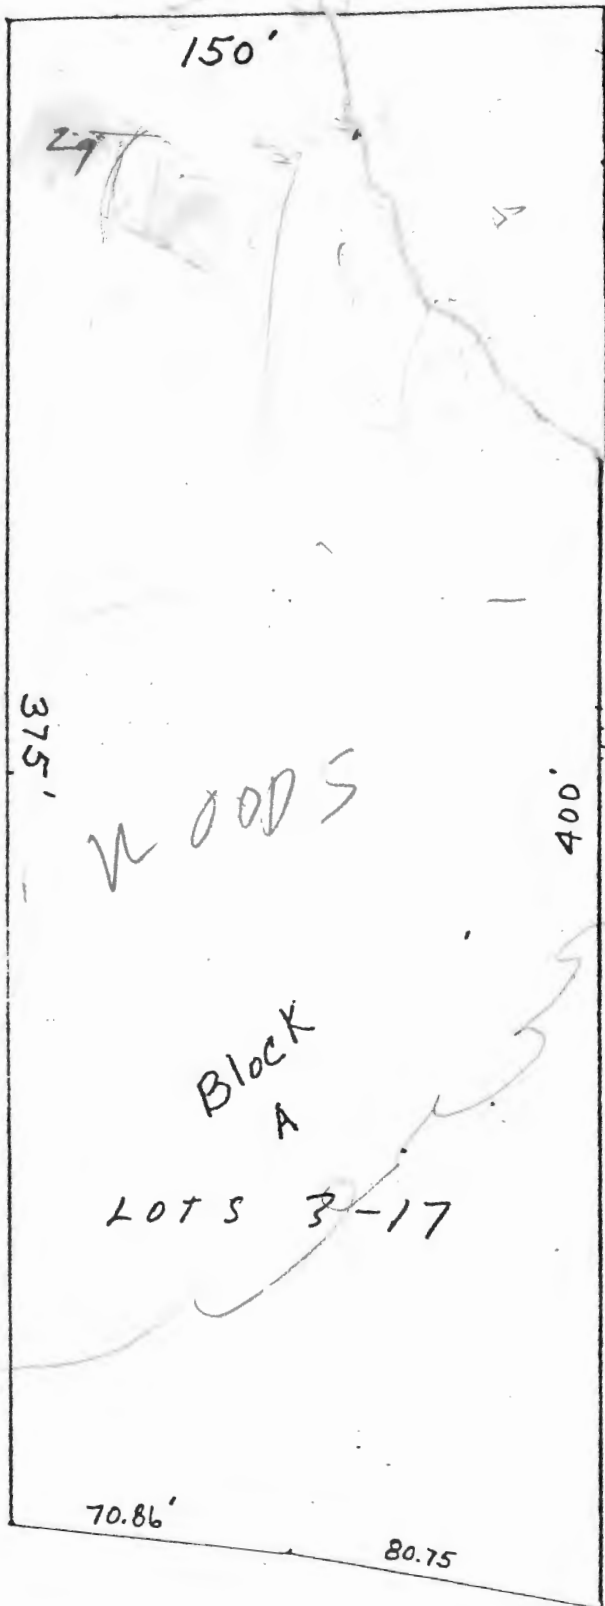


White Ave.
(Dedicated 40' street R/W)

WOODS

Block A

LOTS 3-17

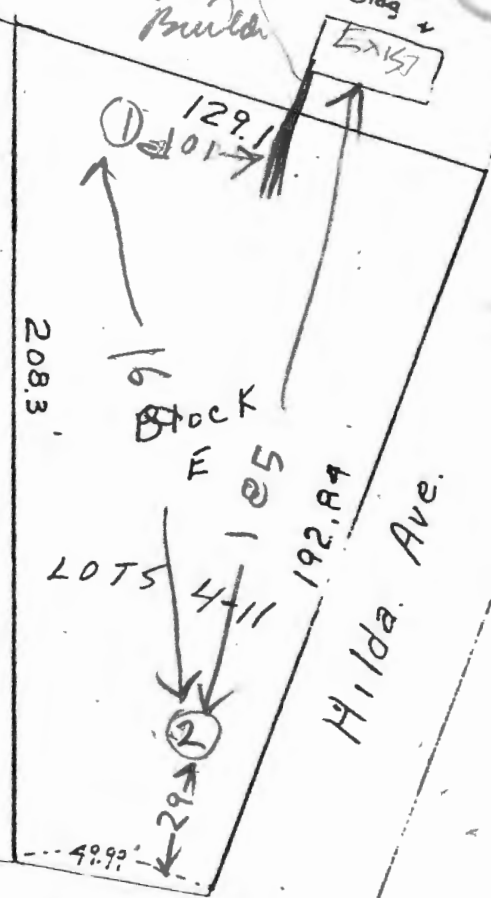

2 ACRES APPROX.

Md. State Rt. # 32

73
79
1

CALLAHAN

PROPERTY

HILDA AVE

Per Test

Scheduled

22 MAY 84

& not run

could not find

site