

# APPLICATION

SEWAGE DISPOSAL TESTING

MARYLAND STATE DEPARTMENT OF HEALTH

HOWARD COUNTY

ELLICOTT CITY

DISTRICT 4

DATE 5-20-63

*Fill out in triplicate.*

*Make fee of \$15.00 payable to:*  
HOWARD COUNTY HEALTH DEPT. - SANITATION

*Dry well 10 ft in dia by 110 ft. deep below the inlet located 153 ft. from the front property line and 104 ft. off the right side property line as determined when facing the lot from Hipsley Mill Rd. Locate inlet at 3 ft. below original grade. 750 gallon tank.*

TO: THE COUNTY HEALTH OFFICER  
ELLICOTT CITY, MARYLAND

I, HEREBY, APPLY FOR THE NECESSARY TESTS IN ORDER TO CONSTRUCT (OR RECONSTRUCT) A SEWAGE DISPOSAL SYSTEM.

PROPERTY OWNER Willard E. Stue  
ADDRESS \_\_\_\_\_ PHONE \_\_\_\_\_

PROPERTY LOCATION:

SUBDIVISION \_\_\_\_\_ LOT NO. \_\_\_\_\_

ROAD AND DESCRIPTION Hipsley Mill Rd - 1/2 mile from junction Chapel Road rd. left.  
OCCUPANT \_\_\_\_\_ PHONE \_\_\_\_\_

PERSON TO CONSTRUCT SYSTEM \_\_\_\_\_  
ADDRESS \_\_\_\_\_ PHONE \_\_\_\_\_

SIZE OF LOT 1 acre plus TYPE BLDG. 3  
NUMBER OF BEDROOMS \_\_\_\_\_

IF NOT SINGLE RESIDENCE DESCRIBE \_\_\_\_\_

SIGNATURE OF APPLICANT Willard E. Stue


APPROVED BY Henning FOR Dry Well DATE 5-21-63  
(KIND OF SYSTEM)

REJECTED BY \_\_\_\_\_ FOR \_\_\_\_\_ DATE \_\_\_\_\_  
(KIND OF SYSTEM)

HOLD PENDING FURTHER TESTS \_\_\_\_\_ DATE \_\_\_\_\_

REASONS FOR REJECTION OR HOLDING \_\_\_\_\_

# THIS IS NOT A PERMIT

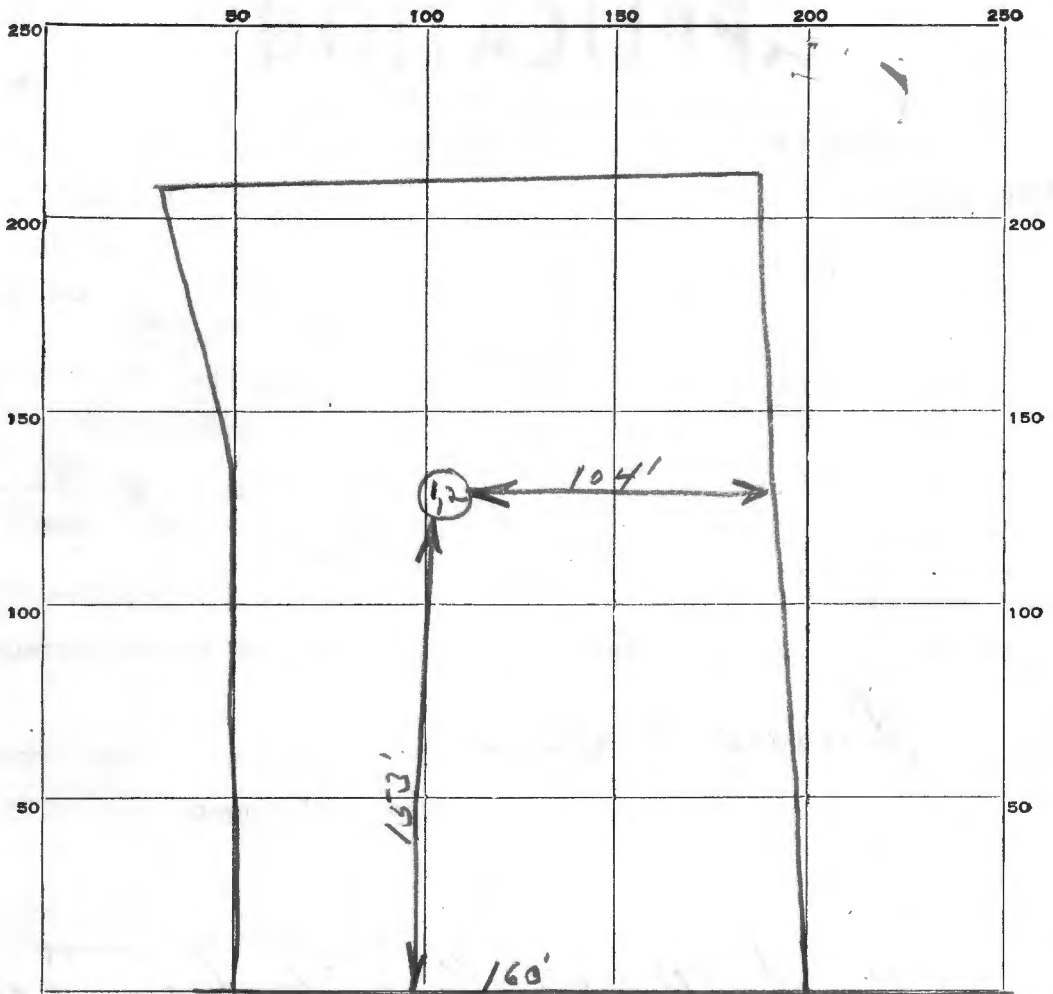

DATE	TEST NO.	DEPTH	PRE-WET		TEST - 1" DROP		TIME
			START	STOP	START	STOP	
5-21-63	1	9'	1:44	1:49	1:49	1:55	67 min
1	2	4 1/2'	1:45	1:49	1:49	1:55	67 min

SOIL AUGER FINDING \_\_\_\_\_

TESTED BY \_\_\_\_\_

REMARKS Inlet at 3 FT. 10' x 10' D.W.

5-21-63 ALSO PRESENT Willard E. Ruse LOT NO. \_\_\_\_\_