

APPLICATION

SEWAGE DISPOSAL TESTING

A 03204
P _____

MARYLAND STATE DEPARTMENT OF HEALTH

HOWARD COUNTY 750 Gallon tank

ELLICOTT CITY

Tile Field - 376 sq ft bottom area

DISTRICT 4

DATE 11-18-60

Place the tile field on the area

135 ft to 130 ft from the edge of Rt # 97
and 15 ft to 100 ft from the side of the
lot which is closest to Route # 144 -

TO: THE COUNTY HEALTH OFFICER
ELLICOTT CITY, MARYLAND

RETEST REQUIRED

EXISTING BUILDING & DUG WELL 4/5/58 CWL

I, HEREBY, APPLY FOR THE NECESSARY TESTS IN ORDER TO CONSTRUCT (OR RECONSTRUCT) A SEWAGE DISPOSAL SYSTEM.

PROPERTY OWNER Lillie and Clarence Anderson

ADDRESS Route 97 Glenwood, Md.

PHONE _____

PROPERTY LOCATION:

SUBDIVISION _____

LOT NO. _____

ROAD AND DESCRIPTION Route 97 Lot is on the right hand side across from
the colored church right out of Glenwood.

OCCUPANT _____

PHONE _____

PERSON TO CONSTRUCT SYSTEM _____

ADDRESS _____

PHONE _____

SIZE OF LOT 1 acre

TYPE BLDG. 2

NUMBER OF BEDROOMS

IF NOT SINGLE RESIDENCE DESCRIBE _____

SIGNATURE OF APPLICANT X. Roland Pinkney

APPROVED BY Raymond Hodges

FOR _____

(KIND OF SYSTEM)

DATE 12/1/60

REJECTED BY _____

FOR _____

(KIND OF SYSTEM)


DATE _____

HOLD PENDING FURTHER TESTS BH

DATE 11/23/60

REASONS FOR REJECTION OR HOLDING percolation on only 1 hole for tile field

THIS IS NOT A PERMIT

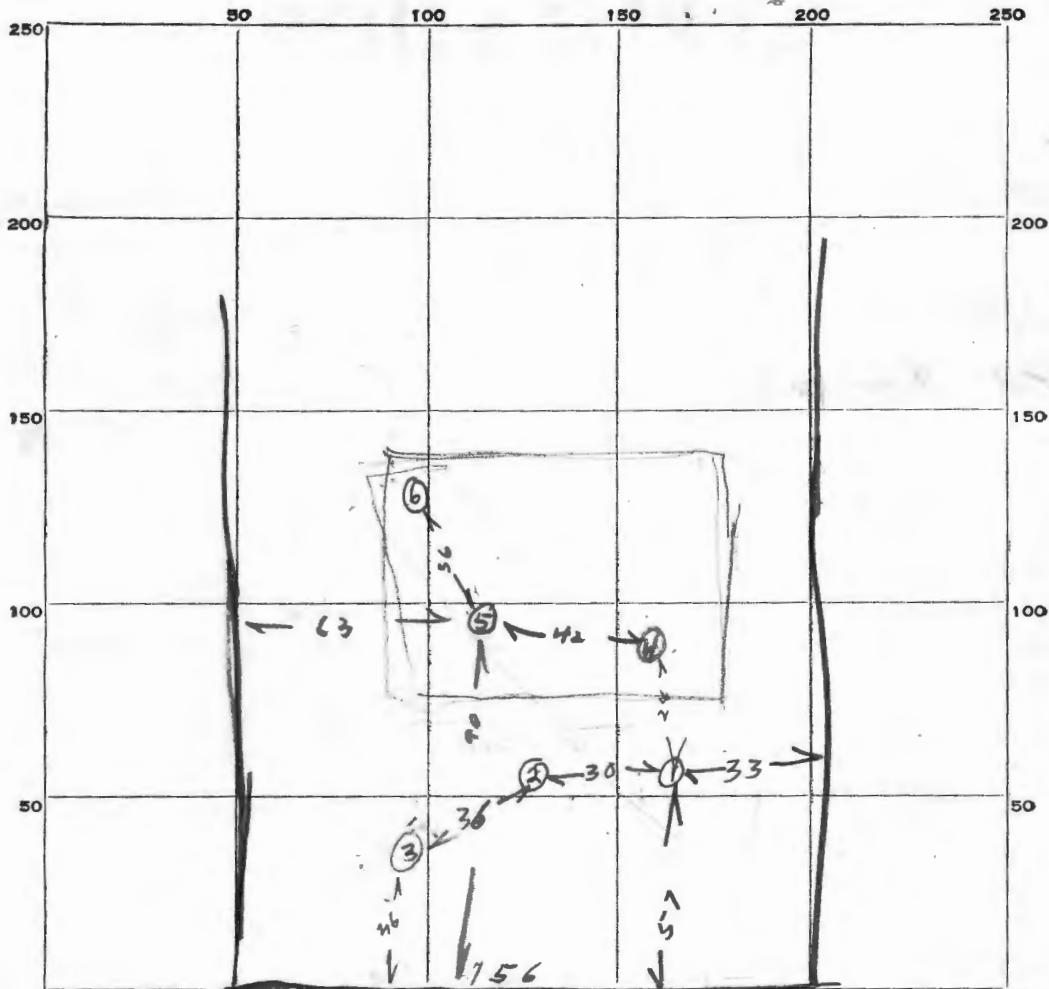

INDICATE NORTH. - NAME ADJOINING ROADWAY AS BASE LINE.

RT # 97

TO RT # 144 →

DATE	TEST NO.	DEPTH	PRE-WET		TEST - 1" DROP		TIME
			START	STOP	START	STOP	
11/23/60	1	2 1/2	943	959	959	1024	25 min
"	2	3	1052	1134	little perc		
"	3	3	1104	1134	little perc		
12/1/60	4	3	946	1026	1026	1st inch = 40 min	
"	5	3	949	958	958	1025	27 min
"	6	3	953	1010	1010	1030	20 min

33
42
76

9'

SOIL AUGER FINDING

11/23/60 TESTED BY Raymond Hodges 12/1/60

11/23/60 REMARKS Roland Pirchney 12/1/60 Roland Pirchney

ALSO PRESENT

LOT NO.

STATE OF MARYLAND

HOWARD COUNTY HEALTH DEPARTMENT ELLICOTT CITY, MARYLAND

Date 11/19/60 19

Name Clarence Anderson

Telephone No. —

DETAILED LOCATION OF SITE, DEVELOPMENT,
SECTION, ROAD, LOT NO. & ELECTION DISTRICT

Rt 97, # Kenwood

PRIVATE SEWAGE DISPOSAL SYSTEMS

Testing and Inspection

\$ 10.⁰⁰

Installation Permit

\$ —

Received
Payment

Palmer F. Wine

A03204
DUPLICATE

THIS RECEIPT IS NOT
A PERMIT AND IT IS
NOT A WARRANTY OF
PERFORMANCE OF
THE SYSTEM THAT
IS INSTALLED

STATE OF MARYLAND

HOWARD COUNTY HEALTH DEPARTMENT

ELLCOTT CITY, MARYLAND

Date

11/19/60

19

Name

Charles Anderson

Telephone No.

—

DETAILED LOCATION OF SITE, DEVELOPMENT,
SECTION, ROAD, LOT NO. & ELECTION DISTRICT

Rt 77, * Kenwood

PRIVATE SEWAGE DISPOSAL SYSTEMS

Testing and Inspection

\$

10.⁰⁰

Installation Permit

\$

Received
Payment

Palmer F. Wone

A03204
TRIPLICATE

THIS RECEIPT IS NOT
A PERMIT AND IT IS
NOT A WARRANTY OF
PERFORMANCE OF
THE SYSTEM THAT
IS INSTALLED