

4/30/81  
1:30 P.M.  
Prel

# APPLICATION

SEWAGE DISPOSAL TESTING

STATE OF MARYLAND - DEPARTMENT OF HEALTH AND MENTAL HYGIENE

HOWARD COUNTY HEALTH DEPARTMENT  
ENVIRONMENTAL HEALTH SERVICES  
P. O. BOX 473 ELLICOTT CITY, MARYLAND 21043  
TELEPHONE: 992-2330

A 31345  
P \_\_\_\_\_  
DISTRICT 5th.  
DATE 4/28/81

TO: THE COUNTY HEALTH OFFICER  
ELLICOTT CITY, MARYLAND

I, HEREBY, APPLY FOR THE NECESSARY TEST IN ORDER TO CONSTRUCT (OR RECONSTRUCT) A SEWAGE DISPOSAL SYSTEM.

PROPERTY OWNER Shirley P Smith.

ADDRESS 11330 Johns Hopkins Rd Clarksville PHONE 621 1119.

PROPERTY LOCATION: 11330 Johns Hopkins Rd Clarksville MD

SUBDIVISION \_\_\_\_\_ LOT NO. 40

ROAD AND DESCRIPTION Hopkins Way - Off Johns Hopkins Road

SIZE OF LOT 3.5 acres m/d TYPE BLDG. 2-3  
(NUMBER OF BEDROOMS)

THE SYSTEM INSTALLED UNDER THIS APPLICATION IS ACCEPTABLE ONLY UNTIL PUBLIC FACILITIES BECOME AVAILABLE. I FULLY UNDERSTAND THE

FEE CONNECTED WITH THE FILING OF THIS PERC TEST APPLICATION IS NON-REFUNDABLE UNDER ANY CIRCUMSTANCES. I ALSO AGREE TO COMPLY

WITH ALL M.O.S.H.A. REQUIREMENTS IN TESTING THIS LOT. Russell B Smith + Shirley P. Smith  
(SIGNATURE OF APPLICANT)

APPROVED BY \_\_\_\_\_ FOR \_\_\_\_\_ DATE \_\_\_\_\_

REJECTED BY \_\_\_\_\_ FOR \_\_\_\_\_ DATE \_\_\_\_\_

HOLD PENDING FURTHER TESTS \_\_\_\_\_ DATE \_\_\_\_\_



REASONS FOR REJECTION OR HOLDING 4/30/81 more tests water

## THIS IS NOT A PERMIT

Skinner  
130 Thurs.

HUBBARD - 27

SOIL PROFILE

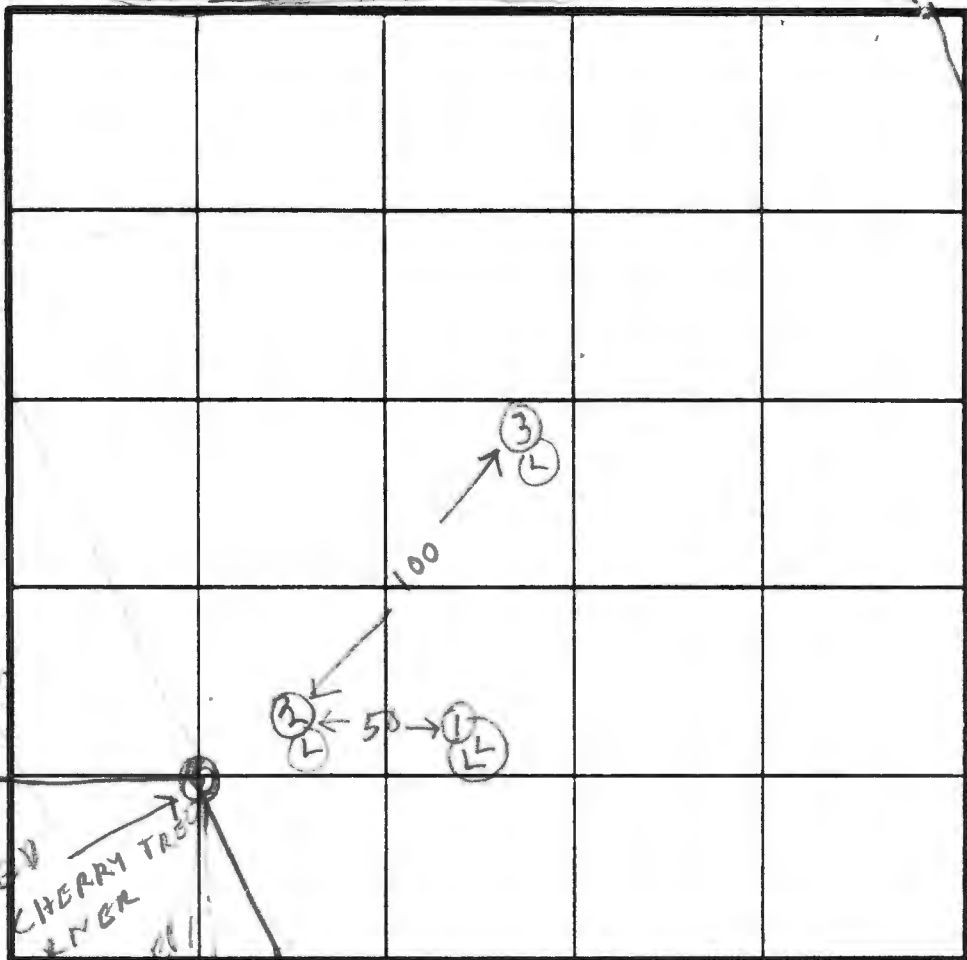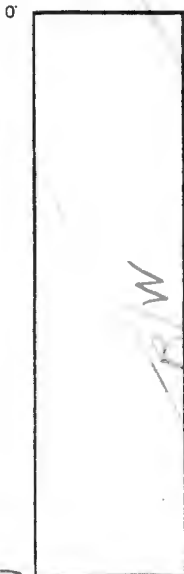

156.50

374

BIG BLAZED  
DEAD CHERRY TREE  
IS CORNER  
MARK

INDICATE NORTH - NAME ADJOINING ROADWAY AS BASE LINE.

DATE	TEST NO.	DEPTH	PRE-WET		TEST - 1" DROP		TIME
			START	STOP	START	STOP	
4/30/01	1V	9	TOP 4 FT CLAY		BOT 5 FT SANDY		WATER 8 FT
	2S	4 1/2	206	208	208	215	11
	2D	8	228	234	234	249	14
	2V	14	TOP 3 FT CLAY		BOT 11 FT SANDY MICA		
	3S	3	339	340	340	342	2
	3D	8	346	350	350	358	12
	3V	14	ALL SAND		WATER 12 1/2 FT		

# APPLICATION

SEWAGE DISPOSAL TESTING

STATE OF MARYLAND - DEPARTMENT OF HEALTH AND MENTAL HYGIENE

HOWARD COUNTY HEALTH DEPARTMENT  
ENVIRONMENTAL HEALTH SERVICES  
P. O. BOX 473 ELLICOTT CITY, MARYLAND 21043  
TELEPHONE: 992-2330

A 31345

P \_\_\_\_\_

DISTRICT 5th

DATE 4/28/81

TO: THE COUNTY HEALTH OFFICER  
ELLICOTT CITY, MARYLAND

I, HEREBY, APPLY FOR THE NECESSARY TEST IN ORDER TO CONSTRUCT (OR RECONSTRUCT) A SEWAGE DISPOSAL SYSTEM.

PROPERTY OWNER Shirley P Smith

ADDRESS 11330 Johns Hopkins Rd Clarksville PHONE 621 1119

PROPERTY LOCATION: 11330 Johns Hopkins Rd Clarksville MD.

SUBDIVISION \_\_\_\_\_ LOT NO. 40

ROAD AND DESCRIPTION Hopkins Way - off of Johns Hopkins Road

SIZE OF LOT 3.5 acres m/l TYPE BLDG. 2-3  
(NUMBER OF BEDROOMS)

THE SYSTEM INSTALLED UNDER THIS APPLICATION IS ACCEPTABLE ONLY UNTIL PUBLIC FACILITIES BECOME AVAILABLE. I FULLY UNDERSTAND THE

FEE CONNECTED WITH THE FILING OF THIS PERC TEST APPLICATION IS NON-REFUNDABLE UNDER ANY CIRCUMSTANCES. I ALSO AGREE TO COMPLY

WITH ALL M.O.S.H.A. REQUIREMENTS IN TESTING THIS LOT.

Russell B Smith Shirley P. Smith  
(SIGNATURE OF APPLICANT)

APPROVED BY \_\_\_\_\_ FOR \_\_\_\_\_ DATE \_\_\_\_\_

REJECTED BY \_\_\_\_\_ FOR \_\_\_\_\_ DATE \_\_\_\_\_

HOLD PENDING FURTHER TESTS \_\_\_\_\_ DATE \_\_\_\_\_

REASONS FOR REJECTION OR HOLDING \_\_\_\_\_

# THIS IS NOT A PERMIT

35



S. H. WALKER  
731830 (373/154)  
16.85A  
P.158

LEO. E. MCKENZIE  
412/704  
646/297  
P.157  
4-26/53

S. COCHRAN  
290/237  
10.22A  
P.148

VOGEL FARM PARTNERSHIP  
868/71  
192.24A.  
P.44

HOWARD RESEARCH  
413/1  
107.99  
P.45

ANTHONY JEAN-CARNEY  
807/107  
720/702  
5.29A  
P.370

R.M. CARNEY  
720/702  
5.29A  
P.370

K.W. CARLSON  
754/224  
B.18A.  
P.406

K.W. CARLSON  
751/95  
B.03A.  
P.379

E.S. PARLETTE  
P.68 485/73

JAMES E. JORDAN  
710/369  
5.45A  
P.373

B.J. CREVILLA, JR. ET AL.  
802/442  
52.10A.  
P.47

E.W. HAWTHORNE  
959/228  
S.13A.  
P.36

G.L. HAMLIN  
636/212  
6.80A.  
P.79

WARFEL  
845/421  
S.00A.  
P.391

L.D. TUBBS  
753/658  
7.03A  
P.375

K.W. CARLSON  
751/119  
7.37A.  
P.383

JAMES E. JORDAN  
710/369  
5.45A  
P.373

JOHNS HOPKINS UNIV.  
450/283, 710/351  
64.52A  
P.49

JOHNS HOPKINS UNIV.  
237/541  
20.45A.  
P.51

JOHNS HOPKINS UNIV.  
234/304  
76.86A.  
P.50

JOHNS HOPKINS UNIV.  
400/625  
80.70A.  
P.289

H.W. WESSELL JR., ET. AL.  
870/206  
87.26A.  
P.124

J.N. EV. TRUSTEES  
74C  
4E  
P

FLAME WOOD SEC. 1  
P.399

FLAME WOOD SEC. 1  
P.412

FLAME WOOD SEC. 1  
P.422

FLAME WOOD SEC. 1  
P.428

FLAME WOOD SEC. 1  
P.429

FLAME WOOD SEC. 1  
P.430

FLAME WOOD SEC. 1  
P.431

FLAME WOOD SEC. 1  
P.432

FLAME WOOD SEC. 1  
P.433

FLAME WOOD SEC. 1  
P.434

C. E. IAGER, ETAL  
894/593

GRAVEL EST. P. 113

BERNARD G. MAULK  
180/251  
10.50A  
P.119

JOHNS HOPKINS UNIV.  
234/336, 398/244  
127.98A.  
P.125

JOHNS HOPKINS UNIV.  
234/304  
76.86A.  
P.50


JOHNS HOPKINS UNIV.  
400/625  
80.70A.  
P.289

JOHNS HOPKINS UNIV.  
237/541  
20.45A.  
P.51

JOHNS HOPKINS UNIV.  
450/283, 710/351  
64.52A  
P.49

H.W. WESSELL JR., ET. AL.  
870/206  
87.26A.  
P.124

J.N. EV. TRUSTEES  
74C  
4E  
P

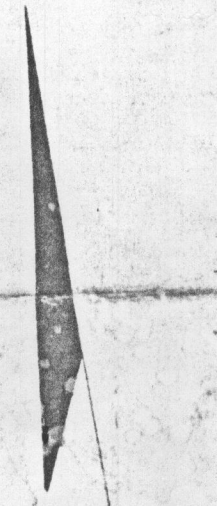

G.L. Hamilton  
636/218

J. Oliver Arrington  
109/294

Future Well

88°42'30"E - 186.90'

576°05'E - 374'

Hopkins Way  
N17°03'30"E - 447.10'  
10' Right-of-Way for Ingress & Egress  
H.B.N. 199/294  
177.75'

50' Right-of-Way  
For Ingress & Egress  
H.B.N. 199/294

N86°50'W - 285.78'

Stone  
N86°50'W - 16'

509°25'W - 318.16'

J. Oliver Arrington  
109/294

2 Story Dwelling

Concrete Swimming Pool

30' Right-of-Way  
For Ingress & Egress  
J.H.O. 79/606

To Johns Hopkins Rd.

Donald L. Simpson  
381/358

**CROVO & ASSOCIATES, INC.**

CIVIL ENGINEERING  
LAND SURVEYING

866AK ROAD  
BALTIMORE, MARYLAND  
21234

Walter Park, L.S., Md. Reg. No. 5399  
July 18, 1977  
Date

PROPERTY OF  
**NELSON E. YATES**

5TH ELECTION DISTRICT  
JULY 17, 1977  
HOWARD COUNTY, MARYLAND  
SCALE: 1" = 50'