

APPLICATION

A 05622

P _____

SEWAGE DISPOSAL TESTING

MARYLAND STATE DEPARTMENT OF HEALTH

HOWARD COUNTY

ELLICOTT CITY

Septic Tank - 1000 gals

DISTRICT _____

Dry Well - 624 sq ft absorbent sidewall area below the inlet pipe.

DATE 8/14/62

Place Dry Well about 57 ft from Owen Brown Rd and about 42 ft from right side of lot (side furthest from Route 29)

Two Dry Wells each being 10 ft diameter & 10 ft deep below the inlet pipe is suggested. If two 11' by 11' ft. dry wells are used they must be 30 ft apart from edge to edge & each dry well to be connected separately to a distribution box.

I, HEREBY, APPLY FOR THE NECESSARY TESTS IN ORDER TO CONSTRUCT (OR RECONSTRUCT) A SEWAGE DISPOSAL SYSTEM.

PROPERTY OWNER

Andrew Valenzia

ADDRESS

Owen B 30 Orchard Drive E.C.

PHONE

405-1342

PROPERTY LOCATION:

SUBDIVISION

LOT NO.

B.

ROAD AND DESCRIPTION

Owen Brown Rd - 1/4 mile from Rt 29 on left going west.

OCCUPANT

PHONE

PERSON TO CONSTRUCT SYSTEM

ADDRESS

PHONE

SIZE OF LOT

(approx) 500' X 200'

TYPE BLDG.

NUMBER OF BEDROOMS

4

IF NOT SINGLE RESIDENCE DESCRIBE

SIGNATURE OF APPLICANT

Andrew Valenzia

APPROVED BY

Donald W. Monaghan

FOR

Dry well

(KIND OF SYSTEM)

DATE

8-17-62

REJECTED BY

FOR

(KIND OF SYSTEM)


DATE

HOLD PENDING FURTHER TESTS

DATE

REASONS FOR REJECTION OR HOLDING

THIS IS NOT A PERMIT

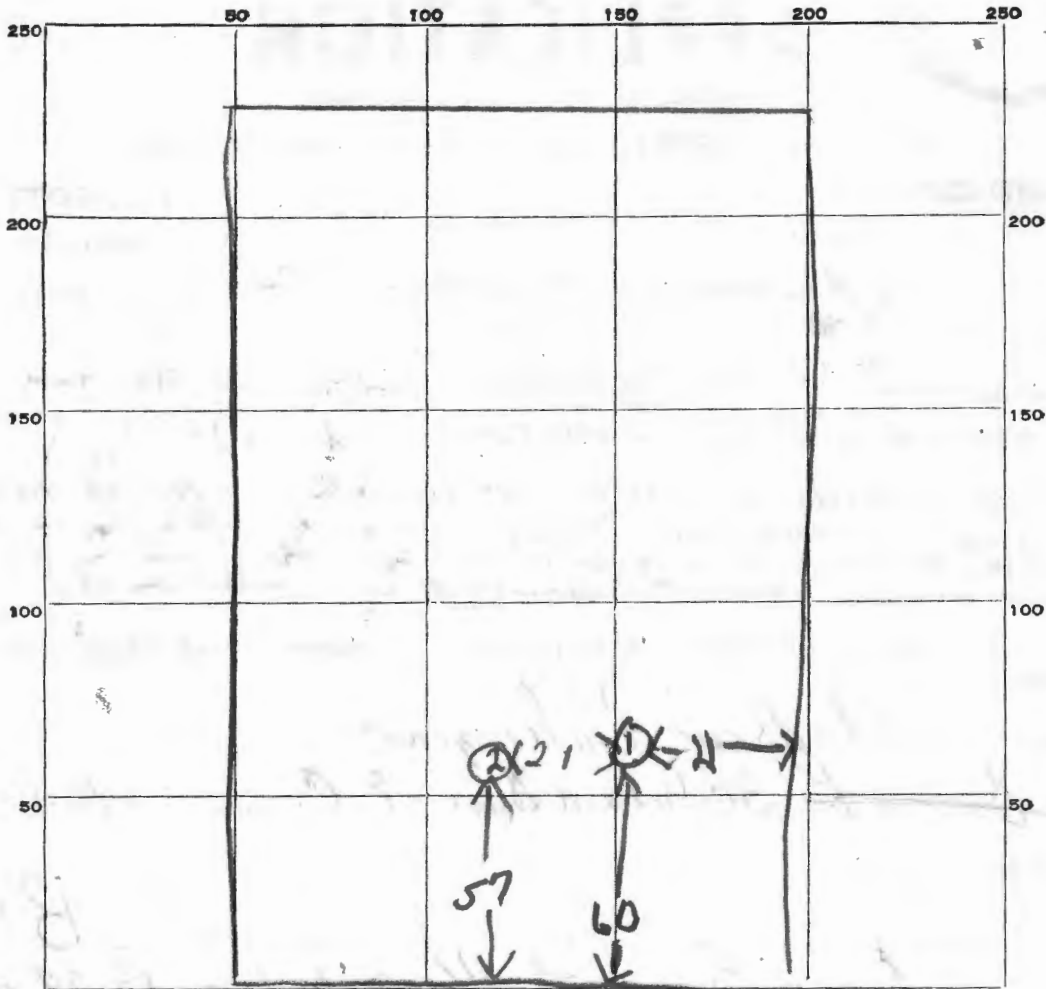

DATE	TEST NO.	DEPTH	PRE-WET		TEST - 1" DROP		TIME
			START	STOP	START	STOP	
3-11-17	1	8 1/2	158	stop test	hole covered in.		
	2	9	222	232	232	250	18 min

SOIL AUGER FINDING _____

TESTED BY Dunn 8-17-12

REMARKS _____

ALSO PRESENT E. Palmer LOT NO. B- finished from RT 159