

APPLICATION

A 27764

P _____

SEWAGE DISPOSAL TESTING

STATE OF MARYLAND - DEPARTMENT OF HEALTH AND MENTAL HYGIENE

DISTRICT 5

HOWARD COUNTY HEALTH DEPARTMENT
ENVIRONMENTAL HEALTH SERVICES

DATE 4/4/78

P O BOX 476, ELLICOTT CITY, MARYLAND 21043
TELEPHONE 465-5000 EXT. 356

Cancelled

Septic Tank - 1000 gal.

*Dry Well - 125 sq ft absorbent sidewall area per bedroom
to begin below the first 3 ft of original grade. Max depth permitted
for well is 10 ft below original grade.*

*Place Dry Well 400 ft from the lot & property line and
300 ft from the 679. to line*

TO THE COUNTY HEALTH OFFICER
ELLICOTT CITY, MARYLAND

I HEREBY APPLY FOR THE NECESSARY TEST IN ORDER TO CONSTRUCT (OR RECONSTRUCT) A SEWAGE
DISPOSAL SYSTEM.

PROPERTY OWNER WARFEL, C. DAVE SEALING (CONTRACT)

ADDRESS 7418 Cherry Tree Dr Fulton, Md 20759 PHONE 498 0926

PROPERTY LOCATION

SUBDIVISION NONE - WARFEL PROPERTY LOT NO. 1

ROAD AND DESCRIPTION PINDELL SCHOOL Rd

Next to Semans Nursing Home

SIZE OF LOT 9 ACRES TYPE BLDG. 3
NUMBER OF BEDROOMS

IF NOT SINGLE RESIDENCE DESCRIBE _____

THE SYSTEM INSTALLED UNDER THIS APPLICATION IS ACCEPTABLE ONLY UNTIL PUBLIC
FACILITIES BECOME AVAILABLE.

SIGNATURE OF APPLICANT Charles D. Sealing

APPROVED BY Laura Giller FOR Dry well DATE 4/27/78
(KIND OF SYSTEM)

REJECTED BY _____ FOR _____ DATE _____
(KIND OF SYSTEM)


HOLD PENDING FURTHER TESTS _____ DATE _____

REASONS FOR REJECTION OR HOLDING Hold for certified test hole
Locations.

THIS IS NOT A PERMIT

1-2' clayey
Sandy
Very
Porous

12'
Pindell School Rd.

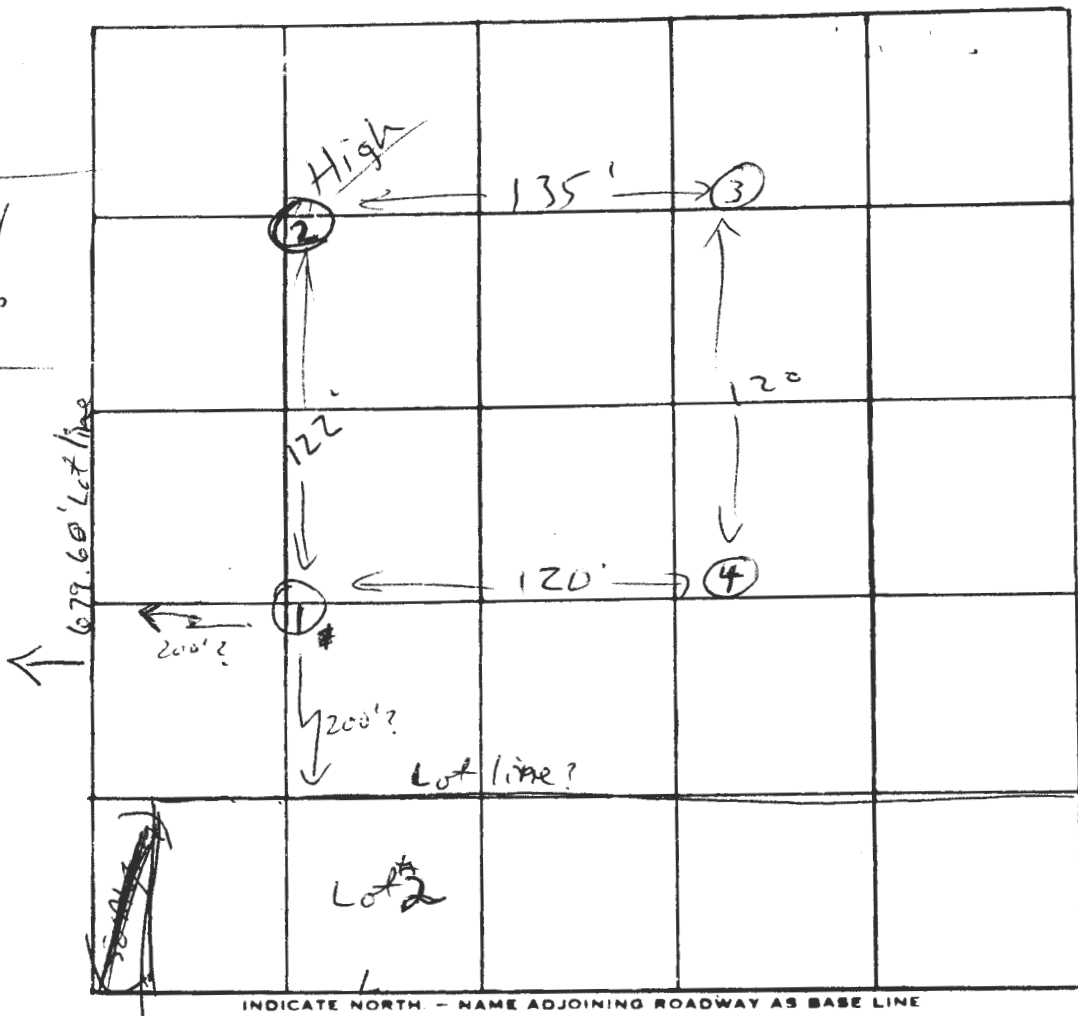

DATE	TEST NO.	DEPTH	PRE-WET		TEST - 1" DROP		TIME
			START	STOP	START	STOP	
4/27	1 S	3'	2:26	2:28	2:28	2:31	3 mm.
"	1 D	13'	2:25	2:27	2:27	2:30	3
"	2 S	4'	2:33	2:34	2:34	2:35	1
"	2 P	10.5	2:34	2:35	2:35	2:39	4
"	3	Visual sandy soil to 14'					
"	4 S	4.5	2:43	2:44	2:44	2:47	3
"	4 D	12'	2:43	2:48	2:48	2:55	8

REMARKS Mr. Fyock told to have holes certified

TYPE OF SOIL Predominately Sandy

TESTED BY L. Spilker ALSO PRESENT: D. Mangham
J. Fyock

HOWARD COUNTY HEALTH DEPARTMENT

JOYCE M. BOYD, M.D., M.P.H.
DEPUTY STATE AND
COUNTY HEALTH OFFICER



P.O. BOX 476
ELLCOTT CITY, MARYLAND 21043
TELEPHONE 465-5000

TO WHOM IT MAY CONCERN:

I fully understand the fee connected with the filing of this
perc test application is non-refundable under any circumstances.

Charles D. Serling
Signature

4/4/28
Date

April 28, 1978

Mr. Charles D. Sealing
7418 Cherry Tree Drive
Fulton, Md. 20759

Dear Mr. Sealing:

This is to inform you that Lots #1 and #2, the Warfel property on Pindell School Road, have passed a standard percolation test. Your applications are now being held in our office pending receipt of a plat showing the field located test pits. We want to receive this within two (2) weeks.

Very truly yours,

Lawrence Spilker,
Sanitarian

LS:dg

Please
file

May 10, 1978

Lawrence Spilker,
Sanitarian
Howard County Health Department
Ellicott City, Maryland 21043

Re: Lots #1 and #2
Warfel Property

Dear Mr. Spilker,

I have received your request for a plat showing the field location of the test pits. This information is being prepared by my engineer Boender Associates and will be forwarded to your attention upon completion. If I can be of further assistance, please advise.

Very truly yours,

Charles D. Sealing
Charles D. Sealing

cc. Boender Associates

June 19, 1978

Lawrence Spilker
Sanitarian
Howard County Health Department
Ellicott City, Maryland 21043


Re: Lots #1 and #2
Warfel Property

Dear Mr. Spilker,

After checking with my engineer on the status of the plat you requested on the test pit location, I find that these have not been completed due to his heavy workload. In addition, I have been advised that the pending Board of Appeals Case on this property is not scheduled until July 27, 1978.

Your consideration in delaying the requirement for these plats until the pending Board of Appeals hearing is completed would be appreciated. Should you desire these plats prior to the hearing date, please advise. Thank you for your consideration.

Very truly yours,

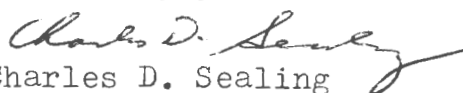
Charles D. Sealing

cc. Boender Associates

BALTIMORE DIVISION INC.
SUITE 102-107 TOWN & COUNTRY PROFESSIONAL BUILDING
ELLICOTT CITY, MARYLAND 21043
BALTIMORE 301-465-7777

TO: []

Howard County Department
of Environmental Health
The Ligon Building
Ellicott City, Maryland 21043

DATE: December 20, 1978

ATTENTION: Mr. Don Monaghan

RE: Warfel Property - Lots 1 and 2

-GENTLEMEN:

- WE ARE SENDING YOU ATTACHED UNDER SEPARATE COVER VIA _____ THE FOLLOWING ITEMS:
- SHOP DRAWINGS PRINTS PLANS SAMPLES SPECIFICATIONS
- COPY OF LETTER _____

copies	date or no.	description
1	7822	Original percolation test plat

THESE ARE TRANSMITTED AS CHECKED BELOW:

- FOR APPROVAL APPROVED AS SUBMITTED RESUBMIT _____ COPIES FOR APPROVAL
- FOR YOUR USE APPROVED AS NOTED SUBMIT _____ COPIES FOR DISTRIBUTION
- AS REQUESTED RETURNED FOR CORRECTIONS RETURN _____ CORRECTED PRINTS
- FOR REVIEW AND COMMENT signature _____
- FOR BIDS DUE _____ 19 _____ PRINTS RETURNED AFTER LOAN TO US

REMARKS:

If you have any questions relevant to the attached plat, please do not hesitate to contact the office at your earliest convenience.

COPIES:

IF ENCLOSURES ARE NOT AS NOTED, KINDLY NOTIFIED US AT ONCE.

SIGNED: Jean Silvers

