

Bureau of Environmental Health
 8930 Stanford Boulevard, Columbia, MD 21045
 Main: 410-313-2640 | Fax: 410-313-2648
 TDD 410-313-2323 | Toll Free 1-866-313-6300
www.hchealth.org
 Facebook: www.facebook.com/hocohealth

Maura J. Rossman, M.D., Health Officer

RECEIPT DATE: 11/14/22 **ONSITE SEWAGE DISPOSAL SYSTEM** P 572687

APPROVAL DATE: 2/16/2023 **PERMIT:** REPAIR A _____

PROPERTY ADDRESS: 14155 Burntwoods Road

SUBDIVISION: _____ LOT: _____ TAX ID: _____

CONTRACTOR: Fogle's Septic Clean Inc. EMAIL: kim@foglesinc.com

CONTRACTOR ADDRESS: 580 Obrecht Road, Sykesville, MD 21784 PHONE: 410-795-5670

PROPERTY OWNER: Gethsemane Baptist Church EMAIL: _____

OWNER ADDRESS: 14135 Burntwoods Road, Glenwood, MD 21738 PHONE: _____

SEPTIC TANK SIZE (GALLONS): _____ TANK MANUFACTURER: _____

PUMP MODEL: _____ PUMP SIZE _____ PUMP TANK CAPACITY: _____

DISTRIBUTION SYSTEM: GRAVITY PRESSURE DOSED BEDROOMS: _____ APPLICATION RATE: _____


TRENCHES:	LINEAR FEET REQUIRED: _____	INLET DEPTH: _____
	TRENCH WIDTH: _____	MAXIMUM BOTTOM DEPTH: _____
	MINIMUM SPACE BETWEEN TRENCHES: _____	EFFECTIVE AREA BEGINNING DEPTH: _____
LOCATION:	PER APPROVED SITE PLAN. SEWAGE DISPOSAL AREA AND TANK LOCATIONS MUST BE STAKED BY LICENSED SURVEYOR PRIOR TO PRE-CONSTRUCTION INSPECTION.	
NOTES:		

ISSUED BY: _____ ISSUE DATE: _____ EXPIRATION DATE: _____

- NOTE: **CONTRACTOR MUST SCHEDULE A PRE-CONSTRUCTION INSPECTION PRIOR TO BEGINNING ANY INSTALLATION**
- NOTE: CONTRACTOR MUST SCHEDULE AN INSPECTION AND GAIN APPROVAL OF ALL COMPONENTS PRIOR TO COVERING
- NOTE: STONE MUST BE APPROVED BY HEALTH DEPARTMENT AND GRAVEL TICKET MUST BE AVAILABLE FOR REVIEW.
- NOTE: WATERTIGHT TANKS REQUIRED
- NOTE: ALL PARTS OF SEPTIC SYSTEM SHALL BE AT LEAST 100 FEET DOWNGRADIENT FROM ANY WATER WELL
- NOTE: MANHOLE RISERS REQUIRED ON ALL SEPTIC TANKS AND PUMP CHAMBERS
- NOTE: **AN ELECTRICAL PERMIT IS REQUIRED FOR INSTALLATION OF ANY ELECTRICAL COMPONENTS OF THE SYSTEM**
- ELECTRICAL PERMIT ISSUED E _____
- NOTE: **MDE RECOMMENDS SEPTIC TANKS, BAT, AND OTHER PRETREATMENT UNITS BE PUMPED AT A FREQUENCY ADEQUATE TO ENSURE THAT SOLIDS ARE NOT DISCHARGED TO THE DISPOSAL AREA**

NEITHER THE HOWARD COUNTY COUNCIL NOR THE HEALTH DEPARTMENT IS RESPONSIBLE FOR THE SUCCESSFUL OPERATION OF ANY SYSTEM. PERMITTEE RESPONSIBLE FOR OBTAINING FINAL APPROVAL ON THIS PERMIT. CALL 410-313-1771 TO SCHEDULE INSPECTIONS.

NOT TO SCALE

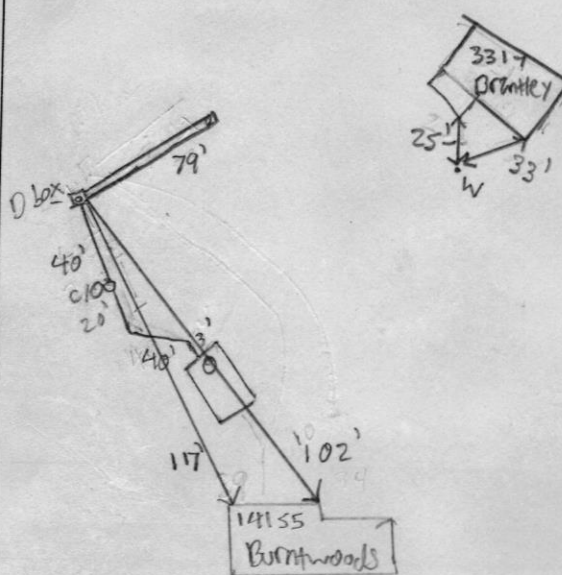

TRENCH/DRAINFIELD DATA

WIDTH	INLET	BOTTOM
3'	3'	9'
NUMBER OF TRENCHES 1		
TOTAL LENGTH 79		
ABSORPTION AREA 237		
DISTRIBUTION BOX LEVEL -		
DISTRIBUTION BOX BAFFLE yes		
DISTRIBUTION BOX PORT yes		

SEPTIC TANK DATA

SEPTIC TANK 1 LEVEL N/A

MANUFACTURER _____

CAPACITY _____ GAL

SEAM LOC _____

TANK LID DEPTH _____

BAFFLES _____

BAFFLE FILTER _____

MANHOLE LOC _____

6" PORT LOC _____

WATERTIGHT TEST _____

SLOTTED _____

DATE ON LID _____

PUMP/SEPTIC TANK LEVEL N/A

MANUFACTURER _____

CAPACITY _____ GAL

SEAM LOC _____

TANK LID DEPTH _____

BAFFLES _____

BAFFLE FILTER _____

MANHOLE LOC _____

6" PORT LOC _____

WATERTIGHT TEST _____

SLOTTED _____

DATE ON LID _____

Burntwoods Rd
ROAD NAME

PRE-CONSTRUCTION:

INSTALLATION: 7/16/2023 - contractor added new risers @ back of tank. Contractor also added Bullrun valve. So prior trenches wouldn't take any more solids. D box w/ pathole installed. Trench @ 79' & 3' inlet & 3' width. Gave contractor OK to backfill. Weather conditions were lots of rain. Also located well @ 3317 Brentley (SP)

FINAL INSPECTOR Shepsura Page DATE OF APPROVAL 2/16/2023

Howard County Health Department

Bureau of Environmental Health, Columbia, MD 21045 - 410-313-1771

SEWAGE DISPOSAL PERMIT NO. A- _____ P- 572687

RESIDENTIAL PERMIT
(NUMBER OF BEDROOMS: _____)

COMMERCIAL PERMIT
(DESIGN FLOW: _____ GPD)

PERMITEE: Fogles Septic Clean Inc.

LOCATION: 4495 Burntwoods Road

****POST THIS CARD WHERE IT CAN BE SEEN FROM ROAD****

STOP ALL CONSTRUCTION ON SEWAGE DISPOSAL SYSTEM AND CONTACT HEALTH DEPARTMENT BEFORE CONTINUING

Inspector Date

WORK IS SATISFACTORY, OK TO CONTINUE

Inspector Date

COMMENTS: _____

FINAL INSPECTION MADE, OK TO COVER ALL WORK

Inspector Date

4/2/84
mid-afternoon

approved
4/2/84
C. Callahan

PERMIT

P 33718
A 32949

SEWAGE DISPOSAL SYSTEM

MARYLAND STATE DEPARTMENT OF HEALTH*

HOWARD COUNTY
BUREAU OF ENVIRONMENTAL HEALTH
992-2330

INDEXED

04-343107

ELLICOTT CITY
DISTRICT 4th.
DATE 3/22/84

Robert L. Orndorff IS PERMITTED TO INSTALL X ALTER _____

ADDRESS 7469 Glanewood Drive, Clarksville, Maryland PHONE 776-0444

SUBDIVISION Brantly ROAD 14155 Burntwoods Road LOT 29

PROPERTY OWNER Joseph Morris

ADDRESS 1100 Annapolis Junction Road
Annapolis Junction, Maryland 20701

IF GARBAGE GRINDER IS USED INCREASE SEPTIC TANK CAPACITY BY 50% AND ABSORPTION AREA BY 22%.

GARBAGE GRINDER? YES X NO _____

SEPTIC TANK CAPACITY 2000 GALLONS NUMBER OF BEDROOMS 4

TRENCHES - 193 sq. ft. absorbent area per bedroom. Trench to be 2 ft. wide, Inlet 3 feet below original grade. Bottom maximum depth 10 feet below original grade. Effective area begins at 3 feet below original grade with 7 feet of stone below distribution pipe.

LOCATION: Start the trench 250 feet from the front lot line and 80 feet from the left side line as seen when facing the lot from Burntwoods Road. If trench issued, run the trench on level ground the necessary distance. NOTES: No trench to exceed 100 feet in length. If more than one trench used, a distribution box is required. Call for inspection of trench - before and after gravel is installed. Provide 6"-8" diameter cleanout and cap to grade or above on septic tank.

PLANS APPROVED BY Frank Skinner DATE 1/21/84

COVER NO WORK UNTIL INSPECTED AND APPROVED.

NEITHER THE HOWARD COUNTY COUNCIL NOR THE HEALTH DEPARTMENT IS RESPONSIBLE FOR THE SUCCESSFUL OPERATION OF ANY SYSTEM.

NOTE: IF TRENCH IS USED CALL FOR INSPECTION BEFORE AND AFTER PLACING GRAVEL IN TRENCH.

NOTE: NO DRY WELL SHALL EXCEED 15 FOOT IN DIAMETER. NO ABSORPTION TRENCH TO EXCEED 100 FEET IN LENGTH.

NOTE: ALL PIPE FROM HOUSE TO SEPTIC TANK MUST BE CAST IRON OR SCHEDULE 40 PVC OR ABS.

PERMIT VOID AFTER THREE YEARS.


NOTE: INSTALL STAND PIPE ON SEPTIC TANK AND DRY WELL. STAND PIPES MUST BE 6 INCHES IN DIAMETER. CAST IRON, CONCRETE OR TERRA COTTA, OR PVC OR ABS ACCEPTED. IF TOP OF SEPTIC TANK IS DEEPER THAN 3 FEET MANHOLE TO GRADE REQUIRED.

***INSTALLER IS RESPONSIBLE FOR OBTAINING FINAL APROVAL ON THIS PERMIT**

*CALL 992-2330 FOR INSPECTION OF SEPTIC SYSTEMS.

EH - 2-1082

A 32949

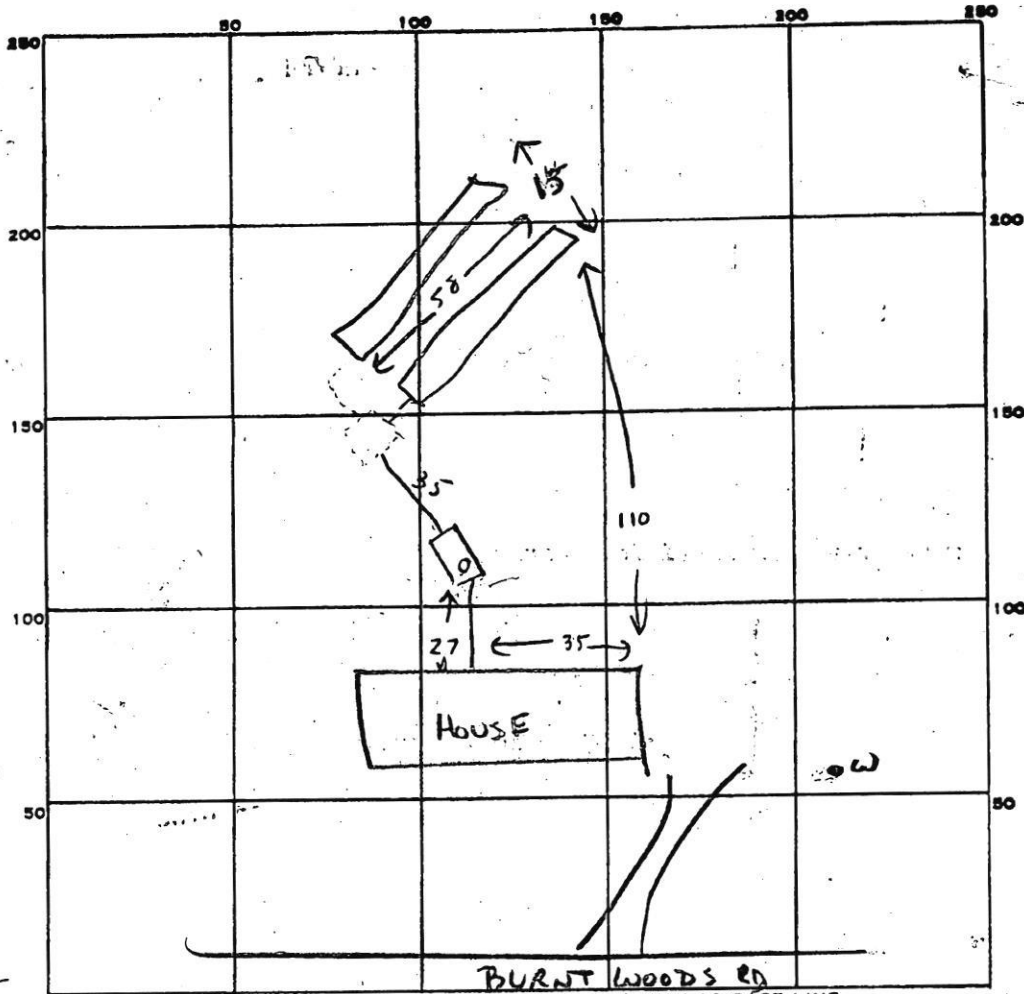

INDICATE NORTH. - NAME ADJOINING ROADWAY AS BASE LINE.

3 1
 193
 4
 7 772
 110

 193 120
 6 52 7720-1
 2965
 28122
 430
 116
 812

PERMIT CARD

SEPTIC TANK, LEVEL 2000

CLEANOUTS

DISTRIBUTION BOX, LEVEL

TILE FIELD, DEPTH 10 FT. TRENCH WIDTH 2 FT.

GRAVEL DEPTH 17 FT. TOTAL LENGTH 58 x 2 = 116 FT.

NUMBER OF TRENCHES 2 ONE SIDEWALL TOTAL BOTTOM AREA 812

SEEPAGE PITS, INSIDE DIAMETER _____ FT. DEPTH BELOW INLET _____ FT.

ABSORBENT AREA 812 SQ. FT.

REMARKS _____

DATE SYSTEM APPROVED 4/2/84

INSPECTOR CWILLIAMS