

7/1/83
932

APPLICATION

A 32949
P _____

SEWAGE DISPOSAL TESTING

STATE OF MARYLAND - DEPARTMENT OF HEALTH AND MENTAL HYGIENE

HOWARD COUNTY HEALTH DEPARTMENT
ENVIRONMENTAL HEALTH SERVICES
P.O. BOX 476 ELLICOTT, MARYLAND 21043
TELEPHONE: 992-2330

DISTRICT 4TH

DATE 6-27-83

TO: THE COUNTY HEALTH OFFICER
ELLICOTT CITY, MARYLAND

I HEREBY APPLY FOR THE NECESSARY TEST IN ORDER TO CONSTRUCT (OR RECONSTRUCT) A SEWAGE DISPOSAL SYSTEM.

PROPERTY OWNER Joseph T. Morris
TRUSTEES OF BRANTLY BAPTIST CHURCH

ADDRESS 5007 BALTIMORE NATIONAL PIKE PHONE 566-0036

PROPERTY LOCATION:

SUBDIVISION BRANTLY SECT II LOT NO. 79

ROAD AND DESCRIPTION 14155
BURNWOODS ROAD. 400' NORTH OF SHARP RD.

SIZE OF LOT 3.8 AC± TYPE BLDG. SINGLE FAMILY

THE SYSTEM INSTALLED UNDER THIS APPLICATION IS ACCEPTABLE ONLY UNTIL PUBLIC FACILITIES BECOME AVAILABLE.

I FULLY UNDERSTAND THE FEE CONNECTED WITH THE FILING OF THIS PERC TEST APPLICATION IS NON-REFUNDABLE UNDER

ANY CIRCUMSTANCES.

SIGNATURE OF APPLICANT Anthony J. Bigston

APPROVED BY Frank Shuman FOR drywell or trenches DATE 12/16/83

REJECTED BY _____ FOR _____ DATE _____


HOLD PENDING FURTHER TESTS _____ DATE _____

REASONS FOR REJECTION OR HOLDING 6/30/83 Minimum 3awbds needed see attached drawing F.S.

BLDG. PERMIT SIGNED
AND RETURNED 4/30/84
Serial # 57197

THIS IS NOT A PERMIT


A
 8" Red brn sbrk cl
 3' Red cl sbrk
 8' Red/Yel ls wkf
 Yel ls sbrk

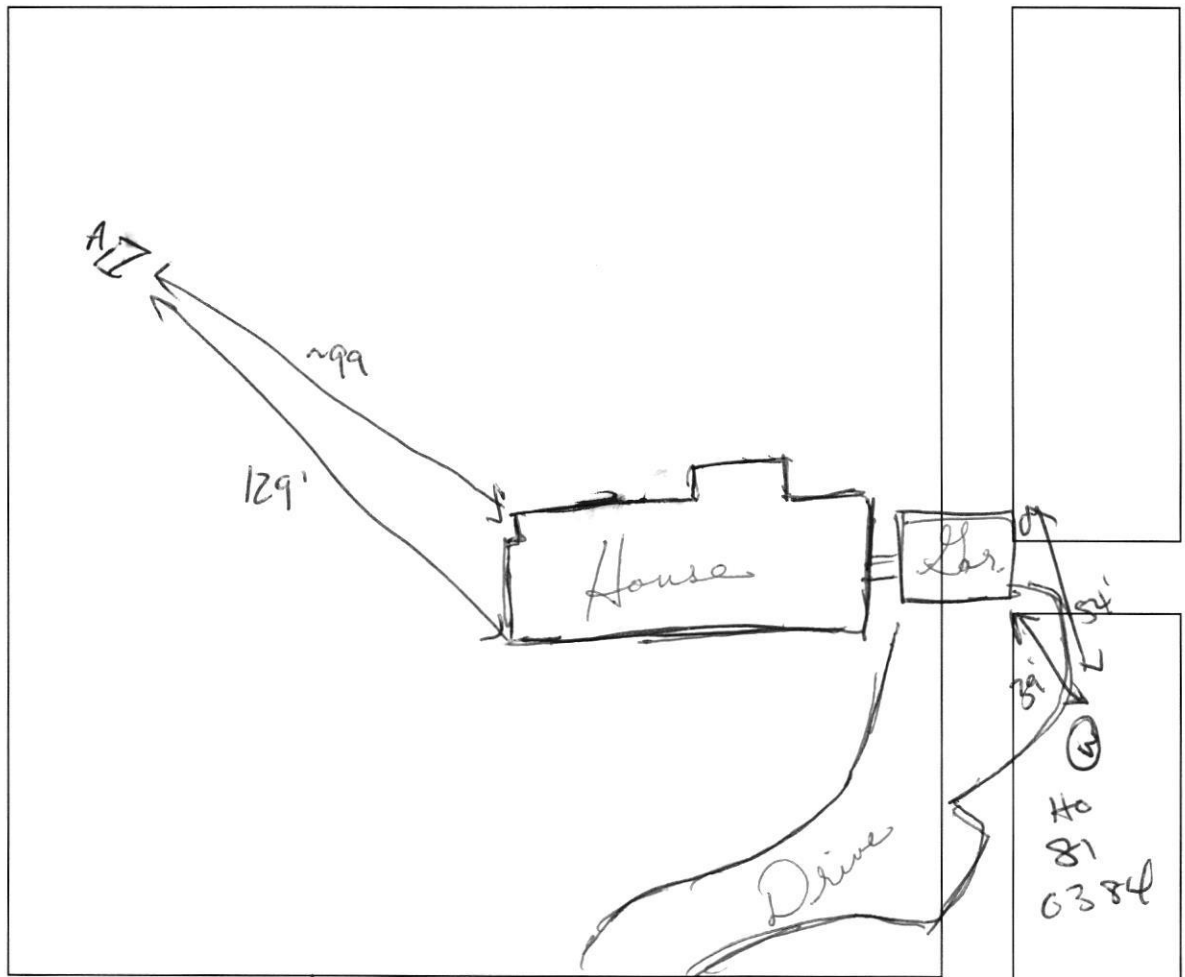

STAFF/BOTTOM MISS BURNWOODS ROAD

DATE	TEST #	DEPTH	START	BREAK 1" DROP	STOP 2" DROP	TIME OF 2ND INCH	P/F/H
12/07/2022	A	3' / 13'	0:00	4:00	8:30 10:30	6:30	P

REMARKS EX TRS HYDRAULIC OVERLOAD + ROOT INTRUSION
 SANITARIAN CABATHUG 001997 BACKHOE FOGLES OTHERS OWNER
 TEST HOLES USED IN SDA _____ AVG. PERC TIME 6.5m SQ. FT/BR 4
 TRENCH WIDTH 3' INLET DEPTH 3' MAX. BOT DEPTH 9' EFFECTIVE SW 6'

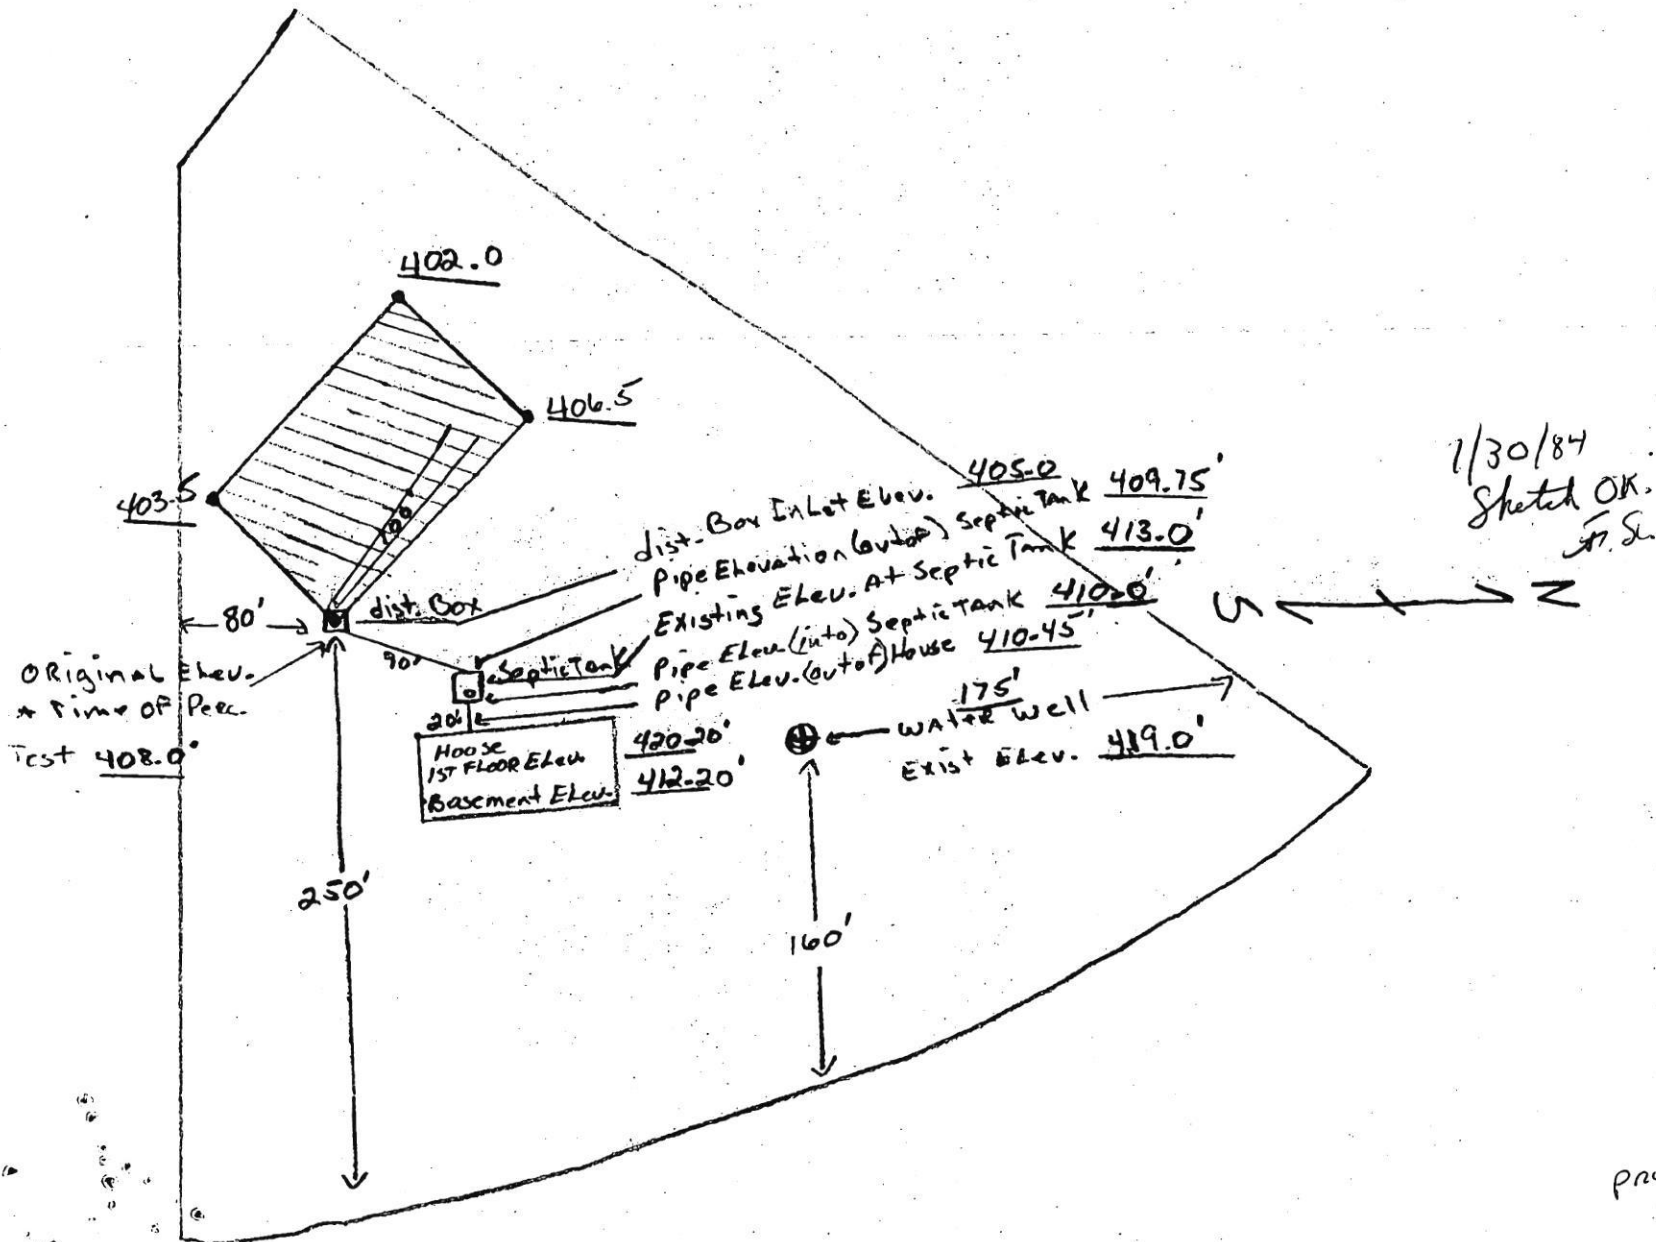

I certify the ABOVE measurements and Elevations are correct for this property
 Signed. Joseph T. Morris

PROPERTY OF JOE MORRIS
 11000 ANNAPOLIS JUNCTION RD.