

# APPLICATION

19139

H. H. H.

## SEWAGE DISPOSAL TESTING

P. \_\_\_\_\_

STATE OF MARYLAND - DEPARTMENT OF HEALTH AND MENTAL HYGIENE

HOWARD COUNTY HEALTH DEPARTMENT  
ENVIRONMENTAL HEALTH SERVICES

DISTRICT Third & Fourth

P. O. BOX 476, ELLICOTT CITY, MARYLAND 21043  
TELEPHONE: 465-8000, EXT. 386

DATE October 30, 1973

3 BR      4 BR  
S.T. 1000 gal      1250 gal

Trenches to be 2' wide, 10' deep, with 5' of stone. Trench (s) will begin at a point 30' from the 282' property line and 100' from the 145' prop line. There will be a minimum of 125' of sidewalk per B.R.

2 inspections

KJM

TO: THE COUNTY HEALTH OFFICER  
ELLICOTT CITY, MARYLAND

I, HEREBY, APPLY FOR THE NECESSARY TEST IN ORDER TO CONSTRUCT (OR RECONSTRUCT) A SEWAGE DISPOSAL SYSTEM.

PROPERTY OWNER Mr. Weldon L. Boring

ADDRESS Burntwoods Road, Glenwood, Maryland PHONE 442-2483

PROPERTY LOCATION:

SUBDIVISION Gwenlee Estates - Section II LOT NO. 12 Block A

ROAD AND DESCRIPTION West side of Sharp Road

SIZE OF LOT 150' x 270' TYPE BLDG. Two (3 or 4)  
NUMBER OF BEDROOMS

IF NOT SINGLE RESIDENCE DESCRIBE \_\_\_\_\_

THE SYSTEM INSTALLED UNDER THIS APPLICATION IS ACCEPTABLE ONLY UNTIL PUBLIC FACILITIES BECOME AVAILABLE.

BLDG. PERMIT SIGNATURE  
AND RETURNED 4/11/77  
Serial No. 31012

SIGNATURE OF APPLICANT William R. Hopkins

APPROVED BY [Signature] FOR Trenches DATE 2/19/76  
(KIND OF SYSTEM)

REJECTED BY \_\_\_\_\_ FOR \_\_\_\_\_ DATE \_\_\_\_\_  
(KIND OF SYSTEM)

HOLD PENDING FURTHER TESTS \_\_\_\_\_ DATE \_\_\_\_\_

REASONS FOR REJECTION OR HOLDING \_\_\_\_\_

# THIS IS NOT A PERMIT

# NOTATION

	(3)				(142)
	/				
	-				
	(107)				(6)

INDICATE NORTH - NAME ADJOINING ROADWAY AS BASE LINE

DATE	TEST NO.	DEPTH	PRE-WET		TEST - 1" DROP		TIME
			START	STOP	START	STOP	
7/16	1	11.0	3:45	3:47	3:47	3:50	3:00
	2	11.0	3:49	3:49	3:49	3:52	3:00
	3						
7/16	4	11.0	3:38	3:37	3:39	3:42	3:00
	5	11.0	3:40	3:41	3:41	3:49	3:00

Avg time  
5 min  
shut  
5 ft  
B.S

REMARKS \_\_\_\_\_

TYPE OF SOIL \_\_\_\_\_

# APPLICATION

A 19139

## SEWAGE DISPOSAL TESTING

P \_\_\_\_\_

STATE OF MARYLAND - DEPARTMENT OF HEALTH AND MENTAL HYGIENE

HOWARD COUNTY HEALTH DEPARTMENT  
ENVIRONMENTAL HEALTH SERVICES  
P. O. BOX 478, ELLICOTT CITY, MARYLAND 21043  
TELEPHONE: 468-5000, EXT. 386

DISTRICT ~~Third & Fourth~~

DATE ~~October 30, 1973~~

TO: THE COUNTY HEALTH OFFICER  
ELLICOTT CITY, MARYLAND

I, HEREBY, APPLY FOR THE NECESSARY TEST IN ORDER TO CONSTRUCT (OR RECONSTRUCT) A SEWAGE DISPOSAL SYSTEM.

PROPERTY OWNER Mr. Weldon L. Boring

ADDRESS Burntwoods Road, Glenwood, Maryland PHONE 442-2483

### PROPERTY LOCATION:

SUBDIVISION Cwenlee Estates - Section II LOT NO. 12, Block A

ROAD AND DESCRIPTION West side of Sharp Road

SIZE OF LOT 150' x 270' TYPE BLDG. 3 or 4  
NUMBER OF BEDROOMS

IF NOT SINGLE RESIDENCE DESCRIBE \_\_\_\_\_

THE SYSTEM INSTALLED UNDER THIS APPLICATION IS ACCEPTABLE ONLY UNTIL PUBLIC FACILITIES BECOME AVAILABLE.

SIGNATURE OF APPLICANT William R. Hopkins

APPROVED BY \_\_\_\_\_ FOR \_\_\_\_\_ DATE \_\_\_\_\_  
(KIND OF SYSTEM)

REJECTED BY \_\_\_\_\_ FOR \_\_\_\_\_ DATE \_\_\_\_\_  
(KIND OF SYSTEM)

HOLD PENDING FURTHER TESTS \_\_\_\_\_ DATE \_\_\_\_\_

REASONS FOR REJECTION OR HOLDING \_\_\_\_\_


# THIS IS NOT A PERMIT






First Floor G18  
 Basement G10  
 House Invert G11.5  
 Tank Inlet G11  
 Tank Elevation G13  
 Perh Test G12  
 Trench Inlet G07  
 Final Grade G12  
 Well G16

04 2709  
 2/28/99

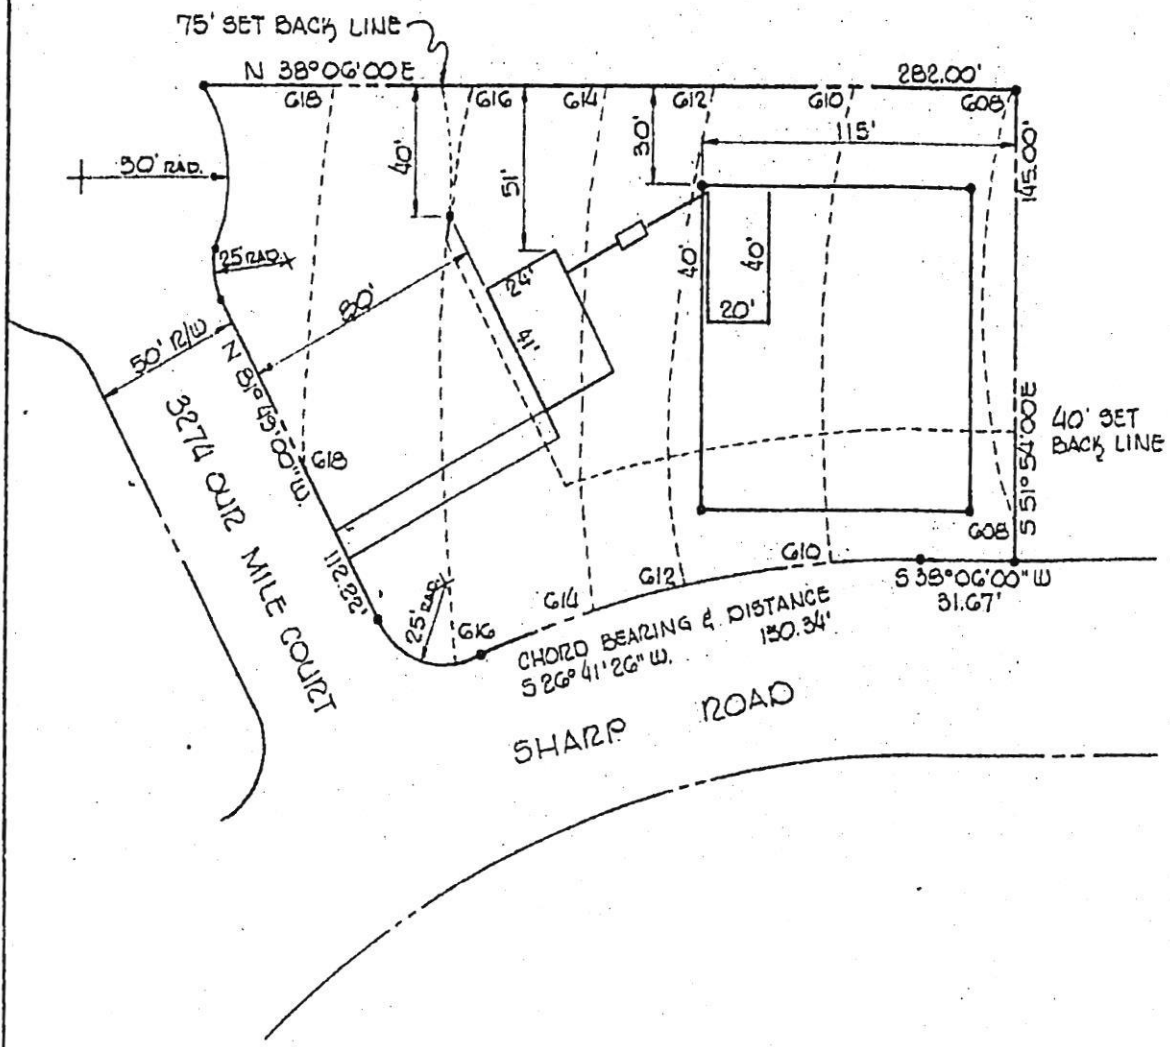

LOT 12A - BLK. 'A' - SEC. II - GWENLEE EST.  
 COSTELLO BUILDERS CORP.  
 GP 76-22 SCALE 1"=50'

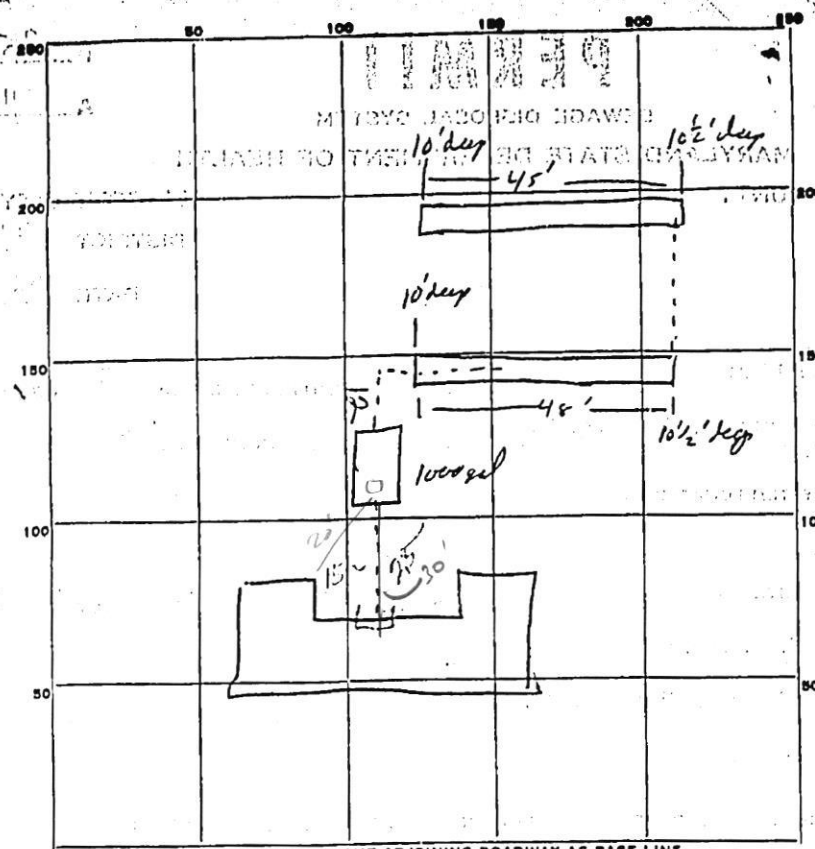

INDICATE NORTH. - NAME ADJOINING ROADWAY AS BASE LINE.

PERMIT CARD 25562 ← Rd →  
10/10/77 S.T.  
Mantoloking  
single brick

SEPTIC TANK, LEVEL  CLEANOUTS \_\_\_\_\_

DISTRIBUTION BOX, LEVEL \_\_\_\_\_

TILE FIELD, DEPTH 10-10 1/2 FT. TRENCH WIDTH 2 FT.

GRAVEL DEPTH 0.5 FT. TOTAL LENGTH 93 FT.

NUMBER OF TRENCHES 2 TOTAL BOTTOM AREA 465 Sideroad

SEEPAGE PITS, INSIDE DIAMETER \_\_\_\_\_ FT. DEPTH BELOW INLET \_\_\_\_\_ FT.

ABSORBENT AREA 465 SQ. FT.

REMARKS

14 Sep 77 1) S.T. may need mantoloking cleanout R.M.

2) continue work

3) OK to cover everything but manhole

RB 9/15/77

10/10/77 Man hole + top on to make only thing seen. skid to cover that part of system due to B.C. cases.

DATE SYSTEM APPROVED 10 Oct 77 INSPECTOR R. Biggs

