

December 20, 1965

Mr. Luther L. Green, President
Watermont Swim Club, Inc.
Box 304
Ellicott City, Maryland

RE: WATERMONT SWIM CLUB PROPERTY

Dear Mr. Green:

This is to certify that the above referenced property did
not pass the percolation test conducted by me on December 17, 1965.

Very truly yours,

John H. Kilmore,
Sanitarian

JHK: jr

12/17/65
9:30

APPLICATION

A 11307

P _____

SEWAGE DISPOSAL TESTING

MARYLAND STATE DEPARTMENT OF HEALTH

HOWARD COUNTY

ELLCOTT CITY

DISTRICT 2

DATE 12/1/65

TO: THE COUNTY HEALTH OFFICER
ELLCOTT CITY, MARYLAND

I, HEREBY, APPLY FOR THE NECESSARY TESTS IN ORDER TO CONSTRUCT (OR RECONSTRUCT) A SEWAGE DISPOSAL SYSTEM.

PROPERTY OWNER Watermont Swim Club, Inc.

ADDRESS Box 304, Ellicott City, Maryland PHONE 465-2015

PROPERTY LOCATION:

SUBDIVISION N/A LOT NO. N/A

ROAD AND DESCRIPTION Southeast of Ilchester Road, part of Old Ryder property.
Second election district.

OCCUPANT None PHONE _____

PERSON TO CONSTRUCT SYSTEM Ira C. Rigger, Inc.

ADDRESS Cockeysville, Maryland PHONE 666-1800

SIZE OF LOT 12.2 Acres TYPE BLDG. Swimming Pool
NUMBER OF BEDROOMS _____

IF NOT SINGLE RESIDENCE DESCRIBE Junior size Olympic swimming pool, bathhouse, and
parking lot.

SIGNATURE OF APPLICANT *Luther L. Green*
Luther L. Green, President, Watermont Swim Club, Inc.


APPROVED BY _____ FOR _____ DATE _____
(KIND OF SYSTEM)

REJECTED BY _____ FOR _____ DATE _____
(KIND OF SYSTEM)

HOLD PENDING FURTHER TESTS _____ DATE _____

REASONS FOR REJECTION OR HOLDING _____

THIS IS NOT A PERMIT

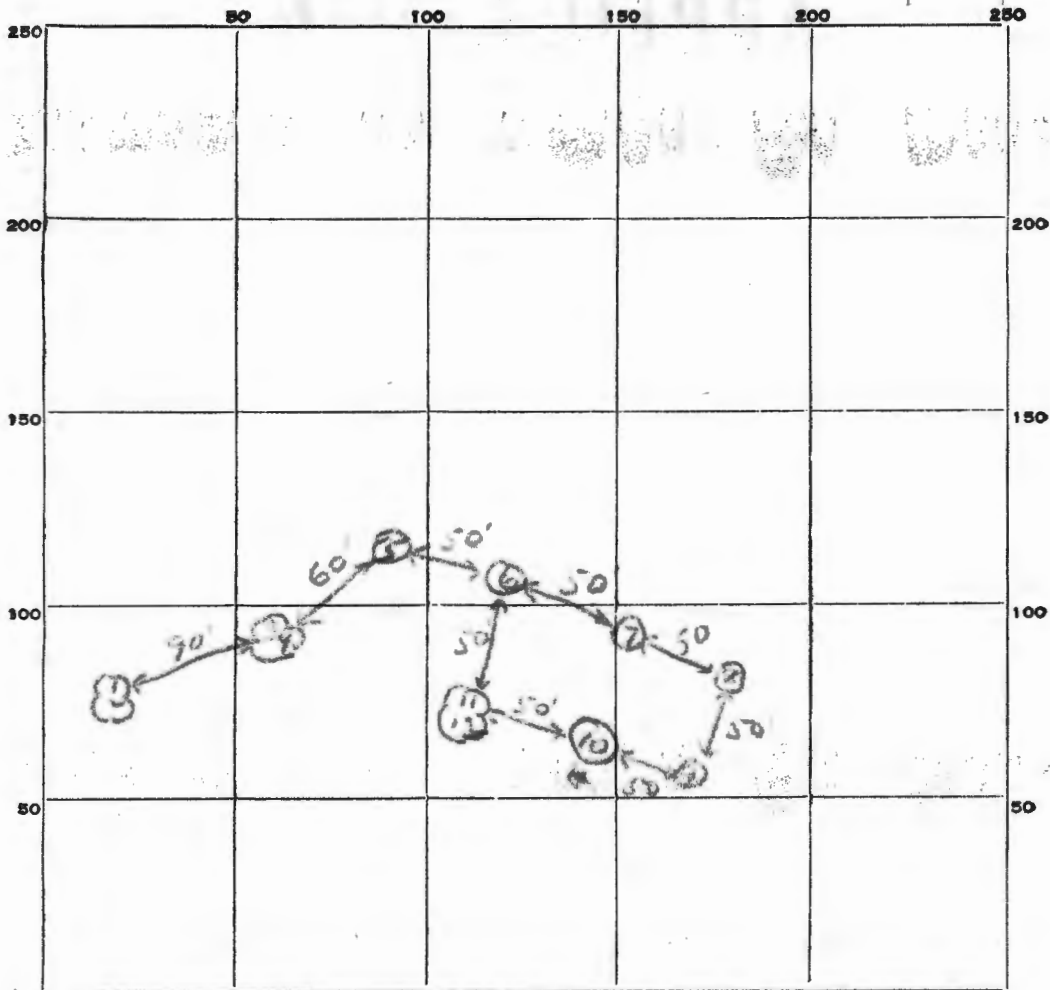

INDICATE NORTH. - NAME ADJOINING ROADWAY AS BASE LINE.

| DATE | TEST NO. | DEPTH | PRE-WET | | TEST - 1" DROP | | TIME | |
|---------|----------|--------|--------------------------------|-------------------|----------------|-------|--------|--|
| | | | START | STOP | START | STOP | | |
| 4/17/15 | 1 | 9' | Water at 5' | | | | | |
| | 2 | 4 1/2' | 10:30 | 10:15 | 10:15 | 11:30 | 42 min | |
| | 3 | 9' | Water at 8' | | | | | |
| | 4 | 5' | 10:15 | 10:18 | 10:18 | 10:25 | 7 min | |
| | 5 | 15' | Water at 12' | | | | | |
| | 6 | 4' | 11:00 | 11:10 | 11:10 | 11:25 | 15 min | |
| | 7 | 3 1/2' | 11:07 | 11:22 | 11:22 | 11:50 | 28 min | |
| | 8 | 7' | 11:27 | Overtime 1st inch | | | | |
| | 9 | 3' | 11:34 | 11:52 | 11:52 | | | |
| | 10 | 3' | 11:52 | Overtime 1st inch | | | | |
| | 11 | 10' | Not tested - no water observed | | | | | |
| | 12 | 3' | 12:00 | Overtime 1st inch | | | | |

SOIL AUGER FINDING _____

TESTED BY JHK

REMARKS _____

APPLICATION

SEWAGE DISPOSAL TESTING

MARYLAND STATE DEPARTMENT OF HEALTH

HOWARD COUNTY

ELLICOTT CITY

DISTRICT 2

DATE 12/1/65

A 11307

P _____

TO: THE COUNTY HEALTH OFFICER
ELLICOTT CITY, MARYLAND

I, HEREBY, APPLY FOR THE NECESSARY TESTS IN ORDER TO CONSTRUCT (OR RECONSTRUCT) A SEWAGE DISPOSAL SYSTEM.

PROPERTY OWNER Watermont Swim Club, Inc.

ADDRESS Box 304, Ellicott City, Maryland PHONE 465-2015

PROPERTY LOCATION:

SUBDIVISION N/A LOT NO. N/A

ROAD AND DESCRIPTION Southeast of Illichester Road, part of Old Ryder property.

Second election district.

OCCUPANT None PHONE _____

PERSON TO CONSTRUCT SYSTEM Ira C. Rigger, Inc.

ADDRESS Cockeysville, Maryland PHONE 666-1800

SIZE OF LOT 12.2 Acres TYPE BLDG. Swimming Pool

NUMBER OF BEDROOMS

IF NOT SINGLE RESIDENCE DESCRIBE Junior size Olympic swimming pool, bathhouse, and

parking lot.

SIGNATURE OF APPLICANT Luther L. Green, President, Watermont Swim Club, Inc.


APPROVED BY _____ FOR _____ DATE _____
(KIND OF SYSTEM)

REJECTED BY _____ FOR _____ DATE _____
(KIND OF SYSTEM)

HOLD PENDING FURTHER TESTS _____ DATE _____

REASONS FOR REJECTION OR HOLDING _____

THIS IS NOT A PERMIT

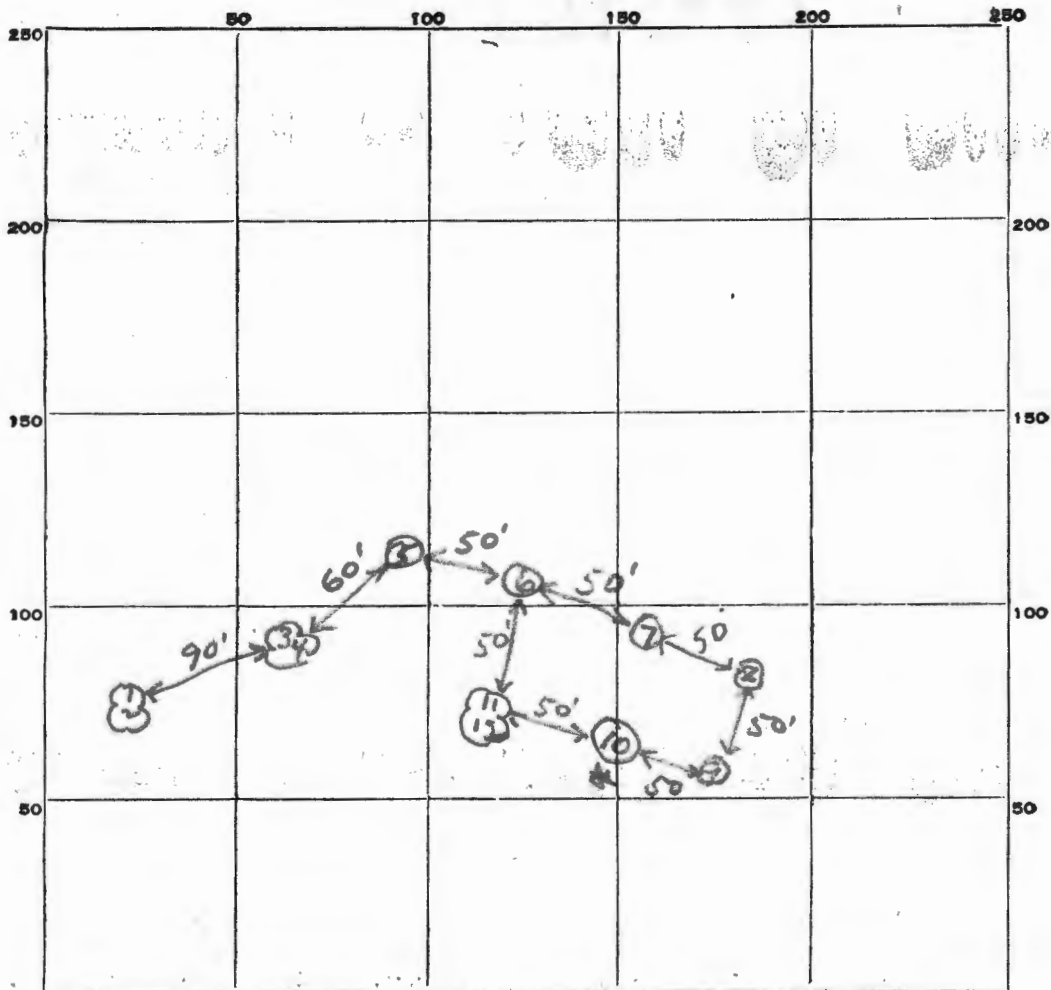

INDICATE NORTH. - NAME ADJOINING ROADWAY AS BASE LINE.

| DATE | TEST NO. | DEPTH | PRE-WET | | TEST - 1" DROP | | TIME | |
|----------|----------|--------|--------------------------------|-------------------|----------------|-------|--------|--|
| | | | START | STOP | START | STOP | | |
| 12/17/05 | 1 | 9' | Water at 8' | | | | | |
| | 2 | 4 1/2' | 10:30 | 10:38 | 10:38 | 11:20 | 42 min | |
| | 3 | 9' | Water at 8' | | | | | |
| | 4 | 5' | 10:15 | 10:18 | 10:18 | 10:25 | 7 min | |
| | 5 | 13' | Water at 12' | | | | | |
| | 6 | 4' | 11:00 | 11:10 | 11:10 | 11:25 | 15 min | |
| | 7 | 3 1/2' | 11:07 | 11:22 | 11:22 | 11:50 | 28 min | |
| | 8 | 3' | 11:27 | Overtime 1st inch | | | | |
| | 9 | 3' | 11:34 | 11:52 | 11:52 | | | |
| | 10 | 3' | 11:52 | Overtime 1st inch | | | | |
| | 11 | 10' | Not tested - no water observed | | | | | |
| | 12 | 3' | 12:00 | Overtime 1st inch | | | | |

SOIL AUGER FINDING _____

TESTED BY JHK

REMARKS _____

R-20 ZONE

S 30° 41' 44" E 312.72'

C15.23'

55° 17' 00" E
TRANSMISSION CO. R/W

150'

764.74'
R-20 ZONE

Perc Test Hole
as staked in Field

234'

TOTAL AREA: 12.273 ACRES ±
(INCLUDING TRANSMISSION R/W)

PRESENT ZONE - R-20
REQUESTED ZONING SPECIAL USE (SWIM CLUB)
SECTION 12.21

R-20 ZONE

N 85° 55' 41" E
580.81'

ROAD

ILCHESTER
(County Road)

PAVING

EXISTING

± 600 ± 75 ± Intersection of
Kearner Rd.

N 32° 40' 10" W 202.03'

Q = 275.00'

CHD = 1192.58 45° W 149.22'

L = 161.22'

N 01° 10' 16" W 26.7'

± 50' RIGHT OF WAY

Q = 200.00'

CHD = N 52° 00' 17" W

R-20 ZONE

404.11'

N 52° 55' 41" E

404.17'

N 52° 55' 41" E

N 22° 31' 25" W 200.82'

R-20 ZONE

N 22° 31' 08" W 200.91'

APPLICANT: WATERMONT SWIM CLUB, INC.
& OWNER: Box 304
ELLICOTT CITY, MARYLAND

COUNSEL: RAYMOND CARRILLO
BRITTANY DRIVE
ELLICOTT CITY, MARYLAND

PLAT TO ACCOMPANY PETITION
FOR SPECIAL LAND USE
PROPERTY OF
WATERMONT SWIM CLUB, INC.

2nd ELECTION DIST HOWARD CO., MD
JULY 30 1965 SCALE 1" = 50'

LOCATED ON TAX MAP No. 31
LOCAL COMMUNITY: Ilchester

ADDITIONS: NOVEMBER 24, 1965

PURDUM & NESCHKE
ENGINEERS
24 PARK AVENUE
ELLICOTT CITY, MARYLAND