

APPLICATION

A 18256

SEWAGE DISPOSAL TESTING

P _____

STATE OF MARYLAND - DEPARTMENT OF HEALTH AND MENTAL HYGIENE

HOWARD COUNTY HEALTH DEPARTMENT
ENVIRONMENTAL HEALTH SERVICES
P. O. BOX 476, ELLICOTT CITY, MARYLAND 21043
TELEPHONE: 465-5000, EXT. 356

DISTRICT 4th

DATE 4/12/73

TO: THE COUNTY HEALTH OFFICER
ELLICOTT CITY, MARYLAND

I, HEREBY, APPLY FOR THE NECESSARY TEST IN ORDER TO CONSTRUCT (OR RECONSTRUCT) A SEWAGE DISPOSAL SYSTEM.

PROPERTY OWNER Mordecai Hoseh
ADDRESS Woodbine, Maryland PHONE 286-2336
Any questions call Louise Adams:

PROPERTY LOCATION:

SUBDIVISION _____ LOT NO. Parcel 25

ROAD AND DESCRIPTION Florence Road

SIZE OF LOT 5 acres TYPE BLDG. 3 or 4 bedrooms
NUMBER OF BEDROOMS

IF NOT SINGLE RESIDENCE DESCRIBE _____

THE SYSTEM INSTALLED UNDER THIS APPLICATION IS ACCEPTABLE ONLY UNTIL PUBLIC FACILITIES BECOME AVAILABLE.

SIGNATURE OF APPLICANT /s/ Louise H. Adams


APPROVED BY _____ FOR _____ DATE _____
(KIND OF SYSTEM)

REJECTED BY _____ FOR _____ DATE _____
(KIND OF SYSTEM)

HOLD PENDING FURTHER TESTS _____ DATE _____

REASONS FOR REJECTION OR HOLDING _____

THIS IS NOT A PERMIT

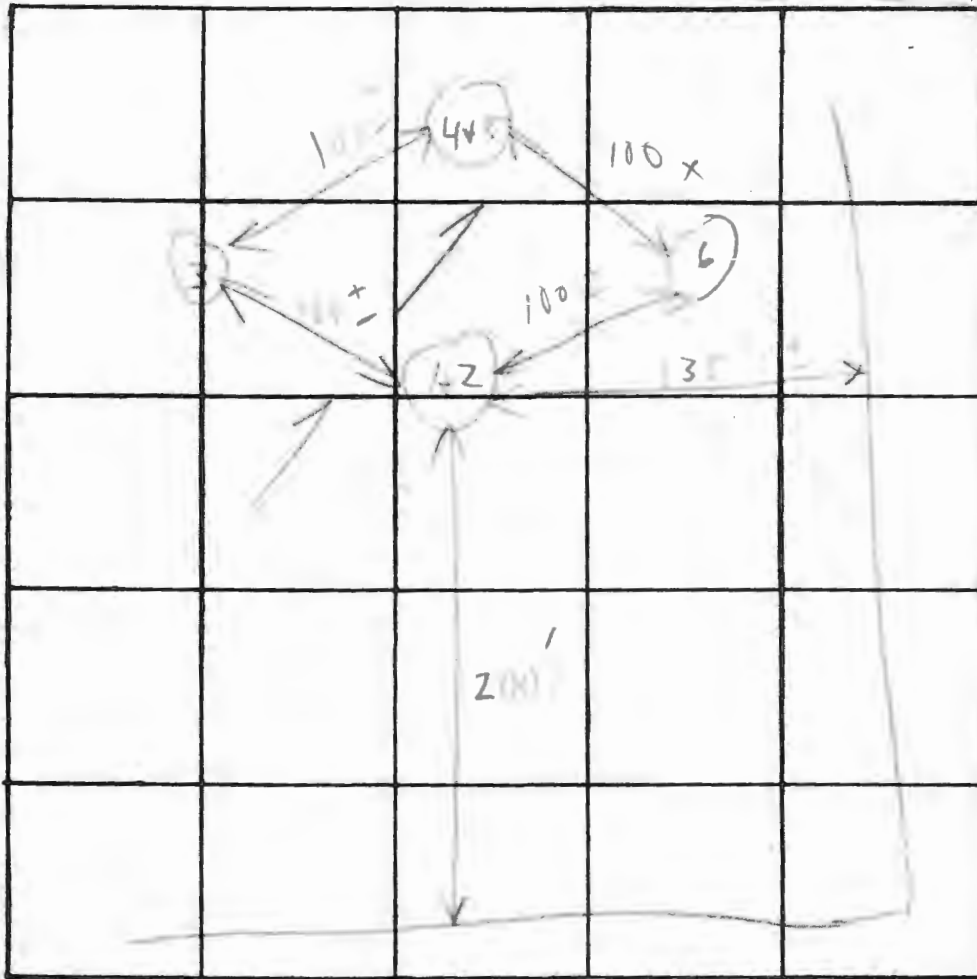

INDICATE NORTH. - NAME ADJOINING ROADWAY AS BASE LINE.

DATE	TEST NO.	DEPTH	PRE-WET		TEST - 1" DROP		TIME	
			START	STOP	START	STOP		
5/18/73	1	3 1/2'	10:44	10:46	10:46	10:52	12 min	
	2	12'	10:45	10:48	10:47	10:50	3 min	
	3	11'	Vertical similar to 1+2					
	4	4'	10:57	10:58	10:58	11:12	14 min	
	5	12'	10:56	11:00	11:00	11:13	13 min	
	6	11'	Vertical similar to 4+5					
						47	44 min	

Use 1+2
 Omit 3 1/2'
 150 yds
 per bed room

REMARKS Depth 11' slope

TYPE OF SOIL _____



A-3529-25

*3 or 4 Redwood
286-2336*



PLAT OF SURVEY
FOR

MORDECAI HOSEH
FOURTH ELECTION DIST. HOWARD COUNTY,
WOODBINE, MARYLAND.

SCALE: 1 IN. = 200 FT. JANUARY 17, 1973.

Claude M. Skinner, Jr.
Claude M. Skinner, Jr.
Reg. Professional Engineer &
Land Surveyor No. 2237