

APPLICATION

A 16634

P _____

SEWAGE DISPOSAL TESTING

MARYLAND STATE DEPARTMENT OF HEALTH

HOWARD COUNTY Septic TANK - 1000 gal.

ELLICOTT CITY

Dry Well + Deep trench -

DISTRICT 5th

DATE 12-27-71

Dry well to have 400 yd ft absorbent sidewall area to begin within the first 5 ft of non-porous soil. All trench to be installed opp dry well - 30 ft long 4 ft deep with 2 1/2 ft of gravel. Locate dry well 130 ft from front property line & 150 ft from 1/2 side line as seen from front road lane.

TO: THE COUNTY HEALTH OFFICER
ELLICOTT CITY, MARYLAND

I, HEREBY, APPLY FOR THE NECESSARY TESTS IN ORDER TO CONSTRUCT (OR RECONSTRUCT) A SEWAGE DISPOSAL SYSTEM.

PROPERTY OWNER Walter D. Kone

ADDRESS 614 E. 34th St., Baltimore, Md. PHONE HO7-4437

PROPERTY LOCATION:

SUBDIVISION _____ LOT NO. _____

ROAD AND DESCRIPTION Featherbed Lane

Can met you at Barmans Market and take you to perc test.

OCCUPANT _____ PHONE _____

PERSON TO CONSTRUCT SYSTEM _____

ADDRESS _____ PHONE _____

SIZE OF LOT 2 Acres TYPE BLDG. Single Family Dwelling
3 - Bedrooms
NUMBER OF BEDROOMS

IF NOT SINGLE RESIDENCE DESCRIBE _____

SIGNATURE OF APPLICANT Charles W. Jones


APPROVED BY Robert V. Tane FOR Dry Well + Deep Trench DATE 2/14/72
(KIND OF SYSTEM)

REJECTED BY _____ FOR _____ DATE _____
(KIND OF SYSTEM)

HOLD PENDING FURTHER TESTS _____ DATE _____

REASONS FOR REJECTION OR HOLDING _____

THIS IS NOT A PERMIT

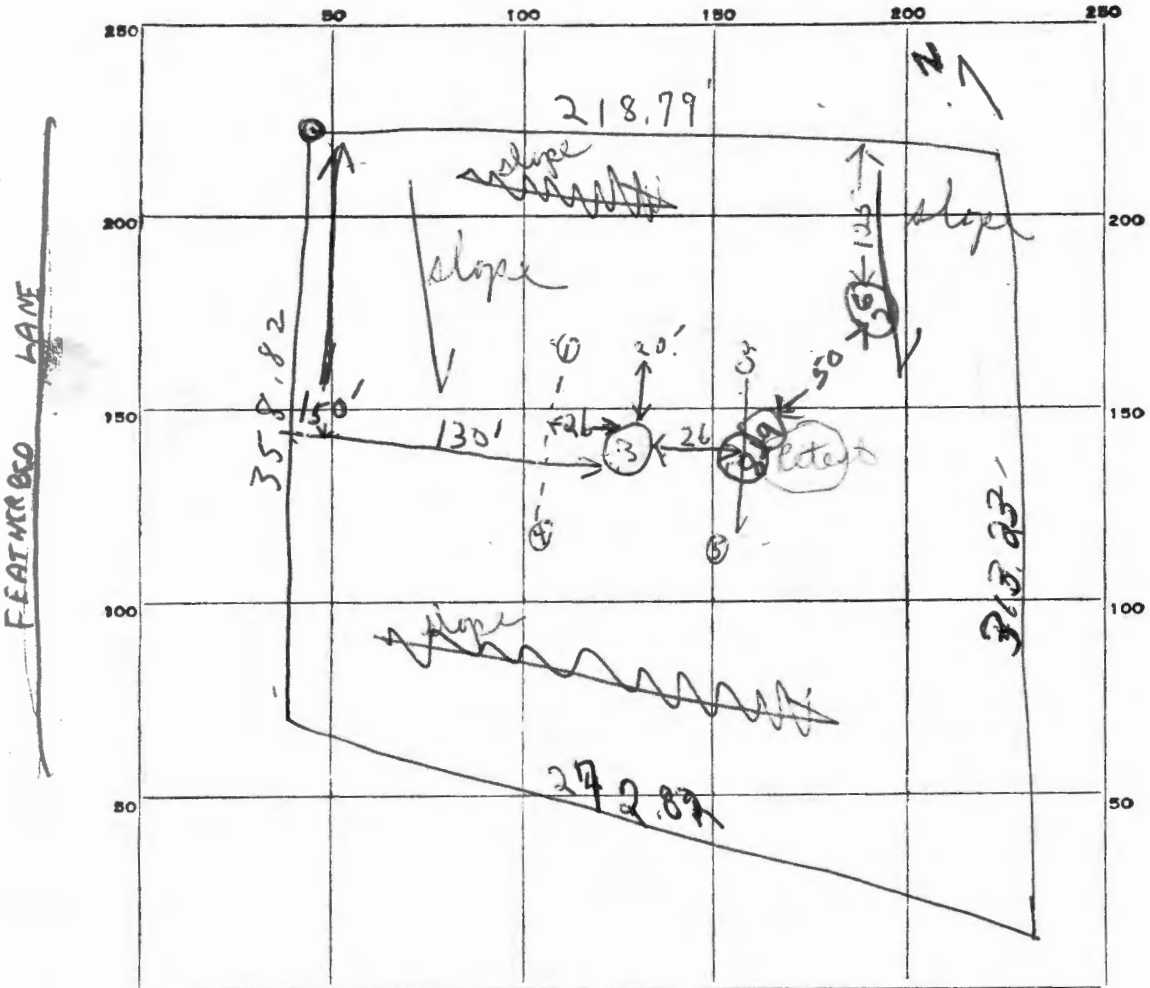

INDICATE NORTH. - NAME ADJOINING ROADWAY AS BASE LINE.

DATE	TEST NO.	DEPTH	PRE-WET		TEST - 1" DROP		TIME
			START	STOP	START	STOP	
1/7/72	1	3'	10:14	10:35	10:35	11:02	27 min
	2	3'	10:15	10:25	10:25	10:31	6 min
	3	9'	10:20	10:39	10:39	11:09	30 min
	4	Water in hole		No test		—	
	5	3'	10:31	10:49	10:49	Top little per. at 11:19	
2/10/72	6	11 1/2 ft.	10 ²⁰	10 ²⁶	10 ²⁶	10 ³⁹	13 min
	7	4 ft.	10 ²⁵	11 ⁰⁵	1 inch	2nd inch very slow	
	8	11 ft.	10 ³¹	1st	over time		} Ground frozen
	9	4 ft.	10 ³⁵	11 ⁰⁵	1/2 inch		

SOIL AUGER FINDING

Retest
~~Prain field~~ Recommended deep pit 50'
 from #3 Retest by P.W. G.S.

TESTED BY B.S.

REMARKS Prain Field attempt Soil wet + damp!! Dig Well if 45'

11/17/72
 R.T.
 used
 with
 mine

APPLICATION

A 16634

SEWAGE DISPOSAL TESTING

P _____

MARYLAND STATE DEPARTMENT OF HEALTH

HOWARD COUNTY Septic TANK - 1000 gal.

ELLICOTT CITY

DISTRICT 5th

DATE 12-27-71

1/14/72
9:30
1/27/72
9:30
Dry Well + Deep trench -

Dry well to have 400 sq. ft. absorbent sidewall area to begin below the first 5 ft. of non-porous soil. Additional trench to be installed off dry well - 30 ft. long. 11 ft. deep with six (6) ft. of gravel. Locate dry well 130 ft. from front property line + 150 ft. from left side line as seen from Featherbed Lane.

TO: THE COUNTY HEALTH OFFICER
ELLICOTT CITY, MARYLAND

I, HEREBY, APPLY FOR THE NECESSARY TESTS IN ORDER TO CONSTRUCT (OR RECONSTRUCT) A SEWAGE DISPOSAL SYSTEM.

PROPERTY OWNER Walter D. Kone

ADDRESS 614 E. 34th St., Baltimore, Md. PHONE HO7-4437

PROPERTY LOCATION:

SUBDIVISION _____ LOT NO. _____

ROAD AND DESCRIPTION Featherbed Lane Highland

Can met you at Barmans Market and take you to perc test.

OCCUPANT _____ PHONE _____

PERSON TO CONSTRUCT SYSTEM _____

ADDRESS _____ PHONE _____

SIZE OF LOT 2 Acres TYPE BLDG. Single Family Dwelling
3 - Bedrooms
NUMBER OF BEDROOMS

IF NOT SINGLE RESIDENCE DESCRIBE _____

SIGNATURE OF APPLICANT X Charles W. James - 725-3703

APPROVED BY Robert V. Tave FOR Dry Well + Deep Trench DATE 2/14/72
(KIND OF SYSTEM)

REJECTED BY _____ FOR _____ DATE _____
(KIND OF SYSTEM)

HOLD PENDING FURTHER TESTS _____ DATE _____

REASONS FOR REJECTION OR HOLDING Hold see instructions on back page for retest

THIS IS NOT A PERMIT

2/14/72

Please nothing
on this until
signed boundary
plot is returned.



Prepared By:
BOENDER ASSOCIATES
 Baltimore & Columbia, Md
 Telephone: (301) 790-4400



VICINITY MAP
 Scale: 1" = 2000'

APPROVED: Private Water & Private Sewer
Dr. T. R. SHROP - Co. Health Officer
APPROVED: Office of Planning & Zoning
T. G. HARRIS - Planning Director

OWNER:
 Walter D. Kone & Wife

TITLE REFERENCE:
 RHM 324, Folio 514

Herbert Malmud
 HERBERT MALMUD
 Md. No 7558

403/369 M. B. SULLIVAN

4.661 Acres ±
 LOT 2

2.000 Acres ±
 LOT 1

OWNER'S STATEMENT

We, the undersigned, owners of the property shown hereon, our heirs or assigns, adopt this plan of subdivision and do hereby establish the building setback restriction shown hereon in order to comply with the General Plan of Highways in Howard County, Md.

Walter D. Kone 12/4/71
 WALTER D. KONE Date
Sabra S. Kone 12/4/71
 SABRA S. KONE Date

5th Election District
 Howard County, Md.
 Scale: 1" = 100' Nov. 1971

