

11/26/85
11/26/85
PM
WPT

APPROVED
11/26/85
RA 36159
P 36159
A 31739

PERMIT

SEWAGE DISPOSAL SYSTEM

MARYLAND STATE DEPARTMENT OF HEALTH

HOWARD COUNTY
BUREAU OF ENVIRONMENTAL HEALTH

461-9933

ELLICOTT CITY

DISTRICT 5th

DATE 10/30/85

INDEXED

WPT incomplete
11/26/85

Kastner Plumbing & Heating Inc. IS PERMITTED TO INSTALL X ALTER

ADDRESS 13556 Argo Drive, Dayton, Maryland 21036 PHONE 725-5000

SUBDIVISION Dunfretten Estates ROAD 13645 Triadelphia Mill LOT 26

PROPERTY OWNER ~~Chester Phillips~~ Michael J. Wachur

ADDRESS _____

IF GARBAGE GRINDER IS USED INCREASE SEPTIC TANK CAPACITY BY 50% AND ABSORPTION AREA BY 22%.

GARBAGE GRINDER? YES _____ NO X

SEPTIC TANK CAPACITY 1250 1000 GALLONS NUMBER OF BEDROOMS 4 3

TRENCHES - 158 sq. ft. per bedroom. Trench to be 2 feet wide. Inlet 2 1/2 feet below original grade. Bottom maximum depth 9 1/2 feet below original grade. Effective area begins at 2 1/2 feet below original grade. 7 feet of stone below distribution pipe.

LOCATION: Start the trench at perc hole #1 which is located 150 feet from the back lot line and 30 feet from the right side of the lot as seen when facing the lot from Triadelphia Mill Road. Run the trench toward the left side of the lot as seen when facing the lot from Triadelphia Mill Road. NOTE: No trench to exceed 100 feet in length. If more than one trench used, a distribution box is required. Call for inspection of trench(s) before and after gravel is installed. Provide 6" - 8" diameter cleanout and cap to grade or above on septic tank. ok/cw

BLDG. PERMIT SIGNED
AND RETURNED 9/22/84
Sue #58917
radis

PLANS APPROVED BY Raymond Hodges DATE 6/02/83

COVER NO WORK UNTIL INSPECTED AND APPROVED.

NEITHER THE HOWARD COUNTY COUNCIL NOR THE HEALTH DEPARTMENT IS RESPONSIBLE FOR THE SUCCESSFUL OPERATION OF ANY SYSTEM.

NOTE: IF TRENCH IS USED CALL FOR INSPECTION BEFORE AND AFTER PLACING GRAVEL IN TRENCH.

NOTE: NO DRY WELL SHALL EXCEED 15 FOOT IN DIAMETER. NO ABSORPTION TRENCH TO EXCEED 100 FEET IN LENGTH.

NOTE: ALL PIPE FROM HOUSE TO SEPTIC TANK MUST BE CAST IRON OR SCHEDULE 40 PVC OR ABS.

PERMIT VOID AFTER THREE YEARS.

NOTE: INSTALL STAND PIPE ON SEPTIC TANK AND DRY WELL. STAND PIPES MUST BE 6 INCHES IN DIAMETER. CAST IRON, CONCRETE OR TERRA COTTA, OR PVC OR ABS ACCEPTED. IF TOP OF SEPTIC TANK IS DEEPER THAN 3 FEET MANHOLE TO GRADE REQUIRED


***INSTALLER IS RESPONSIBLE FOR OBTAINING FINAL APPROVAL ON THIS PERMIT**

*CALL 992-2330 FOR INSPECTION OF SEPTIC SYSTEMS.

EH - 2-1082

461 9933

A 31739

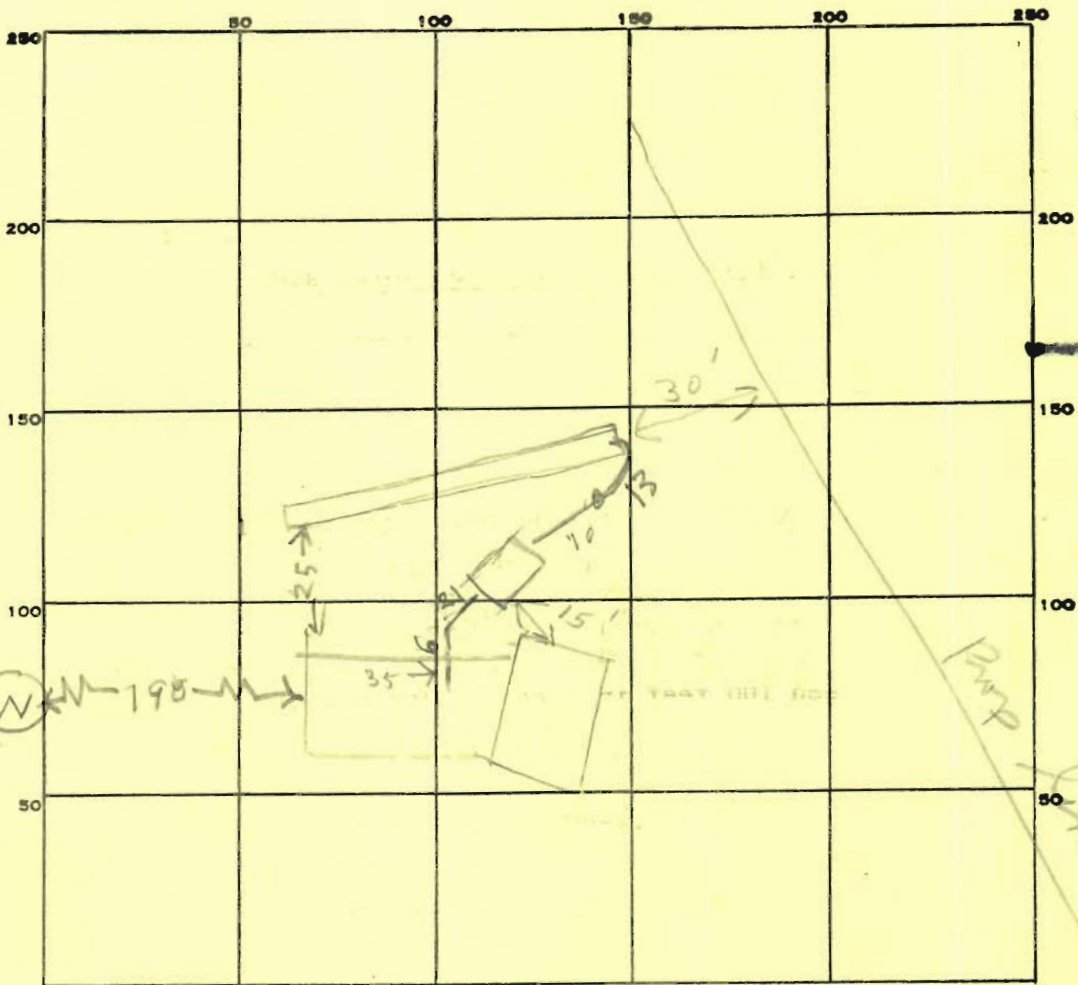

INDICATE NORTH. - NAME ADJOINING ROADWAY AS BASE LINE.

Main Mill Rd

PERMIT CARD _____

SEPTIC TANK, LEVEL 150

CLEANOUTS OK

DISTRIBUTION BOX, LEVEL _____

TILE FIELD, DEPTH 9 1/2 FT. TRENCH WIDTH 2 FT.

GRAVEL DEPTH _____ IN. TOTAL LENGTH 95 FT.

NUMBER OF TRENCHES 1 TOTAL BOTTOM AREA 665

SEEPAGE PITS, INSIDE DIAMETER _____ FT. DEPTH BELOW INLET _____ FT.

ABSORBENT AREA _____ SQ. FT.

REMARKS 11/25/85 OK to add stone in trench
11/26/85 - SOME STONE ADDED TO TRENCH TANK HOOKED TO TRENCH
11/26/85 - STONE ADDED 4 BR 632 SQ FT
NEEDED. 665 SQ FT INSTALLED. ADD PAPER
TO TRENCH & FINISH HOOKING UP HOUSE SEWER

DATE SYSTEM APPROVED 11/26/85

INSPECTOR Raymond Hodges