

CHAPEL VIEW

DATE TEST	LOT #	DEPTH TEST	DEPTH SYSTEM	DEPTH INLET	SOFT	AV TIME	REMARKS
NOV 61	13	3	3	1-2	564 ft 3 BR	25	THREE 3 ft HOLES DUG ONE HOLE FAILED (SLOW)
OCT 74	26 and 3	9	5	2-3	850 ft 4 BR	20	FIVE HOLES DUG THREE 5 ft HOLES FAILED (RUSH) ONE 9 ft HOLE FAILED (SLOW) PUBLIC SEWER NOT AVAILABLE 1968 (FT)

compiled 11/13/81 RH

APPLICATION

A 04423

P _____

SEWAGE DISPOSAL TESTING

MARYLAND STATE DEPARTMENT OF HEALTH

HOWARD COUNTY

ELLICOTT CITY

DISTRICT 2

DATE 10/24/61

564 sq. FT. of tile field located 470 ft. from the front property line. Trenches to run across slope and have grade of one inch fall on tiles for every 33 ft. of trench.

75 gal. septic Tank.

TO: THE COUNTY HEALTH OFFICER
ELLICOTT CITY, MARYLAND

I HEREBY, APPLY FOR THE NECESSARY TESTS IN ORDER TO CONSTRUCT (OR RECONSTRUCT) A SEWAGE DISPOSAL SYSTEM.

PROPERTY OWNER Guy Sykes

ADDRESS Ellicott City PHONE Plumber's Number Mr. Kline - Hu 6-6500

PROPERTY LOCATION:

SUBDIVISION Chapel View LOT NO. 13

ROAD AND DESCRIPTION Oak Glen Road Oak Rd-a

OCCUPANT _____ PHONE _____

PERSON TO CONSTRUCT SYSTEM _____

ADDRESS _____ PHONE _____

SIZE OF LOT 20,250 TYPE BLDG. 3 NUMBER OF BEDROOMS

IF NOT SINGLE RESIDENCE DESCRIBE _____

SIGNATURE OF APPLICANT Kline/dma


APPROVED BY J. Hennigan FOR Tile field DATE 11-1-61

REJECTED BY _____ FOR _____ DATE _____

HOLD PENDING FURTHER TESTS _____ DATE _____

REASONS FOR REJECTION OR HOLDING _____

THIS IS NOT A PERMIT

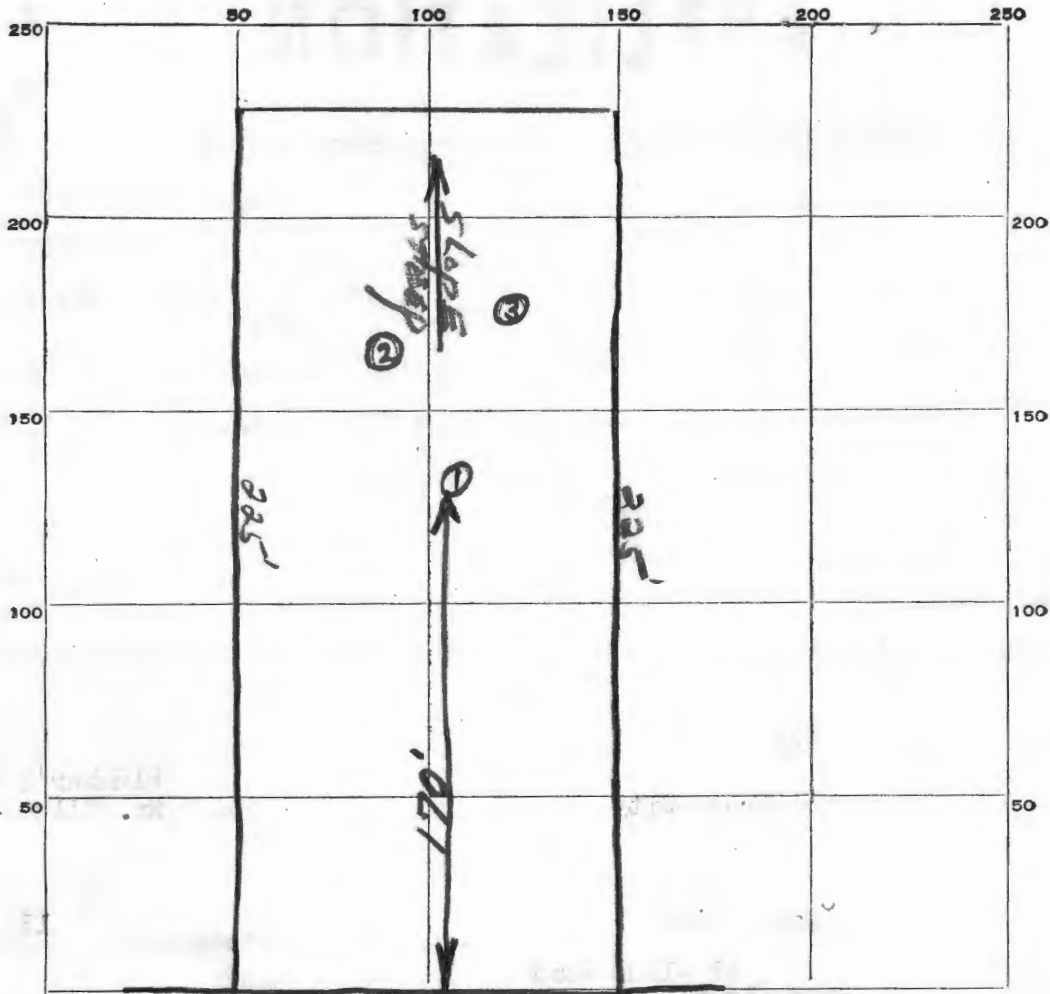

INDICATE NORTH. - NAME ADJOINING ROADWAY AS BASE LINE.

CHAPEL VIEW ROAD

DATE	TEST NO.	DEPTH	PRE-WET		TEST - 1" DROP		TIME
			START	STOP	START	STOP	
11-1-61	1	3	2:01	2:23	2:23	2:52	29 Min
	2	1	2:02	over time			
			2:02	—			
	3	1	2:12	2:21	2:21	2:42	21 Min.

lot 20 old #
 lot 23 new #
 3:01
 3:03
 3:04

SOIL AUGER FINDING _____
 TESTED BY J. Herring
 REMARKS Maintain 1" fill on tile in trenches for every 33'
 11-1-61
 ALSO PRESENT Ralph Klein LOT NO. 12

LA. 26 Sec. 3 Chapel View

Public sewer on adjacent lot ends approx. 25' from
subject property line (manhole 10' deep)

need elevation of house to be built

9-14-68. Mr. Johnson said their surveyor is to shoot
elevations from lot to sewer on adjacent lot. F.F.

APPLICATION

A 09181

SEWAGE DISPOSAL TESTING

P _____

MARYLAND STATE DEPARTMENT OF HEALTH

HOWARD COUNTY

ELLICOTT CITY

*1000 gallon tank
Leaching Bed - 850 sq ft bottom
area installed at a depth of 5 ft*

DISTRICT 2

DATE 10/7/64

*Place the bed ^{between} 10 ft & 40 ft from the
front lot line and ^{between} 10 ft & 40 ft from the
left side of the lot as seen when ~~viewed~~
facing the lot from
Chapel View Drive*

TO: THE COUNTY HEALTH OFFICER
ELLICOTT CITY, MARYLAND

I, HEREBY, APPLY FOR THE NECESSARY TESTS IN ORDER TO CONSTRUCT (OR RECONSTRUCT) A SEWAGE DISPOSAL SYSTEM.

PROPERTY OWNER Marva Realty Corp.

ADDRESS 354 Chapel View Drive PHONE HO 5-5370

PROPERTY LOCATION:

SUBDIVISION Chapel View LOT NO. 26, Sec. 3

ROAD AND DESCRIPTION Chapel View Drive

OCCUPANT _____ PHONE _____

PERSON TO CONSTRUCT SYSTEM _____

ADDRESS _____ PHONE _____

SIZE OF LOT 1/2 acre TYPE BLDG. 4
NUMBER OF BEDROOMS

IF NOT SINGLE RESIDENCE DESCRIBE _____

SIGNATURE OF APPLICANT Joseph Kenney


APPROVED BY Raymond Hodges FOR Leaching Bed DATE 14 OCT 64
(KIND OF SYSTEM)

REJECTED BY _____ FOR _____ DATE _____
(KIND OF SYSTEM)

HOLD PENDING FURTHER TESTS _____ DATE _____

REASONS FOR REJECTION OR HOLDING _____

THIS IS NOT A PERMIT

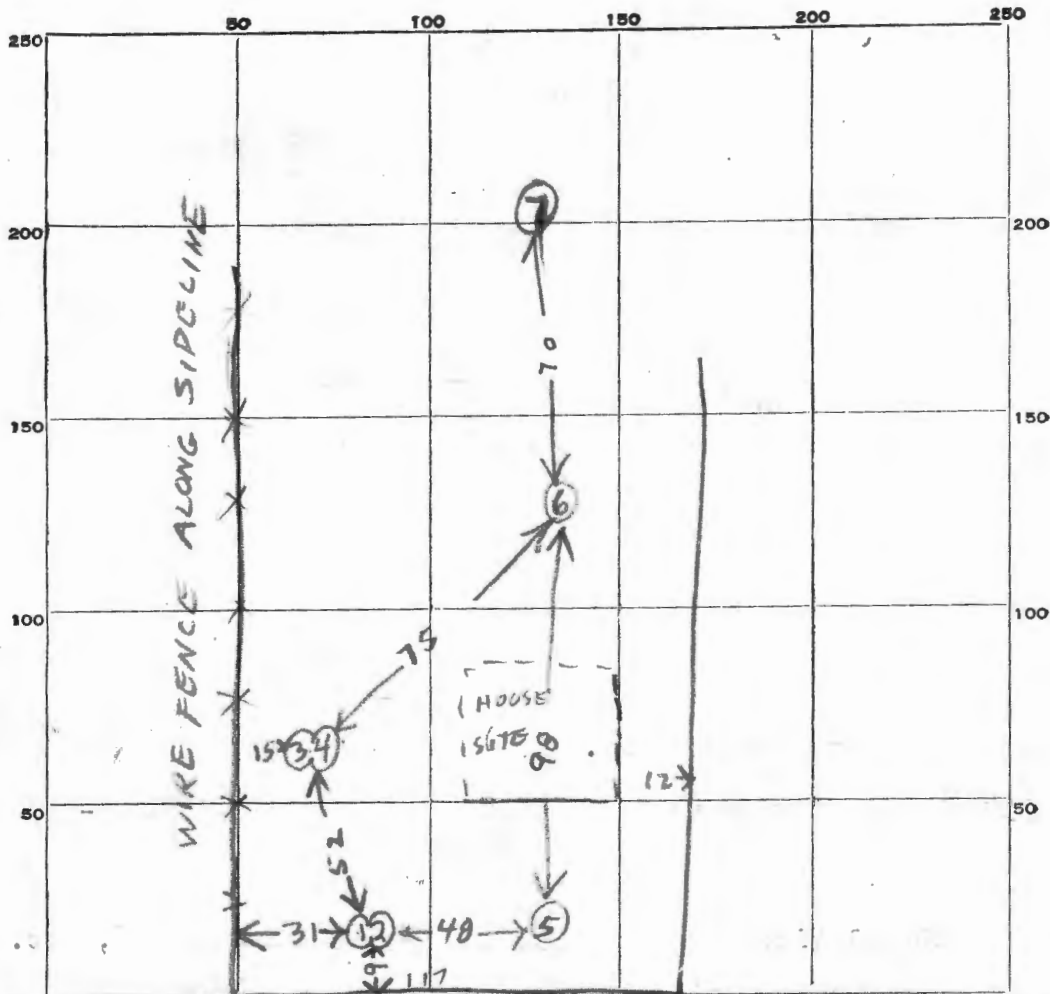

INDICATE NORTH. - NAME ADJOINING ROADWAY AS BASE LINE.

CHAPEL VIEW DRIVE TO ROGERS AVE. →

DATE	TEST NO.	DEPTH	PRE-WET		TEST - 1" DROP		TIME
			START	STOP	START	STOP	
4/9/64	1	9	9:41	10:41	10:41	11:01	little perc
"	2	5	9:43	9:50	9:50	10:03	13
"	3	9	9:56	→	→	10:27	16
"	4	5	9:59	10:20	10:20	10:52	32
"	5	5	Not tested		Hot Rock		
"	6	5	"	"	"	"	
"	7	6	"	"	"	"	

SOIL AUGER FINDING _____

TESTED BY _____

REMARKS _____

ALSO PRESENT _____

LOT NO. _____

Raymond Kedges

Stedman

Handwritten notes on the right side of the page, including '66', '12', '15 30', '153 0', '110', '13', '90', '101', '25', and '32'.