

APPLICATION

rel
11/24/78
1:30 P.M.

SEWAGE DISPOSAL TESTING

STATE OF MARYLAND - DEPARTMENT OF HEALTH AND MENTAL HYGIENE

A 29202

P _____

HOWARD COUNTY HEALTH DEPARTMENT
ENVIRONMENTAL HEALTH SERVICES
P.O. BOX 476 ELLICOTT, MARYLAND 21043
TELEPHONE: 992-2330

DISTRICT 5th

DATE 11/9/78

spec - next page

TO: THE COUNTY HEALTH OFFICER
ELLICOTT CITY, MARYLAND

I, HEREBY, APPLY FOR THE NECESSARY TEST IN ORDER TO CONSTRUCT (OR RECONSTRUCT) A SEWAGE DISPOSAL SYSTEM.

PROPERTY OWNER Edward L. Cochran and Wife

ADDRESS Pindell School Road PHONE _____

PROPERTY LOCATION

SUBDIVISION _____ LOT NO _____

ROAD AND DESCRIPTION Pindell School Road

SIZE OF LOT ? TYPE BLDG. 3 or 4 bedrooms

THE SYSTEM INSTALLED UNDER THIS APPLICATION IS ACCEPTABLE ONLY UNTIL PUBLIC FACILITIES BECOME AVAILABLE.

I FULLY UNDERSTAND THE FEE CONNECTED WITH THE FILING OF THIS PERC TEST APPLICATION IS NON-REFUNDABLE UNDER ANY CIRCUMSTANCES.

SIGNATURE OF APPLICANT /s/ Fisher, Collins & Carter, Inc., Consulting Engineers, 8388 Court Avenue, Ellicott City, Md.

APPROVED BY _____ FOR _____ DATE _____

REJECTED BY _____ FOR _____ DATE _____


HOLD PENDING FURTHER TESTS _____ DATE _____

REASONS FOR REJECTION OR HOLDING _____

THIS IS NOT A PERMIT

SOIL PROFILE

0-13
sandy
loam
Mucor
little clay

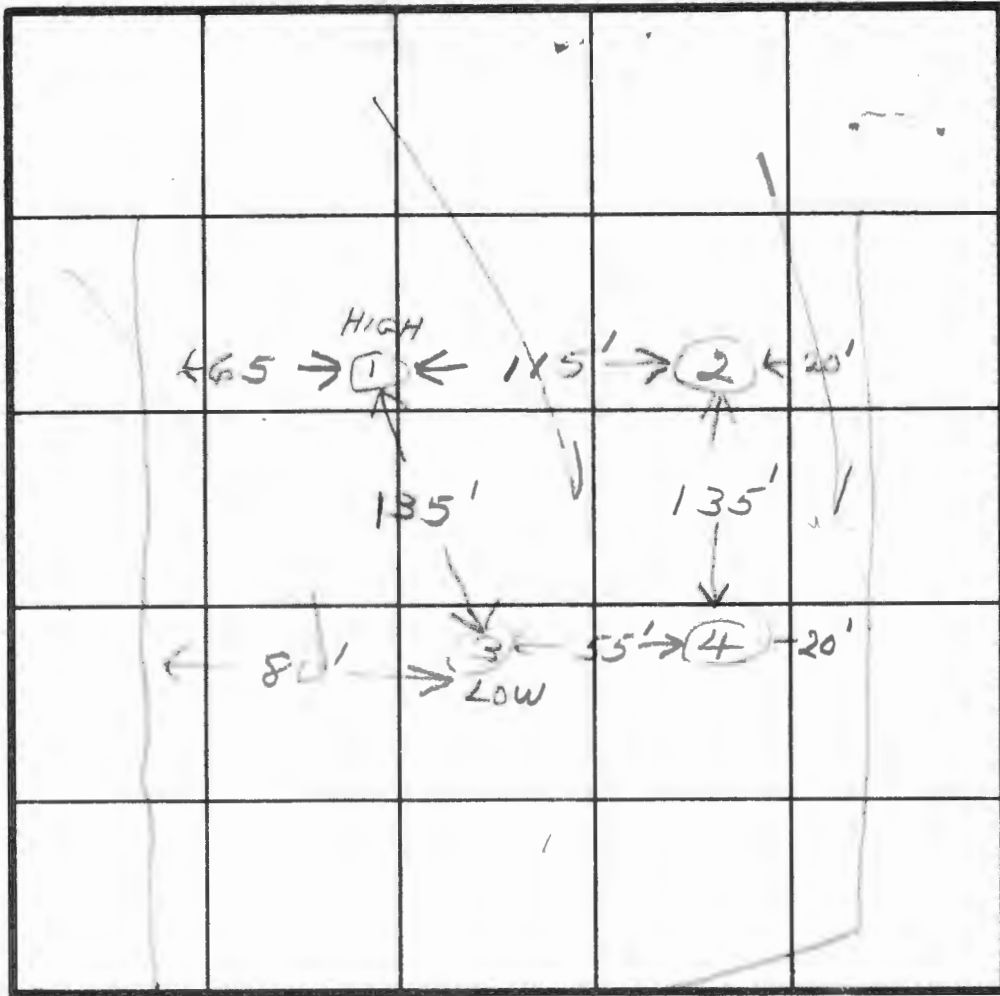

INDICATE NORTH - NAME ADJOINING ROADWAY AS BASE LINE.

PINDELL SCHOOL RD

DATE	TEST NO.	DEPTH	PRE-WET		TEST - 1" DROP		TIME
			START	STOP	START	STOP	
11/24/78	1 S	4	1:31	1:37	1:37	1:46	9
	1 D	13	1:31	1:38	1:38	1:44	6
	2	13	VISUAL				
	3 S	4 1/2	1:46	1:50	1:50	1:54	4
	3-D	12	1:47	1:51	1:51	1:55	4
	4 S	4	1:55	1:57	1:57	2:01	4
	4 D	13	1:55	2:00	2:00	2:06	6

REMARKS _____

TYPE OF SOIL soil consistent

TESTED BY [Signature] ALSO PRESENT MR. COCHRAN
MR. ARNOLD

Cochran Property

3 bedroom - 1000 gal

4 bedroom - 1250 gal

Dry well to have 120 sq ft effective
absorbent sidewall area per bedroom
below inlet.


Inlet to be 3 ft below original
grade with maximum depth 12 ft. below org grade


Dry well to be located 450 ft from
the corner property line, west right side
- away from fence - and
65 ft from left property line

APPROVED: Private Water & Private Sewage Disposal System

Howard County Health Officer _____ Date _____

The lot shown complies with the minimum ownership & lot area as required by the Maryland State Dept. of Health and Mental Hygiene.

 Sewage Disposal Easement As required by State Dept. of Health and Mental Hygiene.

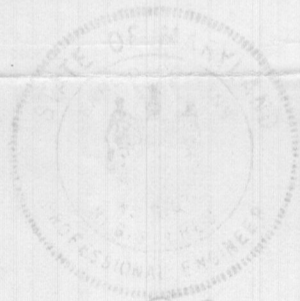

Ed L. Cochran

11/24/78
1:30 P.M.

APPROX. 600 TO SANNER RD.
PINDELL SCHOOL ROAD

FISHER, COLLINS & CARTER, Inc.
Consulting Engineers
8388 Court Avenue
Ellicott City, Md. 21043

PLAN TO ACCOMPANY
Application For Percolation Tests
Property of
Edward L. Cochran & Wife
5th Election District Howard Co., Md.
Scale 1"=100' November 6, 1978