

Must accompany state permit to be submitted signed by Reg. Engr. Road Serv.

APPLICATION

A 23750

P _____

Fill out in triplicate.
Make \$30.00 check payable:
Howard County Health Dept. - Sanitation

SEWAGE DISPOSAL TESTING

STATE OF MARYLAND - DEPARTMENT OF HEALTH AND MENTAL HYGIENE

DISTRICT 2nd

DATE 8/13/76

6/31/76
9:30
HOWARD COUNTY HEALTH DEPARTMENT
ENVIRONMENTAL HEALTH SERVICES
P. O. BOX 476, ELLICOTT CITY, MARYLAND 21043
TELEPHONE: 465-5000, EXT. 356

TO: THE COUNTY HEALTH OFFICER
ELLICOTT CITY, MARYLAND

I, HEREBY, APPLY FOR THE NECESSARY TEST IN ORDER TO CONSTRUCT (OR RECONSTRUCT) A SEWAGE DISPOSAL SYSTEM.

PROPERTY OWNER Dorothea A Hargadon

ADDRESS 5023 Frederick Ave. PHONE 644-6145

PROPERTY LOCATION: off of new cut Road

SUBDIVISION Right in the center of Worthing LOT NO. 1

ROAD AND DESCRIPTION Dirt Road in very good condition

SIZE OF LOT 6 acres TYPE BLDG. 3 or 4 bedrooms
NONE NUMBER OF BEDROOMS

IF NOT SINGLE RESIDENCE DESCRIBE _____

THE SYSTEM INSTALLED UNDER THIS APPLICATION IS ACCEPTABLE ONLY UNTIL PUBLIC FACILITIES BECOME AVAILABLE.

SIGNATURE OF APPLICANT Dorothea A. Hargadon

APPROVED BY _____ FOR _____ DATE _____
(KIND OF SYSTEM)

REJECTED BY _____ FOR _____ DATE _____
(KIND OF SYSTEM)

HOLD PENDING FURTHER TESTS _____ DATE _____

REASONS FOR REJECTION OR HOLDING _____

THIS IS NOT A PERMIT

APPLICATION

SEWAGE DISPOSAL TESTING

STATE OF MARYLAND - DEPARTMENT OF HEALTH AND MENTAL HYGIENE

HOWARD COUNTY HEALTH DEPARTMENT
ENVIRONMENTAL HEALTH SERVICES
P. O. BOX 476, ELLICOTT CITY, MARYLAND 21043
TELEPHONE: 465-5000, EXT. 356

A _____

P _____

DISTRICT _____

DATE _____

TO: THE COUNTY HEALTH OFFICER
ELLICOTT CITY, MARYLAND

I, HEREBY, APPLY FOR THE NECESSARY TEST IN ORDER TO CONSTRUCT (OR RECONSTRUCT) A SEWAGE DISPOSAL SYSTEM.

PROPERTY OWNER _____

ADDRESS _____ PHONE _____

PROPERTY LOCATION:

SUBDIVISION _____ LOT NO. _____

ROAD AND DESCRIPTION _____

SIZE OF LOT _____ TYPE BLDG. _____
NUMBER OF BEDROOMS

IF NOT SINGLE RESIDENCE DESCRIBE _____

THE SYSTEM INSTALLED UNDER THIS APPLICATION IS ACCEPTABLE ONLY UNTIL PUBLIC FACILITIES BECOME AVAILABLE.

SIGNATURE OF APPLICANT _____

APPROVED BY _____ FOR _____ DATE _____
(KIND OF SYSTEM)

REJECTED BY _____ FOR _____ DATE _____
(KIND OF SYSTEM)

HOLD PENDING FURTHER TESTS _____ DATE _____

REASONS FOR REJECTION OR HOLDING _____

THIS IS NOT A PERMIT

Boundary plat must be submitted signed by Reg. Eng. Road Surv.

APPLICATION

Fill out in triplicate -
Make \$30.00 check payable:
Howard County Health Dept. - Sanitation

A 23730

SEWAGE DISPOSAL TESTING

P _____

STATE OF MARYLAND - DEPARTMENT OF HEALTH AND MENTAL HYGIENE

DISTRICT 2nd

DATE 8/13/76

8/31/76
9:30
HOWARD COUNTY HEALTH DEPARTMENT
ENVIRONMENTAL HEALTH SERVICES
P. O. BOX 476, ELLICOTT CITY, MARYLAND 21043
TELEPHONE: 465-5000, EXT. 356

11/10/76
9:30
5/3/77 - no one showed
9:30 a.m.

TO: THE COUNTY HEALTH OFFICER
ELLICOTT CITY, MARYLAND

I, HEREBY, APPLY FOR THE NECESSARY TEST IN ORDER TO CONSTRUCT (OR RECONSTRUCT) A SEWAGE DISPOSAL SYSTEM.

PROPERTY OWNER Dorothea A Hargadon

ADDRESS 5023 Frederick Ave. PHONE 644-6145

PROPERTY LOCATION: off of new cut Road
SUBDIVISION Right in the center of Worthing LOT NO. 1

ROAD AND DESCRIPTION Dirt Road in very good condition

SIZE OF LOT 6 acres TYPE BLDG. 3 or 4 bedrooms
NONE NUMBER OF BEDROOMS

IF NOT SINGLE RESIDENCE DESCRIBE _____

THE SYSTEM INSTALLED UNDER THIS APPLICATION IS ACCEPTABLE ONLY UNTIL PUBLIC FACILITIES BECOME AVAILABLE.

SIGNATURE OF APPLICANT Dorothea A. Hargadon

APPROVED BY _____ FOR _____ DATE _____
(KIND OF SYSTEM)


REJECTED BY _____ FOR _____ DATE _____
(KIND OF SYSTEM)

HOLD PENDING FURTHER TESTS WWB DATE 8/31/76

REASONS FOR REJECTION OR HOLDING Inauff. tests

Lot #
1

THIS IS NOT A PERMIT

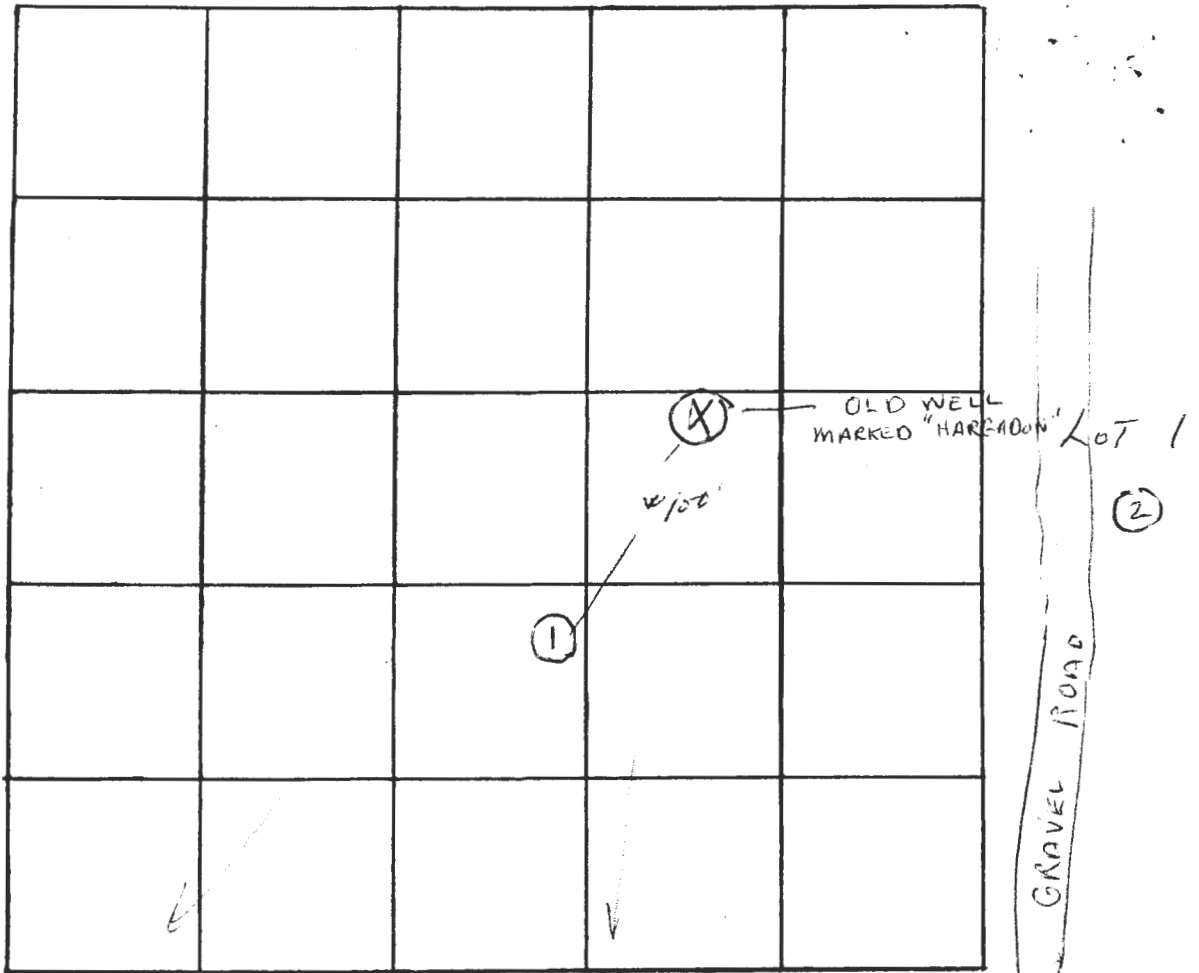

INDICATE NORTH. - NAME ADJOINING ROADWAY AS BASE LINE.

DATE	TEST NO.	DEPTH	PRE-WET		TEST - 1" DROP		TIME
			START	STOP	START	STOP	
8/31/76	1	8 1/2'	Granite type rock @	8 1/2'			
	2	12'	All clay to	28'			
			Sandy type soil - not tested due to lack of suff. area.				

REMARKS _____

TYPE OF SOIL _____

TESTED BY WWZ ALSO PRESENT: Carol Amigo, Crest Realty

Dear Sir

Enclosed find check for
60.00 Ten Quik Test

I received your form &
filled them out and
also sent package of
my ground.

It is in center of Washington
St

Please return same to
me -

Barthol A. Mergader
5023 Frederick Ave

Balt. Md 21229

Lots - 1 and 2
are my lots
The ones to be perked
~~tested~~

Please return my black
plot of ground Thanks

APPLICATION

A _____

P _____

SEWAGE DISPOSAL TESTING

STATE OF MARYLAND - DEPARTMENT OF HEALTH AND MENTAL HYGIENE

HOWARD COUNTY HEALTH DEPARTMENT
ENVIRONMENTAL HEALTH SERVICES
P. O. BOX 476, ELLICOTT CITY, MARYLAND 21043
TELEPHONE: 465-5000, EXT. 356

DISTRICT _____

DATE _____

TO: THE COUNTY HEALTH OFFICER
ELLICOTT CITY, MARYLAND

I, HEREBY, APPLY FOR THE NECESSARY TEST IN ORDER TO CONSTRUCT (OR RECONSTRUCT) A SEWAGE DISPOSAL SYSTEM.

PROPERTY OWNER _____

ADDRESS _____ PHONE _____

PROPERTY LOCATION:

SUBDIVISION _____ LOT NO. _____

ROAD AND DESCRIPTION _____

SIZE OF LOT _____ TYPE BLDG. _____
NUMBER OF BEDROOMS _____

IF NOT SINGLE RESIDENCE DESCRIBE _____

THE SYSTEM INSTALLED UNDER THIS APPLICATION IS ACCEPTABLE ONLY UNTIL PUBLIC FACILITIES BECOME AVAILABLE.

SIGNATURE OF APPLICANT _____

APPROVED BY _____ FOR _____ DATE _____
(KIND OF SYSTEM)

REJECTED BY _____ FOR _____ DATE _____
(KIND OF SYSTEM)


HOLD PENDING FURTHER TESTS _____ DATE _____

REASONS FOR REJECTION OR HOLDING _____

THIS IS NOT A PERMIT

③
 0
 6 clay
 13 sandy from
 regmatite

⑤
 0
 2-3 clay
 sandy
 12

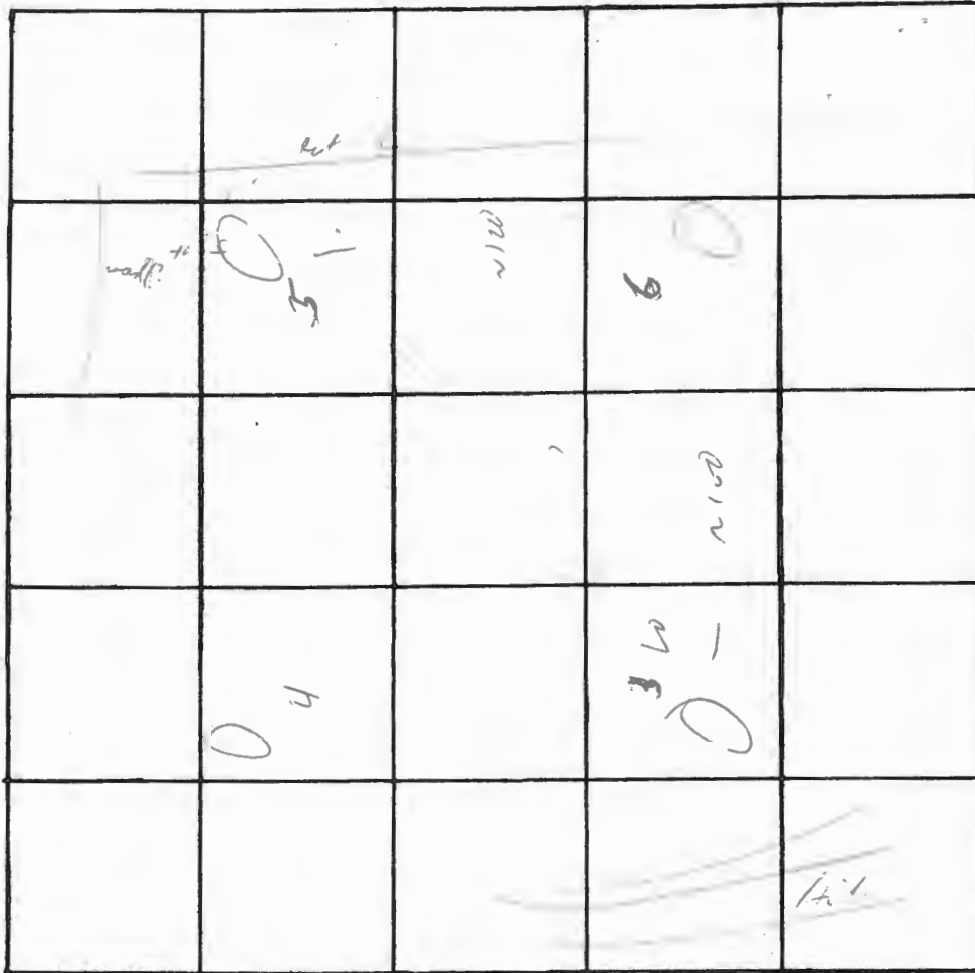

INDICATE NORTH. - NAME ADJOINING ROADWAY AS BASE LINE.

DATE	TEST NO.	DEPTH	PRE-WET		TEST - 1" DROP		TIME
			START	STOP	START	STOP	
11/10/71	3	6	11 24	11 32	11 32	11 45	13
	3A	12	11 24	11 32	11 32	11 45	13
	4	3	11 55	12 12	12 15	12 14	20
	4A	12	11 55	12 04	12 04	12 18	14
	5	12	11 45	11 49	11 49	11 51	2
	6	4	11 20	11 27	11 27	11 40	13
	6A	12	11 20	11 22	11 2	11 27	5

REMARKS _____

TYPE OF SOIL _____

TESTED BY MA _____

ALSO PRESENT: _____



Plot of land described in deed from Clara Kraft and William E. Kraft, Adms.
 to Emma A Pierson, dated February 3, 1948, Liber M.W.B. No. 202 folio
 491 c., situate in the 2nd District, Howard County, Maryland.
 August 26, 1949. Scale 1" = 200.

J. Harry Keller
 Land Surveyor No. 250


Approved: For private water and private
sewage systems. Howard County
Health Department

Joyce Boyd 12-22-76
County Health Officer Date

Note: The lot shown hereon complies with minimum ownership width and lot area as required by the Maryland State Department of Health and Mental Hygiene Regulations.

LEGEND

- ⊕ Field location of percolation test hole.
- ⊙ Approximate location of well.
- ⊠ Approximate location of dwelling.

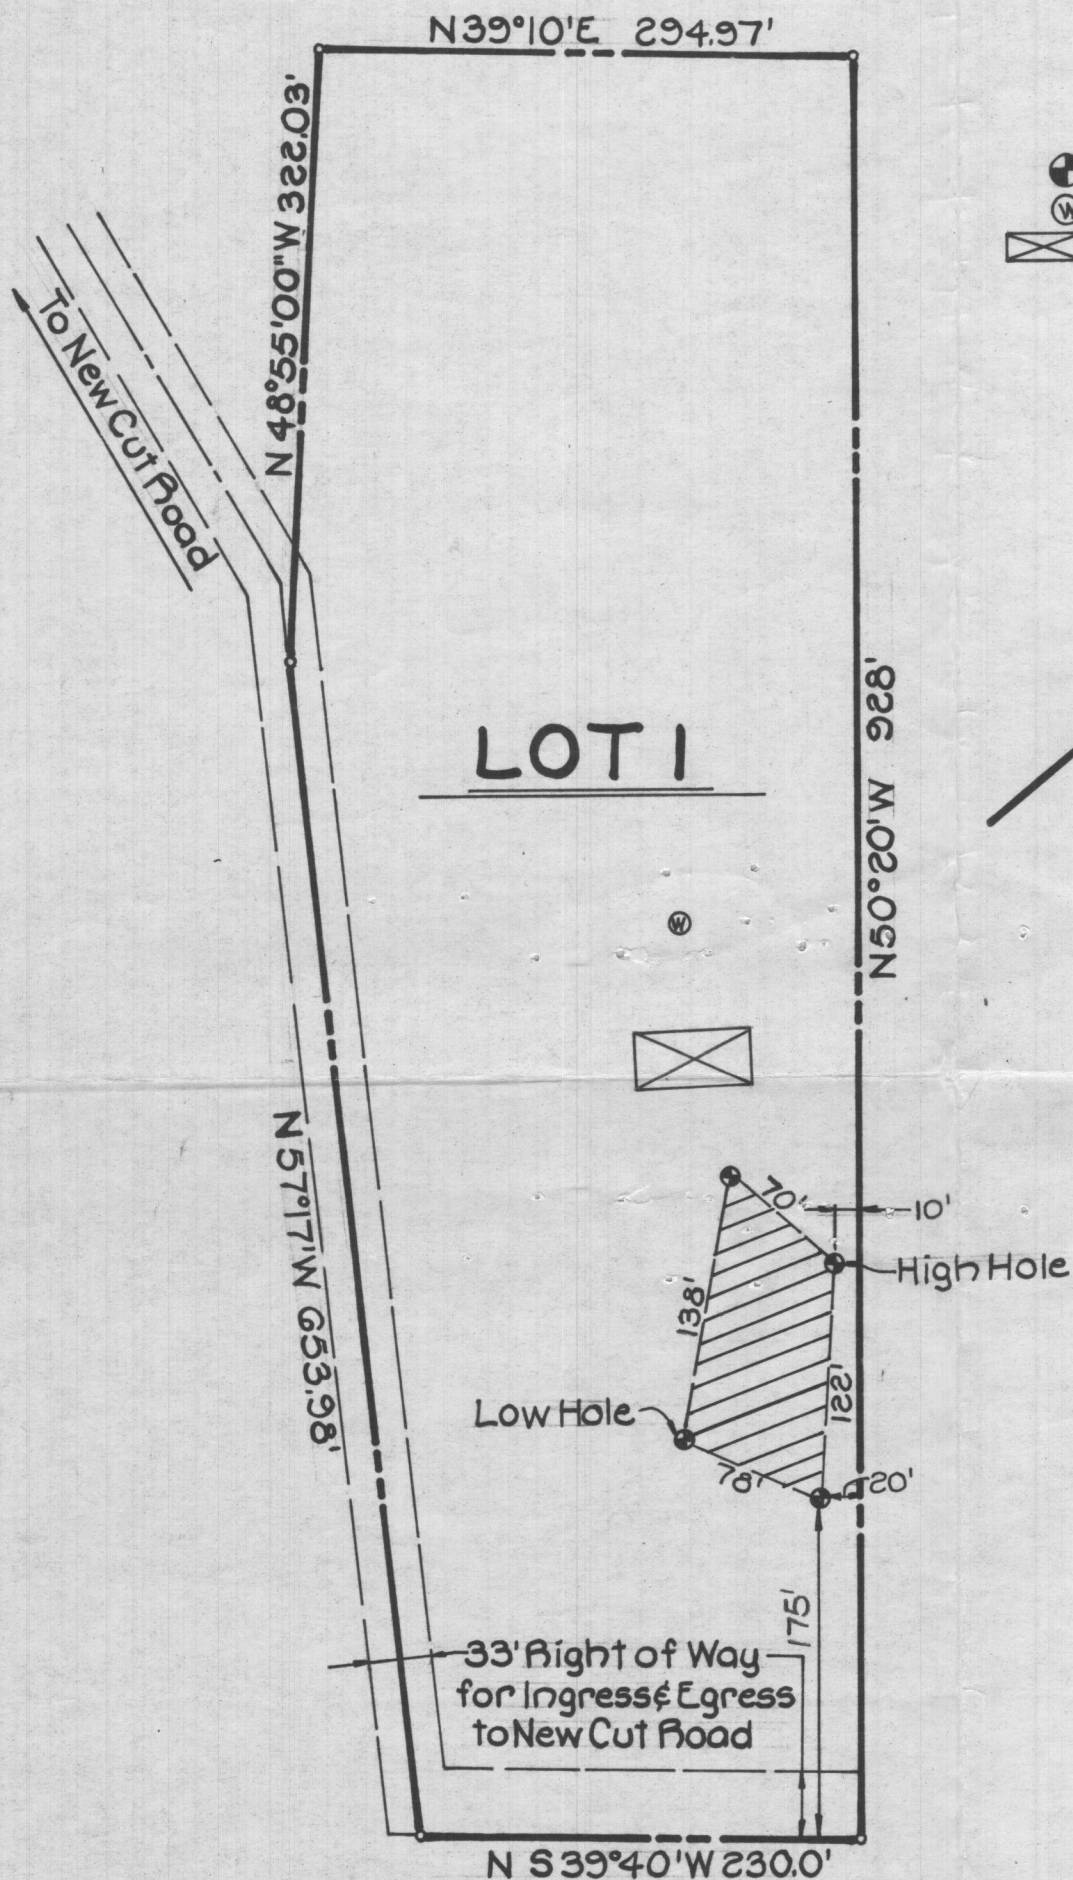

LAND SURVEYOR'S CERTIFICATE

I hereby certify the measurements for the sewage disposal area, and the sewage disposal area is as designated.

Walter Park
Walter Park Land Surveyor
Md. Reg. #5539

CROVO & ASSOCIATES, INC.

CIVIL ENGINEERING &
LAND SURVEYING
8669 OAK ROAD
BALTIMORE, MARYLAND 21234

PLAN FOR APPROVAL OF
PRIVATE WATER & PRIVATE SEWAGE SYSTEMS
PROPERTY OF
DOBROTHEA A. HARGADON
2ND ELECTION DISTRICT HOWARD COUNTY, MD.
DECEMBER 13, 1976 SCALE: 1"=100'