

# APPLICATION

A 19893

## SEWAGE DISPOSAL TESTING

P. \_\_\_\_\_

STATE OF MARYLAND - DEPARTMENT OF HEALTH AND MENTAL HYGIENE

HOWARD COUNTY HEALTH DEPARTMENT *Septic Tank - 1250 gal.* DISTRICT 5  
ENVIRONMENTAL HEALTH SERVICES *Dry Well - 500 gal.* DATE 5/3/74  
P. O. BOX 476, ELLICOTT CITY, MARYLAND 21043  
TELEPHONE: 465-5000, EXT. 356

*about 2000' area to be in  
below the inlet. Maximum depth permitted per dry well  
is 11 1/2 ft. Locate dry well 70 ft. from left side line and  
110 ft. from front lot line as seen from Murphy Rd.*

*House will have to be set 125' ft back from  
front lot line*

TO: THE COUNTY HEALTH OFFICER  
ELLICOTT CITY, MARYLAND

I, HEREBY, APPLY FOR THE NECESSARY TEST IN ORDER TO CONSTRUCT (OR RECONSTRUCT) A SEWAGE DISPOSAL SYSTEM.

PROPERTY OWNER Charles E. Inger, Jr., et al

ADDRESS Route 216, Fulton, Md. PHONE \_\_\_\_\_

PROPERTY LOCATION:

SUBDIVISION \_\_\_\_\_ LOT NO. 1

ROAD AND DESCRIPTION Murphy Road near Stabean Drive

SIZE OF LOT 0.918 acres TYPE BLDG. 3 or 4

NUMBER OF BEDROOMS \_\_\_\_\_

IF NOT SINGLE RESIDENCE DESCRIBE \_\_\_\_\_

THE SYSTEM INSTALLED UNDER THIS APPLICATION IS ACCEPTABLE ONLY UNTIL PUBLIC FACILITIES BECOME AVAILABLE.

SIGNATURE OF APPLICANT /s/ C. Ellsworth Inger

APPROVED BY Robert Towner FOR Dry Well DATE 5/13/74  
(KIND OF SYSTEM)


REJECTED BY \_\_\_\_\_ FOR \_\_\_\_\_ DATE \_\_\_\_\_  
(KIND OF SYSTEM)

HOLD PENDING FURTHER TESTS \_\_\_\_\_ DATE \_\_\_\_\_

REASONS FOR REJECTION OR HOLDING \_\_\_\_\_

# THIS IS NOT A PERMIT

A 1989.3

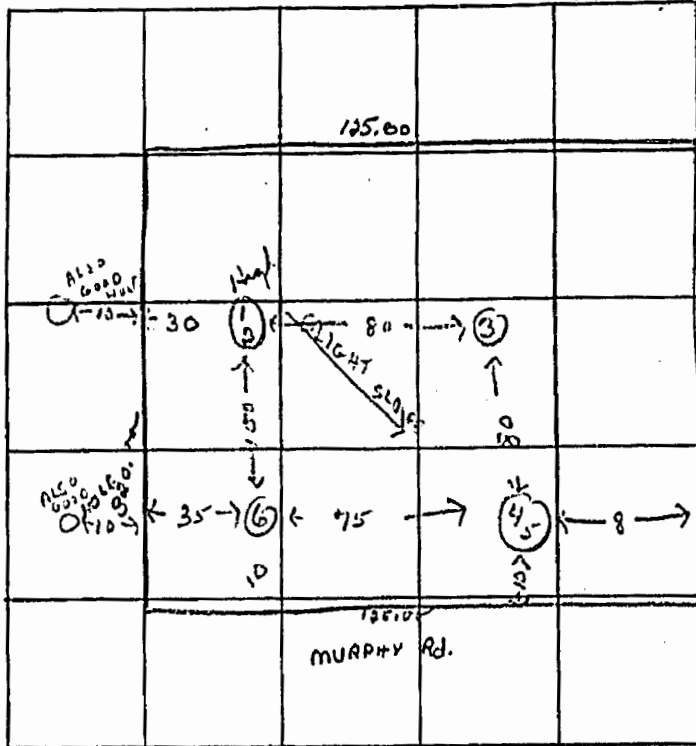

INDICATE NORTH. - NAME ADJOINING ROADWAY AS BASE LINE.

DATE	TEST NO.	DEPTH	PRE-WET		TEST - 1" DROP		TIME	
			START	STOP	START	STOP		
5/10/74	1	11 1/2 ft.	2:22	2:25	2:25	2:29	4 min.	
	2	3 ft.	2:22	2:25	2:29		7 min.	
	3	11 1/2 ft.	Good	out.				
	4	11 1/2 ft.	2:33	2:33	2:40		7 min.	
	5	4 ft.	2:33	2:33	2:39		6 min.	
	6	10 1/2 ft.	Same	out.				
		Sample - mica - Tuffaceous						0.

REMARKS System will have to be installed 100 ft back and 10 ft up from line 125.00

TYPE OF SOIL \_\_\_\_\_

TESTED BY R.T. ALSO PRESENT: \_\_\_\_\_