

Howard County Health Dept. - Baltimore
Make \$15.00 check payable to
the Dept. of Health

APPLICATION

A 15363

P _____

SEWAGE DISPOSAL TESTING

MARYLAND STATE DEPARTMENT OF HEALTH

HOWARD COUNTY

ELLICOTT CITY

DISTRICT Third

DATE 6-30-70

TO: THE COUNTY HEALTH OFFICER
ELLICOTT CITY, MARYLAND

I, HEREBY, APPLY FOR THE NECESSARY TESTS IN ORDER TO CONSTRUCT (OR RECONSTRUCT) A SEWAGE DISPOSAL SYSTEM.

PROPERTY OWNER Mrs. Roberta C. Crist

ADDRESS 2340 Monument Avenue, Richmond, Va. 23220 PHONE 703-353-0700

PROPERTY LOCATION:

SUBDIVISION _____ LOT NO. _____

ROAD AND DESCRIPTION Tridelphia Road, Glenelg, Maryland adjacent to Tommy Sullivan
for a more detailed designation Call Mrs. Howard G. Crist, Sr. in Glenelg.

OCCUPANT None - vacant lot PHONE _____

PERSON TO CONSTRUCT SYSTEM Not selected as yet - Person to conduct test
John Fyock

ADDRESS Glenelg, Maryland PHONE _____

SIZE OF LOT 1.018 acre TYPE BLDG 6
NUMBER OF BEDROOMS

IF NOT SINGLE RESIDENCE DESCRIBE two family duplex

SIGNATURE OF APPLICANT Roberta C. Crist

APPROVED BY _____ FOR _____ DATE _____
(KIND OF SYSTEM)

REJECTED BY Don Monaghan FOR Septic System DATE 7-29-70
(KIND OF SYSTEM)


HOLD PENDING FURTHER TESTS _____ DATE _____

REASONS FOR REJECTION OR HOLDING 1/21/70 - no permit - high water

THIS IS NOT A PERMIT

21
2
102

JUL 2 8 48 AM '70
HOWARD COUNTY
HEALTH DEPT.
ELLICOTT CITY, MD.

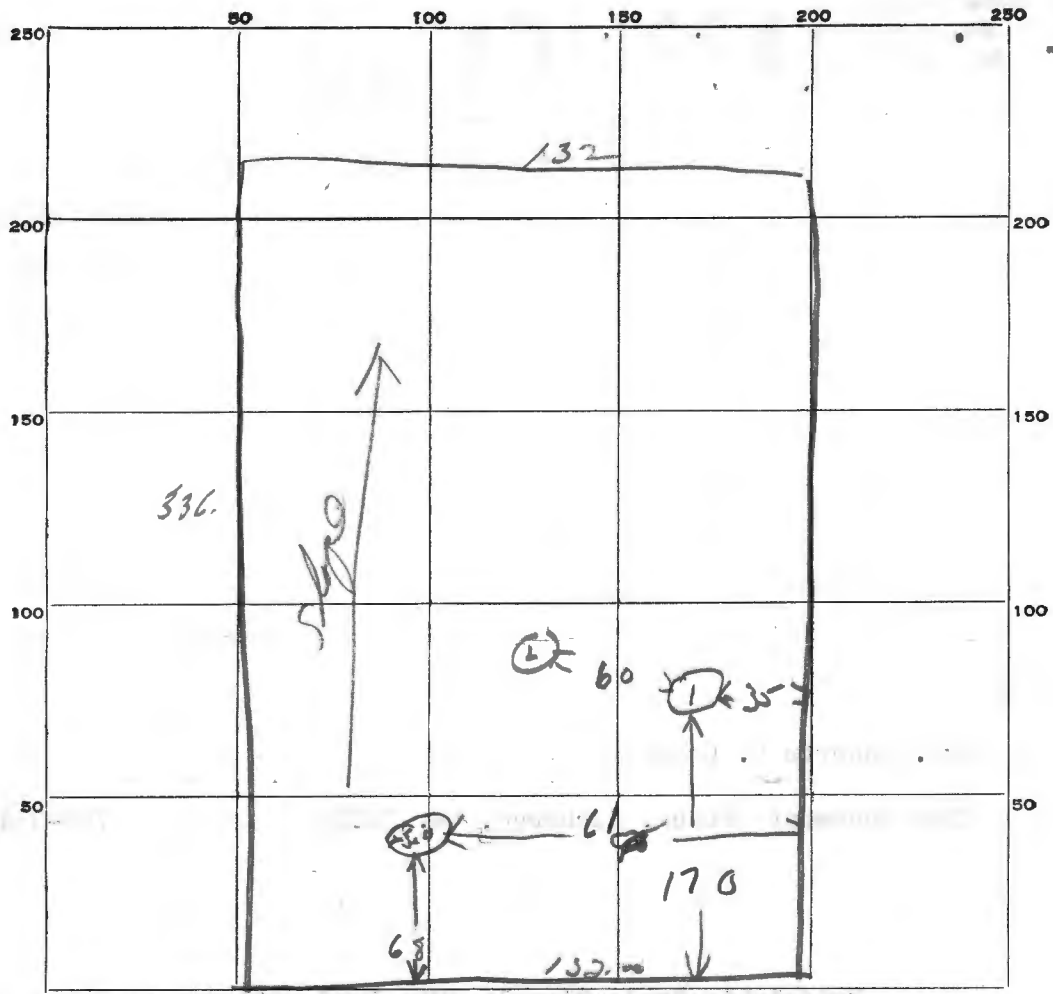

Triadelphia Rd

DATE	TEST NO.	DEPTH	PRE-WET		TEST - 1" DROP		TIME
			START	STOP	START	STOP	
7/29/70	1	4ft	all	clay -	water	in bottom of pit	
	2	8ft	all	clay			
	3	10ft	9 ⁵⁴		stop test - no perc		
	4	7ft	9 ⁵⁴		stop test - no perc		

SOIL AUGER FINDING _____

TESTED BY Dun

REMARKS _____

who present - Jack & Frock

Proteinizing?
Record'd
7/29/70
9:30

APPLICATION

A 15353

SEWAGE DISPOSAL TESTING

P _____

MARYLAND STATE DEPARTMENT OF HEALTH

HOWARD COUNTY

ELLICOTT CITY

DISTRICT Third

DATE 6-30-70

TO: THE COUNTY HEALTH OFFICER
ELLICOTT CITY, MARYLAND

I, HEREBY, APPLY FOR THE NECESSARY TESTS IN ORDER TO CONSTRUCT (OR RECONSTRUCT) A SEWAGE DISPOSAL SYSTEM.

PROPERTY OWNER Mrs. Roberta C. Crist

ADDRESS 2340 Monument Avenue, Richmond, Va. 23220 PHONE 703-353-0700

PROPERTY LOCATION:

SUBDIVISION _____ LOT NO. _____

ROAD AND DESCRIPTION Tridelphia Road, Glenelg, Maryland adjacent to Tommy Sullivan

for a more detailed designation Call Mrs. Howard G. Crist, Sr. in Glenelg.

OCCUPANT None - vacant lot PHONE _____

PERSON TO CONSTRUCT SYSTEM Not selected as yet - Person to conduct test
John Fyock

ADDRESS Glenelg, Maryland PHONE _____

SIZE OF LOT 1.018 acre TYPE BLDG. 5
NUMBER OF BEDROOMS _____

IF NOT SINGLE RESIDENCE DESCRIBE two family duplex

SIGNATURE OF APPLICANT Roberta C. Crist


APPROVED BY _____ FOR _____ (KIND OF SYSTEM) DATE _____

REJECTED BY Dr. Monaghan FOR Septic System (KIND OF SYSTEM) DATE 7-29-70

HOLD PENDING FURTHER TESTS _____ DATE _____

REASONS FOR REJECTION OR HOLDING 7/29/70 - repair - high water

THIS IS NOT A PERMIT

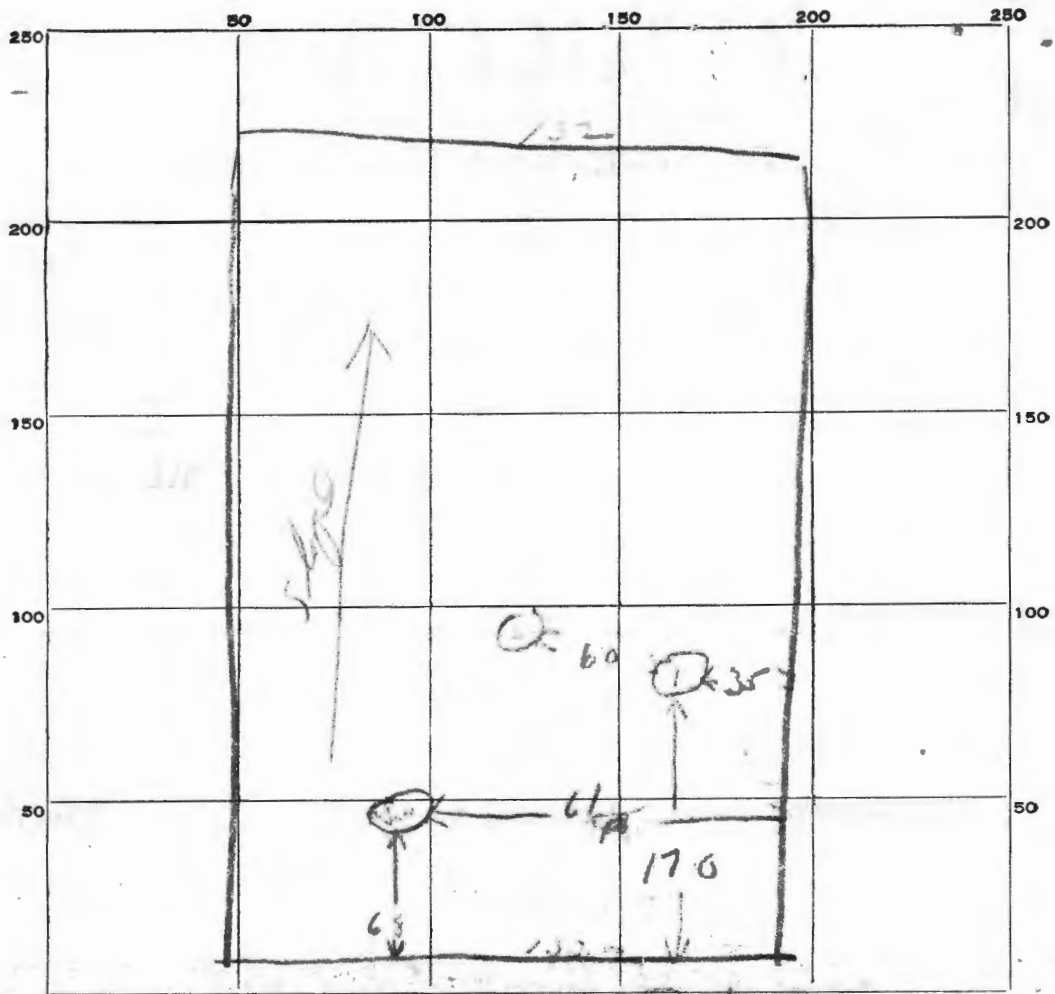

INDICATE NORTH. - NAME ADJOINING ROADWAY AS BASE LINE.

Madison St

DATE	TEST NO.	DEPTH	PRE-WET		TEST - 1" DROP		TIME
			START	STOP	START	STOP	
1/11/76	1	4 ft	all day	water	water	lit	pat
	2	8 ft	all day				
	3	10 ft	9 ³⁰	stop test	no	perc	
	4	7 ft	9 ³⁰	stop test	no	perc	

SOIL AUGER FINDING

TESTED BY

REMARKS

Jack & Zook

August 10, 1971

RECEIVED

SEP 15 1971
HOWARD COUNTY HEALTH DEPT
ELLICOTT CITY, MD

Howard County Health Department
Septic Tank Section
Ellicott City, Maryland

Dear Sirs:

I have a lot on the Tridelphia Road near Glenelg which would not pass the percolation test.

Are there any other acceptable ways to put in a septic system? Can you prepare an area with sand and gravel and then cover the drain field with fill dirt?

I would certainly like to build a house on it, but I may never live long enough for public sewers to arrive in that area. Do you have any suggestions?

Sincerely,

R.C. Crist

Mrs. R. C. Crist
2340 Monument Avenue
Richmond, Virginia 23220

*2 Mrs. Crist
I regret that a State Law prohibits
the use of a septic tank on Tridelphia Rd. Glenelg. I will
be in contact with you regarding this.*

August 24, 1971

Mrs. R. C. Crist
2340 Monument Avenue
Richmond, Virginia 23220

Dear Mrs. Crist:

We regret to inform you that the State Law prohibits us from approving your lot on Triadelphia Road, Glenelg, Maryland, until such time as you obtain minimum percolation test results.

Very truly yours,

Palmer F. Wine, Director
Environmental Health

PFW:jr

RECEIVED

AUG 4 9 58 AM '70

August 3, 1970

HOWARD COUNTY
HEALTH DEPT.
ELLICOTT CITY, MD.

Howard County Health Department
Sanitation Division
Ellicott City, Maryland

Dear Sirs:

I recently had the land which I own on Tridelphia Road in Glenelg tested for percolation. Mr. Jack Fyeck, Jr. tells me that it did not pass the percolation test. This request was for a 6-bedroom residence. Would it have passed for a three bedroom residence?

Since I purchased this land with the intention of building a home, what alternatives do I have now? What is the possibility of public sewers being available in that area? Would appreciate your prompt reply. Thank you.

Very truly yours,

Roberta C. Crist

Mrs. Roberta C. Crist
2340 Monument Avenue
Richmond, Virginia 23220

1/6/70

Dear Mrs. Crist:

Your lot failed to pass the percolation test for any kind of residence. Public sewers are not available for your area at the time the county does not plan to serve that area. Of course that could change within the next 10 to 20 years. State law prohibits your building on the lot unless it passes a percolation test. Very truly yours,
Valerie E. Wilson

August 23, 1971

Howard County Health Department
Sanitation Division
Ellicott City, Maryland

Aug 23 1971
HOWARD COUNTY
HEALTH DEPT
ELLCOTT CITY, MD

Dear Sirs:

About three weeks ago I wrote and asked you to let me know if there were any other acceptable methods of sewerage disposal for land that would not pass a percolation test.


To date, I have not had a reply from you. I have been told that you can build up an absorption field and if this is true, please send me the details of such a system.

I would appreciate an early reply as I am most interested in building a house on my lot. (In Howard County)

Very truly yours,

R. C. Crist

Mrs. R. C. Crist
2340 Monument Avenue
Richmond, Virginia 23220

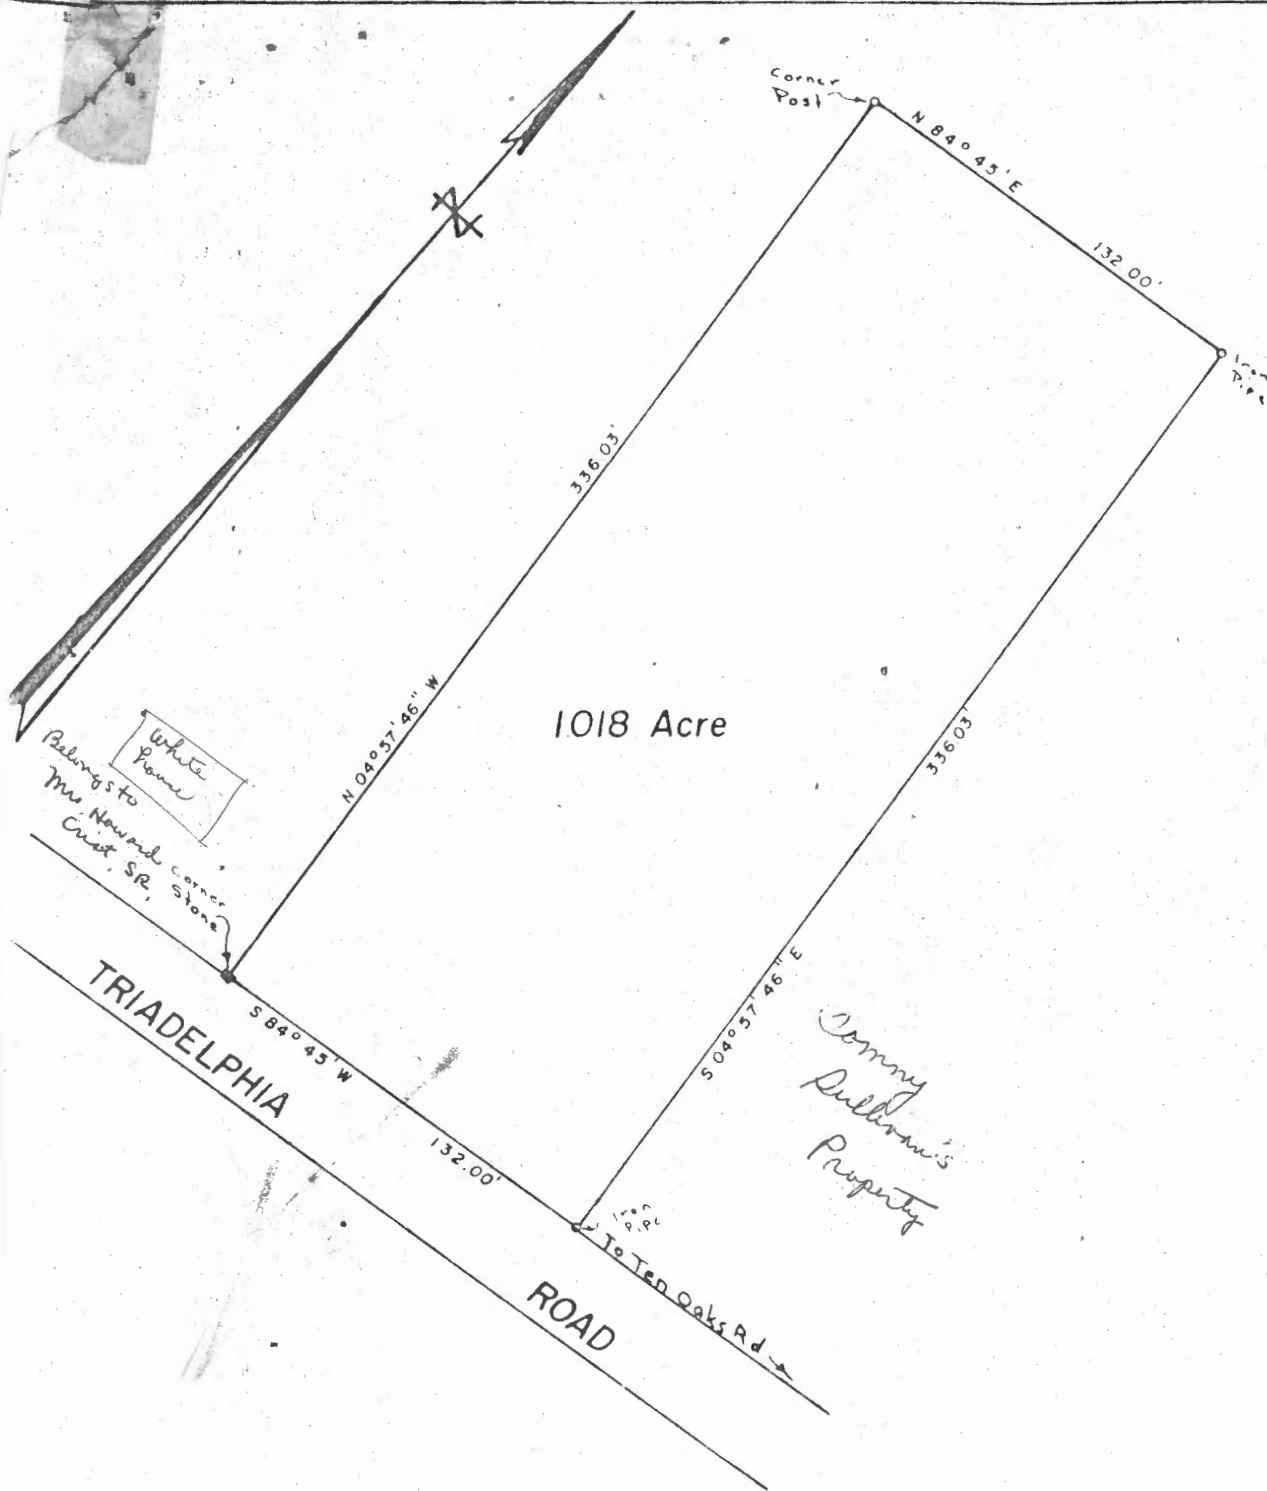

1018 Acre

White Pine
Belongs to
Mrs Howard Crist, SR,
corner Stone

Tommy
Pullman's
Property

TRIADELPHIA

ROAD

To Ten Oaks Rd

PLAT OF SURVEY
FOR
ROBERTA C. CRIST
THIRD ELECTION DISTRICT OF HOWARD COUNTY
GLENELG, MARYLAND
SCALE: 1 IN. = 60 FT. NOVEMBER 24, 1969

Claude M. Skinner Jr.

Claude M. Skinner Jr. Reg. Engineer & Land Surveyor No. 2237