

Howard County Health Dept. Sanitation Sewage Disposal Testing

APPLICATION

A 05580

P _____

MARYLAND STATE DEPARTMENT OF HEALTH

HOWARD COUNTY 7506 Gallon Tank

ELLICOTT CITY

Dry Well - 300 sq ft sidewalk area below the top 4 ft of clay

DISTRICT _____

DATE 8/6/62

Please place the dry well about 110 ft to 130 ft from the edge of Shady Lane and about 90 ft to 110 ft from the left side of the lot. That is the left side of the lot as seen when facing the lot.

TO: THE COUNTY HEALTH OFFICER
ELLICOTT CITY, MARYLAND

Shady Lane

I, HEREBY, APPLY FOR THE NECESSARY TESTS IN ORDER TO CONSTRUCT (OR RECONSTRUCT) A SEWAGE DISPOSAL SYSTEM.

PROPERTY OWNER MRS ANITA LA RICCI

*Mrs. Amelia Galac
1 Shady Lane
Hanover
Eh 1975*

ADDRESS 2031 EARLE ST.

PHONE 63-1597

PROPERTY LOCATION:

SUBDIVISION _____

LOT NO. _____

ROAD AND DESCRIPTION DIRT AND STONES

SHADY LANE OFF HANOVER RD.

OCCUPANT _____

PHONE _____

PERSON TO CONSTRUCT SYSTEM _____

ADDRESS _____

PHONE _____

SIZE OF LOT ACRE MORE OR LESS

TYPE BLDG. _____

NUMBER OF BEDROOMS 3

IF NOT SINGLE RESIDENCE DESCRIBE _____

SIGNATURE OF APPLICANT *Anita La Ricci*

APPROVED BY *Raymond Hodges* FOR Dry Well

DATE 17 AUG 62

REJECTED BY _____ FOR _____

DATE _____


HOLD PENDING FURTHER TESTS 8-8-62

DATE _____

REASONS FOR REJECTION OR HOLDING *8-8-62 dry well rejected due to lack of water in building*

14 AUG 62 No holes dug Back Hoe did not show up RT

THIS IS NOT A PERMIT

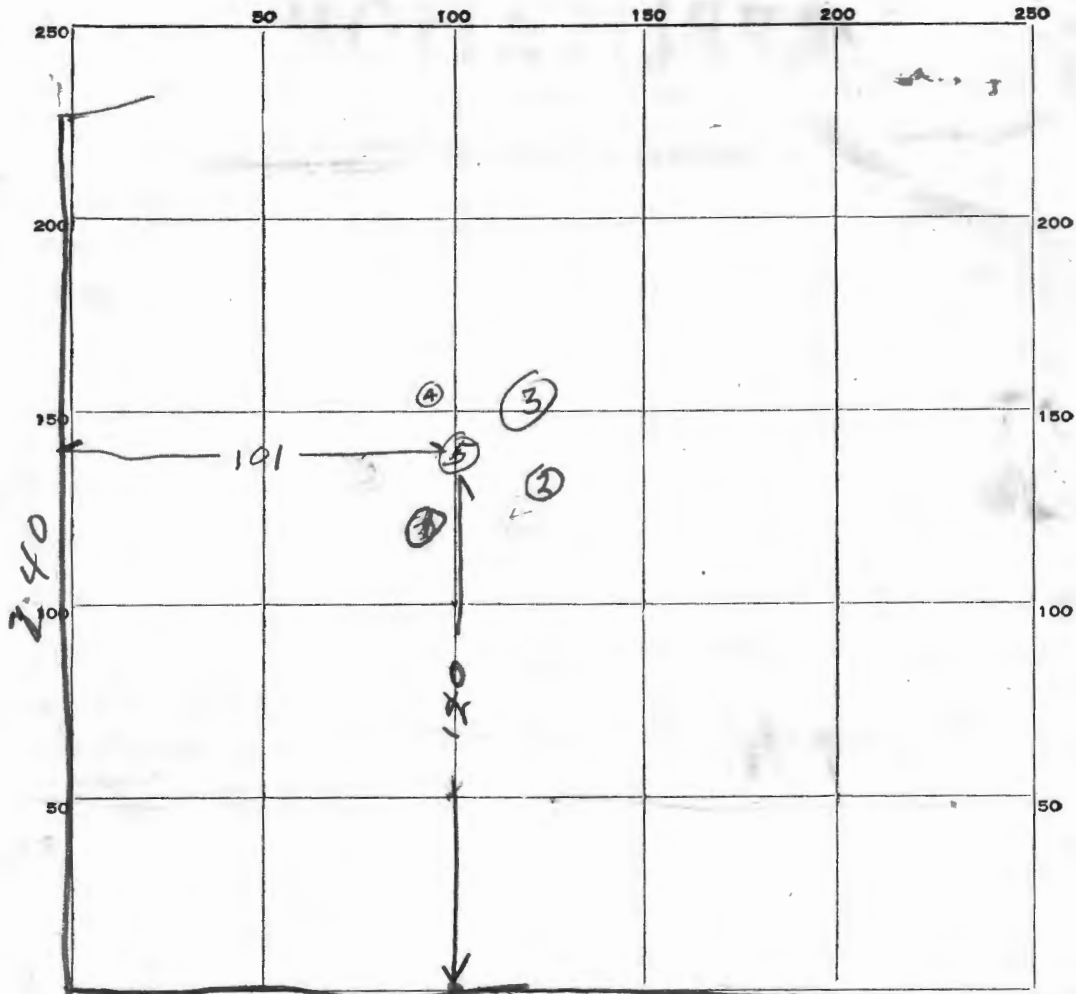

INDICATE NORTH. - NAME ADJOINING ROADWAY AS BASE LINE.

Shady Lane

DATE	TEST NO.	DEPTH	PRE-WET		TEST - 1" DROP		TIME
			START	STOP	START	STOP	
17 AUG 62	1	3	939	1020	no perc		
17 "	2	3	941	1020	little perc		
17 "	3	3	946	1020	no perc		
17 "	4	3	950	1020	little perc		
17 "	5	8	955	957	957	1004	7 min

*Top 4 ft clay
bottom of well*

SOIL AUGER FINDING

TESTED BY

Raymond Hodges

REMARKS

Lot includes shady lane

ALSO PRESENT

Paul D. Fitzgerald

LOT NO.