

LAYOUT 2/21/08 INSP 4 _____
INSP 2 2/27/08 INSP 5 _____
INSP 3 2/29/08 INSP 6 _____

ISSUE DATE: 2/8/2008 P 528491
APPROVAL DATE: 4/8/08 A 521638

PERMIT

Logged Into Permit Manager
TAX ID # 03346145

ON-SITE SEWAGE DISPOSAL SYSTEM HOWARD COUNTY HEALTH DEPARTMENT BUREAU OF ENVIRONMENTAL HEALTH

South Carroll Backhoe IS PERMITTED TO INSTALL ALTER

ADDRESS: 4410 Salem Bottom Road, Westminster PHONE NUMBER: 410-875-4197

SUBDIVISION: Hudson Property LOT NUMBER: 1

ADDRESS: 12875 Frederick Rd PROPERTY OWNER: Eric Stonesifer

SEPTIC TANK CAPACITY (GALLONS): 1500 OUTLET BAFFLE FILTER REQUIRED

PUMP CHAMBER CAPACITY (GALLONS): 1250 COMPARTMENTED TANK REQUIRED

NUMBER OF BEDROOMS: 4 *Inlet 4.5'*

SQUARE FEET PER BEDROOM: _____ *Bottom 7.5'*

LINEAR FEET OF TRENCH REQUIRED: 100 170' *Trenches 2' Wide*

75'+95' Trench


TRENCHES:	Trench to be 3.0 feet wide. Inlet 3.0 feet below original grade. Bottom maximum depth 5.5 feet below original grade. Effective area begins at 4.5 feet below original grade. 3.0 feet of stone below distribution pipe.
LOCATION:	
NOTES:	Install per plan unless directed by HCHD. Layout inspection required prior to septic installation.

PLANS APPROVED: Sara Sappington DATE: 12/12/07

- NOTE: PERMIT VOID AFTER 2 YEARS
- NOTE: CONTRACTOR RESPONSIBLE FOR SCHEDULING A PRE-CONSTRUCTION INSPECTION FOR ALL INSTALLATIONS
- NOTE: WATERTIGHT SEPTIC TANKS REQUIRED
- NOTE: ALL PARTS OF SEPTIC SYSTEM SHALL BE 100 FEET FROM ANY WATER WELL
- NOTE: MANHOLE RISERS REQUIRED ON ALL SEPTIC TANKS AND PUMP CHAMBERS UNLESS SPECIFICALLY AUTHORIZED

NEITHER THE HOWARD COUNTY COUNCIL NOR THE HEALTH DEPARTMENT IS RESPONSIBLE FOR THE SUCCESSFUL OPERATION OF ANY SYSTEM PERMITTEE RESPONSIBLE FOR OBTAINING FINAL APPROVAL ON THIS PERMIT CALL 410-313-1771 FOR INSPECTION OF SEPTIC SYSTEM

NOT TO SCALE

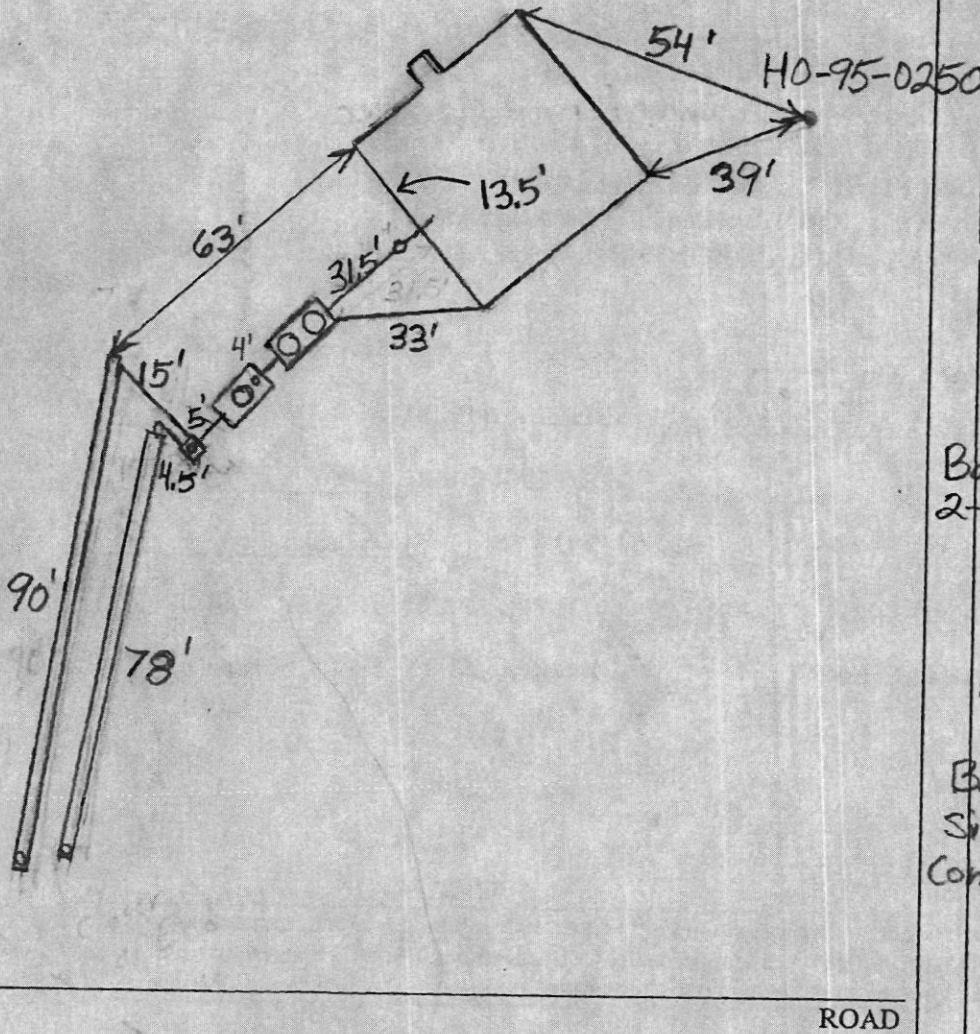


TRENCH/DRAINFIELD DATA		
WIDTH	INLET	BOTTOM
2'	4.5'	7.5'
NUMBER OF TRENCHES		2
TOTAL LENGTH		168'
ABSORPTION AREA		504
DISTRIBUTION BOX LEVEL		Levelers
DISTRIBUTION BOX BAFFLE		Yes
DISTRIBUTION BOX PORT		Yes

SEPTIC TANK DATA	
SEPTIC TANK 1 LEVEL	Yes
CAPACITY	1500 GAL
SEAM LOC	Top
TANK LID DEPTH	0'-2'
BAFFLES	Yes
BAFFLE FILTER	No
MANHOLE LOC	Front/Rear
6" PORT LOC	None
WATERTIGHT TEST	No
SEPTIC TANK 2 LEVEL	Yes
CAPACITY	1250 GAL
SEAM LOC	Top
TANK LID DEPTH	0'-1.5'
BAFFLES	Front + Rear
BAFFLE FILTER	No
MANHOLE LOC	Middle
6" PORT LOC	Front
WATERTIGHT TEST	No

Babylon
2-Comp.
Babylon
Single
Comp.

PRE-CONSTRUCTION 2/21/08 French specs. changed to better use available easement area. Install an upper 75' trench and a lower 95' trench on contour across the bottom of the easement. Had installer put in a pump chamber, although not specified on permit. Should have been a pumped system to begin with. (BB) 2/27/08 System installed. Need to abandon old system. (BB) 2/29/08 Old system abandoned need house connection. (BB) 4/8/08 House connection made. (BB)

FINAL INSPECTOR B. Baker DATE OF APPROVAL 4/8/08

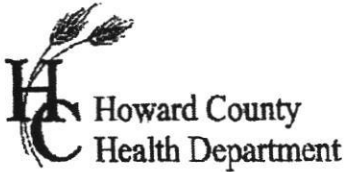

APPLICATION

FOR PERCOLATION TESTING AND SITE EVALUATION

TEST DATE(S) _____ TEST TIME _____ AP 521638
AGENCY REVIEW: _____ DATE 1/4/2005

DO NOT WRITE ABOVE THIS LINE

I HEREBY APPLY FOR THE NECESSARY TESTING/EVALUATION PRIOR TO ISSUANCE OF SEWAGE DISPOSAL SYSTEM PERMIT(S) TO:

CHECK AS NEEDED:

- CONSTRUCT NEW SEPTIC SYSTEM(S)
- REPAIR/ADD TO AN EXISTING SEPTIC SYSTEM
- REPLACE AN EXISTING SEPTIC SYSTEM

CHECK AS NEEDED:

- NEW STRUCTURE(S)
- ADDITION TO AN EXISTING STRUCTURE
- REPLACE AN EXISTING STRUCTURE

CHECK ONE:

- CREATE NEW LOT(S)
- BUILD ON AN EXISTING LOT IN A SUBDIVISION
- BUILD ON AN EXISTING PARCEL OF RECORD

IS THE PROPERTY WITHIN 2500' OF ANY RESERVOIR?

- YES
- NO

THE TYPE OF STRUCTURE IS:

- RESIDENTIAL WITH 4 PROPOSED BEDROOMS IN THE COMPLETED STRUCTURE (NOTE **UNKNOWN** IF APPROPRIATE)
- COMMERCIAL (PROVIDE DETAIL OF NUMBERS AND TYPES OF EMPLOYEES/CUSTOMERS ON ACCOMPANYING PLAN)
- INSTITUTIONAL/GOVERNMENT (PROVIDE DETAIL OF NUMBERS AND TYPES OF EMPLOYEES/USERS ON ACCOMPANYING PLAN)

PROPERTY OWNER(S) James W. Hudson (Teresa Stonestier - Daughter)

DAYTIME PHONE 40-489-5208 CELL _____ FAX _____

MAILING ADDRESS 12795 Route 144 West Friendship, MD 21794
STREET CITY/TOWN STATE ZIP

APPLICANT LDE, Inc (Steve Heiss)

DAYTIME PHONE 410-715-1070 CELL 443-928-4135 FAX 410-715-9540

MAILING ADDRESS 9250 Rumsey Road Columbia, MD 21045
STREET CITY/TOWN STATE ZIP

APPLICANT'S ROLE: DEVELOPER BUILDER BUYER RELATIVE/FRIEND REALTOR CONSULTANT

PROPERTY LOCATION
SUBDIVISION/PROPERTY NAME Hudson Property LOT NO. 1

PROPERTY ADDRESS 12855 Route 144 West Friendship, MD 21794
STREET TOWN/POST OFFICE

TAX MAP PAGE(S) 15 GRID 10 PARCEL(S) 74 PROPOSED LOT SIZE 1 Ac

AS APPLICANT, I UNDERSTAND THE FOLLOWING: THE SYSTEM INSTALLED SUBSEQUENT TO THIS APPLICATION IS ACCEPTABLE ONLY UNTIL PUBLIC SEWERAGE IS AVAILABLE. THIS APPLICATION IS COMPLETE WHEN ALL APPLICABLE FEES AND A SUITABLE SITE PLAN HAVE BEEN RECEIVED. I ACCEPT THE RESPONSIBILITY FOR COMPLIANCE WITH ALL M.O.S.H.A. AND "MISS UTILITY" REQUIREMENTS. APPROVAL IS BASED UPON SATISFACTORY REVIEW OF A PERC CERTIFICATION PLAN.

TEST RESULTS WILL BE MAILED TO APPLICANT. Steve Heiss
SIGNATURE OF APPLICANT

HOWARD COUNTY HEALTH DEPARTMENT, BUREAU OF ENVIRONMENTAL HEALTH, WELL AND SEPTIC PROGRAM
3525-H ELLICOTT MILLS DRIVE, ELLICOTT CITY, MARYLAND 21043-4544 (410) 313-1771 FAX (410) 313-2648
TDD (410) 313-2323 TOLL FREE 1-877-4MD-DHMH

FOGLE'S SEPTIC CLEAN, INC.
 580 Obrecht Road • Sykesville • Maryland 21784
 (410) 795-5670



SEPTIC EVALUATION

<input type="checkbox"/> Buyer / <input type="checkbox"/> Seller <i>Homeowner</i>	Date: <i>7/31/20</i> Time: <i>2PM</i>	Occupied? <input checked="" type="checkbox"/> Yes / <input type="checkbox"/> No
Client: <i>Eric Storerifer</i>	Ordered By:	If vacant, how long?
Property Address: <i>12875 Route 144 West Friendship, MD 21794</i>	Phone: <i>443 812-1894</i>	Last pumped: <i>May 2020</i>
	email:	Property age: <i>2008</i> # Bedrooms: <i>3</i>
	Weather:	County Records: <input type="checkbox"/> Requested <input type="checkbox"/> Not Received
	Ground Conditions:	Confirmed: <input checked="" type="checkbox"/> Yes <input type="checkbox"/> Left Message

Liquid level: <input type="checkbox"/> Above Normal / <input checked="" type="checkbox"/> Normal / <input type="checkbox"/> Below normal	Depth of tank: <i>3' 3'</i>
Maintenance Appears: <input checked="" type="checkbox"/> Good / <input type="checkbox"/> Fair / <input type="checkbox"/> Poor	Access to tank: <i>2MH's - 1mH</i>
Effluent Filter present? <input type="checkbox"/> Yes / <input checked="" type="checkbox"/> No	Pump system: <input type="checkbox"/> Yes / <input checked="" type="checkbox"/> No

Type of Tank	Tank Composition & Size	Type of Absorption System
<input checked="" type="checkbox"/> Septic Tank (1 tank) <input type="checkbox"/> Cesspool <input type="checkbox"/> Aeration System <input type="checkbox"/> Other:	<input type="checkbox"/> Metal <input checked="" type="checkbox"/> Concrete <input type="checkbox"/> Unknown Tank Size: <i>1500g 2comp 1250g</i> Baffles intact? <input checked="" type="checkbox"/> Yes / <input type="checkbox"/> No <i>Future Pump Ch!</i>	<input checked="" type="checkbox"/> Drainfield <i>Z</i> <input type="checkbox"/> Drywell <input type="checkbox"/> Sandmound <input type="checkbox"/> Other:

Inspected System Appears:	Inspector's Comments	Sketch of System
<input checked="" type="checkbox"/> Functional <input type="checkbox"/> Marginal <input type="checkbox"/> Unsatisfactory	<p><i>Septic tank is clean and was recently serviced. Future pump ch. is being used for add settling. System has good flow throughout. Drainfields w/ 4" obs ports are totally dry w/ clean stone.</i></p>	
Inspector:		
Signature: <i>R. Russell</i>		
Inspection Fee: <i>\$250</i>		
Locate/Hand Digging Fee:		
Water Test: <input type="checkbox"/> U&O <input type="checkbox"/> Lead <input type="checkbox"/> Nitrite		
Water Test Other:		
Amount Due:		
Check #		

IMPORTANT:


- This is a subjective and visual inspection only, based upon many unknown and unseen factors.
- The condition of the Sewage Disposal system is reported as of the above date.
- This report does not WARRANT nor GUARANTEE continued functional Sewage Disposal System operations.
- If house has been unoccupied, this report may not be accurate. Little or no use of the septic system could have allowed the problems to temporarily clear themselves.
- If a larger family is moving in than is presently occupying the house, the septic system may be subject to failure.
- If the general ground condition is wet, this report may not be accurate, as ground moisture may cover or hide actual septic effluent on the surface.
- In the above cases, it is strongly suggested that the septic system be re-certified in 3 to 6 months.
- If the system is rated below as marginal or unsatisfactory, it is suggested that the local health department be contacted to inspect and confirm the findings.

Payment for this inspection signifies understanding and acceptance of above clauses.

Kansas State Health Department
 State Health Officer
 Kansas State Health Officer
 Kansas State Health Officer

SOIL LEGEND

SYMBOL	SOIL TYPE	PERMEABILITY	DESIGNATION
(Symbol)	CLAY	LOW	CLAY
(Symbol)	CLAY	MEDIUM	CLAY
(Symbol)	CLAY	HIGH	CLAY
(Symbol)	SAND	LOW	SAND
(Symbol)	SAND	MEDIUM	SAND
(Symbol)	SAND	HIGH	SAND
(Symbol)	GRAVEL	LOW	GRAVEL
(Symbol)	GRAVEL	MEDIUM	GRAVEL
(Symbol)	GRAVEL	HIGH	GRAVEL

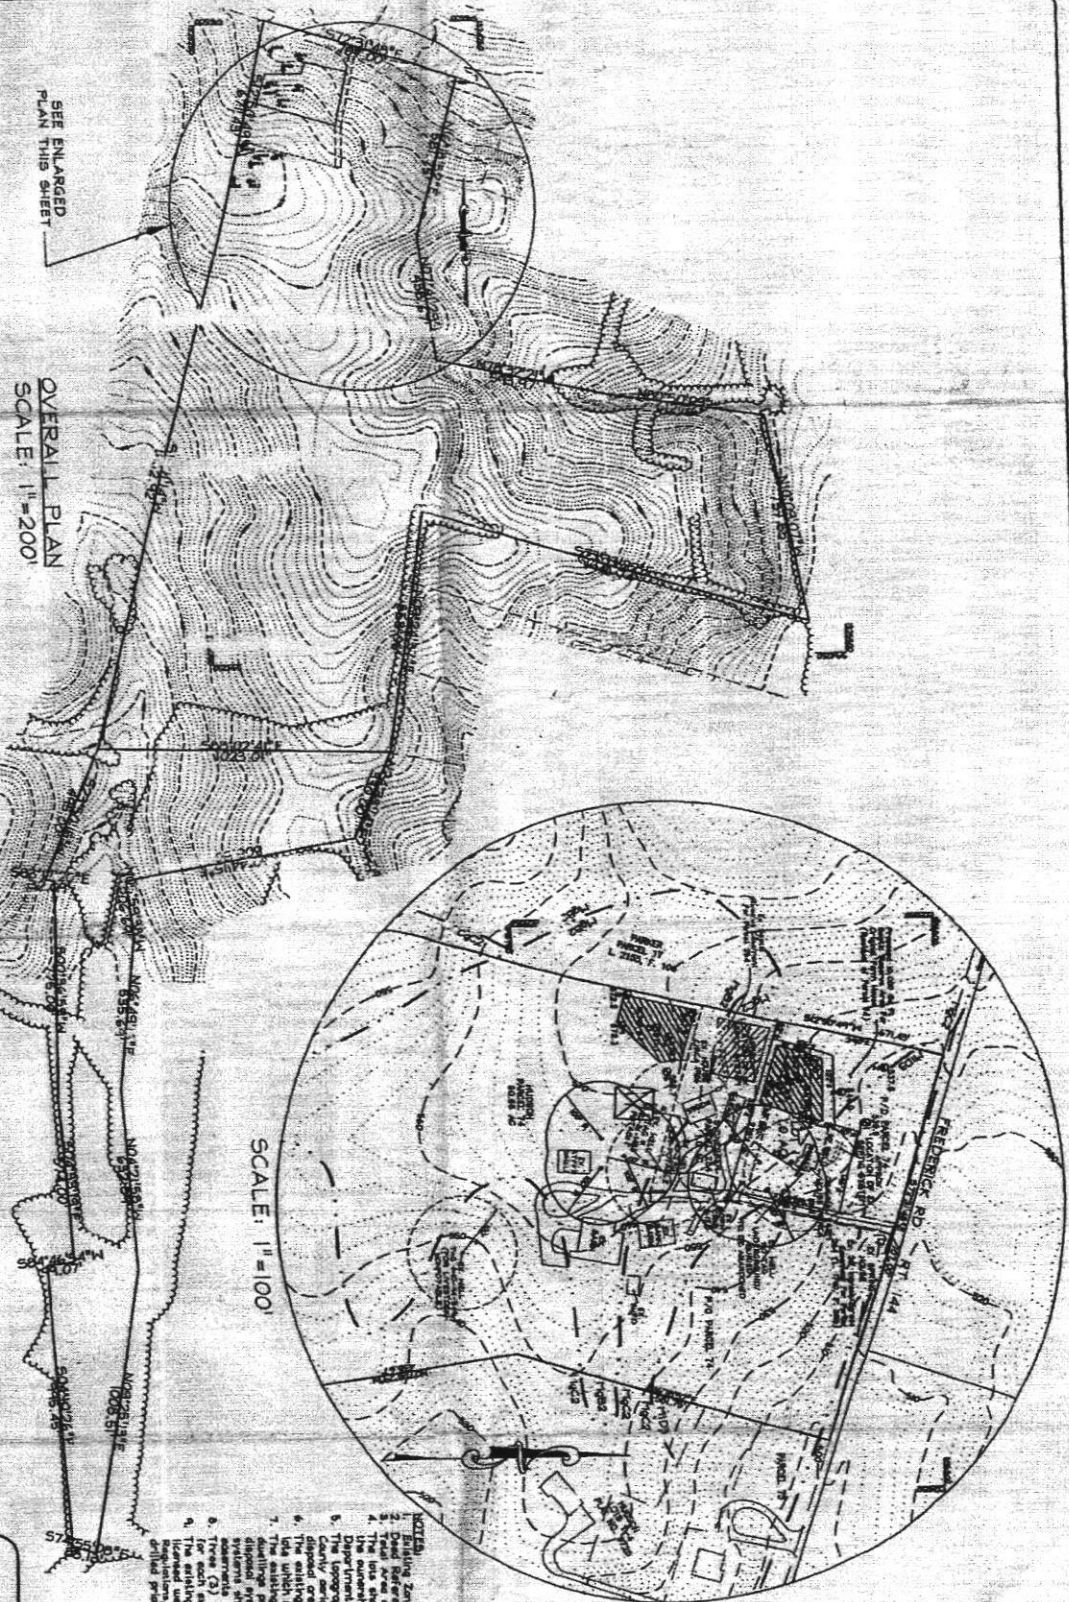


This map depicts a private sewage disposal system as required by the Kansas State Health Department for installation in a residential area. The system is designed to meet the requirements of the Kansas State Health Department. The State Health Officer will have the authority to grant adjustments to the private sewage system.



SCALE: 1"=100'

OVERALL PLAN
SCALE: 1"=200'

SEE ENLARGED
PLAN THIS SHEET

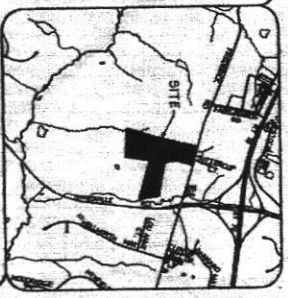

- LEGEND**
- Existing 2' Center -
 - Existing 10' Center -
 - Existing Fence -
 - Existing Driveway -
 - Existing Driveway -
 - Proposed Test Hole (Found) -
 - Proposed Test Hole (Found) -
 - Proposed Primary Well -
 - Proposed Secondary Well -

- NOTES**
1. See Engineering Zoning: RC-250
 2. Dated Reference: 4/17/81
 3. Total Area of Lot: 6000 sq. ft.
 4. The minimum lot area and the ownership which is required by the Kansas State Department of the Environment.
 5. The topography shown thereon is taken from the Howard County aerial photograph field verified.
 6. The existing easements shown on the site plan remain. Each lot which may affect this project.
 7. The existing utility lines have been shown within 100 feet of the lot.
 8. The existing utility lines have been shown within 100 feet of the lot.
PERMITS


S.D.M. **AKH - 198X** **AKH**
 N.D.M. **AKH - 198X** **AKH**
 G.D.M. **AKH - 198X** **AKH**
 B.D.B. **AKH - 198X** **AKH**

4/2005
 04-049

1.2 4.5³ - 7.5

5 x 150 = 750 / 1.2 = 625
 625 / 2 = 312.5 187.5
 $\frac{2+2}{2+1+2(3)} = 0.6$

A/P
 (4)
 Brown L 1'
 Yellow/Brown Sol 3 1/2'
 Red/Orange Brown Sl w/ 10% Rock 12'

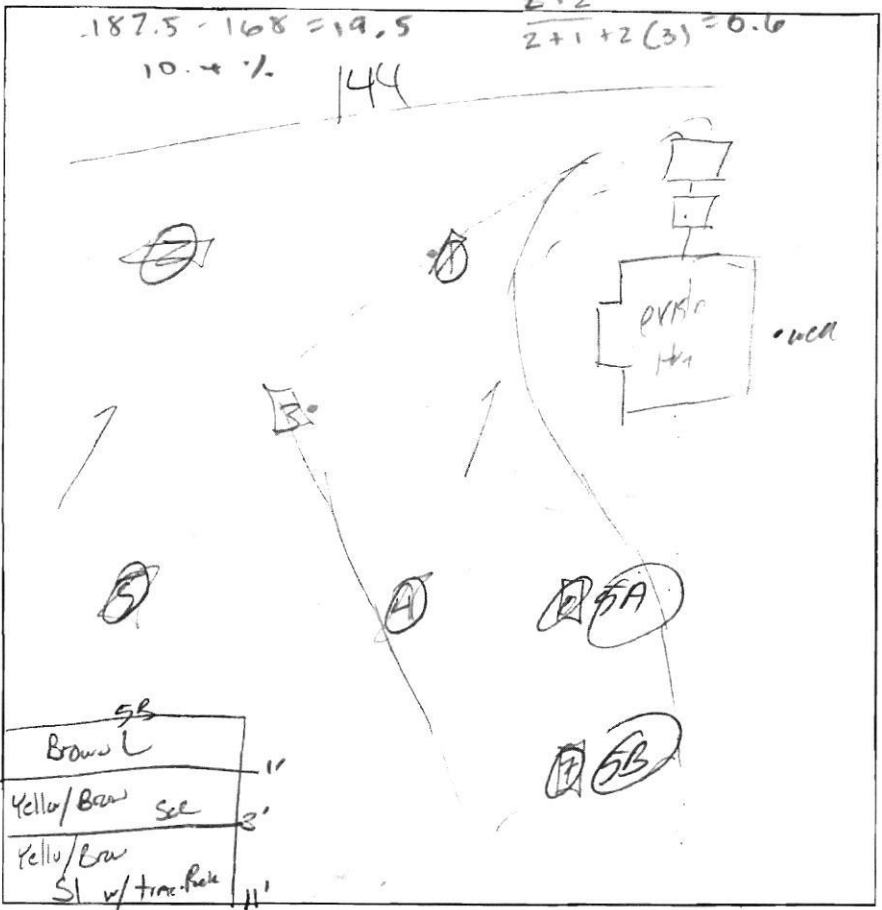

(3)
 Brown L 1'
 Red/Orange MICAS Sol 4'
 Yellow/Brown Sl w/ trace Rock 12'

1
 Brown L 1'
 Red/Orange Sol 4'
 Yellow/Brown MICAS Sl w/ trace Rock 11 1/2'

5B
 Brown L 1'
 Yellow/Brown Sol 3'
 Yellow/Brown Sl w/ trace Rock 11'


(5)
 Brown L 2'
 Red/Orange CL 8'
 Orange/Brown Sol 10'
 Red/Brown Sl w/ trace Rock 12'

DATE	TEST #	DEPTH	START	BREAK 1" DROP	STOP 2" DROP	TIME OF 2ND INCH	P/F/H
1/25/05	(4)	4 1/2' / 12'	9:30	9:32	9:36	4 mi	T
	1	4 1/2' / 11 1/2'	9:37	9:39	9:41	2 mi	P
	2	6' / 13'	9:43	-Pulled	10:05	Slow	F
	3	- / 12'	- Visual -			OK	P
	5	7' / 12'	10:12	-Pulled	10:42	Slow	F
	(5A)	4 1/2' / 11 1/2'	10:47	10:50	10:55	5 mi	P
	(5B)	4 1/2' / 12'	10:50	10:58	11:04	6 mi	P

2
 Brown L 1'
 Red/Orange CL 3'
 Yellow/Brown Sol 7 1/2'
 Red/Orange Sl w/ 20% Rock 10'
 HD 13'

(5A)
 Brown L 1'
 Red/Brown MICAS Sol 4 1/2'
 Red/Brown MICAS Sl w/ trace Rock 11 1/2'

REMARKS _____
 SANITARIAN _____ BACKHOE _____ OTHERS _____
 TEST HOLES USED IN SDA _____ AVG. PERC TIME _____ SQ. FT/BR _____
 TRENCH WIDTH _____ INLET DEPTH _____ MAX. BOT DEPTH _____ EFFECTIVE SW _____

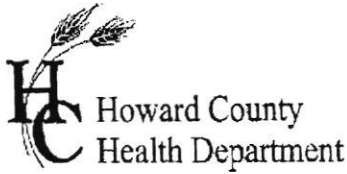

APPLICATION

FOR PERCOLATION TESTING AND SITE EVALUATION

TEST DATE(S) _____ TEST TIME _____ AD 521638

AGENCY REVIEW: _____ DATE 1/4/2005

DO NOT WRITE ABOVE THIS LINE

I HEREBY APPLY FOR THE NECESSARY TESTING/EVALUATION PRIOR TO ISSUANCE OF SEWAGE DISPOSAL SYSTEM PERMIT(S) TO:

CHECK AS NEEDED:

- CONSTRUCT NEW SEPTIC SYSTEM(S)
- REPAIR/ADD TO AN EXISTING SEPTIC SYSTEM
- REPLACE AN EXISTING SEPTIC SYSTEM

CHECK AS NEEDED:

- NEW STRUCTURE(S)
- ADDITION TO AN EXISTING STRUCTURE
- REPLACE AN EXISTING STRUCTURE

CHECK ONE:

- CREATE NEW LOT(S)
- BUILD ON AN EXISTING LOT IN A SUBDIVISION
- BUILD ON AN EXISTING PARCEL OF RECORD

IS THE PROPERTY WITHIN 2500' OF ANY RESERVOIR?

- YES
- NO

THE TYPE OF STRUCTURE IS:

- RESIDENTIAL WITH 4 PROPOSED BEDROOMS IN THE COMPLETED STRUCTURE (NOTE **UNKNOWN** IF APPROPRIATE)
- COMMERCIAL (PROVIDE DETAIL OF NUMBERS AND TYPES OF EMPLOYEES/ CUSTOMERS ON ACCOMPANYING PLAN)
- INSTITUTIONAL/GOVERNMENT (PROVIDE DETAIL OF NUMBERS AND TYPES OF EMPLOYEES/USERS ON ACCOMPANYING PLAN)

PROPERTY OWNER(S) James W. Hudson (Teresa Stonestor - Daughter)

DAYTIME PHONE 40-489-5208 CELL _____ FAX _____

MAILING ADDRESS 12795 Route 144 West Friendship, MD 21794
STREET CITY/TOWN STATE ZIP

APPLICANT LDE, Inc (Steve Heiss)

DAYTIME PHONE 410-715-1070 CELL 443-928-4135 FAX 410-715-9540

MAILING ADDRESS 9250 Rumsey Road Columbia, MD 21045
STREET CITY/TOWN STATE ZIP

APPLICANT'S ROLE: DEVELOPER BUILDER BUYER RELATIVE/FRIEND REALTOR CONSULTANT

PROPERTY LOCATION
SUBDIVISION/PROPERTY NAME Hudson Property LOT NO. 1


PROPERTY ADDRESS 12855 Route 144 West Friendship, MD 21794
STREET TOWN/POST OFFICE

TAX MAP PAGE(S) 15 GRID 10 PARCEL(S) 74 PROPOSED LOT SIZE 1 Ac

AS APPLICANT, I UNDERSTAND THE FOLLOWING: THE SYSTEM INSTALLED SUBSEQUENT TO THIS APPLICATION IS ACCEPTABLE ONLY UNTIL PUBLIC SEWERAGE IS AVAILABLE. THIS APPLICATION IS COMPLETE WHEN ALL APPLICABLE FEES AND A SUITABLE SITE PLAN HAVE BEEN RECEIVED. I ACCEPT THE RESPONSIBILITY FOR COMPLIANCE WITH ALL M.O.S.H.A. AND "MISS UTILITY" REQUIREMENTS. APPROVAL IS BASED UPON SATISFACTORY REVIEW OF A PERC CERTIFICATION PLAN. TEST RESULTS WILL BE MAILED TO APPLICANT.

Steve Heiss
SIGNATURE OF APPLICANT

HOWARD COUNTY HEALTH DEPARTMENT, BUREAU OF ENVIRONMENTAL HEALTH, WELL AND SEPTIC PROGRAM
3525-H ELLICOTT MILLS DRIVE, ELLICOTT CITY, MARYLAND 21043-4544 (410) 313-1771 FAX (410) 313-2648
TDD (410) 313-2323 TOLL FREE 1-877-4MD-DHMH

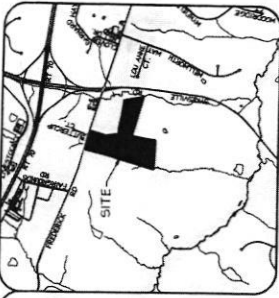

VICINITY MAP

SCALE: 1" = 200'

- LEGEND**
- Existing 2' Contour-
 - Existing 10' Contour-
 - Existing Fence-
 - Existing Trestle-
 - Existing Driveway-
 - Soils Boundary-
 - Percolation Test Hole (Passed)-
 - Percolation Test Hole (Failed)-
 - Proposed Primary Well-*
 - Proposed Secondary Well-O



SCALE: 1" = 100'

NOTES:

1. Existing Zoning: RC-DEO
2. Deed Reference: 457/0547
3. The lots shown herein comply with the minimum lot area and the ownership width as required by the Maryland State Department of the Environment.
4. The lot shown herein is shown within the Howard County aerial topography taken from the Howard County Department of Planning and Zoning.
5. The existing wells have been shown within 100 feet of the disposal area has been field verified.
6. The existing wells have been shown within 100 feet of the disposal area has been field verified.
7. The existing wells have been shown within 100 feet of the disposal area has been field verified.
8. Three (3) future well sites for portable water supply are provided for each existing well on Lot 1 to be abandoned and sealed by a licensed professional engineer or a licensed Professional Land Surveyor, prior to installation of a new well. New well will be drilled prior to final record plat signature.

LDE, INC.

DESIGNED	S.D.H.
DRAWN	M.D.L.
CHECKED	B.D.B.
DATE	4/2005

This area designates a private sewage disposal area required by the Maryland State Department of the Environment. Improvements of any nature in this area are restricted until public sewage is available. The County Health Officer shall have the authority to grant adjustments to the private sewage easement.



Percolation Certification
I certify that the locations shown herein are correct and that I have the necessary knowledge and skill to do so.
Robert A. Heger
Professional Land Surveyor
P.L.S. Reg. No. 13305

HYDROLOGIC SOIL GROUP SYMBOL	SOILS LEGEND	DESCRIPTION	REMARKS
U	U1	Very poor, 1% - 18% slopes	
U	U2	Very poor, less than 1% slopes	
U	U3	Very poor, less than 1% slopes	
U	U4	Very poor, less than 1% slopes	
U	U5	Very poor, less than 1% slopes	
U	U6	Very poor, less than 1% slopes	
U	U7	Very poor, less than 1% slopes	
U	U8	Very poor, less than 1% slopes	
U	U9	Very poor, less than 1% slopes	
U	U10	Very poor, less than 1% slopes	
U	U11	Very poor, less than 1% slopes	
U	U12	Very poor, less than 1% slopes	
U	U13	Very poor, less than 1% slopes	
U	U14	Very poor, less than 1% slopes	
U	U15	Very poor, less than 1% slopes	
U	U16	Very poor, less than 1% slopes	
U	U17	Very poor, less than 1% slopes	
U	U18	Very poor, less than 1% slopes	
U	U19	Very poor, less than 1% slopes	
U	U20	Very poor, less than 1% slopes	


OVERALL PLAN
SCALE: 1" = 200'

SEE ENLARGED
PLAN THIS SHEET

Approved: For private water and private sewerage
Howard County Health Department
Robert A. Heger
Professional Land Surveyor
P.L.S. Reg. No. 13305

PROPERTY KNOWN AS:
 12875 FREDERICK ROAD
 LOT 1
 5TH ELECTION DISTRICT
 HOWARD COUNTY, MARYLAND
 PLAT NO: 18196

THIS PLAT CAN NOT BE USED TO ESTABLISH
 PROPERTY LINES OR CORNERS.

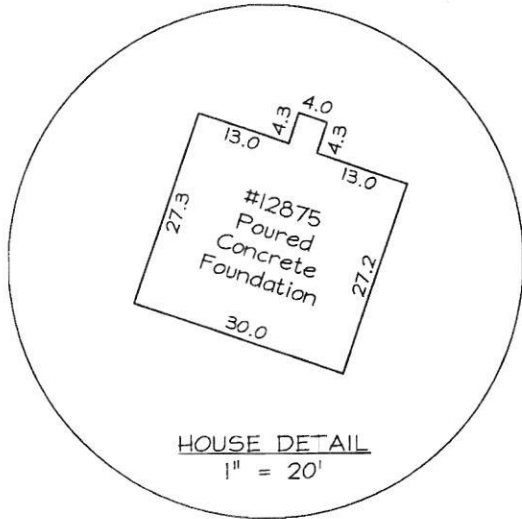


FREDERICK ROAD
 MD ROUTE 144
 (Existing Public Variable Width R/W)
 (Future Public 80' R/W)



PARCEL 74


Private 24' Wide
 Use-In-Common
 Access Easement
 For Lot 1,
 Parcel 254
 & Parcel 74

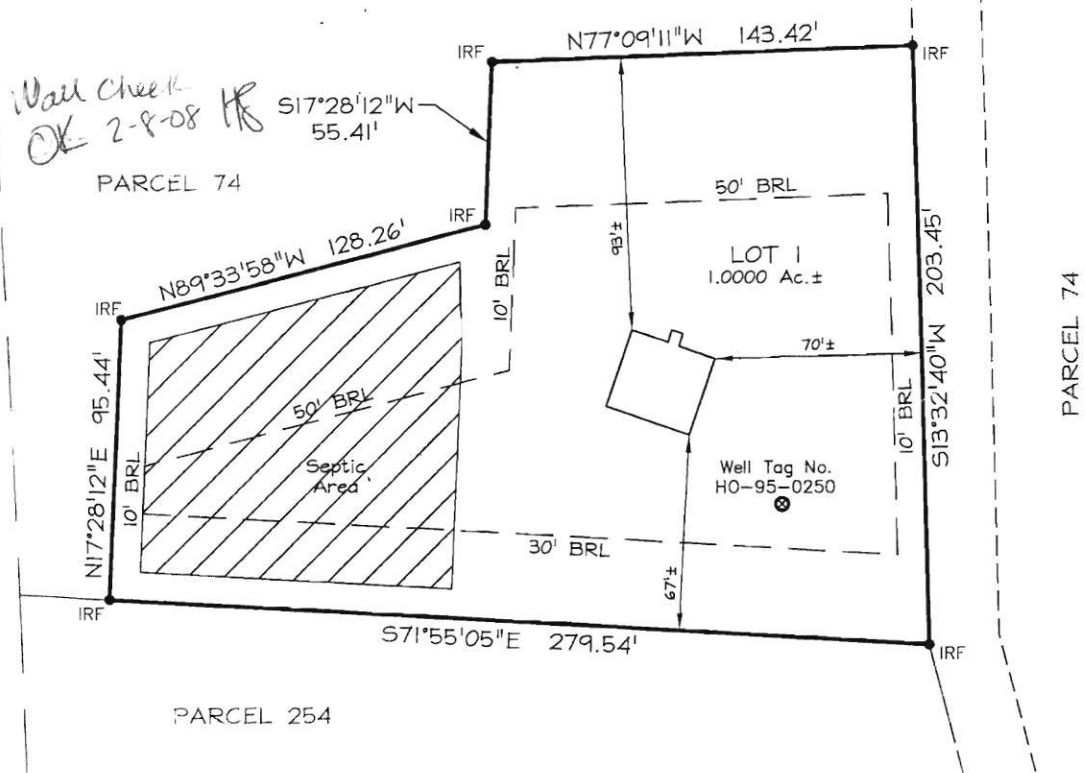

FOUNDATION LOCATION DRAWING TOP OF WALL ELEVATION 555.7'

F:\04-0495-1\dwg\04-0495-1 WALL CHECK.dwg, Layout1, 1/25/2008 8:40:44 AM

<p>CERTIFICATION</p>	<p>SEAL</p>	<p>SCALE: 1" = 50'</p>	<p>DATE: 01/2008</p>
<p>This is to certify that I have surveyed the property known as: 12875 FREDERICK ROAD</p> <p>The information shown has been established by current acceptable survey procedures and from available record information. This drawing is to be used for Title Transfer Financing, or Refinancing Only and IS NOT to be used for the Establishment of Property Lines, Location for Fences, Garages, Buildings, or other Existing or Future Improvements.</p>		<p>LDE Inc. Engineers, Surveyors, Planners</p> <p>9250 Rumsey Road, Suite 106 Columbia, Maryland - 21045 (410)715-1070 - (410)715-9540 Fax</p>	
<p>DRAWING: GDW</p>		<p>JOB #04-049.1</p>	

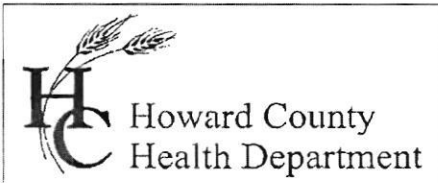

Bureau of Environmental Health
7178 Gateway Drive Columbia, MD 21046
(410) 313-2640 Fax (410) 313-2648
TDD (410) 313-2323 Toll Free 1-866-313-6300
website: www.hchealth.org

Peter L. Beilenson, M.D., M.P.H., Health Officer

April 21, 2008

Eric R. Stonesifer
12868 Route 144
West Friendship, MD 21794

RE: Hudson Property, Lot 1
12875 Frederick Road
West Friendship, MD 21794
BP #: B07004699
Well Permit # HO-95-0250

Dear Sirs:

This is to advise you that the septic system for the above referenced property has been installed and inspected. **Final approval of the septic system was granted on 04/08/2008. Final approval of the well line connection to the dwelling was approved on 02/21/2008.**

The water sample results indicate that the water samples submitted for testing were free of coliform and fecal coliform bacteria at the time of sampling and are bacteriologically safe for drinking. The water sample results were found to be in compliance with COMAR water quality standards.

INTERIM CERTIFICATE OF POTABILITY

This certifies that the initial sampling requirements of COMAR 26.04.04 "Well Regulations" have been met for the water supply system installed under well permit #HO- 95-0250. Although the submitted sample results are in compliance with COMAR standards, the Health Department does not guarantee water supplies. Based upon satisfactory investigation and evaluation, the Howard County Health Department as authorized by the Maryland Department of the Environment accepts this well system as required by COMAR 26.04.04.

This certificate may become final upon completion of the second bacteriological test, which is to be taken by the county health department within six months of receipt of this letter. **Please contact (410) 313-1792 to schedule a final water sample appointment. Currently, there is no charge for this final sampling.**

Date of Water Sample(s): 03/01/2006, 03/27/2008, 04/08/2008 & 04/17/2008
Date of Well Completion: 02/22/2006

Approving Authority,

Stuart Oster, Sanitarian
Well & Septic Program

cc: Building Inspector's Office
Community Health Services
File