



- GENERAL PLAN NOTES**
- A. ALL WOOD STUD PARTITIONS NOT DIMENSIONED ARE TO BE 3 1/2" FOR INTERIOR AND 5 1/2" FOR EXTERIOR WALLS UNLESS OTHERWISE NOTED.
 - B. ALL INTERIOR DIMENSIONS ARE TO FACE OF STUDS.
 - C. ALL EXTERIOR DIMENSIONS ARE TO FACE OF STUDS.
 - D. ALL DIMENSIONS GOVERN OVER SCALE.
 - E. ALL SMOKE DETECTORS ARE TO BE WIRED IN SUCH A MANNER THAT ACTIVATION OF ONE WILL ACTIVATE THEM ALL.
 - F. ENCLOSED ACCESSIBLE SPACE UNDER STAIRS SHALL HAVE WALLS AND SCOFFITS PROTECTED ON ENCLOSED SIDE WITH 1/2" GYPSUM BOARD.
 - G. ALL WINDOWS SIZE ARE NOTED IN FEET + INCHES AS MEASURED FROM SASH TO SASH.
 - H. REFER TO ELEVATIONS FOR WINDOW HEAD HEIGHTS.
 - I. ALL DOORS ARE TO BE 6'-8" HIGH UNLESS OTHERWISE NOTED.
 - J. WASHER ALWAYS TO BE ON LEFT SIDE OF DRYER.
 - K. DISHWASHER ALWAYS TO BE ON RIGHT SIDE OF SINK.

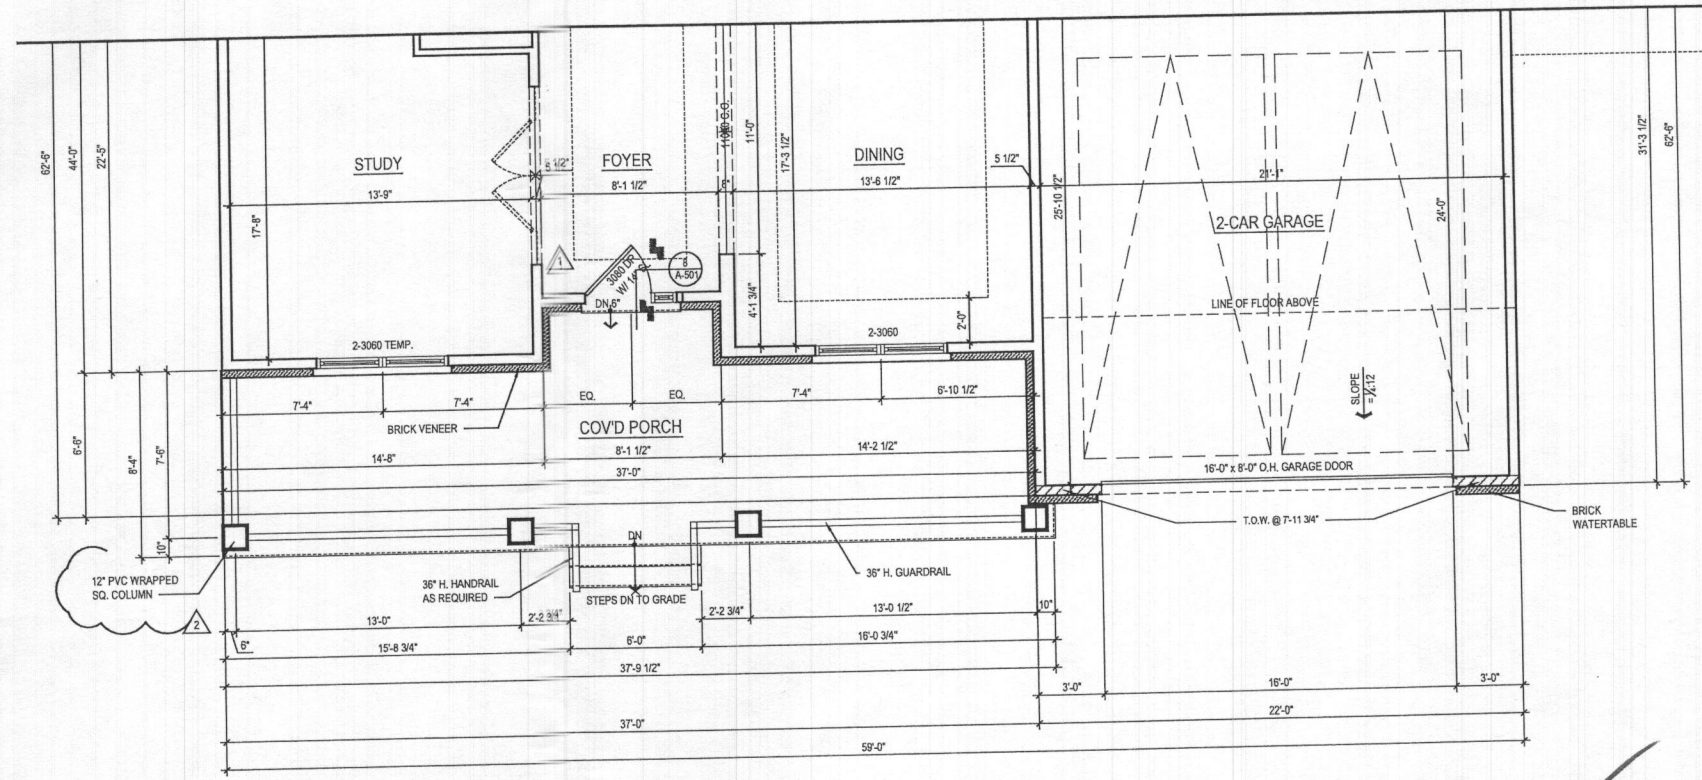


2 FIRST FLOOR PLAN
A-170 SCALE: 1/4"=1'-0"
TOL081a_A170.DWG

@ ELEV. 5 - FAIRVIEW ✓

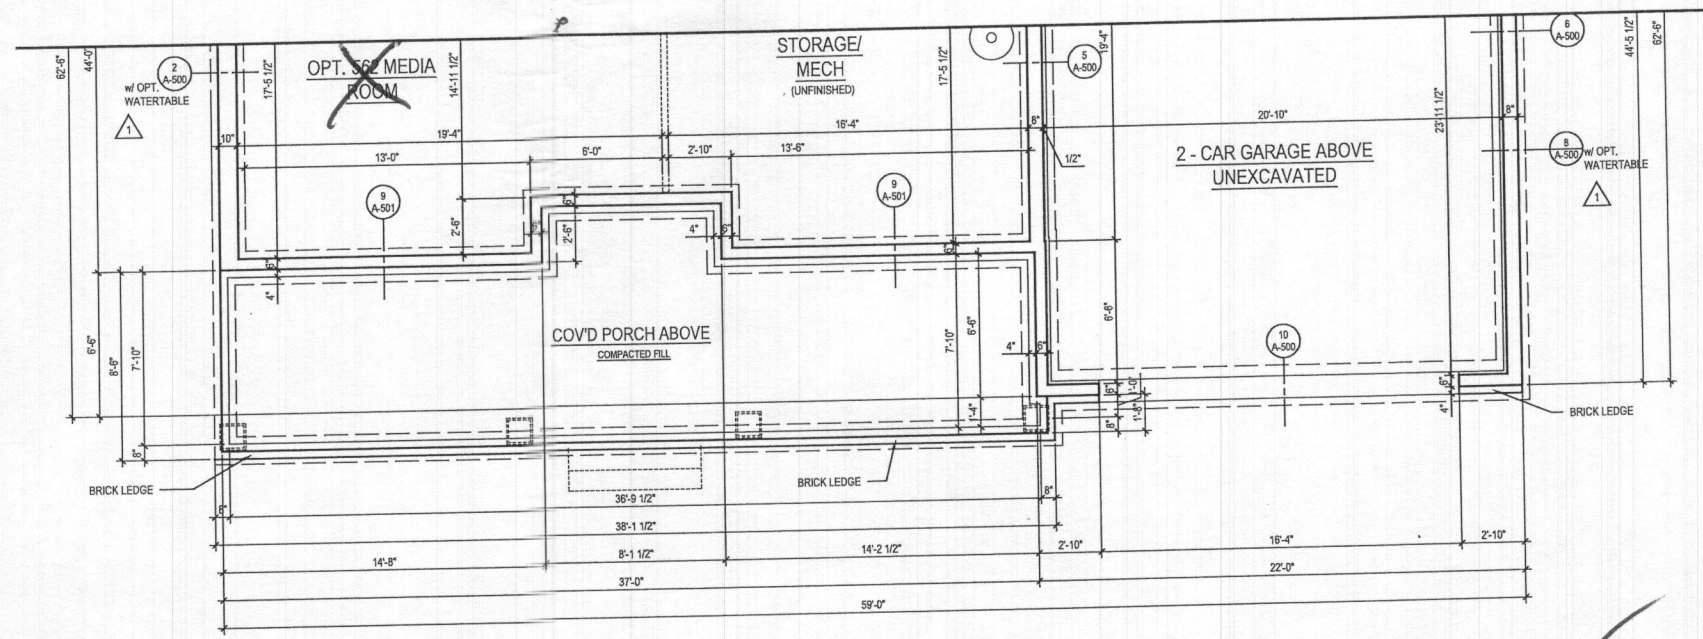

1 BASEMENT FLOOR PLAN
A-170 SCALE: 1/4"=1'-0"
TOL081a_A170.DWG

@ ELEV. 5 - FAIRVIEW ✓

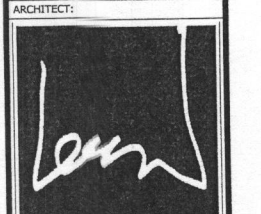

leppard DESIGN

8521 Leesburg Pike
Suite 700 | Vienna, VA 22182
P: 571.830.1800 | F: 571.830.1801
www.leppardesign.com

SEAL & SIGNATURE:

TOLL BROTHERS
19775 BELMONT EXECUTIVE PLAZA
ASHBURN, VA 20147
P: 571.291.8068
CONTACT: CHRISTINA LEMLEY
clemley@tollbrothers.com


PROJECT NAME: MARYLAND
SHEET TITLE: PARKHURST FLOOR PLANS

ISSUE / REVISION		
NO.	DESCRIPTION	DATE
BID SET		05.29.19
PERMIT SET		06.19.19
1	MID NEW STANDARDS	09.16.19
2	MR #220241	12.11.20

PROJECT No: TOL081a
DRAWN BY: AC/RM
CHECKED BY: AP
PLOT DATE: Jan. 20, 2021
FILE NAME: TOL081a_A170.dwg

A-170

- GENERAL PLAN NOTES**
- A. ALL WOOD STUD PARTITIONS NOT DIMENSIONED ARE TO BE 3 1/2" FOR INTERIOR AND 5 1/2" FOR EXTERIOR WALLS UNLESS OTHERWISE NOTED.
 - B. ALL INTERIOR DIMENSIONS ARE TO FACE OF STUDS.
 - C. ALL EXTERIOR DIMENSIONS ARE TO FACE OF STUDS.
 - D. ALL DIMENSIONS GOVERN OVER SCALE.
 - E. ALL SMOKE DETECTORS ARE TO BE WIRED IN SUCH A MANNER THAT ACTIVATION OF ONE WILL ACTIVATE THEM ALL.
 - F. ENCLOSED ACCESSIBLE SPACE UNDER STAIRS SHALL HAVE WALLS AND SOFFITS PROTECTED ON ENCLOSED SIDE WITH 1/2" GYPSUM BOARD.
 - G. ALL WINDOWS SIZE ARE NOTED IN FEET + INCHES AS MEASURED FROM SASH TO SASH.
 - H. REFER TO ELEVATIONS FOR WINDOW HEAD HEIGHTS.
 - I. ALL DOORS ARE TO BE 6'-6" HIGH UNLESS OTHERWISE NOTED.
 - J. WASHER ALWAYS TO BE ON LEFT SIDE OF DRYER.
 - K. DISHWASHER ALWAYS TO BE ON RIGHT SIDE OF SINK.

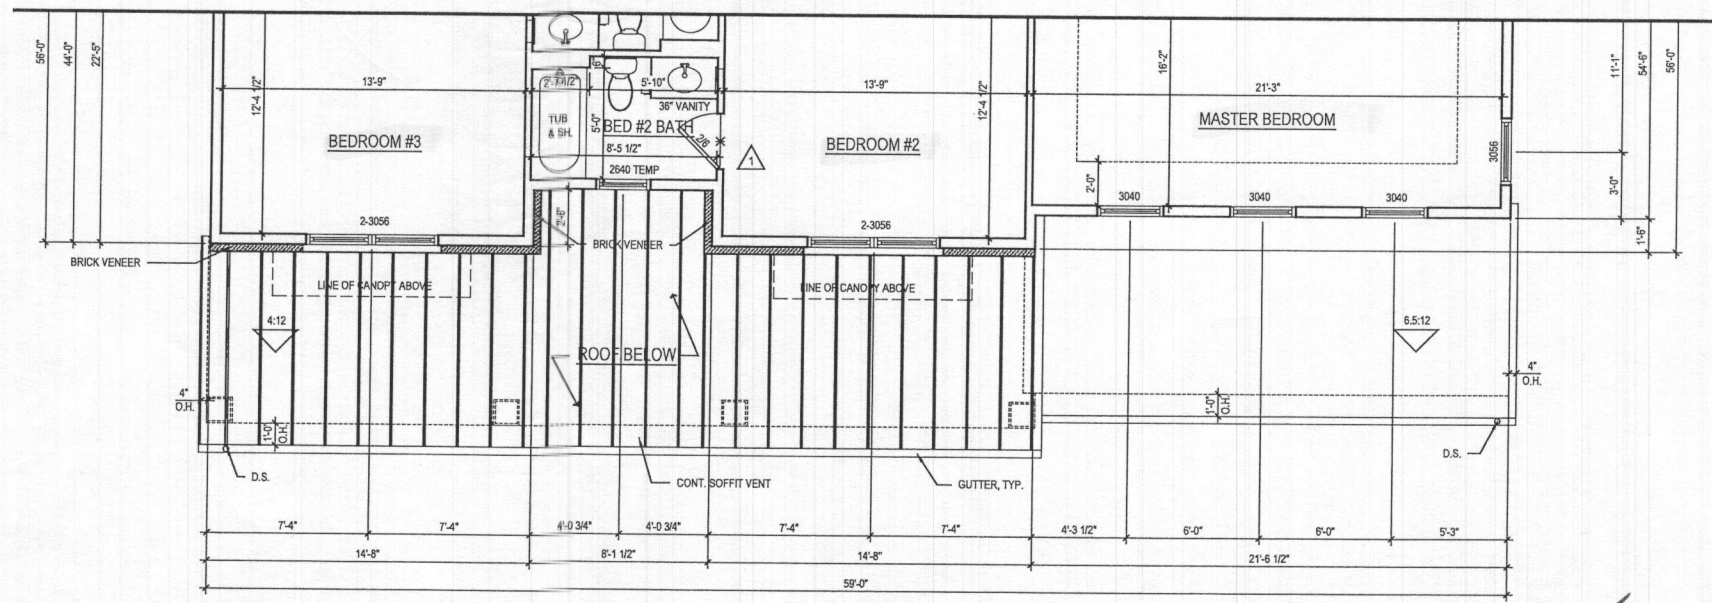

1 SECOND FLOOR PLAN
 A-171 SCALE: 1/4"=1'-0"
 TOL081a_A171.dwg

@ ELEV. 5 - FAIRVIEW ✓

ARCHITECT:

8521 Leesburg Pike
 Suite 700 | Vienna, VA 22182
 P: 571.830.1800 | F: 571.830.1801
 www.lessarddesign.com

SEAL & SIGNATURE:

OWNER:

TOLL BROTHERS
 19775 BELMONT EXECUTIVE PLAZA
 ASHBURN, VA 20147
 P: 571.291.8066
 CONTACT: CHRISTINA LEMLEY
 clemley@tollbrothers.com

PROJECT NAME: MARYLAND

SHEET TITLE: PARKHURST FLOOR PLANS

ISSUE / REVISION		
NO.	DESCRIPTION	DATE
BID SET		05.29.19
PERMIT SET		06.19.19
1	MD NEW STANDARDS	09.16.19
2	MR #220241	12.11.20

PROJECT No: TOL081a
 DRAWN BY: AC/RS
 CHECKED BY: AS
 PLOT DATE: Jan 20, 2021
 FILE NAME: TOL081a_A171.dwg

A-171

SEAL & SIGNATURE:

OWNER:

TOLL BROTHERS
19775 BELMONT EXECUTIVE PLAZA
ASHBURN, VA 20147
P: 571.291.8068
CONTACT: CHRISTINA LEMLEY
clemley@tollbrothers.com


PROJECT NAME: MARYLAND

SHEET TITLE: PARKHURST OPTIONS

ISSUE / REVISION		
NO.	DESCRIPTION	DATE
BID SET		05.29.19
PERMIT SET		06.19.19
1	MD NEW STANDARDS	09.16.19
2	MR. #220241	12.11.20

PROJECT No: TOL081a
DRAWN BY: AC/RN
CHECKED BY: AF
PLOT DATE: Jan. 20, 2021
FILE NAME: TOL081a_A400.dwg

A-400d

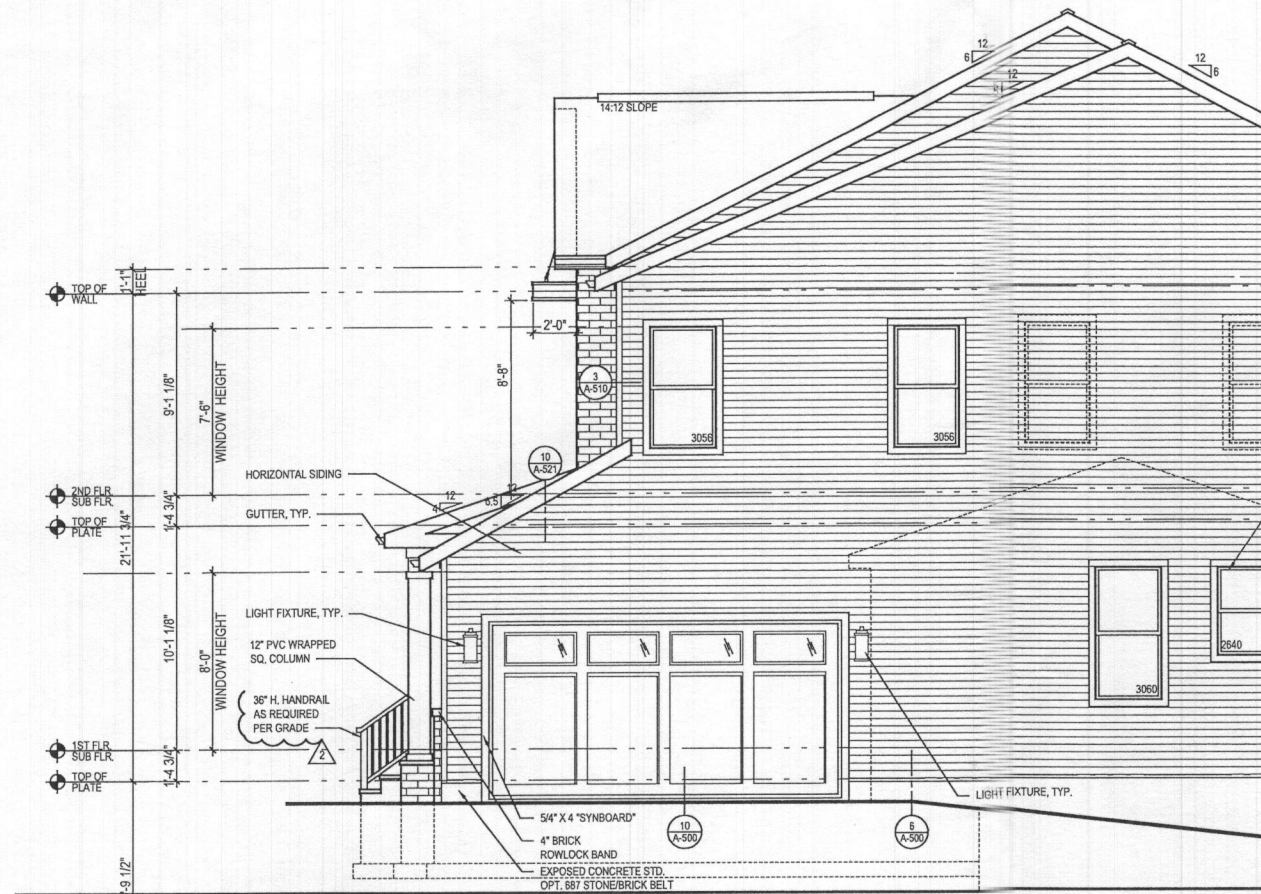


4 PART. RIGHT SIDE ELEVATION w/ OPT. 012 - SIDE LOAD GARAGE
ELEV. 5 - SHOWN
SCALE: 1/4"=1'-0"
TOL081A_A400.DWG




3 PART. FRONT ELEVATION w/ OPT. 012 - SIDE LOAD GARAGE
ELEV. 5 - SHOWN
SCALE: 1/4"=1'-0"
TOL081A_A400.DWG


- GENERAL PLAN NOTES**
- A. ALL WOOD STUD PARTITIONS NOT DIMENSIONED ARE TO BE 3 1/2" FOR INTERIOR AND 5 1/2" FOR EXTERIOR WALLS UNLESS OTHERWISE NOTED.
 - B. ALL INTERIOR DIMENSIONS ARE TO FACE OF STUDS.
 - C. ALL EXTERIOR DIMENSIONS ARE TO FACE OF STUDS.
 - D. ALL DIMENSIONS GOVERN OVER SCALE.
 - E. ALL SMOKE DETECTORS ARE TO BE WIRED IN SUCH A MANNER THAT ACTIVATION OF ONE WILL ACTIVATE THEM ALL.
 - F. ENCLOSED ACCESSIBLE SPACE UNDER STAIRS SHALL HAVE WALLS AND SOFFITS PROTECTED ON ENCLOSED SIDE WITH 1/2" GYPSUM BOARD.
 - G. ALL WINDOWS SIZE ARE NOTED IN FEET + INCHES AS MEASURED FROM SASH TO SASH.
 - H. REFER TO ELEVATIONS FOR WINDOW HEAD HEIGHTS.
 - I. ALL DOORS ARE TO BE 6'-8" HIGH UNLESS OTHERWISE NOTED.
 - J. WASHER ALWAYS TO BE ON LEFT SIDE OF DRYER.
 - K. DISHWASHER ALWAYS TO BE ON RIGHT SIDE OF SINK.

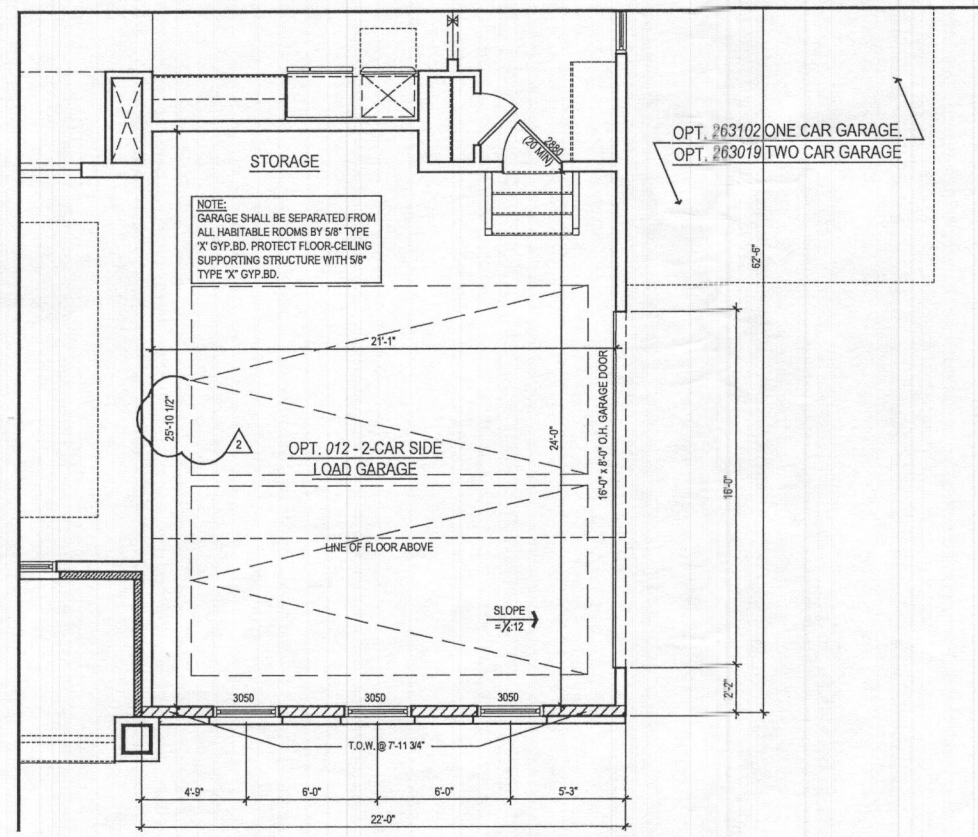


2 PART. FIRST FLOOR PLAN w/ OPT. 012 - SIDE LOAD GARAGE
ELEV. 5 - SHOWN
SCALE: 1/4"=1'-0"
TOL081A_A400.DWG

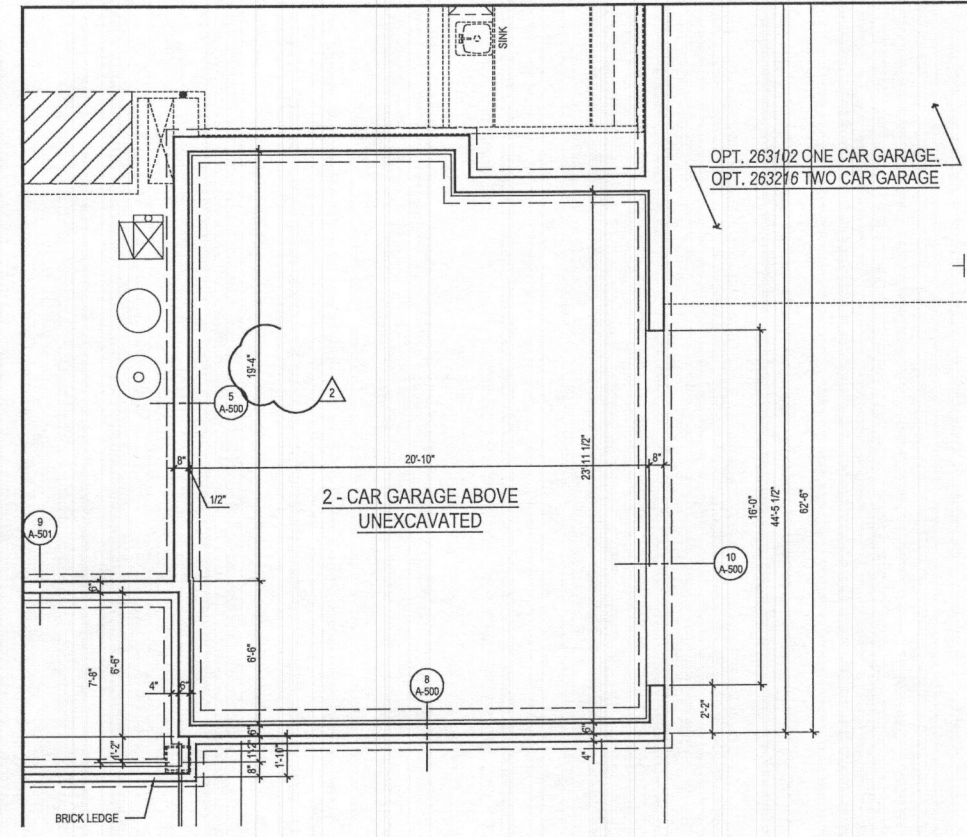


1 PART. BASEMENT FLOOR PLAN w/ OPT. 012 - SIDE LOAD GARAGE
ELEV. 5 - SHOWN
SCALE: 1/4"=1'-0"
TOL081A_A400.DWG

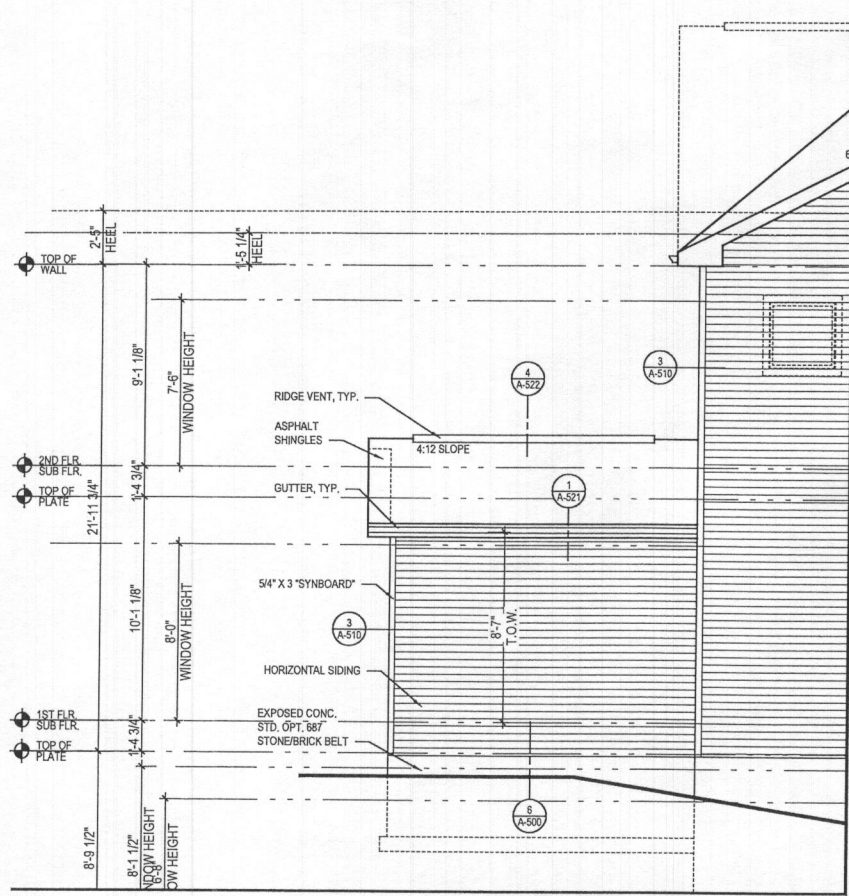

6 PART. REAR ELEVATION w/ OPT. 263102 - ONE CAR GARAGE
 SCALE: 1/4"=1'-0"
 ELEV. 1 - SHOWN

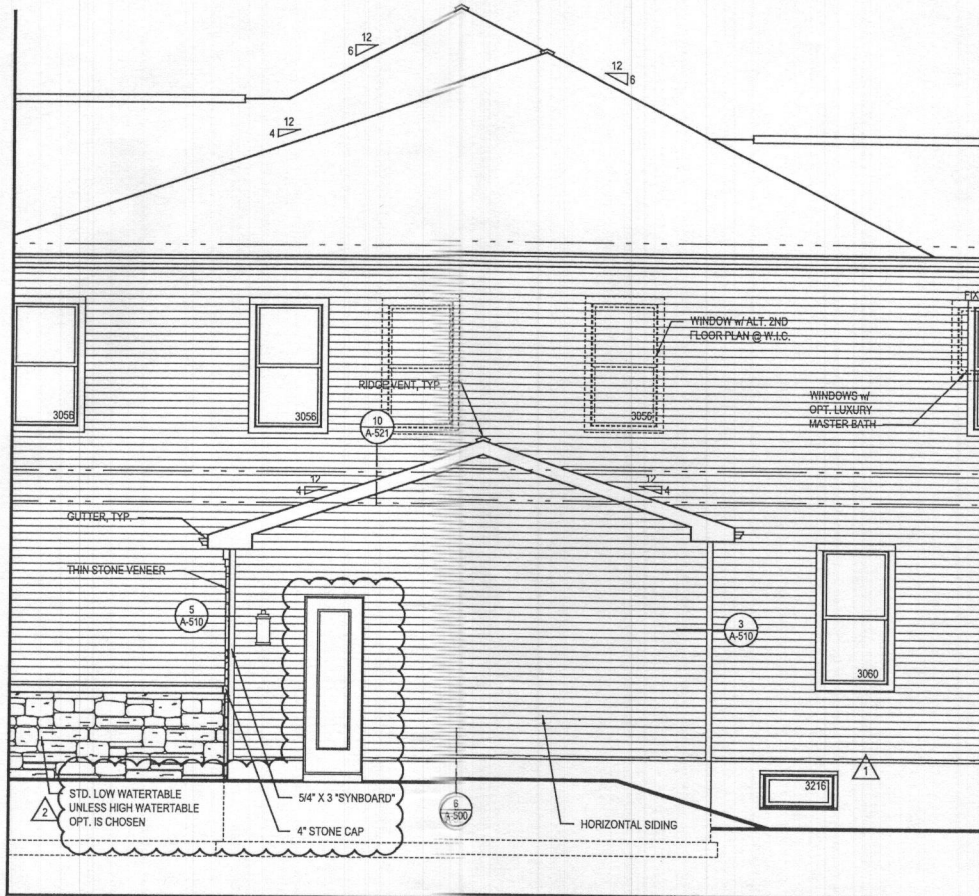


5 PART. RIGHT SIDE ELEVATION w/ OPT. 263102 - ONE CAR GARAGE
 SCALE: 1/4"=1'-0"
 ELEV. 1 - SHOWN

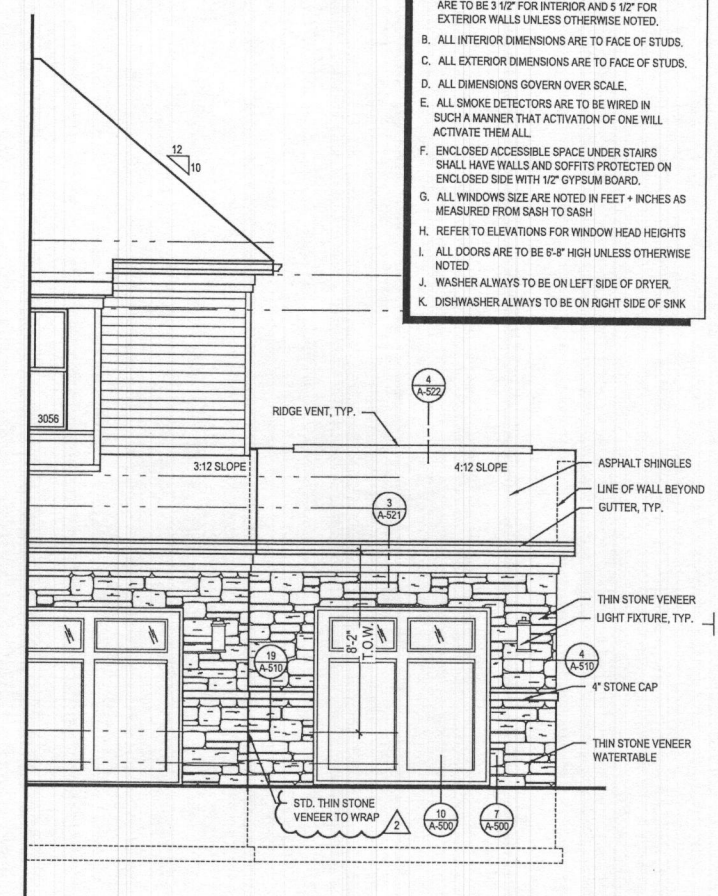


4 PART. FRONT ELEVATION w/ OPT. 263102 - ONE CAR GARAGE
 SCALE: 1/4"=1'-0"
 ELEV. 1 - SHOWN


- GENERAL NOTES**
- A. ALL WOOD STUD PARTITIONS NOT DIMENSIONED ARE TO BE 3 1/2" FOR INTERIOR AND 5 1/2" FOR EXTERIOR WALLS UNLESS OTHERWISE NOTED.
 - B. ALL INTERIOR DIMENSIONS ARE TO FACE OF STUDS.
 - C. ALL EXTERIOR DIMENSIONS ARE TO FACE OF STUDS.
 - D. ALL DIMENSIONS GOVERN OVER SCALE.
 - E. ALL SMOKE DETECTORS ARE TO BE WIRED IN SUCH A MANNER THAT ACTIVATION OF ONE WILL ACTIVATE THEM ALL.
 - F. ENCLOSED ACCESSIBLE SPACE UNDER STAIRS SHALL HAVE WALLS AND SOFFITS PROTECTED ON ENCLOSED SIDE WITH 1/2" GYPSUM BOARD.
 - G. ALL WINDOWS SIZE ARE NOTED IN FEET + INCHES AS MEASURED FROM SASH TO SASH.
 - H. REFER TO ELEVATIONS FOR WINDOW HEAD HEIGHTS.
 - I. ALL DOORS ARE TO BE 6'-8" HIGH UNLESS OTHERWISE NOTED.
 - J. WASHER ALWAYS TO BE ON LEFT SIDE OF DRYER.
 - K. DISHWASHER ALWAYS TO BE ON RIGHT SIDE OF SINK.

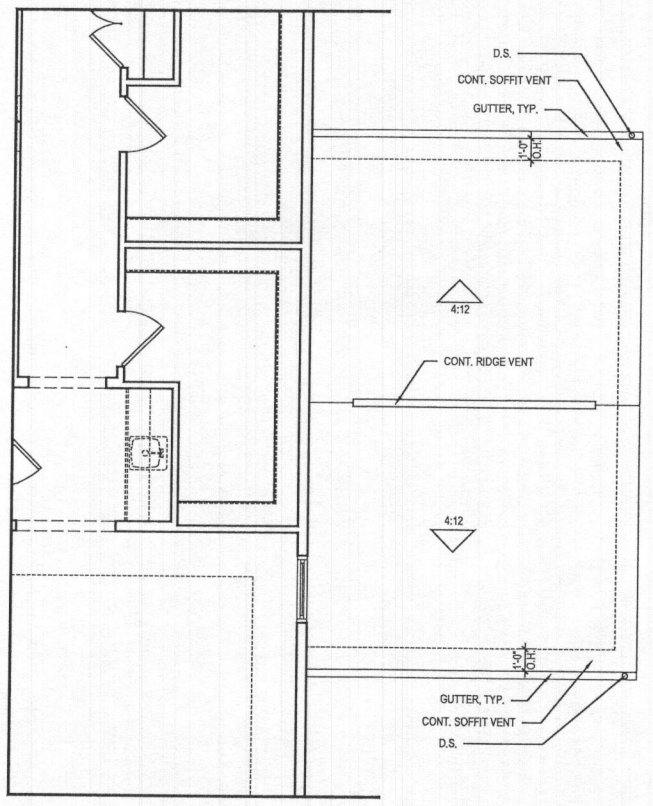

3 PART. SECOND FLOOR PLAN w/ OPT. 263102 - ONE CAR GARAGE
 SCALE: 1/4"=1'-0"
 ELEV. 1 - SHOWN

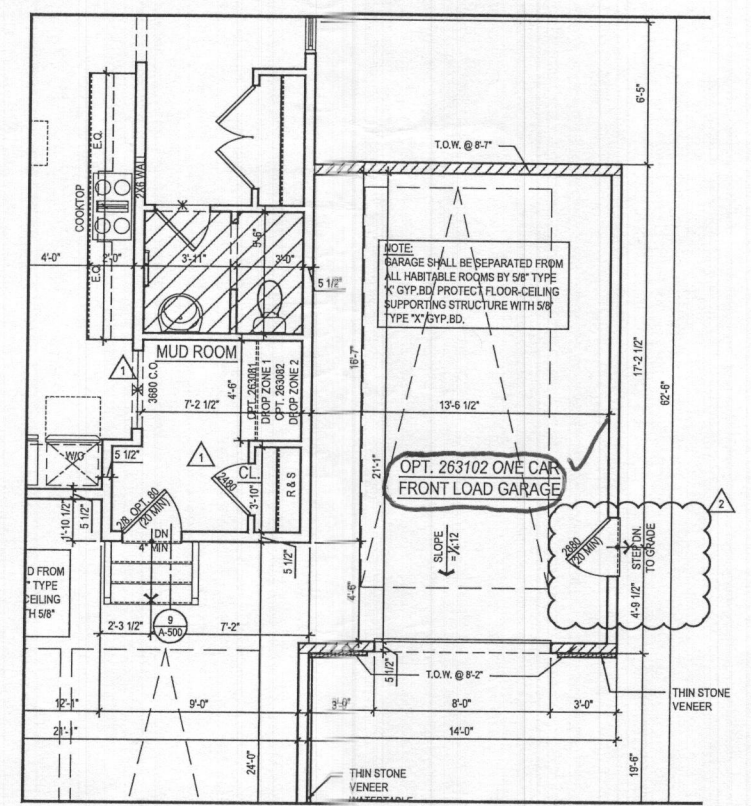

2 PART. FIRST FLOOR PLAN w/ OPT. 263102 - ONE CAR GARAGE
 SCALE: 1/4"=1'-0"
 ELEV. 1 - SHOWN

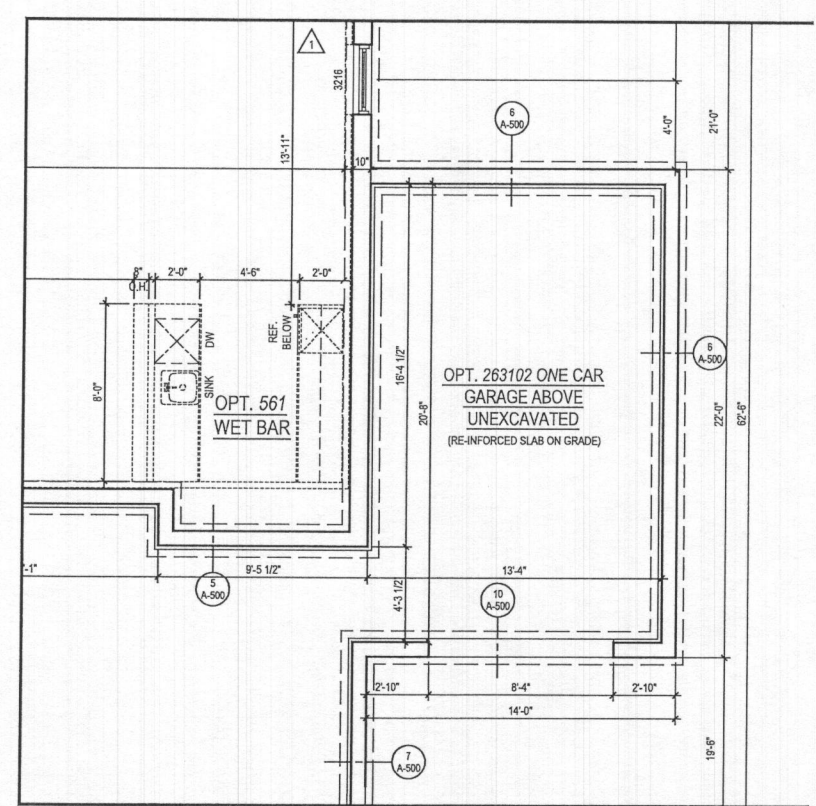

1 PART. BASEMENT FLOOR PLAN w/ OPT. 263102 - ONE CAR GARAGE
 SCALE: 1/4"=1'-0"
 ELEV. 1 - SHOWN

ARCHITECT:

8521 Leesburg Pike
 Suite 700 | Vienna, VA 22182
 P: 571.291.8068 | F: 571.830.1801
 www.lessarddesign.com

SEAL & SIGNATURE:

OWNER:

TOLL BROTHERS
 19775 BELMONT EXECUTIVE PLAZA
 ASHBURN, VA 20147
 P: 571.291.8068
 CONTACT: CHRISTINA LEMLEY
 clemley@tollbrothers.com

PROJECT NAME: MARYLAND

SHEET TITLE: PARKHURST OPTIONS

ISSUE / REVISION		
NO.	DESCRIPTION	DATE
1	BID SET	05.29.19
2	PERMIT SET	06.19.19
3	1 MD NEW STANDARDS	09.16.19
4	2 MFR #220241	12.11.20

PROJECT No: TOL081a
 DRAWN BY: AC/RN
 CHECKED BY: MS
 PLOT DATE: Jan. 20, 2021
 FILE NAME: TOL081a_A401.dwg

A-401


Plot By: sraak File No: TOL081a_A401.dwg

GENERAL PLAN NOTES


- A. ALL WOOD STUD PARTITIONS NOT DIMENSIONED ARE TO BE 3 1/2" FOR INTERIOR AND 5 1/2" FOR EXTERIOR WALLS UNLESS OTHERWISE NOTED.
- B. ALL INTERIOR DIMENSIONS ARE TO FACE OF STUDS.
- C. ALL EXTERIOR DIMENSIONS ARE TO FACE OF STUDS.
- D. ALL DIMENSIONS GOVERN OVER SCALE.
- E. ALL SMOKE DETECTORS ARE TO BE WIRED IN SUCH A MANNER THAT ACTIVATION OF ONE WILL ACTIVATE THEM ALL.
- F. ENCLOSED ACCESSIBLE SPACE UNDER STAIRS SHALL HAVE WALLS AND SOFFITS PROTECTED ON ENCLOSED SIDE WITH 1/2" GYPSUM BOARD.
- G. ALL WINDOWS SIZE ARE NOTED IN FEET + INCHES AS MEASURED FROM SASH TO SASH.
- H. REFER TO ELEVATIONS FOR WINDOW HEAD HEIGHTS.
- I. ALL DOORS ARE TO BE 6'-8" HIGH UNLESS OTHERWISE NOTED.
- J. WASHER ALWAYS TO BE ON LEFT SIDE OF DRYER.
- K. DISHWASHER ALWAYS TO BE ON RIGHT SIDE OF SINK.




5 PART. LEFT ELEV. w/ OPT. 263073 MULTI-GEN. SUITE
 SCALE: 1/4"=1'-0"
 TOL081A_A407.DWG

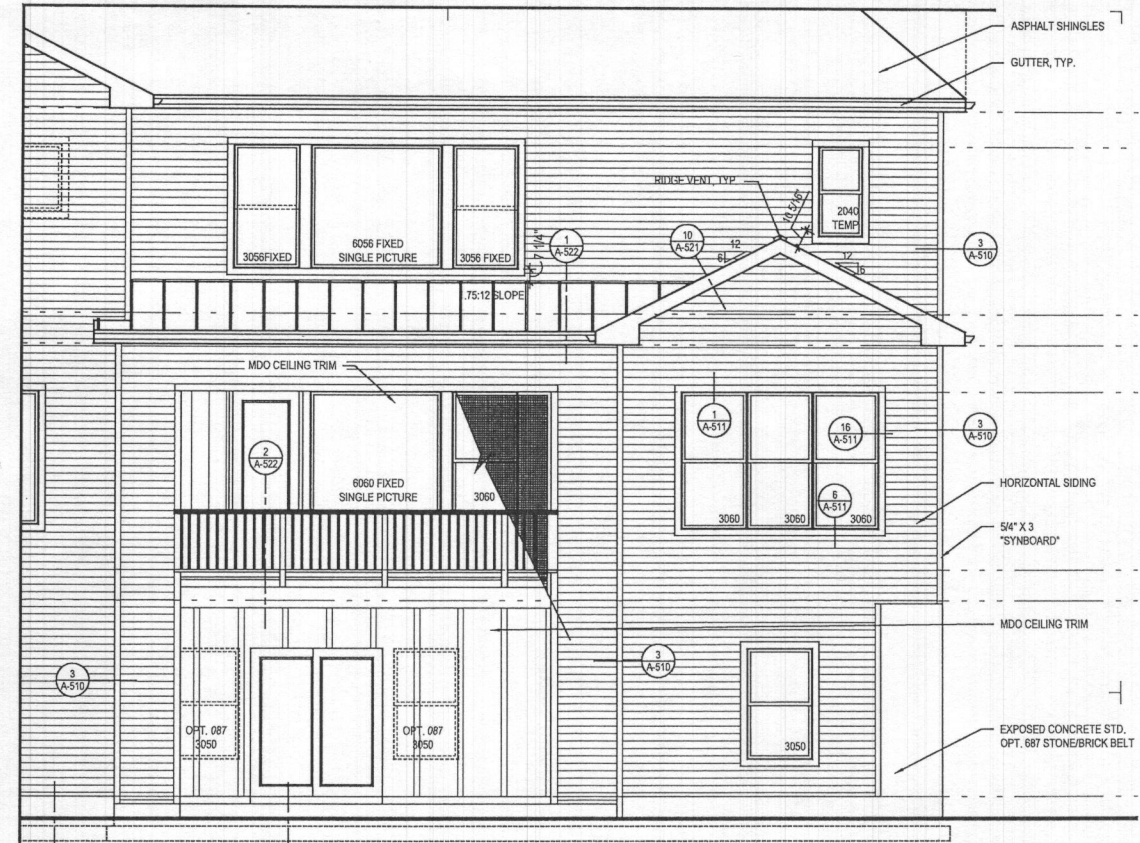


4 REAR ELEVATION w/ OPT. 263073 MULTI-GEN. SUITE
 SCALE: 1/4"=1'-0"
 TOL081A_A407.DWG

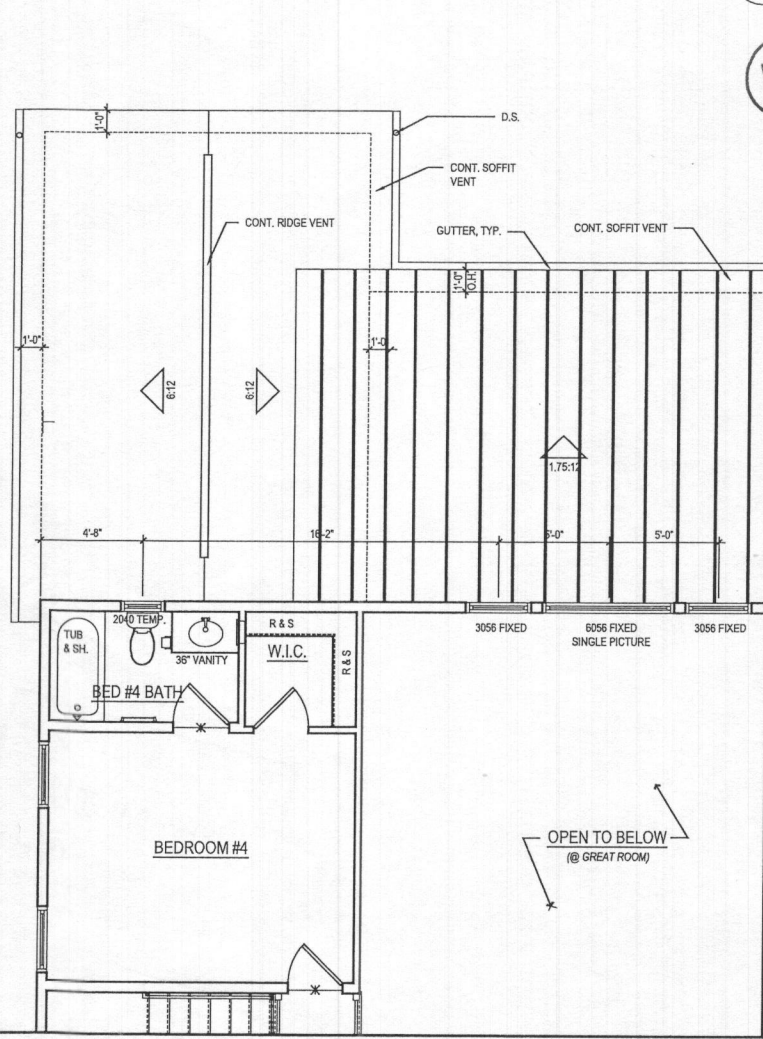

3 PART. SECOND FLOOR PLAN w/ OPT. 263073 MULTI-GEN. SUITE
 SCALE: 1/4"=1'-0"
 TOL081A_A407.DWG

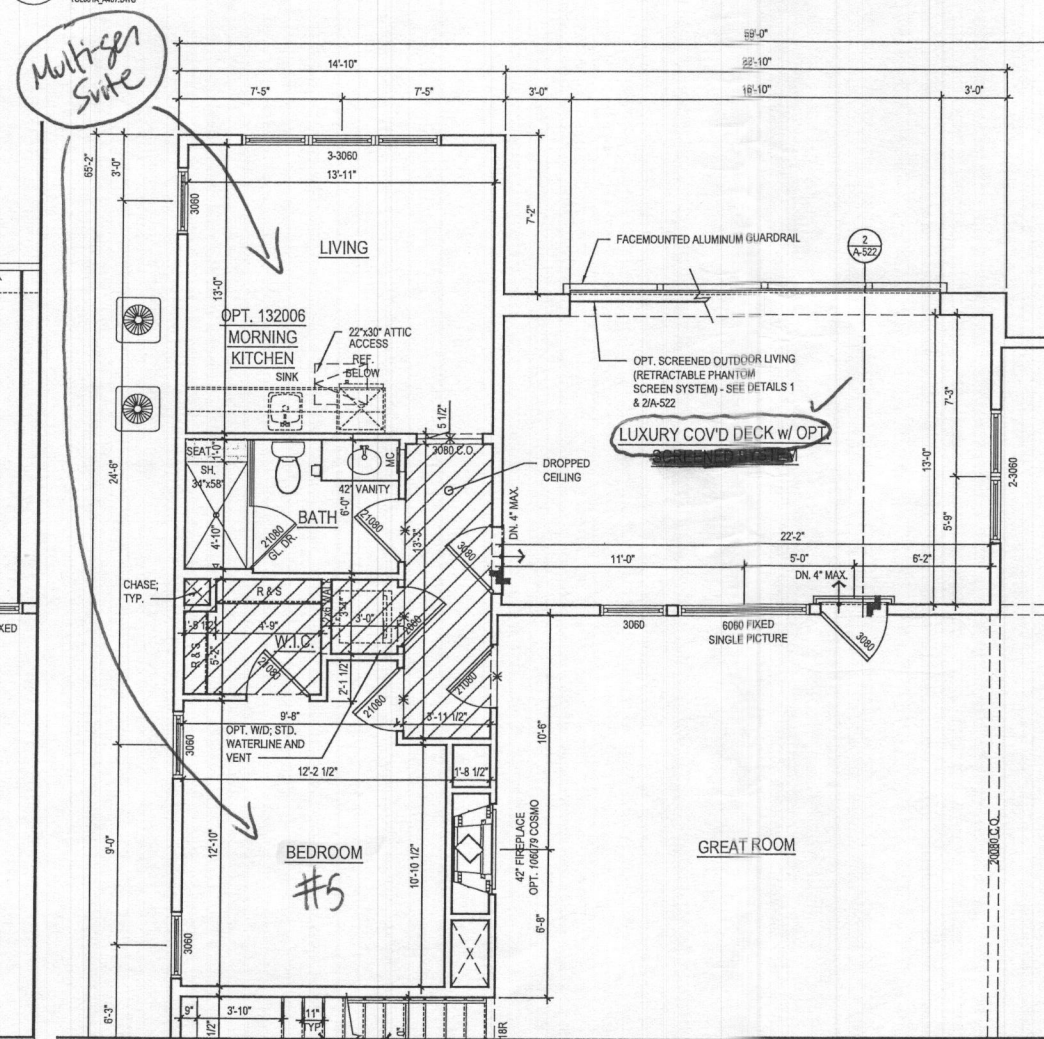

2 PART. FIRST FLOOR PLAN w/ OPT. 263073 MULTI-GEN. SUITE
 SCALE: 1/4"=1'-0"
 TOL081A_A407.DWG

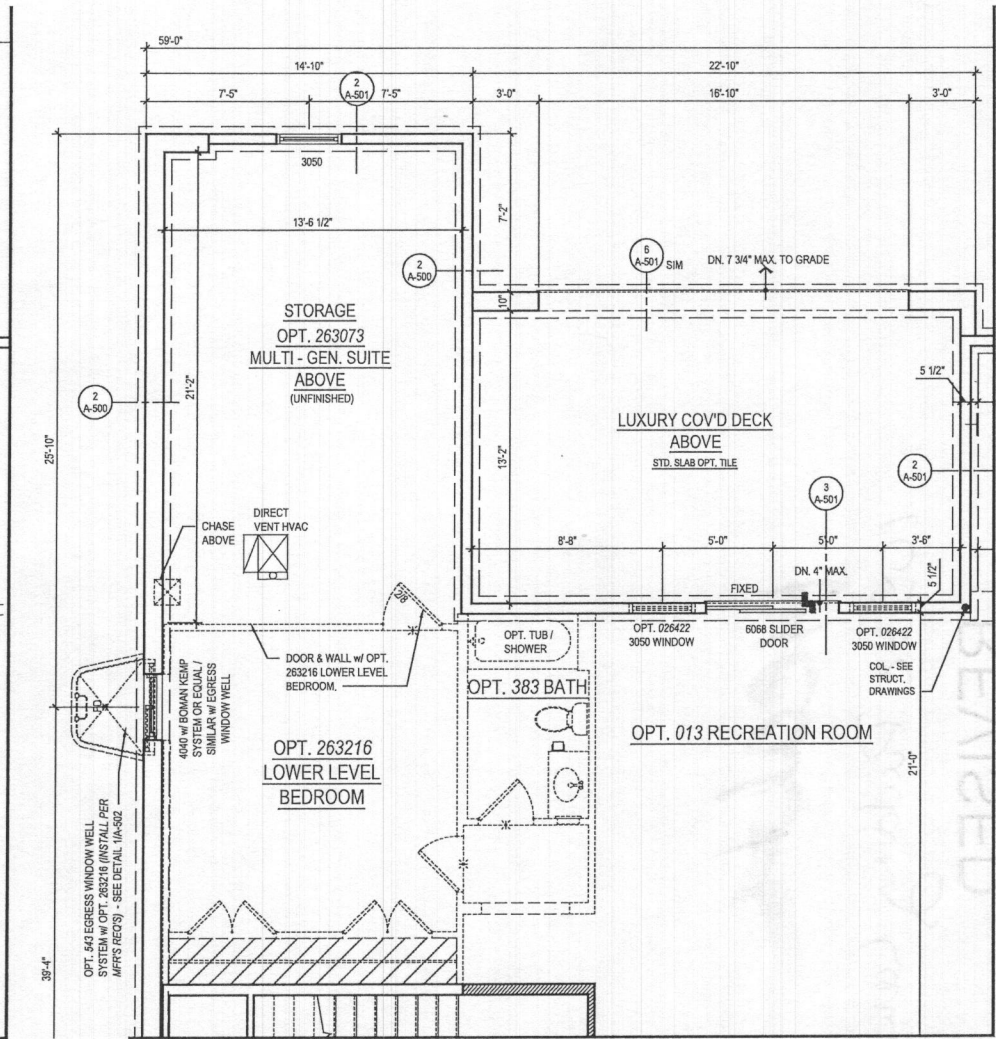

1 PART. BASEMENT PLAN w/ OPT. 263073 MULTI-GEN. SUITE
 SCALE: 1/4"=1'-0"
 TOL081A_A407.DWG

ARCHITECT:

 8521 Leesburg Pike
 Suite 700 | Vienna, VA 22182
 P: 571.830.1800 | F: 571.830.1801
 www.lessarddesign.com

OWNER:
TOLL BROTHERS
 19775 BELMONT EXECUTIVE PLAZA
 ASHBURN, VA 20147
 P: 571.291.8068
 CONTACT: CHRISTINA LEMLEY
 demley@tollbrothers.com


PROJECT NAME: MARYLAND
 SHEET TITLE: PARKHURST OPTIONS

NO.	DESCRIPTION	DATE
1	BID SET	05.29.19
2	PERMIT SET	06.19.19
3	MD NEW STANDARDS	09.16.19
4	MR #220241	12.11.20

PROJECT No: TOL081A
 DRAWN BY: AGR/BN
 CHECKED BY: AP
 PLOT DATE: Jan. 20, 2021
 FILE NAME: TOL081A_A407.dwg

A-407


Plot By: anak
 File No: TOL081A_A407.dwg

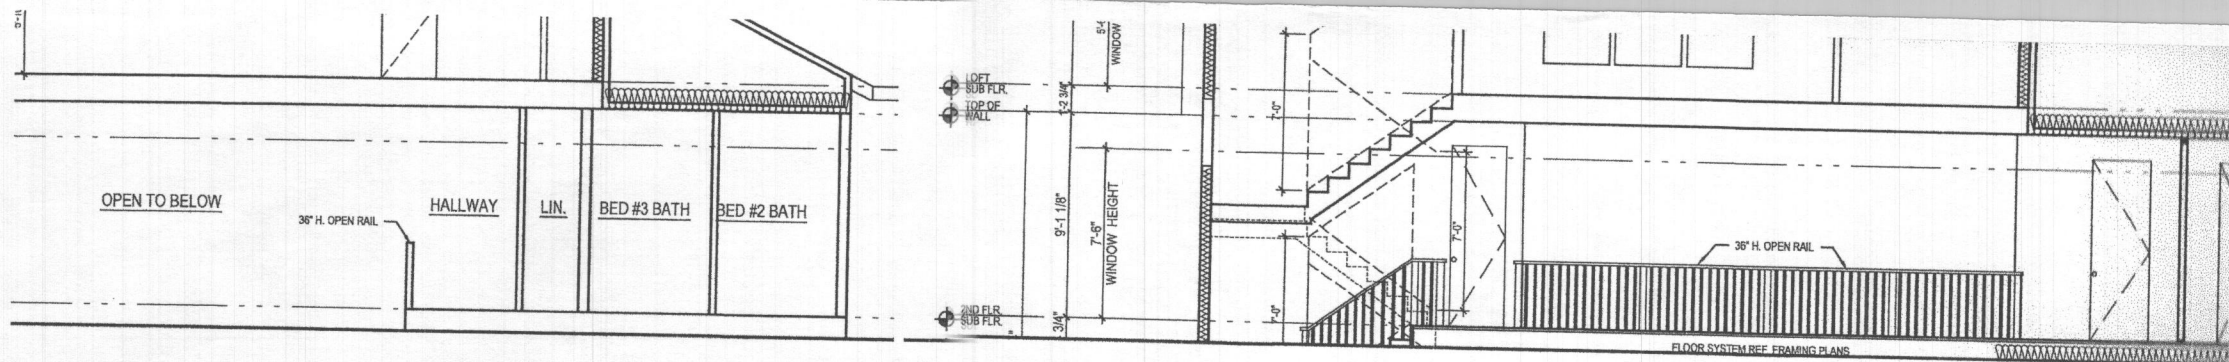


4 ATTIC SECTION
 A-408 SCALE: 1/4"=1'-0"
 w/ OPT. 539 : THIRD FLOOR WALK UP SPACE
 @ ELEV. 2 - MODERN FARMHOUSE, & ELEV. 5 - FAIRVIEW
 N/A W/ ELEV. #1, & #4

3 ATTIC SECTION
 A-408 SCALE: 1/4"=1'-0"
 w/ OPT. 539 : THIRD FLOOR WALK UP SPACE
 @ ELEV. 2 - MODERN FARMHOUSE, & ELEV. 5 - FAIRVIEW
 N/A W/ ELEV. #1, & #4

- NOTES**
- 1. DIMENSIONS NOT DIMENSIONED INTERIOR AND 5/16" FOR EXTERIOR UNLESS OTHERWISE NOTED.
 - 2. DIMENSIONS ARE TO FACE OF STUDS.
 - 3. DIMENSIONS ARE TO FACE OF STUDS.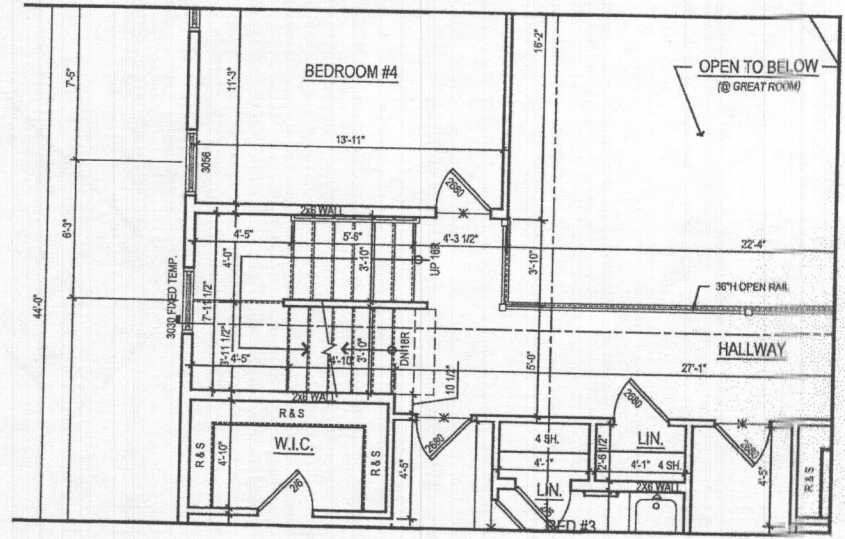

2 PART. SECOND FLOOR PLAN
 A-408 SCALE: 1/4"=1'-0"
 w/ OPT. 539 : THIRD FLOOR WALK UP SPACE
 @ ELEV. 2 - MODERN FARMHOUSE, & ELEV. 5 - FAIRVIEW
 N/A W/ ELEV. #1, & #4

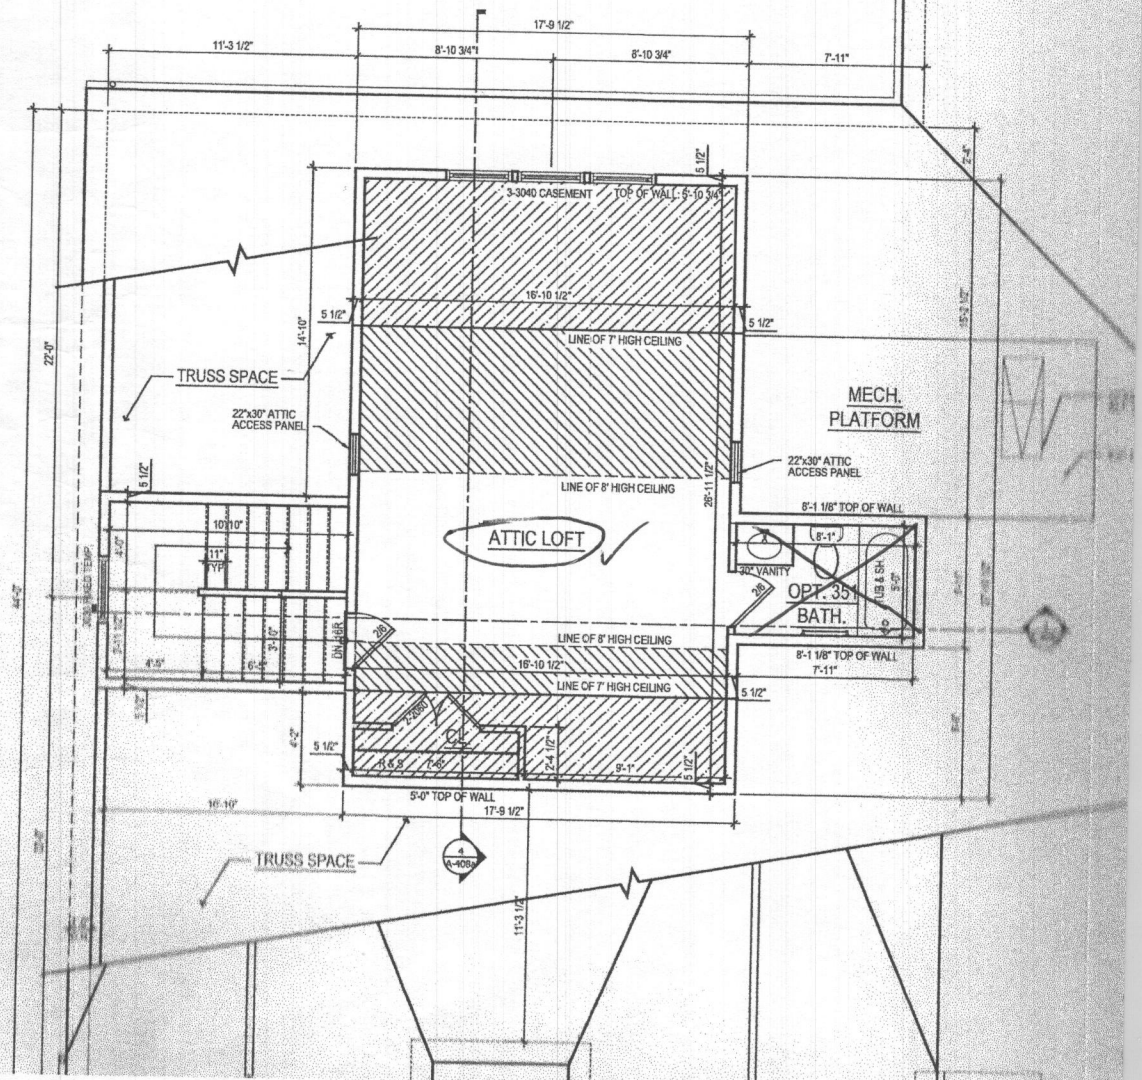

USABLE SPACE	SQ. FT.

- GENERAL PLAN NOTES**
- A. ALL WOOD STUD PARTITIONS NOT DIMENSIONED ARE TO BE 3 1/2" FOR INTERIOR AND 5 1/2" FOR EXTERIOR WALLS UNLESS OTHERWISE NOTED.
 - B. ALL INTERIOR DIMENSIONS ARE TO FACE OF STUDS.
 - C. ALL EXTERIOR DIMENSIONS ARE TO FACE OF STUDS.
 - D. ALL DIMENSIONS GOVERN OVER SCALE.
 - E. ALL SMOKE DETECTORS ARE TO BE WIRED IN SUCH A MANNER THAT ACTIVATION OF ONE WILL ACTIVATE THEM ALL.
 - F. ENCLOSED ACCESSIBLE SPACE UNDER STAIRS SHALL HAVE WALLS AND SOFFITS PROTECTED ON ENCLOSED SIDE WITH 1/2" GYPSUM BOARD.
 - G. ALL WINDOWS SIZE ARE NOTED IN FEET + INCHES AS MEASURED FROM SASH TO SASH.
 - H. REFER TO ELEVATIONS FOR WINDOW HEAD HEIGHTS.
 - I. ALL DOORS ARE TO BE 6'-8" HIGH UNLESS OTHERWISE NOTED.
 - J. WASHER ALWAYS TO BE ON LEFT SIDE OF DRYER.
 - K. DISHWASHER ALWAYS TO BE ON RIGHT SIDE OF SINK.

Health Dept.
 10532 Pudding Lane
 Ellicott City, MD 21042
 Kings Forest - Lot 22

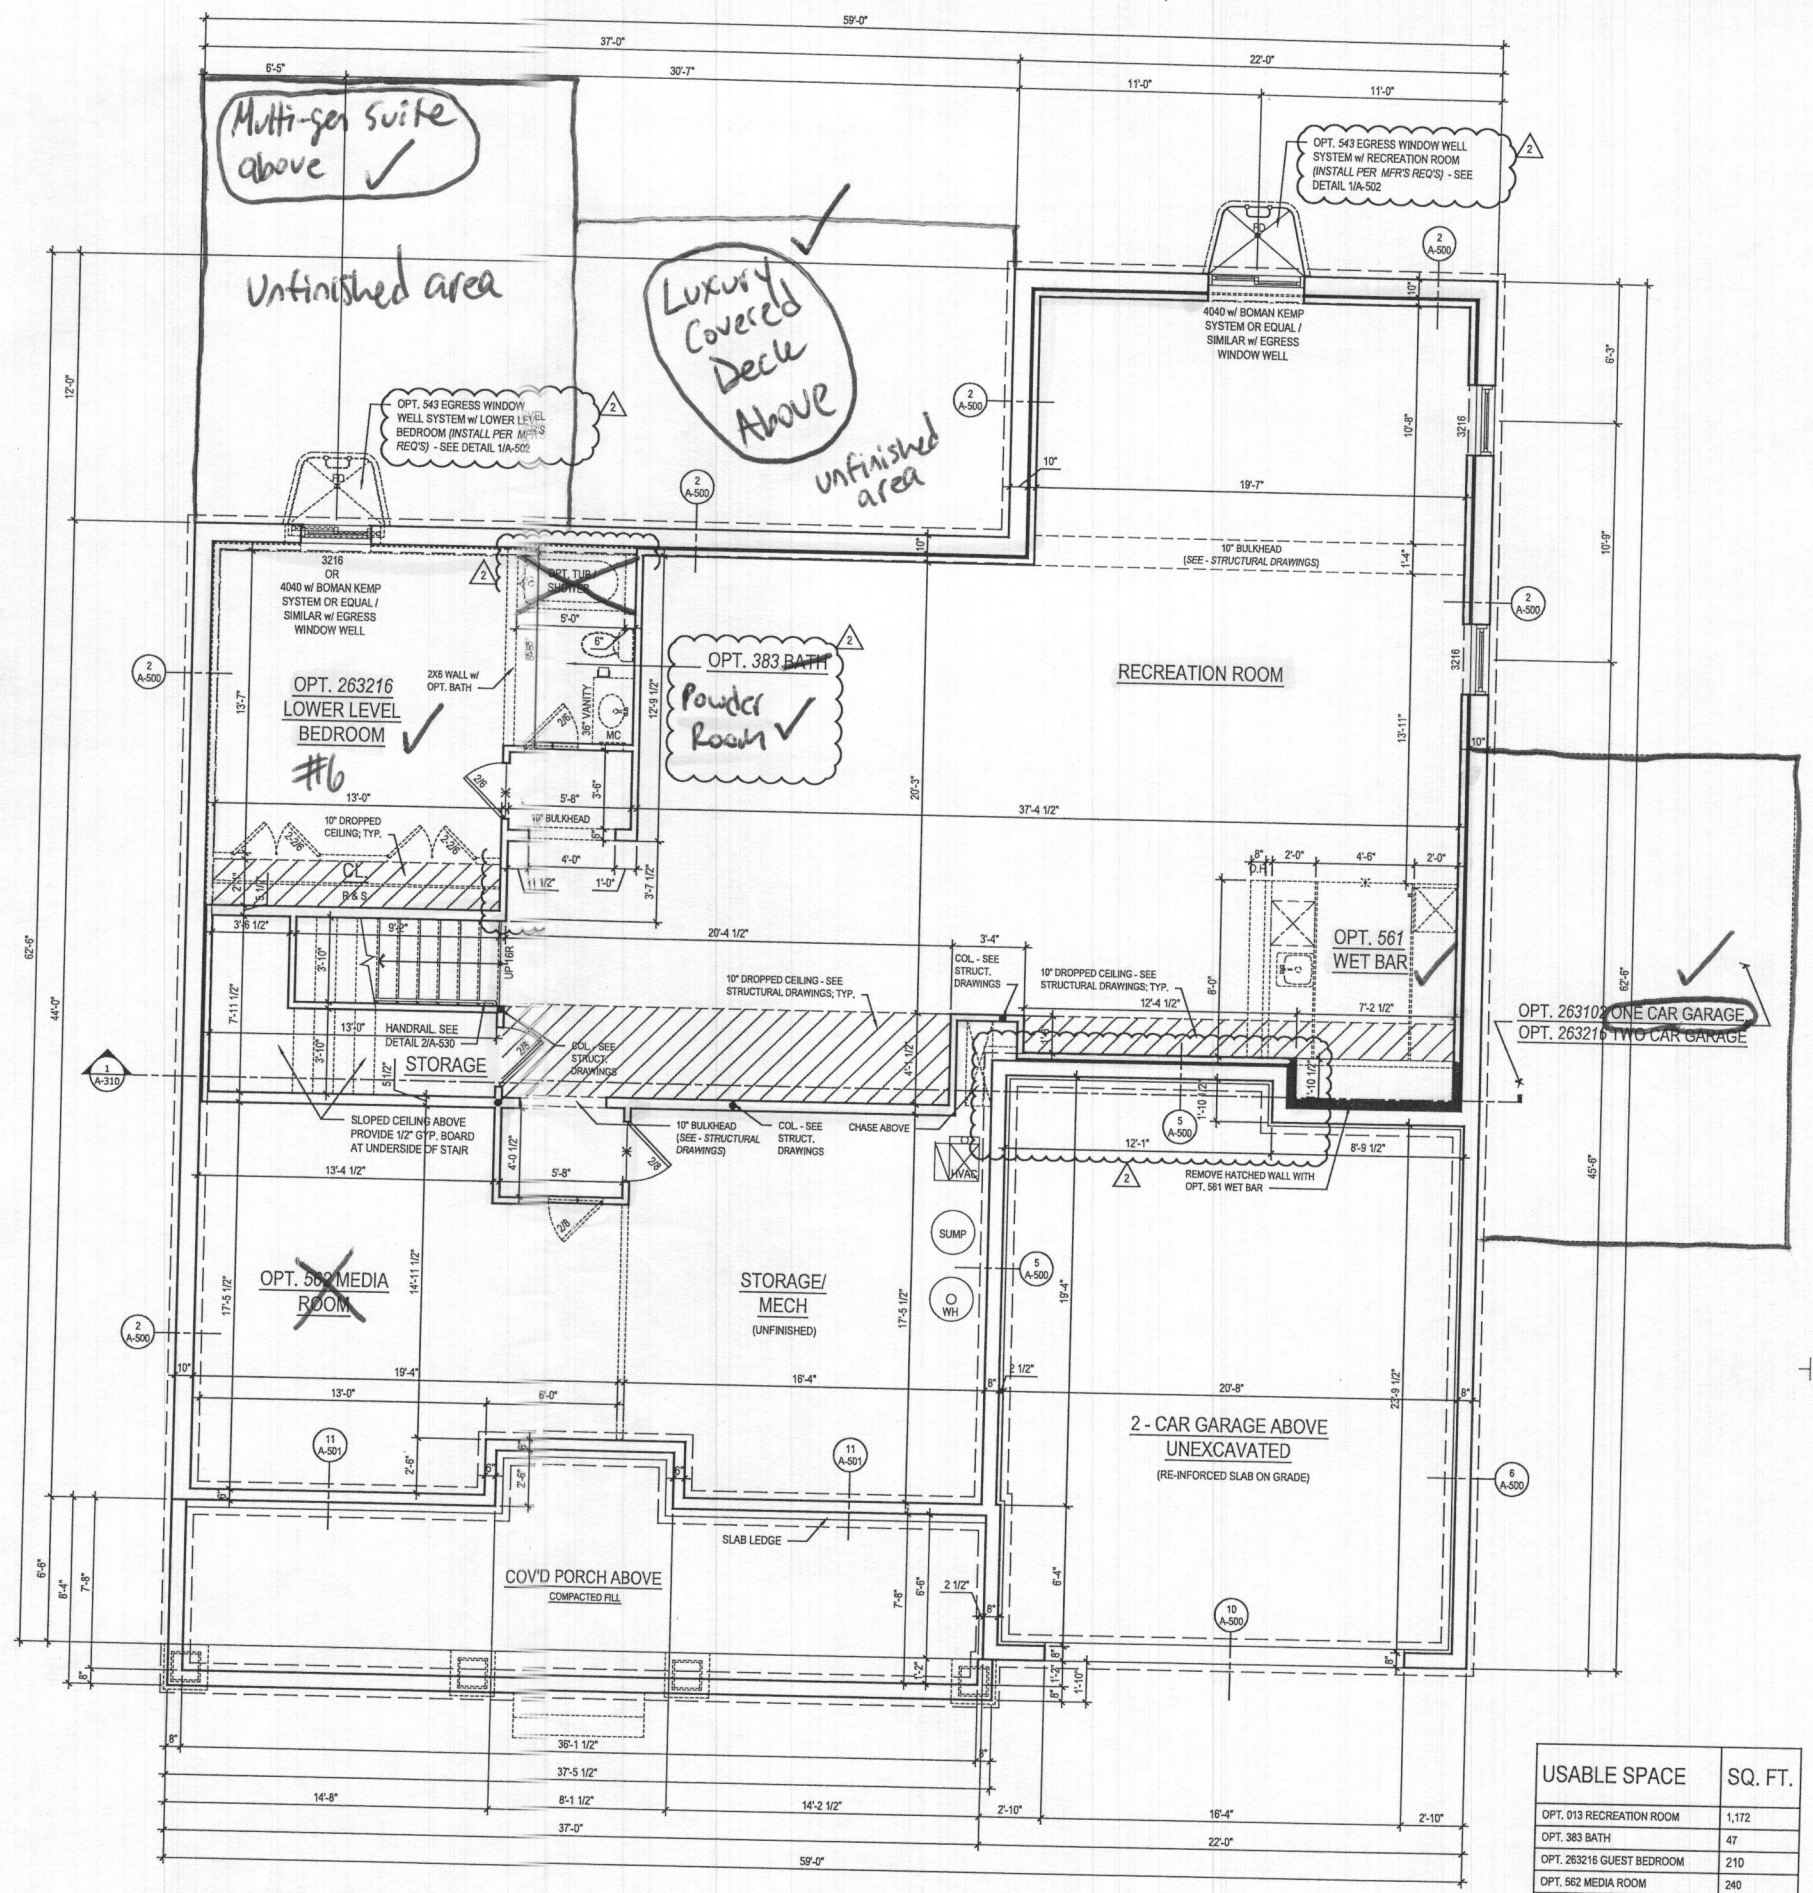

1 BASEMENT FLOOR PLAN
 A-100a SCALE: 1/4"=1'-0"
 TOLBIA, AIA, INC.

W/ OPT 013 RECREATION ROOM @ ELEV. 1 - CRAFTSMAN @ FINISHED CONDITION

USABLE SPACE	SQ. FT.
OPT. 013 RECREATION ROOM	1,172
OPT. 383 BATH	47
OPT. 263216 GUEST BEDROOM	210
OPT. 562 MEDIA ROOM	240
TOTAL	1,669

Sec "Fairview" Elev.

ARCHITECT:
lessard DESIGN
 8521 Leesburg Pike
 Suite 700 | Vienna, VA 22182
 P: 571.830.1800 | F: 571.830.1801
 www.lessarddesign.com

SEAL & SIGNATURE:
 OWNER:
TOLL BROTHERS
 19775 BELMONT EXECUTIVE PLAZA
 ASHBURN, VA 20147
 P: 571.291.8068
 CONTACT: CHRISTINA LEMLEY
 clemley@tollbrothers.com


PROJECT NAME:
MARYLAND
 SHEET TITLE:
PARKHURST FLOOR PLANS

NO.	DESCRIPTION	DATE
1	BID SET	05.29.19
2	PERMIT SET	06.19.19
1	MD NEW STANDARDS	09.16.19
2	MR #220241	12.11.20


PROJECT No: TOL081a
 DRAWN BY: ACJR
 CHECKED BY: AP
 PLOT DATE: Jan. 20, 2021
 FILE NAME: TOL081a_A100.dwg

A-100a

- GENERAL PLAN NOTES**
- ALL WOOD STUD PARTITIONS NOT DIMENSIONED ARE TO BE 3 1/2" FOR INTERIOR AND 5 1/2" FOR EXTERIOR WALLS UNLESS OTHERWISE NOTED.
 - ALL INTERIOR DIMENSIONS ARE TO FACE OF STUDS.
 - ALL EXTERIOR DIMENSIONS ARE TO FACE OF STUDS.
 - ALL DIMENSIONS GOVERN OVER SCALE.
 - ALL SMOKE DETECTORS ARE TO BE WIRED IN SUCH A MANNER THAT ACTIVATION OF ONE WILL ACTIVATE THEM ALL.
 - ENCLOSED ACCESSIBLE SPACE UNDER STAIRS SHALL HAVE WALLS AND SOFFITS PROTECTED ON ENCLOSED SIDE WITH 1/2" GYPSUM BOARD.
 - ALL WINDOWS SIZE ARE NOTED IN FEET + INCHES AS MEASURED FROM SASH TO SASH.
 - REFER TO ELEVATIONS FOR WINDOW HEAD HEIGHTS.
 - ALL DOORS ARE TO BE 6'-8" HIGH UNLESS OTHERWISE NOTED.
 - WASHER ALWAYS TO BE ON LEFT SIDE OF DRYER.
 - DISHWASHER ALWAYS TO BE ON RIGHT SIDE OF SINK.

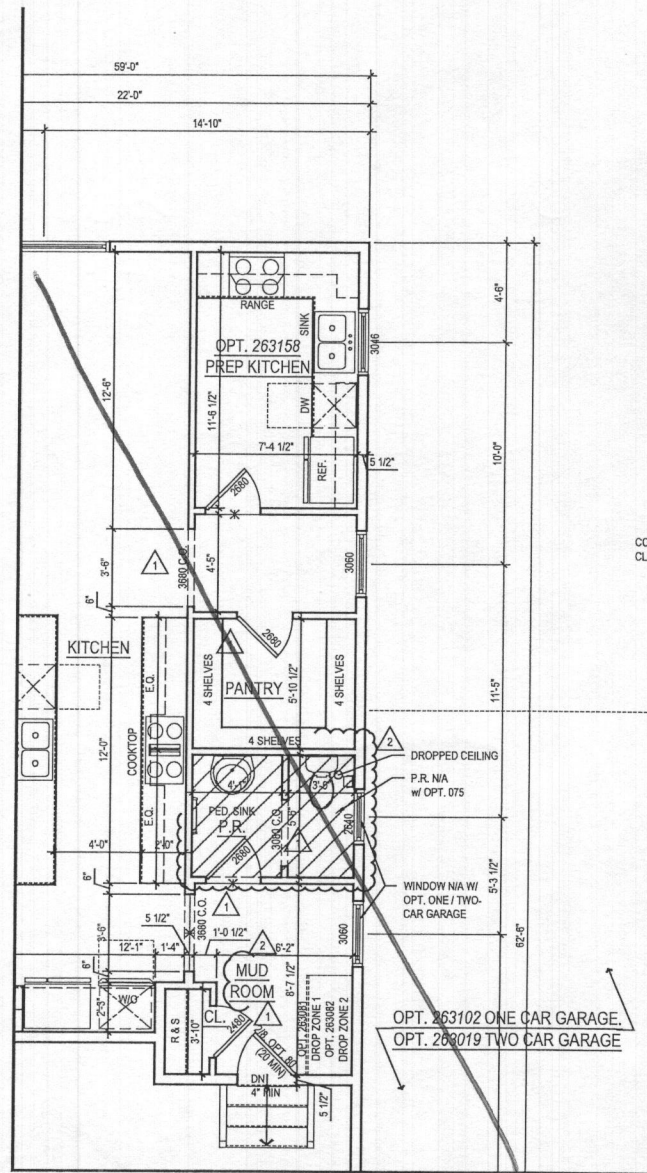

2 PART. FIRST FLOOR PLAN w/ OPT. 263158 - OPT. PREP KITCHEN
 A-110 SCALE: 1/4"=1'-0"
 TOL081A110.DWG

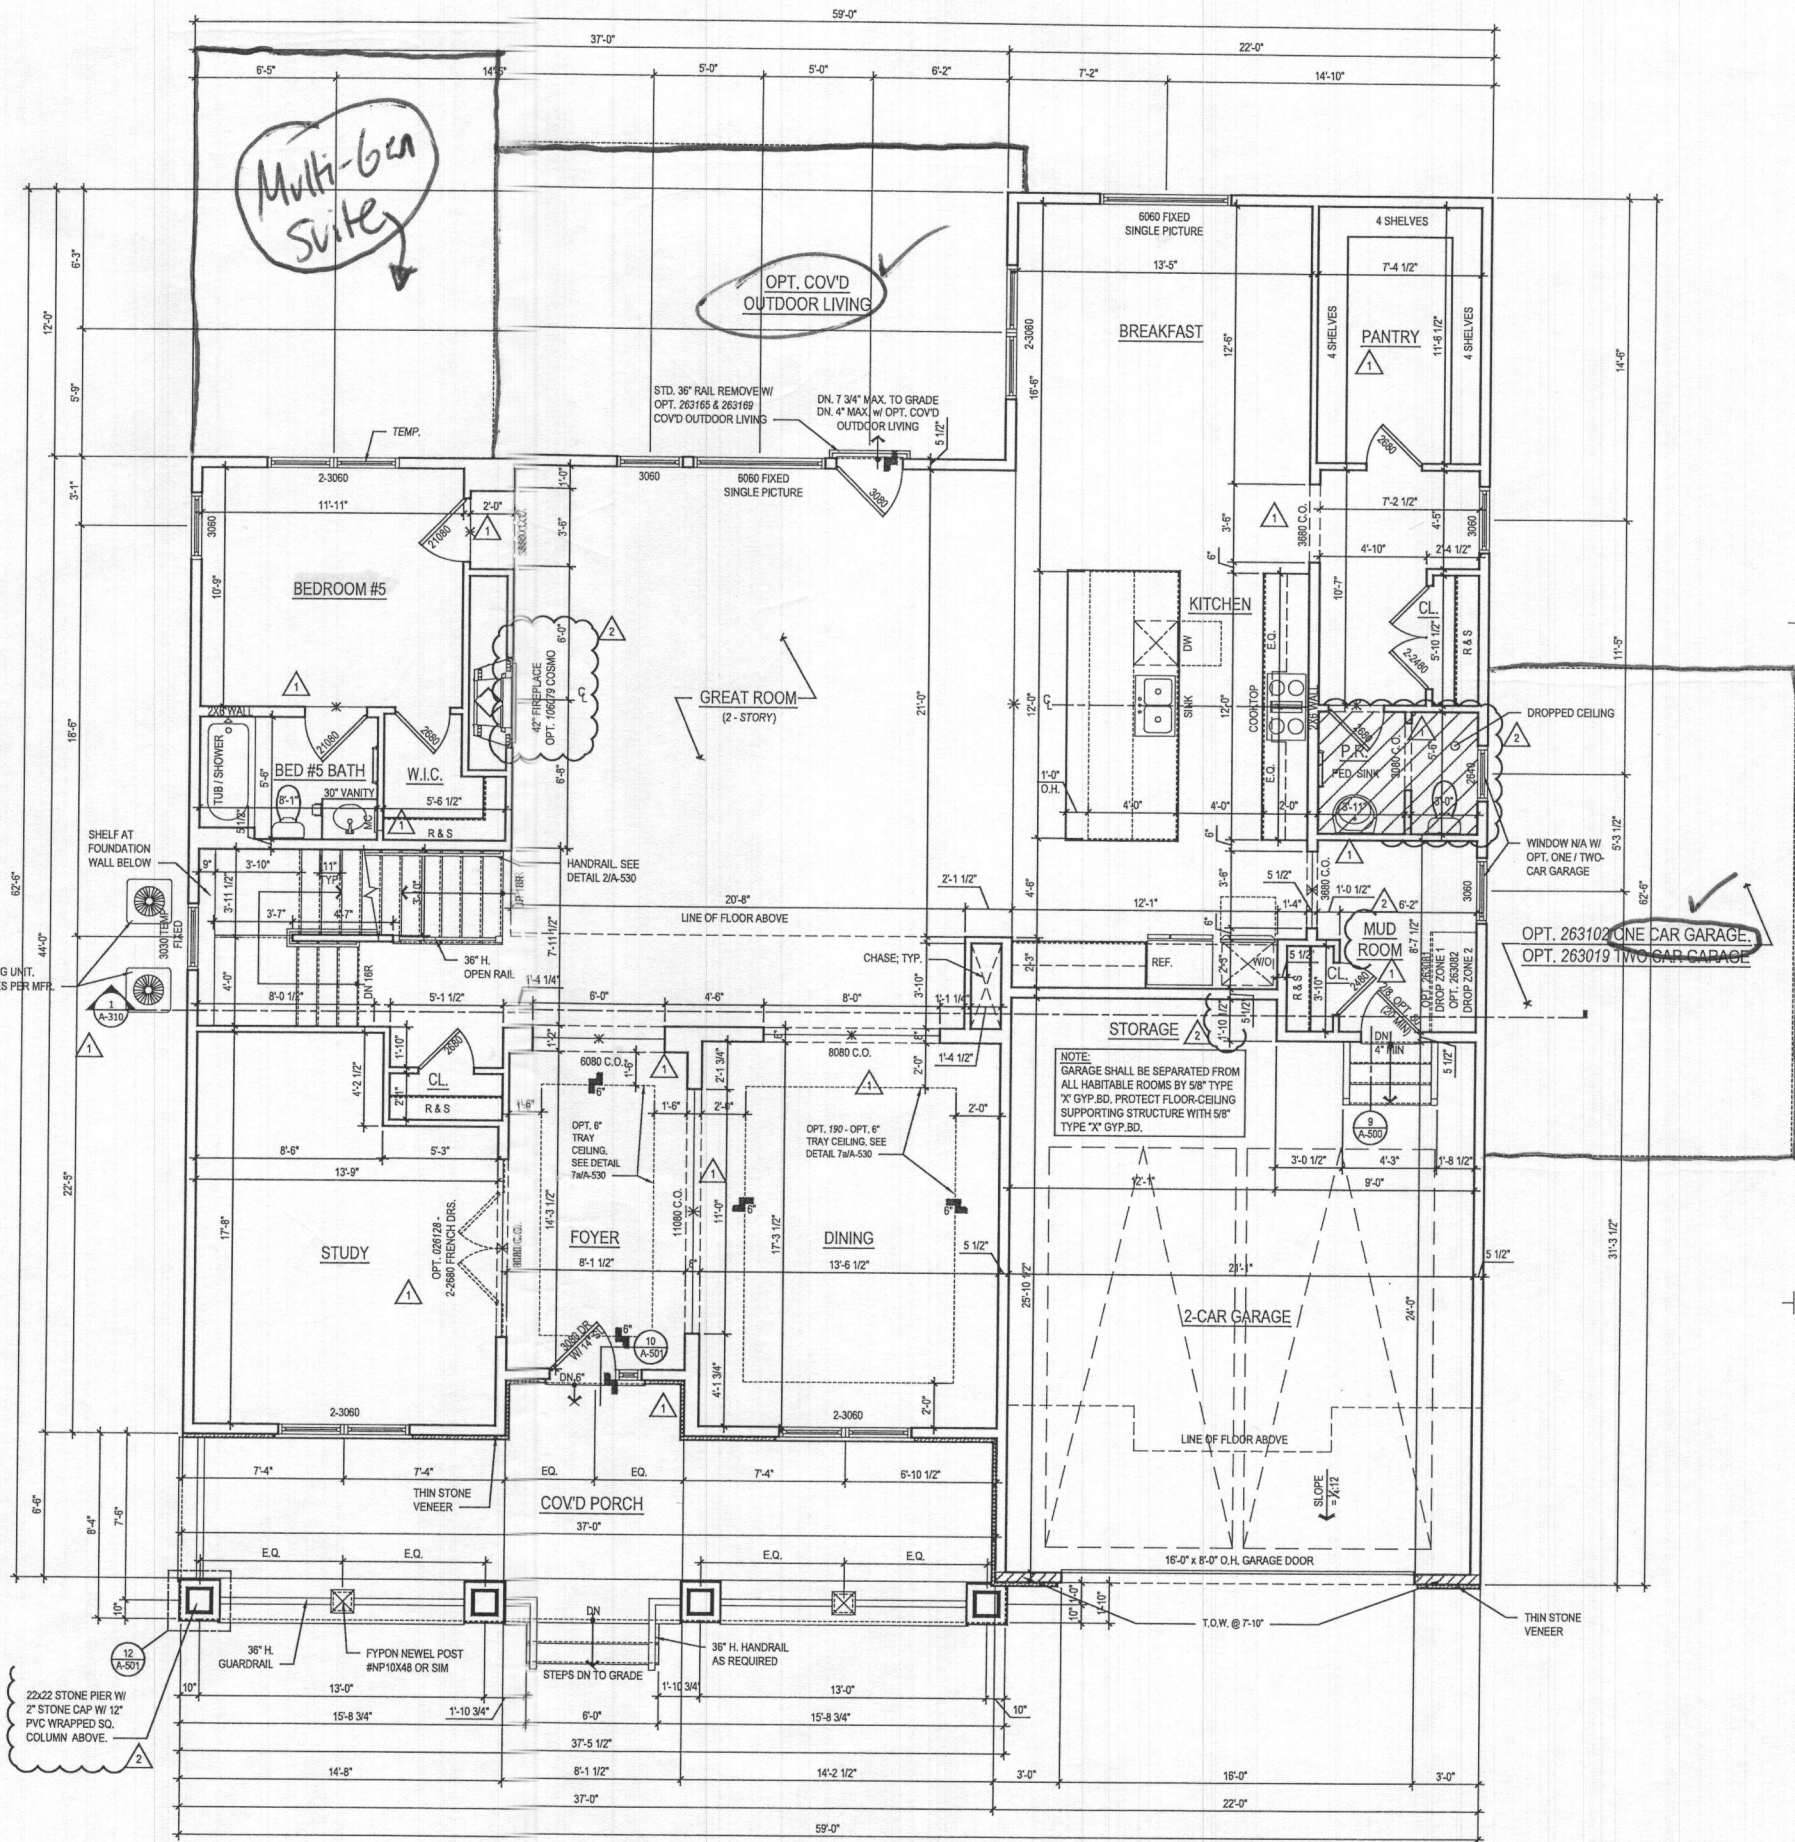

1 FIRST FLOOR PLAN
 A-110 SCALE: 1/4"=1'-0"
 TOL081A110.DWG

@ ELEV. 1 - CRAFTSMAN SHOWN
 See "Fairview" Elev.

ARCHITECT:

 8521 Leesburg Pike
 Suite 700 | Vienna, VA 22182
 P: 571.830.1800 | F: 571.830.1801
 www.lessarddesign.com

SEAL & SIGNATURE:
 OWNER:
 TOLL BROTHERS
 19775 BELMONT EXECUTIVE PLAZA
 ASHBURN, VA 20147
 P: 571.291.8068
 CONTACT: CHRISTINA LEMLEY
 clemley@tollbrothers.com


PROJECT NAME: MARYLAND
 SHEET TITLE: PARKHURST FLOOR PLANS

ISSUE / REVISION		
NO.	DESCRIPTION	DATE
BID SET		05.29.19
PERMIT SET		06.19.19
1	MD NEW STANDARDS	09.16.19
2	MR #220241	12.11.20

PROJECT No: TOL081A
 DRAWN BY: AC/RN
 CHECKED BY: AP
 PLOT DATE: Jan. 20, 2021
 FILE NAME: TOL081A-A110.dwg


A-110

File No: TOL081A-A110.dwg
 Plot By: analk

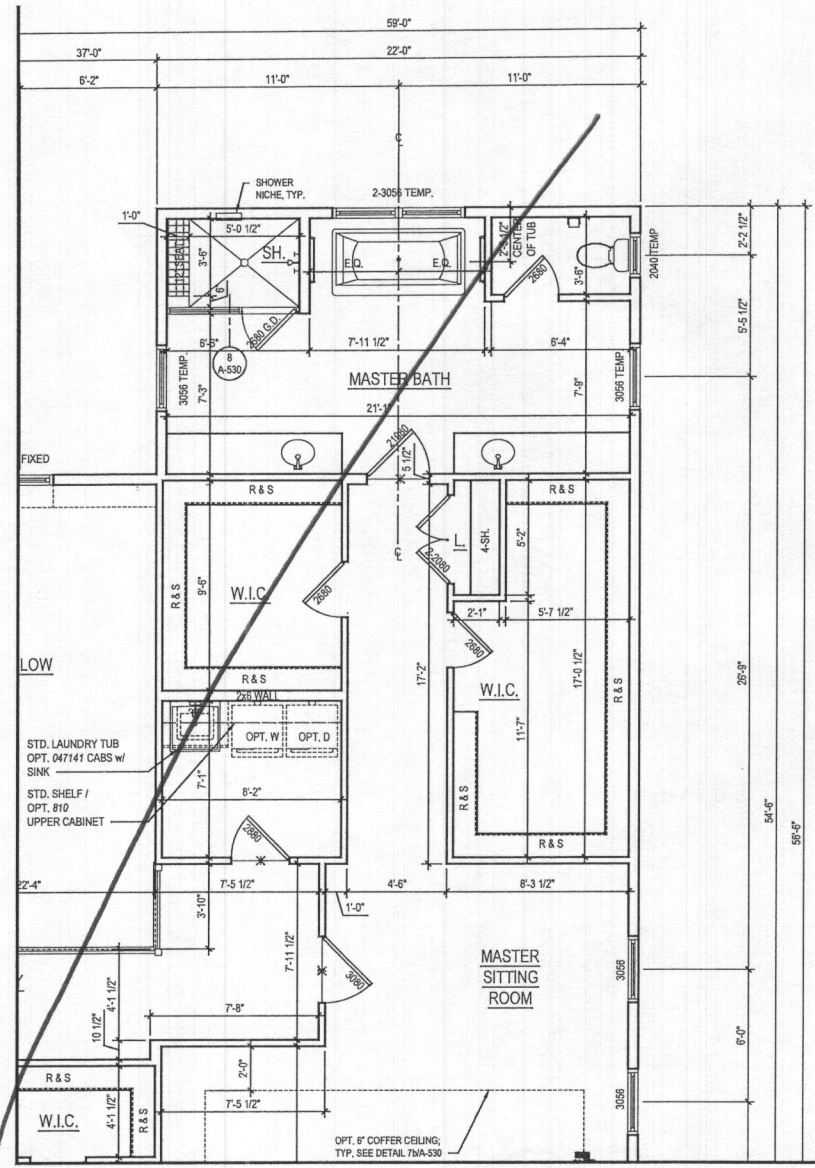

2 PART. SECOND FLOOR PLAN w/ OPT. 030 - ADDITIONAL WALK IN CLOSET
 A-120 SCALE: 1/4"=1'-0"
 TOL081a_A120.dwg

- GENERAL PLAN NOTES**
- A. ALL WOOD STUD PARTITIONS NOT DIMENSIONED ARE TO BE 3 1/2" FOR INTERIOR AND 5 1/2" FOR EXTERIOR WALLS UNLESS OTHERWISE NOTED.
 - B. ALL INTERIOR DIMENSIONS ARE TO FACE OF STUDS.
 - C. ALL EXTERIOR DIMENSIONS ARE TO FACE OF STUDS.
 - D. ALL DIMENSIONS GOVERN OVER SCALE.
 - E. ALL SMOKE DETECTORS ARE TO BE WIRED IN SUCH A MANNER THAT ACTIVATION OF ONE WILL ACTIVATE THEM ALL.
 - F. ENCLOSED ACCESSIBLE SPACE UNDER STAIRS SHALL HAVE WALLS AND SOFFITS PROTECTED ON ENCLOSED SIDE WITH 1/2" GYPSUM BOARD.
 - G. ALL WINDOWS SIZE ARE NOTED IN FEET + INCHES AS MEASURED FROM SASH TO SASH.
 - H. REFER TO ELEVATIONS FOR WINDOW HEAD HEIGHTS.
 - I. ALL DOORS ARE TO BE 6'-8" HIGH UNLESS OTHERWISE NOTED.
 - J. WASHER ALWAYS TO BE ON LEFT SIDE OF DRYER.
 - K. DISHWASHER ALWAYS TO BE ON RIGHT SIDE OF SINK.

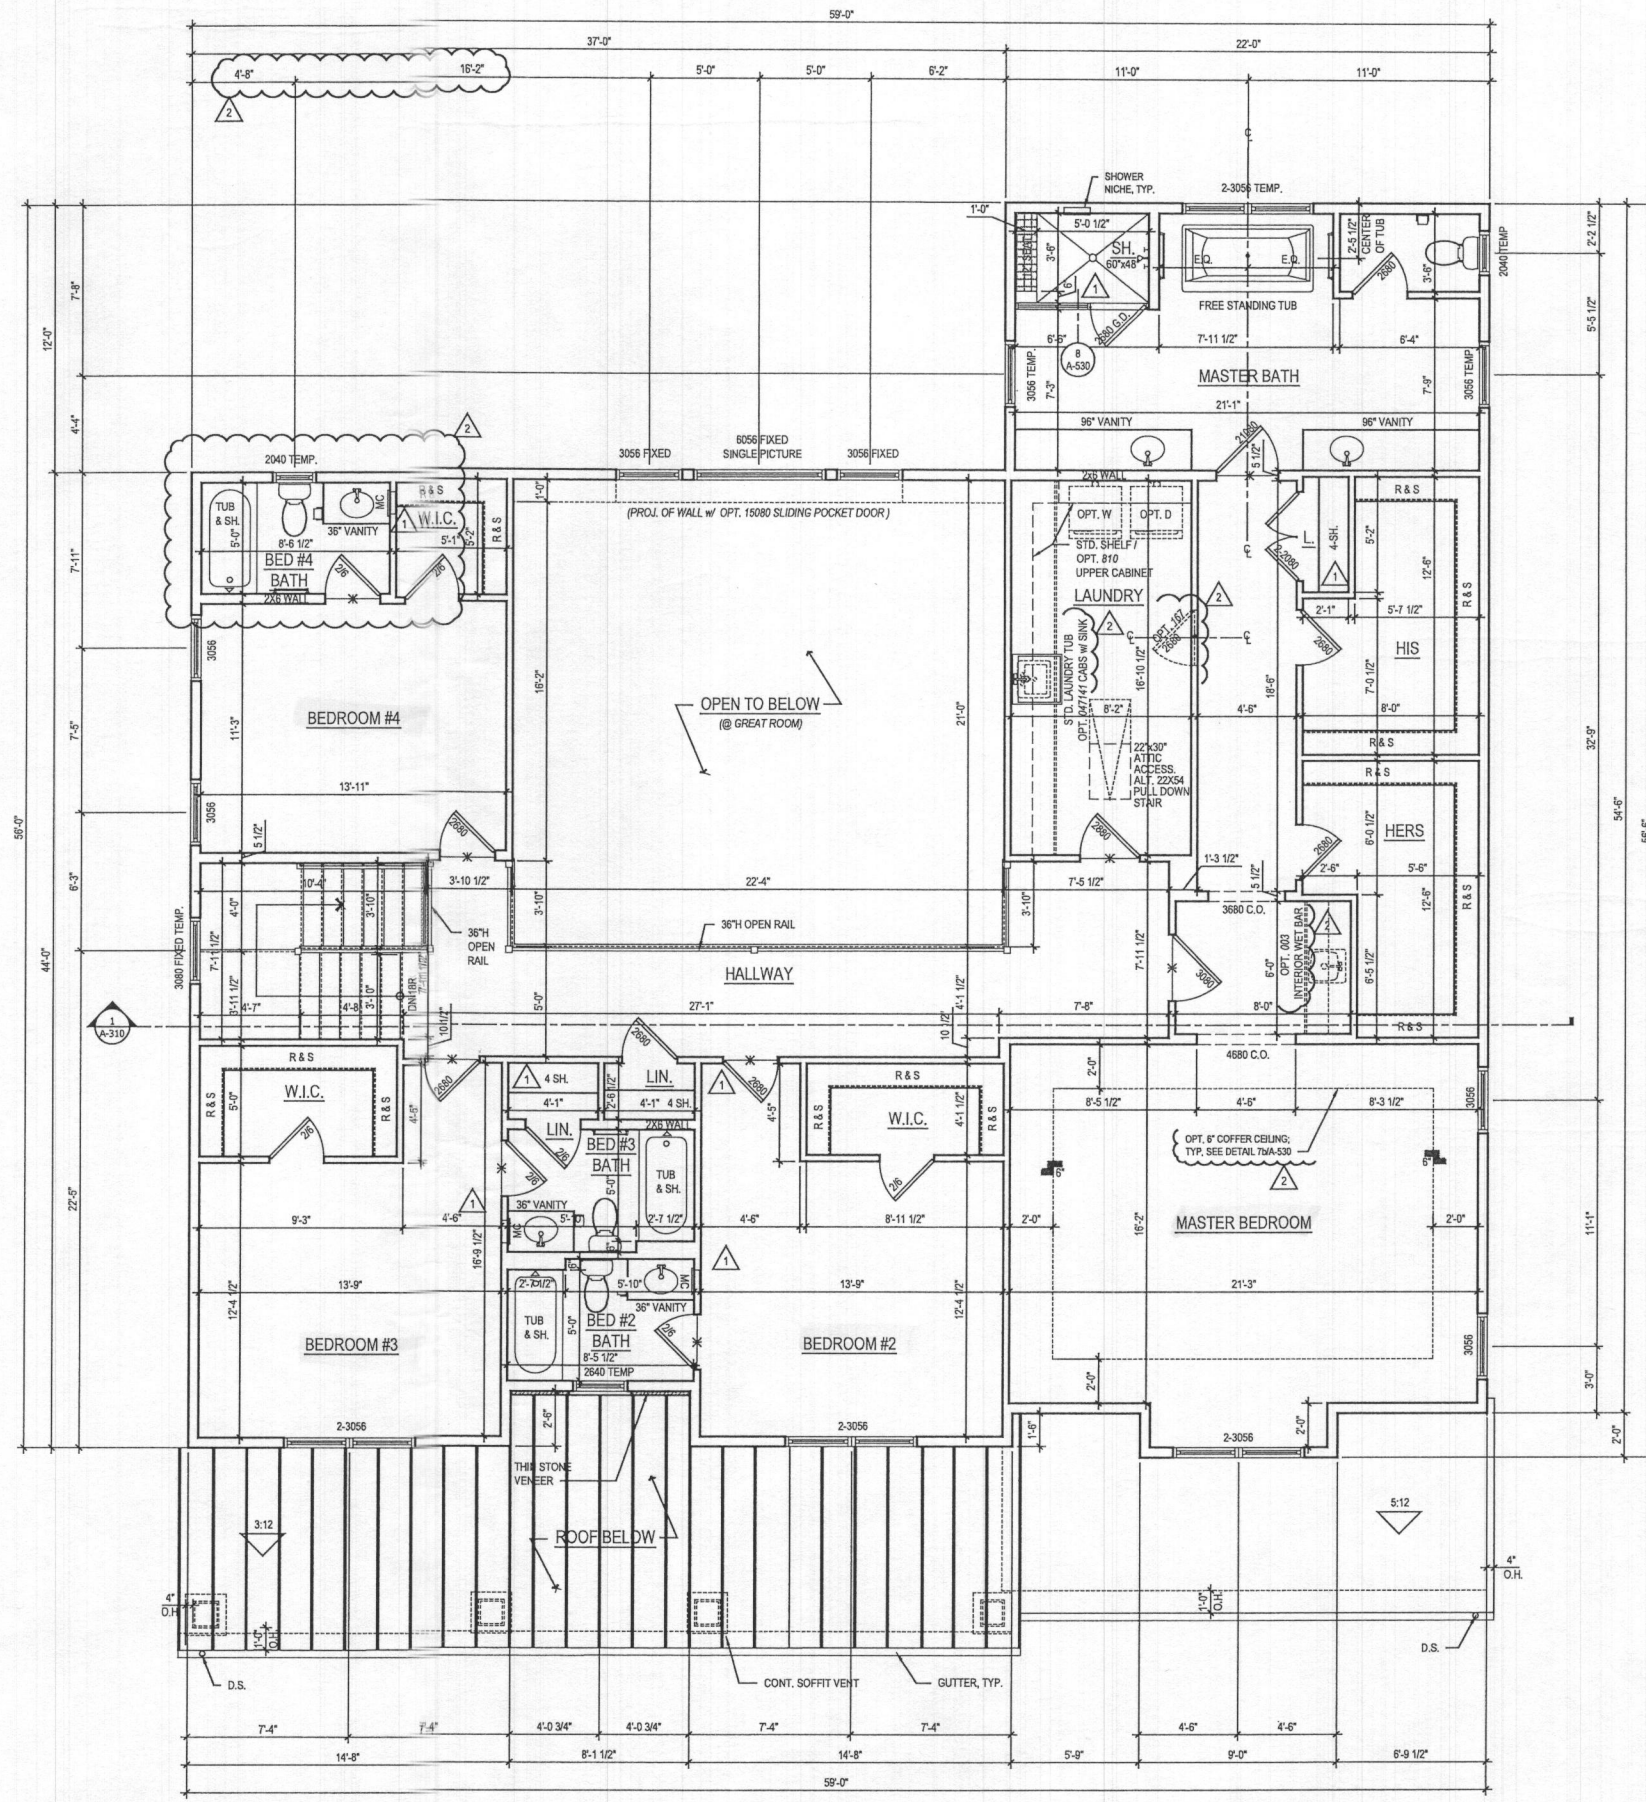

1 SECOND FLOOR PLAN
 A-120 SCALE: 1/4"=1'-0"
 TOL081a_A120.dwg

@ ELEV. 1 - CRAFTSMAN *Shown*
 See "Fairview" Elev.

ARCHITECT:

8521 Leesburg Pike
 Suite 700 | Vienna, VA 22182
 P: 571.830.1800 | F: 571.830.1801
 www.lessarddesign.com

SEAL & SIGNATURE:

OWNER:

TOLL BROTHERS
 19775 BELMONT EXECUTIVE PLAZA
 ASHBURN, VA 20147
 P: 571.291.8068
 CONTACT: CHRISTINA LEMLEY
 clemley@tollbrothers.com

PROJECT NAME: MARYLAND

SHEET TITLE: PARKHURST FLOOR PLANS

ISSUE / REVISION		
NO.	DESCRIPTION	DATE
BID SET		05.29.19
PERMIT SET		06.19.19
1 MD NEW STANDARDS		09.16.19
2 MR #220241		12.11.20

PROJECT No: TOL081a
 DRAWN BY: AC/BN
 CHECKED BY: AP
 PLOT DATE: Jan. 20, 2021
 FILE NAME: TOL081a_A120.dwg

A-120