



\*\*\*\*\*  
 WATER WELL ABANDONMENT SEALING REPORT FORM  
 \*\*\*\*\*

SUBMIT COPIES OF COMPLETED FORM TO:

- \* COUNTY ENVIRONMENTAL AGENCY (contact MDE, WMA if address needed)
- \* WELL OWNER
- \* MDE, WATER MANAGEMENT ADMINISTRATION, WELL PROGRAM

DATE WELL ABANDONED: 6-27-2023 (month/day/year)

\* PERMIT NUMBER OF ABANDONED WELL (if any)

HP-81-1197  
 - -

\* PERMIT NUMBER OF REPLACEMENT WELL:

\* PERSON ABANDONING WELL: Larry Mayer

WELL DRILLER'S LICENSE NUMBER: 027


CIRCLE: MWD / MSD / MGD

\* OWNER'S NAME: Janet Sowers

SITE LOCATION MAP

\* WELL LOCATION:

COUNTY: Howard  
 NEAREST TOWN: Marysville, Md. 21104  
 TAX MAP \_\_\_\_\_ BLOCK \_\_\_\_\_ PARCEL \_\_\_\_\_  
 SUBDIVISION: \_\_\_\_\_  
 SECTION: \_\_\_\_\_ LOT: \_\_\_\_\_  
 STREET ADDRESS: 1641 Herrington Rd.

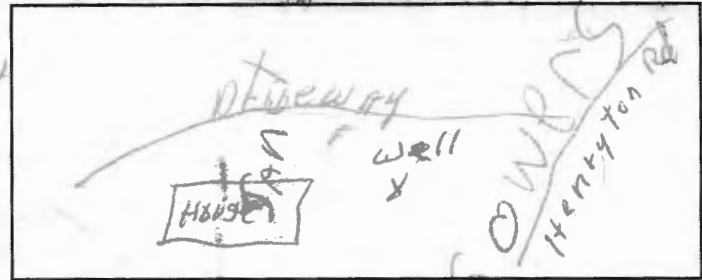

LATITUDE 3 9.32955

LONGITUDE 7 6.92165

LOG OF SEALING MATERIAL

- \* TYPE OF WELL BEING ABANDONED:  
 DRILLED                       JETTED  
 BORED                           HAND DUG  
 OTHER (specify) \_\_\_\_\_

MATERIAL	FEET	
	FROM	TO
<u>Cement &amp; Grout</u>	<u>0</u>	<u>600</u>
<u>Store 3 yard 8,100 pound</u>		
VOLUME OF MATERIAL USED		
<u>Cement 22 bags 2,058 pound WATER-132</u>		

- \* USE CODE:  
 DOMESTIC                       MUNICIPAL/PUBLIC  
 IRRIGATION                       INDUSTRIAL  
 TEST/OBSERVATION               GEOTHERMAL

- \* TYPE OF CASING:  
 STEEL                               PLASTIC  
 CONCRETE                       OTHER (specify) \_\_\_\_\_

SIZE OF CASING: 6 INCHES IN DIAMETER

DEPTH OF WELL: 600 FEET DEEP

WAS ANY CASING REMOVED? YES  NO   
 If yes, length removed, in feet: \_\_\_\_\_

WAS CASING RIPPED OR PERFORATED? YES  NO

Larry Mayer  
 SIGNATURE-MASTER WELL DRILLER OR SUPERVISING SANITARIAN LICENSE#

027                      MWD / MSD / MGS                      6-27-2023  
 CIRCLE ONE                      DATE

Pursuant to § 10-624 of the State Govt. Article of the Maryland Code, personal info requested on this form is used in processing this form pursuant to COMAR 26.04.04. Failure to provide the info may result in this form not being processed. You have the right to inspect, amend, or correct this form. The Maryland Department of the Environment is subject to the Maryland Public Information Act. This form may be made available on the Internet via MDE's website and is subject to inspection or copying, in whole or in part, by the public and other governmental agencies, if not protected by federal or State Law.





MO-81-1197