

PERMIT

SEWAGE DISPOSAL SYSTEM

MARYLAND STATE DEPARTMENT OF HEALTH

HOWARD COUNTY

ELLICOTT CITY

DISTRICT 3

DATE 4/1/75

4/9/75

INDEXED

File final!!
P 21294 *CB*
A 20174

Bollinger Brothers IS PERMITTED TO INSTALL ALTER

ADDRESS 1345 Bollinger Road, Westminster, Md. PHONE 848-6527

A SEWAGE DISPOSAL SYSTEM LOCATED AT _____

SUBDIVISION _____ ROAD off Indian Hill Drive LOT _____

PROPERTY OWNER Thomas Pozzuoli

ADDRESS _____

SPECIFICATIONS - 3 bedrooms

73-0945

DRAIN FIELD _____ DEPTH _____ FEET. BOTTOM AREA _____ SQ. FT.

SEEPAGE PITS _____ ABSORBENT SIDE-WALL AREA _____ SQ. FT.

SEPTIC TANK CAPACITY 1,000 GALLONS

FOR GARBAGE GRINDER, INCREASE DISPOSAL AREA 22% & TANK CAPACITY 50%.

OTHER Dry well - 360 sq. ft. sidewall area below the inlet. Dry well inlet no deeper than 4 ft. and bottom of dry well no deeper than 12 ft. Place the dry well ^{67 ft in back} ~~312 ft. from~~ of house. the lot line which is 455.71 ft. ~~fraxkxkxk~~ long and runs ⁰ ~~937°53'20"~~ and 25 feet from the lot line which is 451.44 ft. long and runs ⁰ ~~N47°35'30"W~~.

4/1/75 changes per R. Toner SEE PERC.

NOTE: ALL PIPE FROM HOUSE TO DISPOSAL AREA MUST BE CAST IRON.
PERMIT VOID AFTER THREE YEARS.

NOTE: INSTALL STAND PIPES ON SEPTIC TANK AND DRY WELL. STAND PIPE MUST BE 6" DIA.


PLANS APPROVED BY Raymond Hodges DATE 8/20/74
CAST IRON, CONCRETE OR TERRA COTTA ACCEPTED.

FILL SEPTIC TANK AND DISTRIBUTION BOX WITH WATER BEFORE CALLING FOR AN INSPECTION. COVER NO WORK UNTIL INSPECTED AND APPROVED.

NEITHER THE HOWARD COUNTY COMMISSIONERS NOR THE HEALTH DEPARTMENT IS RESPONSIBLE FOR THE SUCCESSFUL OPERATION OF ANY SYSTEM.

A 20174

20174

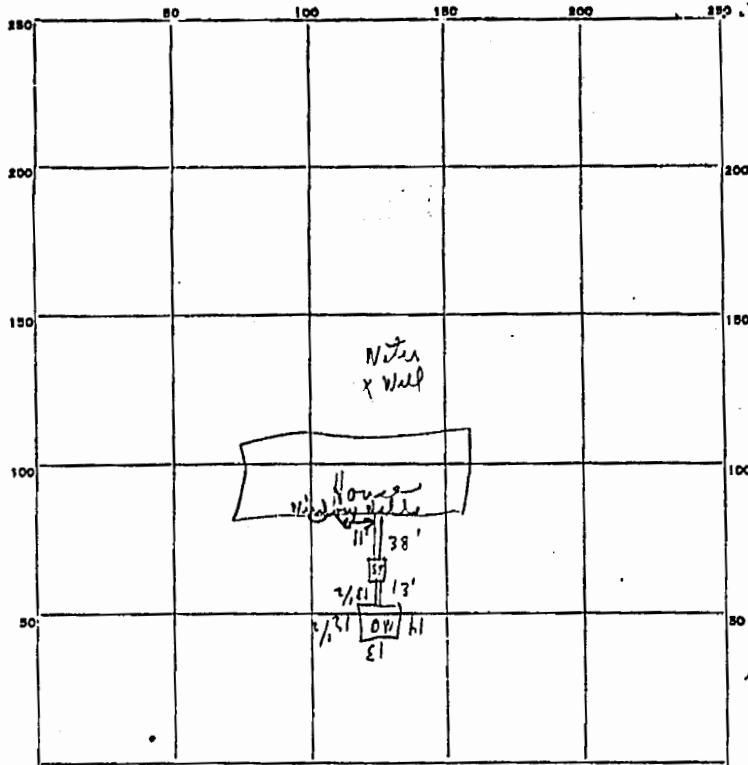

INDICATE NORTH. - NAME ADJOINING ROADWAY AS BASE LINE.

PERMIT CARD Not seen S.T. / P.W.
 SEPTIC TANK, LEVEL OK CLEANOUTS OK / OK
 DISTRIBUTION BOX, LEVEL _____
 TILE FIELD, DEPTH _____ FT. TRENCH WIDTH _____ FT.
 GRAVEL DEPTH _____ IN. TOTAL LENGTH _____ FT. $\frac{13\frac{1}{2}}{-5\frac{1}{2}} = 8'$
 NUMBER OF TRENCHES _____ TOTAL BOTTOM AREA _____
 SEEPAGE PITS, INSIDE DIAMETER outside perimeter 53' FT. DEPTH BELOW INLET 8 ± FT.
 ABSORBENT AREA 424 ± SQ. FT.

REMARKS 4/9/75 set in on all the way.
C.B.S.

DATE SYSTEM APPROVED 4/9/75 as per R. Jones INSPECTOR C. B. Steahe