

OFFICE USE ONLY

CONTROL NO.: _____
 PERMIT NO.: _____
 INSPECTED BY: _____
 DATE INSPECTED: _____

SEWER CONNECTION APPLICATION HOWARD COUNTY

DEPARTMENT OF PUBLIC WORKS
 3430 COURT HOUSE DR. ELLICOTT CITY, MD. 21043

Society
 Account No. 671166

APPLICATION NO.: _____
 CONTRACT NO.: 3729-D
 REBATE CONTRACT NO.: _____
 SEWER ZONE: _____
 CONNECTION WORKSHEET Y ___ N ___

FILL OUT APPLICATION COMPLETELY AND SIGN BELOW. IF LOCATION INFORMATION UNKNOWN, CONTACT THE OFFICE OF PLANNING AND ZONING FOR HOUSE NUMBERS, STREET NAME, ETC. NOTE: COMMERCIAL AND INDUSTRIAL FACILITIES MAY BE SUBJECT TO REQUIREMENTS OF THE COUNTY CODE FOR SEWER SURCHARGES, INDUSTRIAL COST RECOVERY CHARGES, AND PRETREATMENT.

Application is herewith made for a sewer connection to the property described below.

SUBDIVISION Ellicott City SECTION _____ AREA _____ LOT _____ BLOCK _____
 HOUSE NO. 4540 STREET College Ave TAX MAP _____ GRID _____ PARCEL 285
 POST OFFICE Ellicott City ZIP CODE 21043 PHONE NO. _____

NEW OR EXISTING BUILDING? Existing USE (SEE PROPERTY CLASSIFICATIONS ON REVERSE SIDE)

ITEMS CHECK	CONN. DIA.	CHARGES			AMOUNT PAID	FUND	AGENCY	REV. ACCT B/S ACCT	
		DESCRIPTION	FEE						
<input checked="" type="checkbox"/>	4"	INSTALLATION	\$			500		5019	
<input checked="" type="checkbox"/>	6"	INSTALLATION	\$			500		5019	
<input type="checkbox"/>	8"	ADVANCE DEPOSIT*	\$	1500.00	1500.00	500		5020	
<input type="checkbox"/>	3	IN AID OF CONSTRUCTION CHARGE							
		SINGLE FAMILY HOUSE (ALL TYPES) OR TRAILER			\$ 600.00	600.00	500	009	7120
		APARTMENTS (ALL TYPES)	\$	X	NO. OF DWELLING UNITS		730		
		MOTEL	\$	X	NO. OF MOTEL UNITS				
		PUBLIC COMMERCIAL INDUSTRIAL BUILDINGS		REFER TO ENGINEERING FOR CHARGES \$ EST GPD					
<input type="checkbox"/>	4	MIDDLE PATUXENT SUBDISTRICT SUPPLEMENTAL IN-AID OF CONSTRUCTION CHARGE				380	009	7130	
		SINGLE, FAMILY HOUSE (ALL TYPES) OR TRAILER			\$				
		APARTMENTS (ALL TYPES) MOTELS	\$	X	NO. OF UNITS				
		PUBLIC COMMERCIAL INDUSTRIAL BUILDINGS		REFER TO ENGINEERING FOR CHARGES \$ EST GPD					
<input type="checkbox"/>	5	INSPECTION FEE AND PERMIT FEE		\$ 300.00	300.00	710	009	8211	

*Refer to DPZ for estimate of Advance Deposit.
 For installations requiring an Advance Deposit, the owner must enter into a cost agreement with Howard County prior to the commencement of any installation work.

TOTAL AMOUNT PAID

\$ 2400.00

CR# _____
 CR# _____
 CR# _____

THE TERMS AND CONDITIONS OF THIS APPLICATION, INCLUDING ANYTHING ON THE REVERSE SIDE HEREOF ARE BINDING UPON THE UNDERSIGNED OWNER AND ALL SUCCEEDING OWNERS.

FULL FEE MUST ACCOMPANY THIS APPLICATION. MAKE CHECKS PAYABLE TO: DIRECTOR OF FINANCE, HOWARD COUNTY. CREDIT CARDS NOT ACCEPTED.


6

COMPANY NAME _____
 COMPANY ADDRESS _____
 Donald Wagoner ED
 OWNER SIGNATURE _____
 Donald Wagoner
 OWNER NAME (PRINT) _____
 4540 College Ave
 OWNER ADDRESS _____
 Ellicott City, Md 21043

TAX _____ FOR _____
 D/A _____ LEVY _____
 TAB _____ CONTROL _____
 TAX INDEX NO. _____

MANHOLE LOCATION CHART

NO.	ROAD NAME OR NORTHING & EASTING	CL. STATION	DEPTH
10	NORTHING & EASTING	61,075,705.70	
11	NORTHING & EASTING	61,075,484.60	
12	DONCASTER DRIVE	0+62.0	3.0 FT.
13	DONCASTER DRIVE	0+84.3	3.0 FT.
14	DONCASTER DRIVE	1+14.3	3.0 FT.
15	DONCASTER DRIVE	1+76.3	4.0 FT.
16	DONCASTER DRIVE	1+76.3	2.0 FT.
17	DONCASTER DRIVE	1+71.3	3.0 FT.

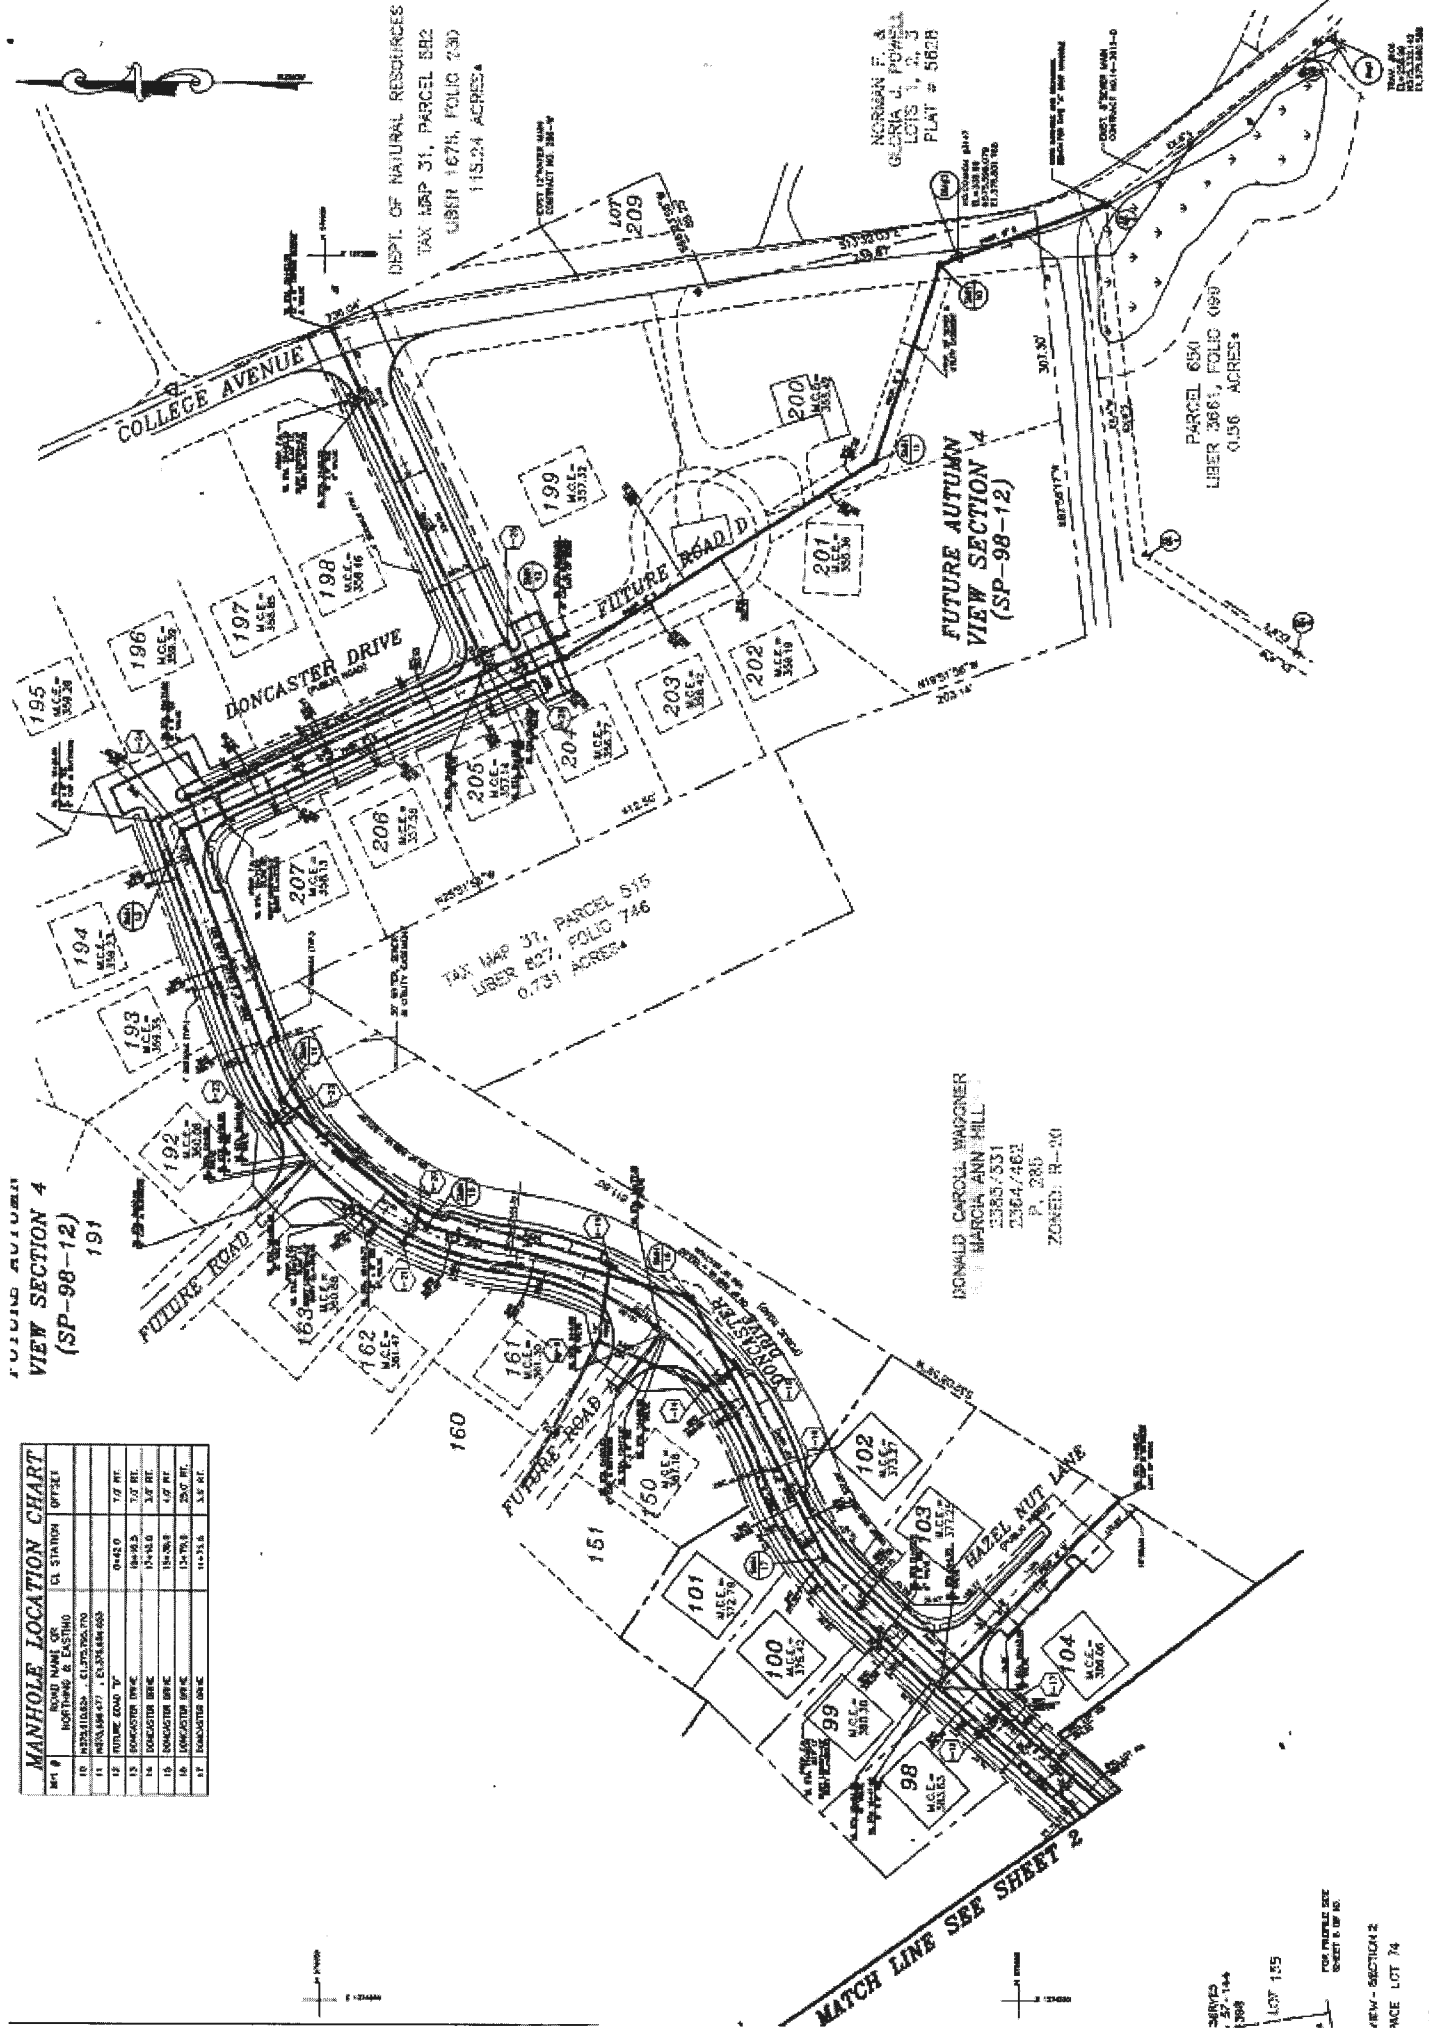

MATCH LINE SEE SHEET 2

REVISED
2-24-144
1998

FOR PRELIM. SITE
SHEET 6 OF 10

LOT 185


#REV - SECTION 2
MCE LOT 74

BY

SITE INSPECTION SHEET

OWNER: Mr. Don Wagoner PHONE #: (410) - 719 - 0693
ADDRESS: 4540 College Ave. CONTRACTOR: _____
Ellicott City, MD WELL TAG #: Connected to Public
SUBDIVISION: _____ LOT: _____ COUNTY #: Howard H20
PROPOSAL: Need to Connect to Public Sewer
Sink Collapsed.

LOCATION DIAGRAM

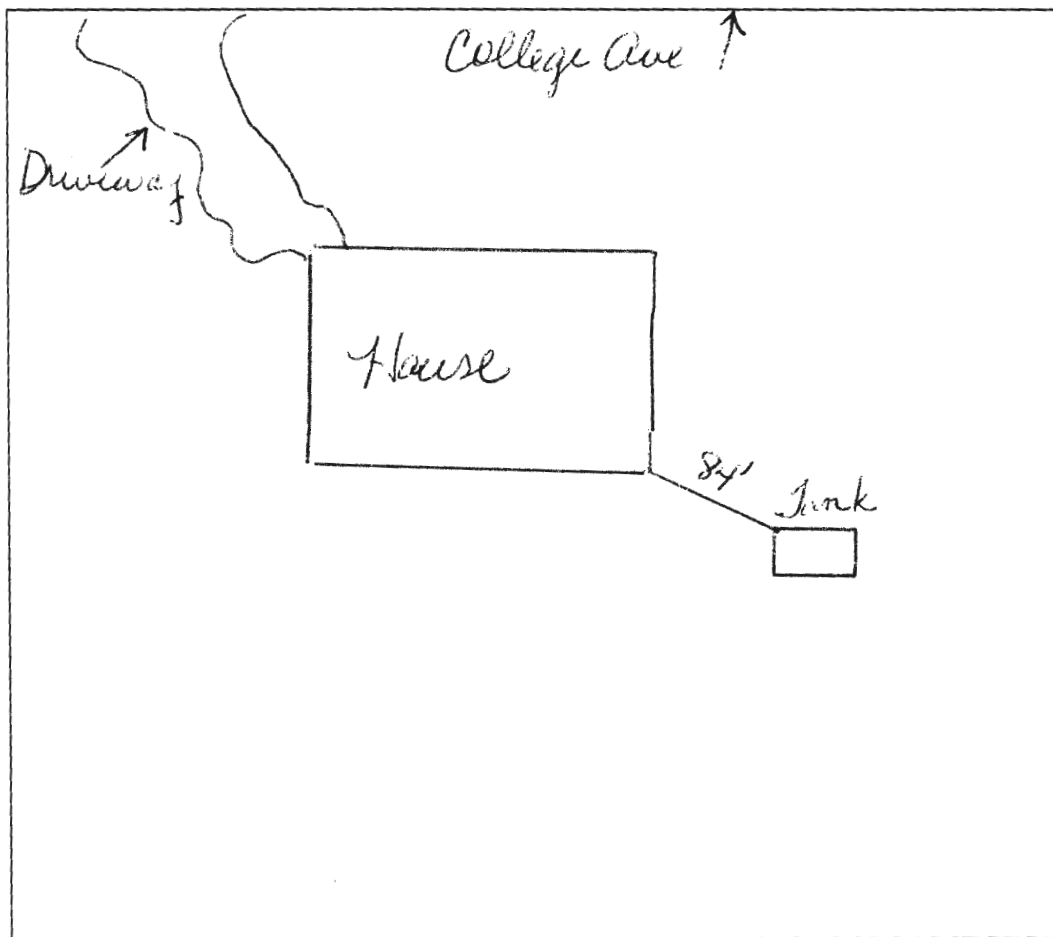

COMMENTS: Visited site on May 15, 2014. Sink
had collapsed. Sink was about 72' from the
house. Must be abandoned and connected to
public sewer.

DATE: 5-15-14 INSPECTOR: Dana Bernard