

AP _____

(130)

0.7' dk grey brn L
2fg to 2fsbk


1.2' brn L, 2fsbk
SS

2' brn fs l
1msbk SS
few mica

3.8' brn & pale brn
lfs alternating
many thin & thick
mica platy

9' brn & pale brn
ch ls

10' ATIS
I 40% rock frag

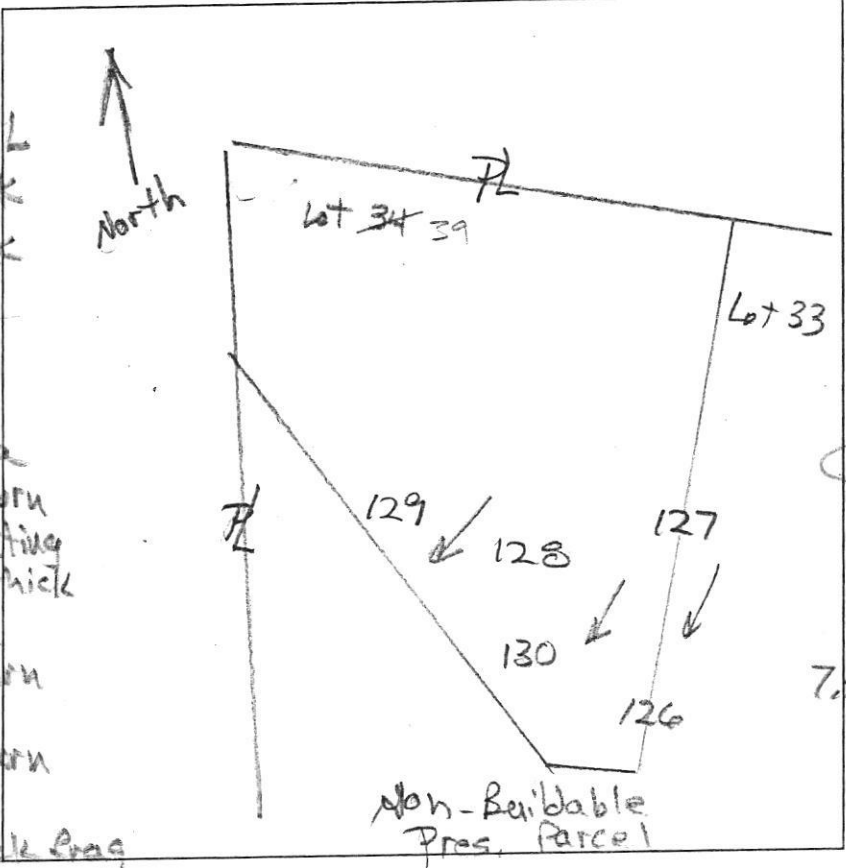

(129)

0.4' dk brn L
2fg to 2fsbk

1' brn L, 2fsbk

2' brn fs l
3msbk mica

4' brn & pale brn
fs l, thick
platy
common mica

7.5' yellow-red, brn
& pale yellow
lfs many
mica
wk. medium
platy
pale brn lfs
thick platy
many mica

11' grey-brn
ATIS thick
platy
many mica

12' _____

(128)

0.7' dk grey-brn fs l
2fg few mica

1.5' brn fs l
1fsbk

1.5' grey-brn lfs
thin platy
many mica

1.5' alternating
layers
grey-brn chls, many
mica

1.7' yellow-red lfs
few mica

11' grey-brn
ch ls, many
mica
thick platy
near vertical

12' grey-brn
ATIS, thick platy
near vertical
many mica

DATE	TEST #	DEPTH	START	BREAK 1" DROP	STOP 2" DROP	TIME OF 2ND INCH	P/F/H
11/7/14	130	37' 9"	2:07	2:10	2:19	9	P
11/7/14	129	59' 11"	2:23	2:34	2:49	15	P
11/7/14	128	41' 11"	2:40	2:43	2:47	4	P

REMARKS _____


SANITARIAN R Bricker BACKHOE Hatchfield's OTHERS Art Leonard, Jason

TEST HOLES USED IN SDA _____ AVG. PERC TIME _____ SQ. FT/BR _____

TRENCH WIDTH _____ INLET DEPTH _____ MAX. BOT DEPTH _____ EFFECTIVE S/W _____

Donnie Jan Kirk

Lot 34

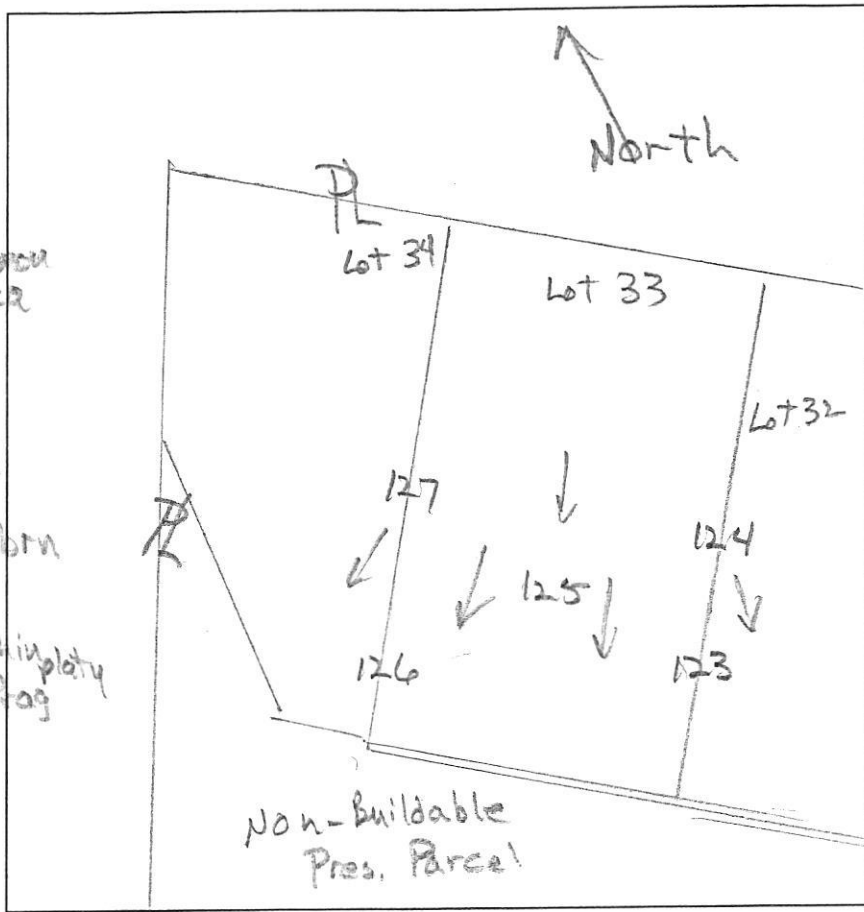

(125)
 0.7' dk brn fsl
 2' fslbk
 6.4' yel-red fsl
 2' msbk
 2' bon fcs
 many mica
 2' yel-red fsl
 Qm, dense
 4.8' brn & pale brn
 fcs many mica
 9' brn chls, thin platy
 20% rock frag
 12.5'

(126)
 grey-brn
 fsl, 2' fsg
 to 2' fslbk
 0.7' yel-red
 2' msbk, ss
 2' yellow fsl
 within platy
 C2d (blk)
 3' red-yellow
 1.5' fcs, thick
 platy
 near
 vertical
 1.1' 2sd (blk)
 11' grey-brn
 v fcs thick
 platy
 13'

(127)
 0.4' dk brn fsl
 2' fslbk
 0.4' brn fsl
 2' msbk to 2' fslbk
 1.7' brn & pale brn
 fsl 1' msbk
 com non mica
 2.5' brn fsl, Qm
 3' yellow, brn
 & pale brn
 fcs, Qm
 9.5' grey-brn
 chls, many mica
 13.5'

DATE	TEST #	DEPTH	START	BREAK 1" DROP	STOP 2" DROP	TIME OF 2ND INCH	P/F/H
11/7/14	125	5.3' / 12.5'	1:23	1:25	1:28	3	P
11/7/14	127	4.1' / 13.5'	1:35	1:38	13:43	5	P
11/7/14	126	5.1' / 11'	0	1.5	5.5	4	P

REMARKS _____
 SANITARIAN R Bricker BACKHOE Hatfield's (Dannie) Art Leonard OTHERS _____
 TEST HOLES USED IN SDA _____ AVG. PERC TIME _____ SQ. FT/BR _____
 TRENCH WIDTH _____ INLET DEPTH _____ MAX. BOT DEPTH _____ EFFECTIVE SW _____