


**2 PART. SECOND FLOOR PLAN** W/ OPT. 030 - ADDITIONAL WALK IN CLOSET  
 SCALE: 1/4"=1'-0"  
 TOL081A\_A120.dwg

- GENERAL PLAN NOTES**
- A. ALL WOOD STUD PARTITIONS NOT DIMENSIONED ARE TO BE 3 1/2" FOR INTERIOR AND 5 1/2" FOR EXTERIOR WALLS UNLESS OTHERWISE NOTED.
  - B. ALL INTERIOR DIMENSIONS ARE TO FACE OF STUDS.
  - C. ALL EXTERIOR DIMENSIONS ARE TO FACE OF STUDS.
  - D. ALL DIMENSIONS GOVERN OVER SCALE.
  - E. ALL SMOKE DETECTORS ARE TO BE WIRED IN SUCH A MANNER THAT ACTIVATION OF ONE WILL ACTIVATE THEM ALL.
  - F. ENCLOSED ACCESSIBLE SPACE UNDER STAIRS SHALL HAVE WALLS AND SOFFITS PROTECTED ON ENCLOSED SIDE WITH 1/2" GYPSUM BOARD.
  - G. ALL WINDOWS SIZE ARE NOTED IN FEET + INCHES AS MEASURED FROM SASH TO SASH.
  - H. REFER TO ELEVATIONS FOR WINDOW HEAD HEIGHTS.
  - I. ALL DOORS ARE TO BE 6'-8" HIGH UNLESS OTHERWISE NOTED.
  - J. WASHER ALWAYS TO BE ON LEFT SIDE OF DRYER.
  - K. DISHWASHER ALWAYS TO BE ON RIGHT SIDE OF SINK.

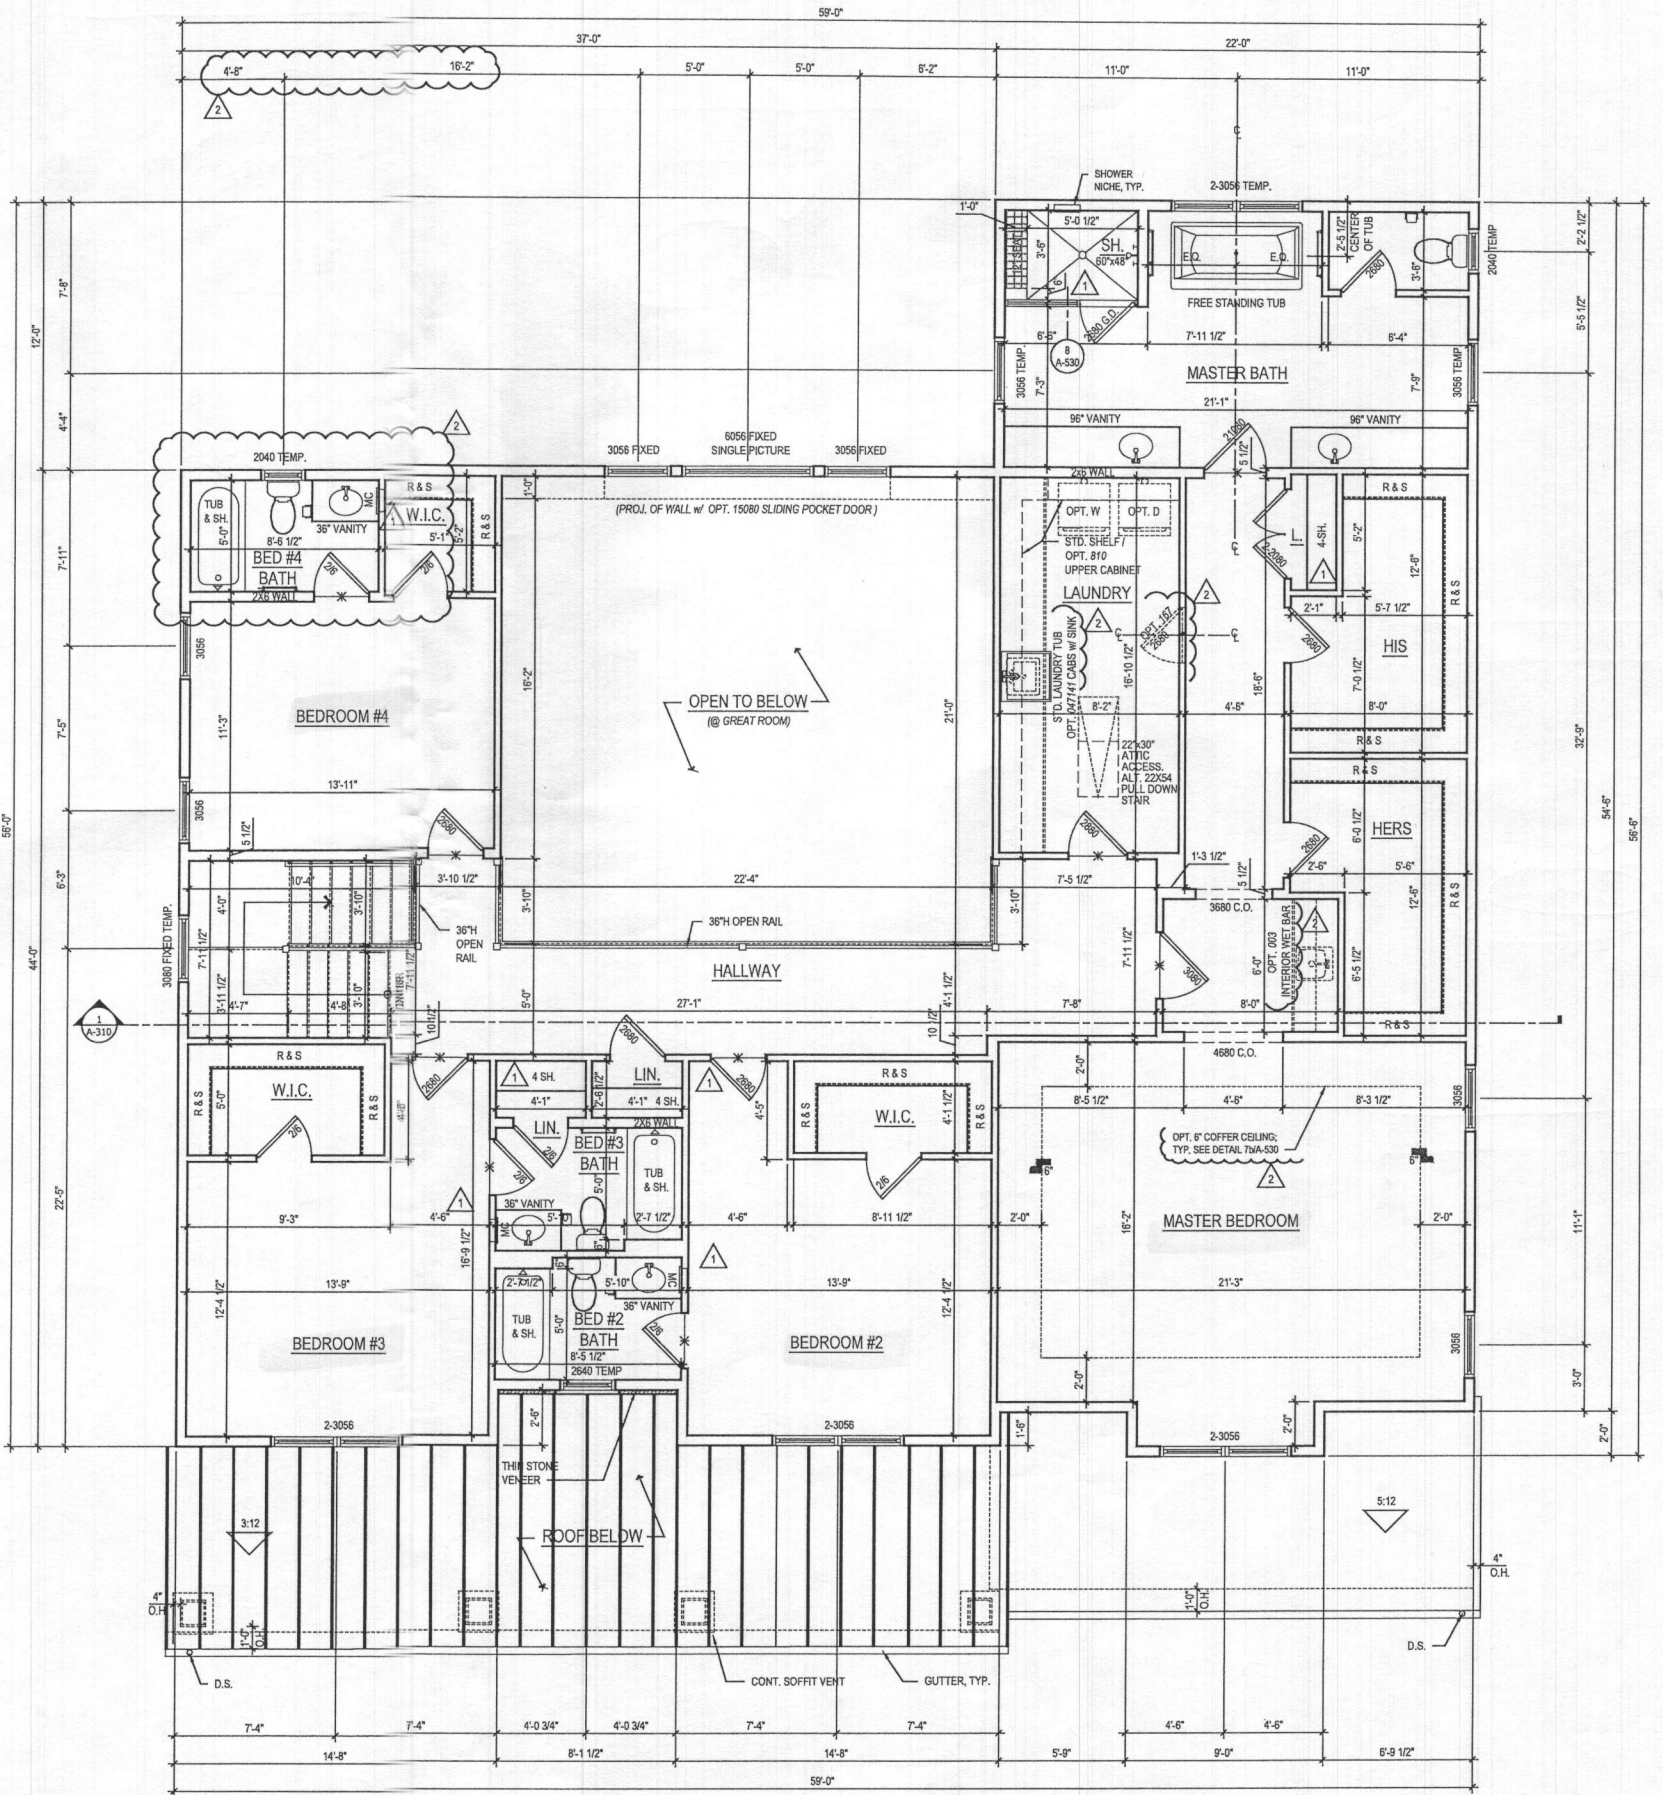

**1 SECOND FLOOR PLAN**  
 SCALE: 1/4"=1'-0"  
 TOL081A\_A120.dwg

*See additional pages for "Preview" elev.*

@ ELEV. 1 - CRAFTSMAN *shown*

ARCHITECT:  
  
 8521 Leesburg Pike  
 Suite 700 | Vienna, VA 22182  
 P: 571.830.1800 | F: 571.830.1801  
 www.lessarddesign.com

SEAL & SIGNATURE:  
 OWNER:  
**TOLL BROTHERS**  
 19775 BELMONT EXECUTIVE PLAZA  
 ASHBURN, VA 20147  
 P: 571.391.8068  
 CONTACT: CHRISTINA LEMLEY  
 clemley@tollbrothers.com


PROJECT NAME: MARYLAND  
 SHEET TITLE: PARKHURST FLOOR PLANS

ISSUE / REVISION		
NO.	DESCRIPTION	DATE
1	BID SET	05.29.19
1	PERMIT SET	06.19.19
1	MD NEW STANDARDS	09.16.19
2	MR. #220241	12.11.20

PROJECT No: TOL081a  
 DRAWN BY: ACZ  
 CHECKED BY: JF  
 PLOT DATE: Jan. 20, 2021  
 FILE NAME: TOL081a\_A120.dwg


**A-120**

- GENERAL PLAN NOTES**
- A. ALL WOOD STUD PARTITIONS NOT DIMENSIONED ARE TO BE 3 1/2" FOR INTERIOR AND 5 1/2" FOR EXTERIOR WALLS UNLESS OTHERWISE NOTED.
  - B. ALL INTERIOR DIMENSIONS ARE TO FACE OF STUDS.
  - C. ALL EXTERIOR DIMENSIONS ARE TO FACE OF STUDS.
  - D. ALL DIMENSIONS GOVERN OVER SCALE.
  - E. ALL SMOKE DETECTORS ARE TO BE WIRED IN SUCH A MANNER THAT ACTIVATION OF ONE WILL ACTIVATE THEM ALL.
  - F. ENCLOSED ACCESSIBLE SPACE UNDER STAIRS SHALL HAVE WALLS AND SOFFITS PROTECTED ON ENCLOSED SIDE WITH 1/2" GYPSUM BOARD.
  - G. ALL WINDOWS SIZE ARE NOTED IN FEET + INCHES AS MEASURED FROM SASH TO SASH.
  - H. REFER TO ELEVATIONS FOR WINDOW HEAD HEIGHTS.
  - I. ALL DOORS ARE TO BE 6'-8" HIGH UNLESS OTHERWISE NOTED.
  - J. WASHER ALWAYS TO BE ON LEFT SIDE OF DRYER.
  - K. DISHWASHER ALWAYS TO BE ON RIGHT SIDE OF SINK.

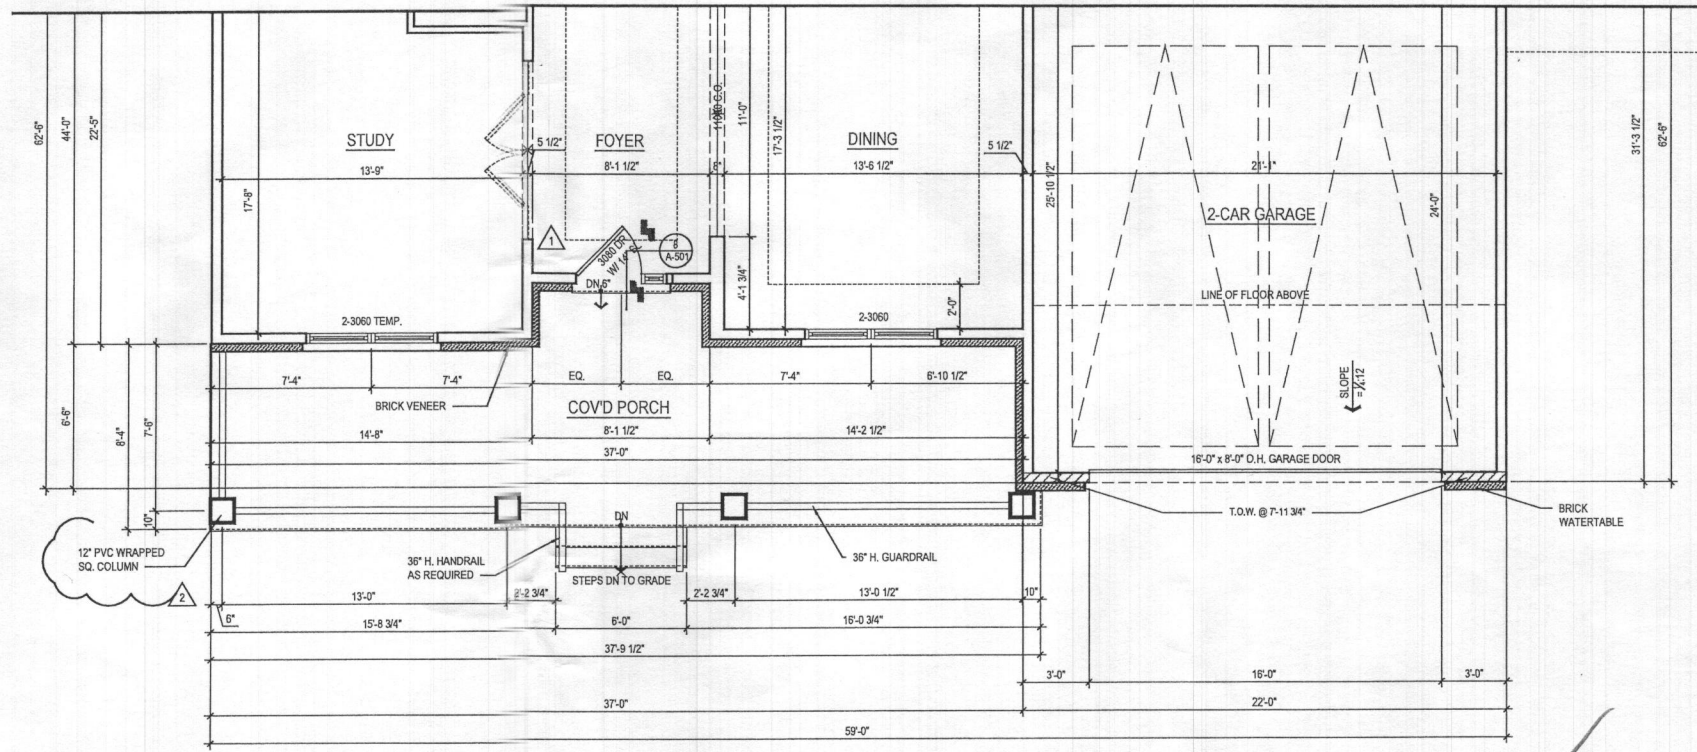


**2 FIRST FLOOR PLAN**  
 A-170 SCALE: 1/4"=1'-0"  
 TOUR18A\_A170.DWG

@ ELEV. 5 - FAIRVIEW

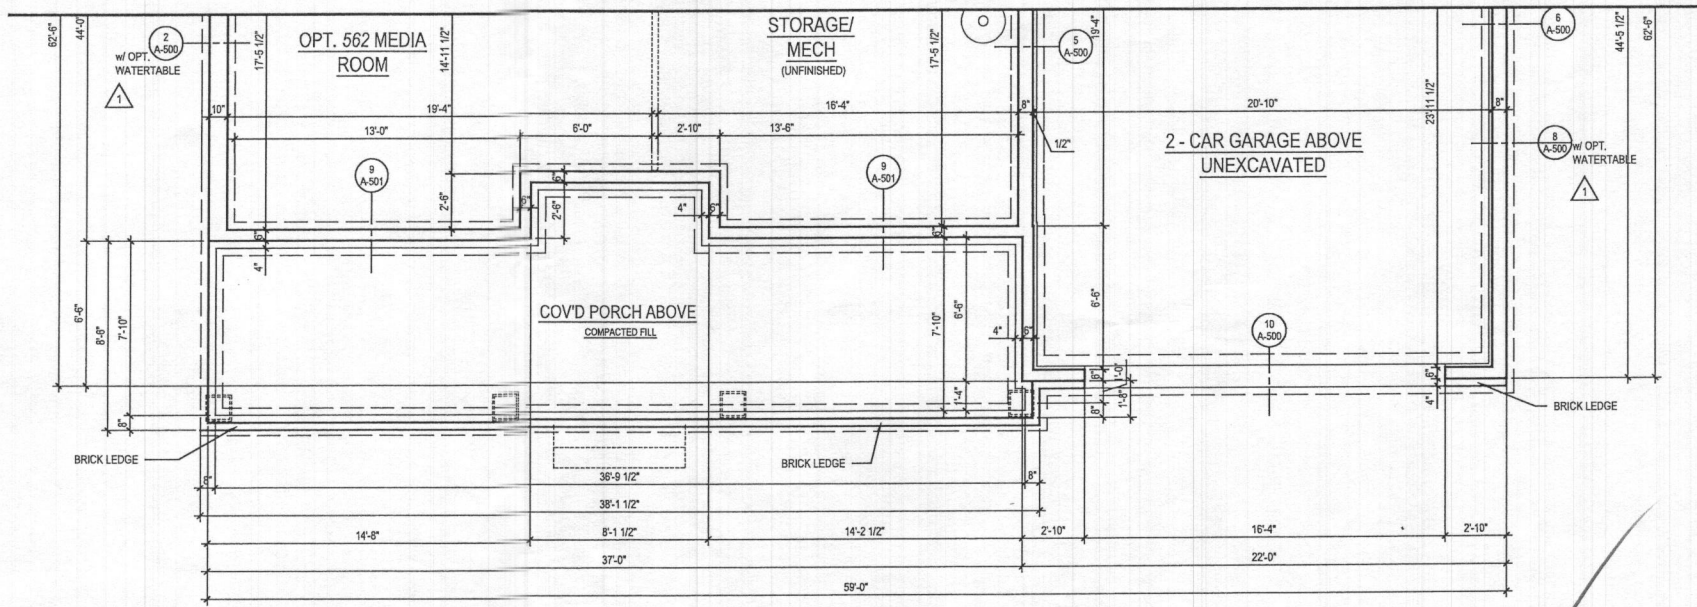

**1 BASEMENT FLOOR PLAN**  
 A-170 SCALE: 1/4"=1'-0"  
 TOUR18A\_A170.DWG

@ ELEV. 5 - FAIRVIEW

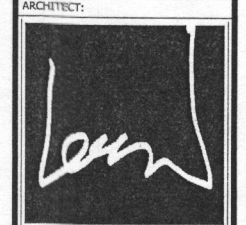

**lessard  
DESIGN**

8521 Leesburg Pike  
 Suite 700 | Vienna, VA 22182  
 P: 571.830.1800 | F: 571.830.1801  
 www.lessarddesign.com

SEAL & SIGNATURE:

OWNER:

**TOLL BROTHERS**  
 19775 BELMONT EXECUTIVE PLAZA  
 ASHBURN, VA 20147  
 P: 571.291.8068  
 CONTACT: CHRISTINA LEMLEY  
 clemley@tollbrothers.com

PROJECT NAME:

SHEET TITLE:


MARYLAND  
**PARKHURST  
FLOOR PLANS**

ISSUE / REVISION		
NO.	DESCRIPTION	DATE
BID SET		05.29.19
PERMIT SET		06.19.19
1	MD NEW STANDARDS	09.16.19
2	MR #220241	12.11.20

PROJECT No:	TOL081a
DRAWN BY:	AC/RN
CHECKED BY:	AM
PLOT DATE:	Jan 20, 2022
FILE NAME:	TOL081a_A170.dwg

**A-170**

- GENERAL PLAN NOTES**
- A. ALL WOOD STUD PARTITIONS NOT DIMENSIONED ARE TO BE 3 1/2" FOR INTERIOR AND 5 1/2" FOR EXTERIOR WALLS UNLESS OTHERWISE NOTED.
  - B. ALL INTERIOR DIMENSIONS ARE TO FACE OF STUDS.
  - C. ALL EXTERIOR DIMENSIONS ARE TO FACE OF STUDS.
  - D. ALL DIMENSIONS GOVERN OVER SCALE.
  - E. ALL SMOKE DETECTORS ARE TO BE WIRED IN SUCH A MANNER THAT ACTIVATION OF ONE WILL ACTIVATE THEM ALL.
  - F. ENCLOSED ACCESSIBLE SPACE UNDER STAIRS SHALL HAVE WALLS AND SOFFITS PROTECTED ON ENCLOSED SIDE WITH 1/2" GYPSUM BOARD.
  - G. ALL WINDOWS SIZE ARE NOTED IN FEET + INCHES AS MEASURED FROM SASH TO SASH.
  - H. REFER TO ELEVATIONS FOR WINDOW HEAD HEIGHTS.
  - I. ALL DOORS ARE TO BE 6'-8" HIGH UNLESS OTHERWISE NOTED.
  - J. WASHER ALWAYS TO BE ON LEFT SIDE OF DRYER.
  - K. DISHWASHER ALWAYS TO BE ON RIGHT SIDE OF SINK.

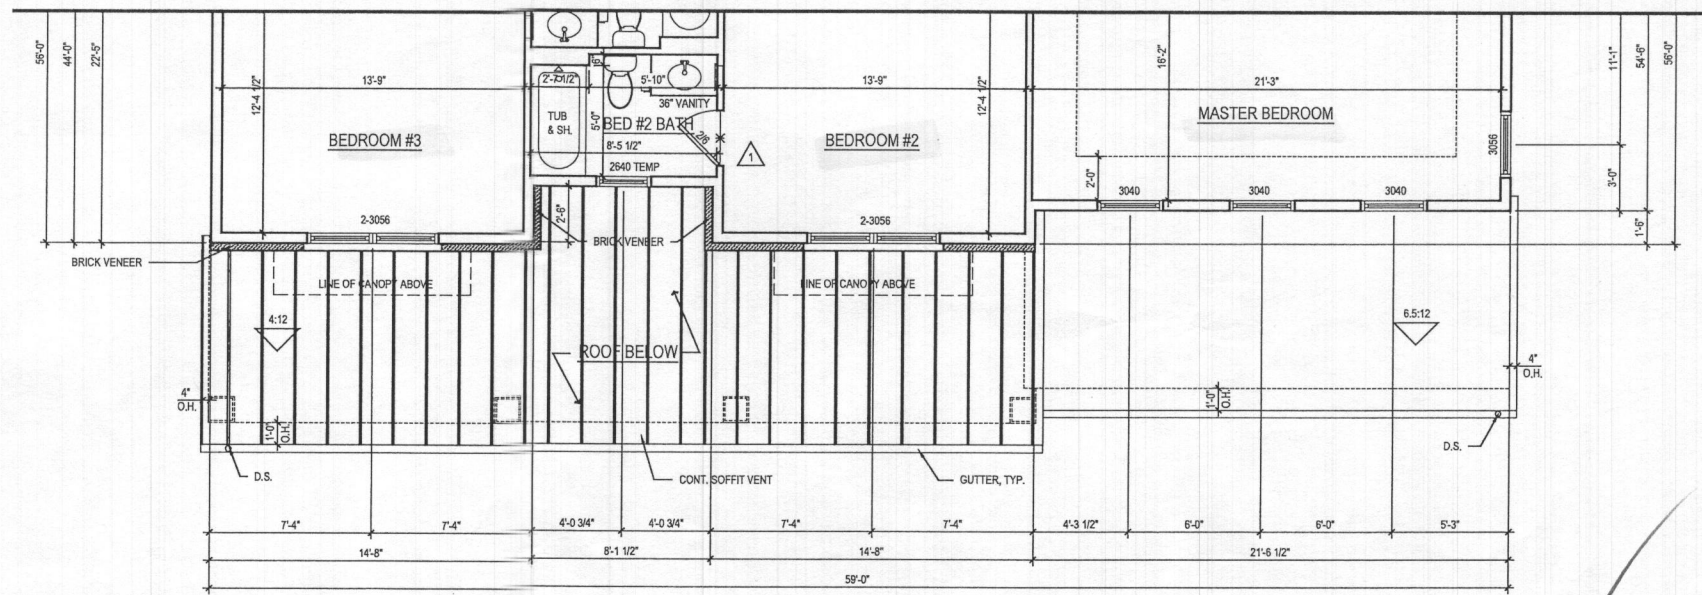

**1 SECOND FLOOR PLAN**  
 A-171 SCALE: 1/4"=1'-0"  
 TOL081a\_A171.dwg

@ ELEV. 5 - FAIRVIEW

ARCHITECT:

**lessard DESIGN**  
 8521 Leesburg Pike  
 Suite 700 | Vienna, VA 22182  
 P: 571.830.1800 | F: 571.830.1801  
 www.lessarddesign.com

SEAL & SIGNATURE:

OWNER:

**TOLL BROTHERS**  
 19775 BELMONT EXECUTIVE PLAZA  
 ASHBURN, VA 20147  
 P: 571.291.8068  
 CONTACT: CHRISTINA LEMLEY  
 clemley@tollbrothers.com


PROJECT NAME: MARYLAND

SHEET TITLE: PARKHURST FLOOR PLANS

ISSUE / REVISION		
NO.	DESCRIPTION	DATE
BID SET		05.29.19
PERMIT SET		06.19.19
1	MD NEW STANDARDS	09.16.19
2	MR #220241	12.11.20

PROJECT No: TOL081a  
 DRAWN BY: AC/RM  
 CHECKED BY: AS  
 PLOT DATE: Jan. 30, 2022  
 FILE NAME: TOL081a\_A171.dwg

**A-171**

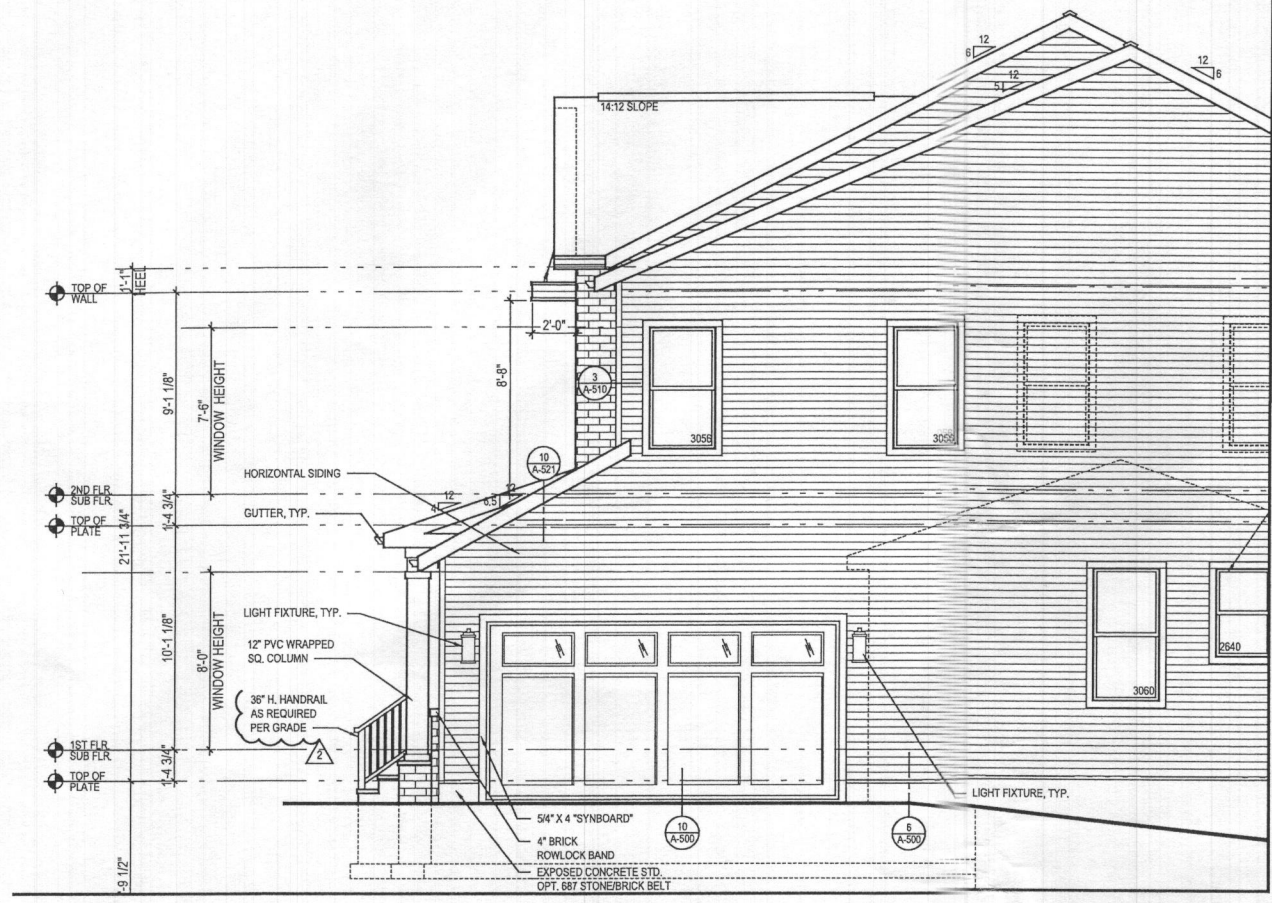


**4 PART. RIGHT SIDE ELEVATION** w/ OPT. 012 - SIDE LOAD GARAGE  
 A-400d SCALE: 1/4"=1'-0"  
 TOLUBA\_ARCH.DWG ELEV. 5 - SHOWN




**3 PART. FRONT ELEVATION** w/ OPT. 012 - SIDE LOAD GARAGE  
 A-400d SCALE: 1/4"=1'-0"  
 TOLUBA\_ARCH.DWG ELEV. 5 - SHOWN

- GENERAL PLAN NOTES**
- A. ALL WOOD STUD PARTITIONS NOT DIMENSIONED ARE TO BE 3 1/2" FOR INTERIOR AND 5 1/2" FOR EXTERIOR WALLS UNLESS OTHERWISE NOTED.
  - B. ALL INTERIOR DIMENSIONS ARE TO FACE OF STUDS.
  - C. ALL EXTERIOR DIMENSIONS ARE TO FACE OF STUDS.
  - D. ALL DIMENSIONS GOVERN OVER SCALE.
  - E. ALL SMOKE DETECTORS ARE TO BE WIRED IN SUCH A MANNER THAT ACTIVATION OF ONE WILL ACTIVATE THEM ALL.
  - F. ENCLOSED ACCESSIBLE SPACE UNDER STAIRS SHALL HAVE WALLS AND SOFFITS PROTECTED ON ENCLOSED SIDE WITH 1/2" GYP/SM BOARD.
  - G. ALL WINDOWS SIZE ARE NOTED IN FEET + INCHES AS MEASURED FROM SASH TO SASH.
  - H. REFER TO ELEVATIONS FOR WINDOW HEAD HEIGHTS.
  - I. ALL DOORS ARE TO BE 8'-0" HIGH UNLESS OTHERWISE NOTED.
  - J. WASHER ALWAYS TO BE ON LEFT SIDE OF DRYER.
  - K. DISHWASHER ALWAYS TO BE ON RIGHT SIDE OF SINK.

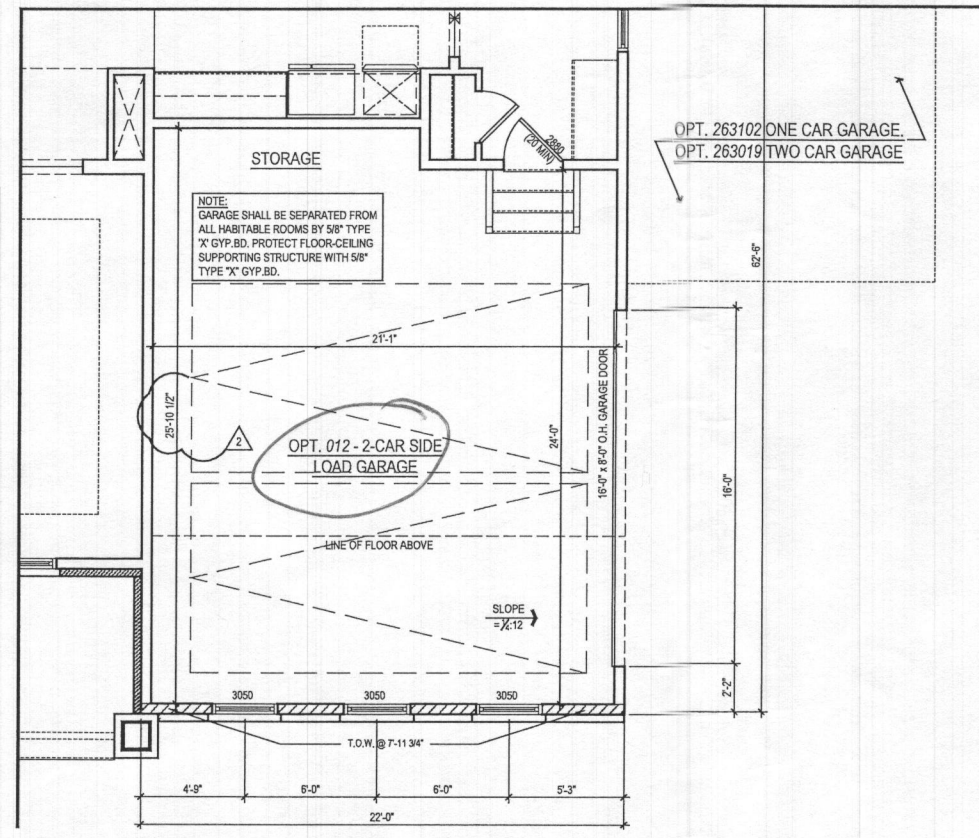

**2 PART. FIRST FLOOR PLAN** w/ OPT. 012 - SIDE LOAD GARAGE  
 A-400d SCALE: 1/4"=1'-0"  
 TOLUBA\_ARCH.DWG ELEV. 5 - SHOWN

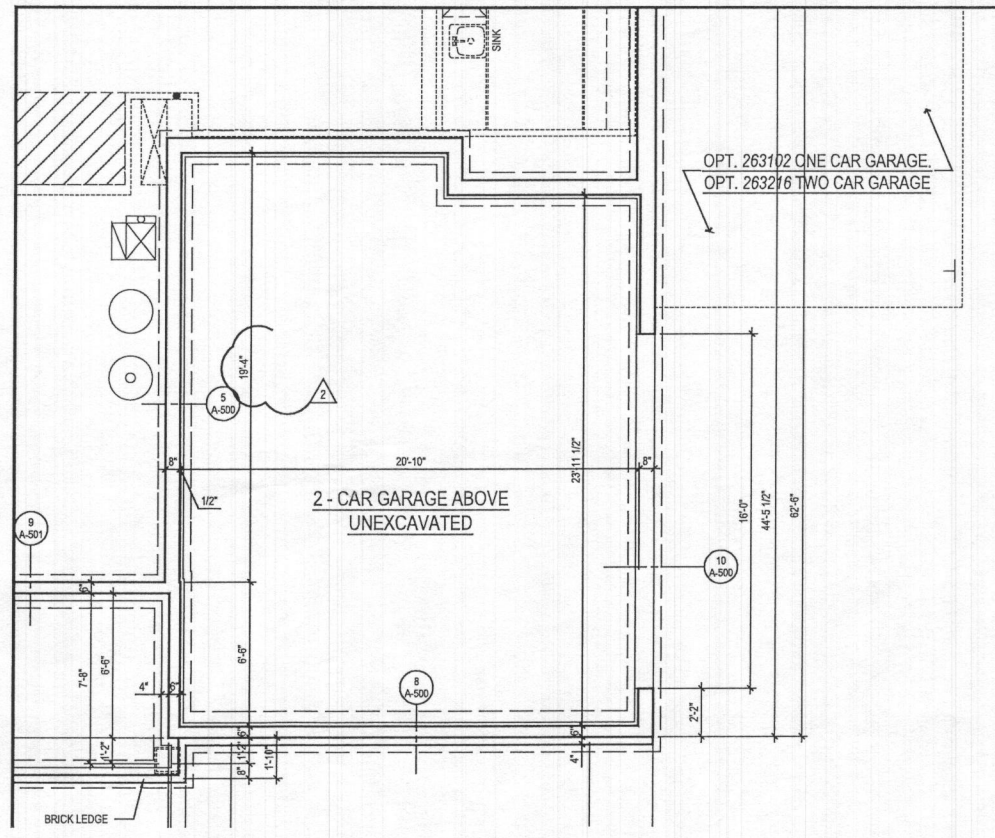

**1 PART. BASEMENT FLOOR PLAN** w/ OPT. 012 - SIDE LOAD GARAGE  
 A-400d SCALE: 1/4"=1'-0"  
 TOLUBA\_ARCH.DWG ELEV. 5 - SHOWN

ARCHITECT:

**lessard**  
DESIGN

8521 Leesburg Pike  
 Suite 700 | Vienna, VA 22182  
 P: 571.830.1800 | F: 571.830.1801  
 www.lessarddesign.com

SEAL & SIGNATURE:

OWNER:

**TOLL BROTHERS**  
 19775 BELMONT EXECUTIVE PLAZA  
 ASHBURN, VA 20147  
 P: 571.291.8068  
 CONTACT: CHRISTINA LEMLEY  
 clemley@tollbrothers.com


PROJECT NAME: MARYLAND

SHEET TITLE: PARKHURST OPTIONS


ISSUE / REVISION		
NO.	DESCRIPTION	DATE
BID SET		05.29.19
PERMIT SET		06.19.19
1	MD NEW STANDARDS	09.16.19
2	M/R #220241	12.11.20

PROJECT No: TOL081a  
 DRAWN BY: ACZ/MS  
 CHECKED BY: AS  
 PLOT DATE: Jan. 20, 2021  
 FILE NAME: TOL081a\_A400.dwg


**A-400d**

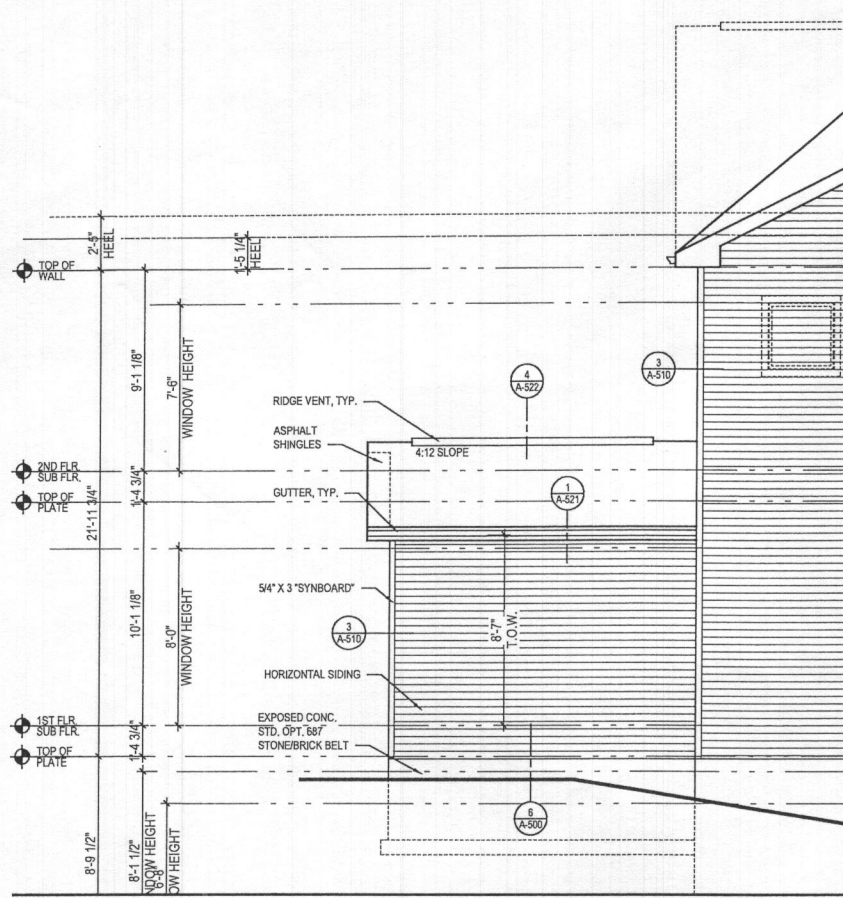

6 PART. REAR ELEVATION w/ OPT. 263102 - ONE CAR GARAGE  
 A-401 SCALE: 1/4"=1'-0" ELEV. 1 - SHOWN  
 TOL081a\_A401.DWG

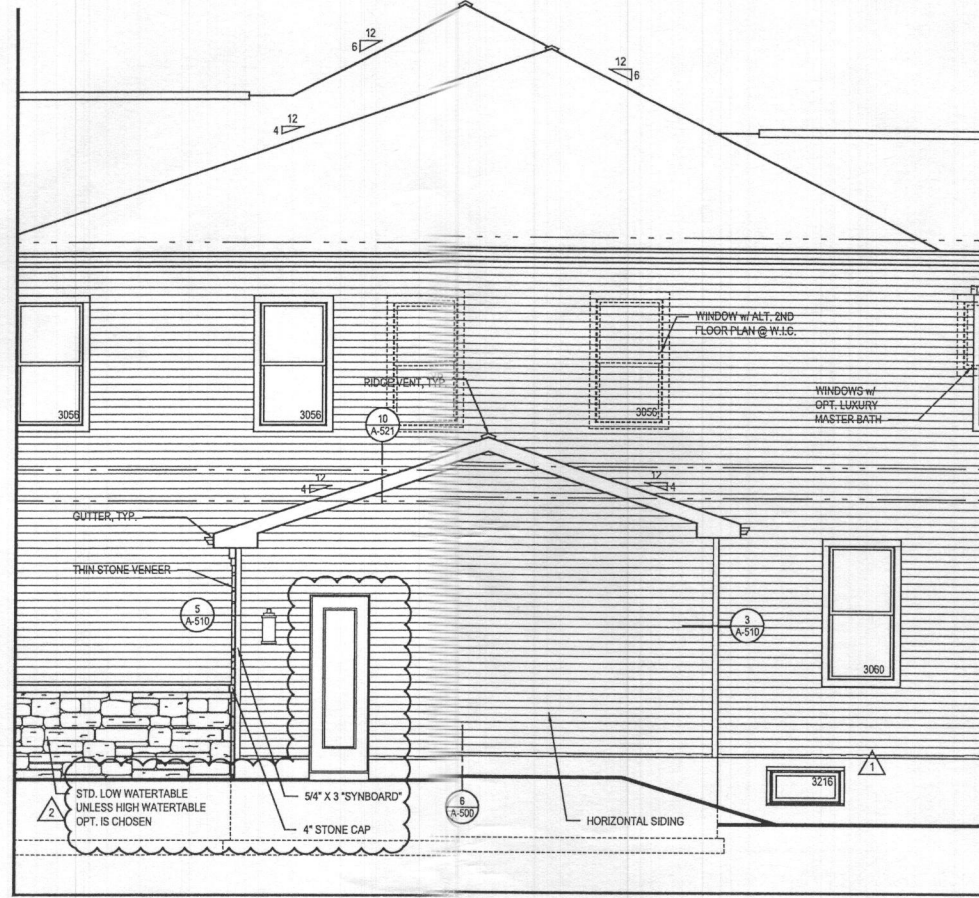


5 PART. RIGHT SIDE ELEVATION w/ OPT. 263102 - ONE CAR GARAGE  
 A-401 SCALE: 1/4"=1'-0" ELEV. 1 - SHOWN  
 TOL081a\_A401.DWG

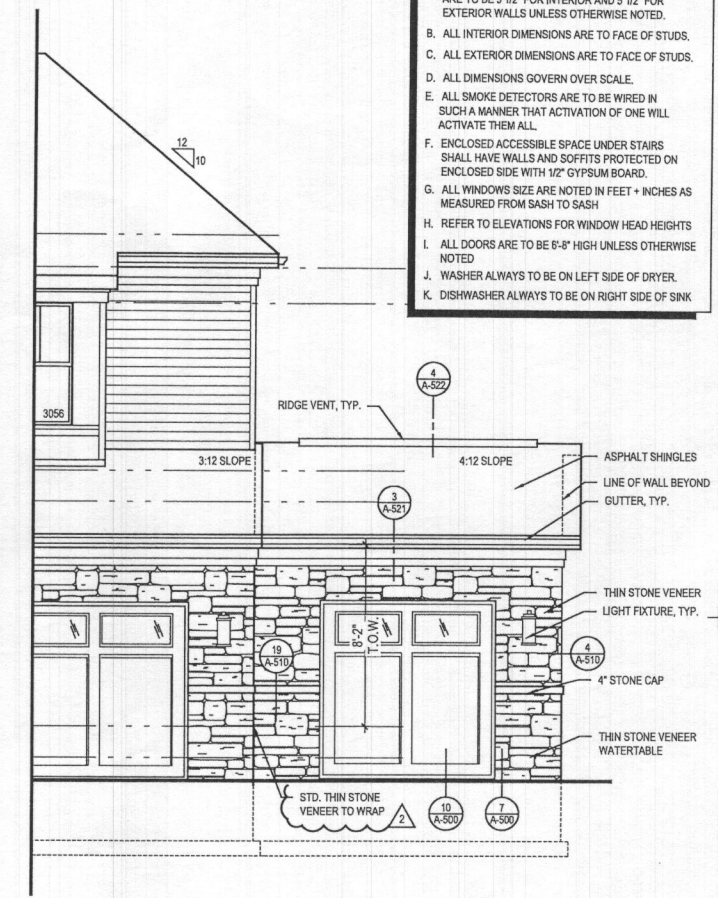


4 PART. FRONT ELEVATION w/ OPT. 263102 - ONE CAR GARAGE  
 A-401 SCALE: 1/4"=1'-0" ELEV. 1 - SHOWN  
 TOL081a\_A401.DWG


- GENERAL PLAN NOTES**
- ALL WOOD STUD PARTITIONS NOT DIMENSIONED ARE TO BE 3 1/2" FOR INTERIOR AND 5 1/2" FOR EXTERIOR WALLS UNLESS OTHERWISE NOTED.
  - ALL INTERIOR DIMENSIONS ARE TO FACE OF STUDS.
  - ALL EXTERIOR DIMENSIONS ARE TO FACE OF STUDS.
  - ALL DIMENSIONS GOVERN OVER SCALE.
  - ALL SMOKE DETECTORS ARE TO BE WIRED IN SUCH A MANNER THAT ACTIVATION OF ONE WILL ACTIVATE THEM ALL.
  - ENCLOSED ACCESSIBLE SPACE UNDER STAIRS SHALL HAVE WALLS AND SOFFITS PROTECTED ON ENCLOSED SIDE WITH 1/2" GYPSUM BOARD.
  - ALL WINDOWS SIZE ARE NOTED IN FEET + INCHES AS MEASURED FROM SASH TO SASH.
  - REFER TO ELEVATIONS FOR WINDOW HEAD HEIGHTS.
  - ALL DOORS ARE TO BE 8'-0" HIGH UNLESS OTHERWISE NOTED.
  - WASHER ALWAYS TO BE ON LEFT SIDE OF DRYER.
  - DISHWASHER ALWAYS TO BE ON RIGHT SIDE OF SINK.

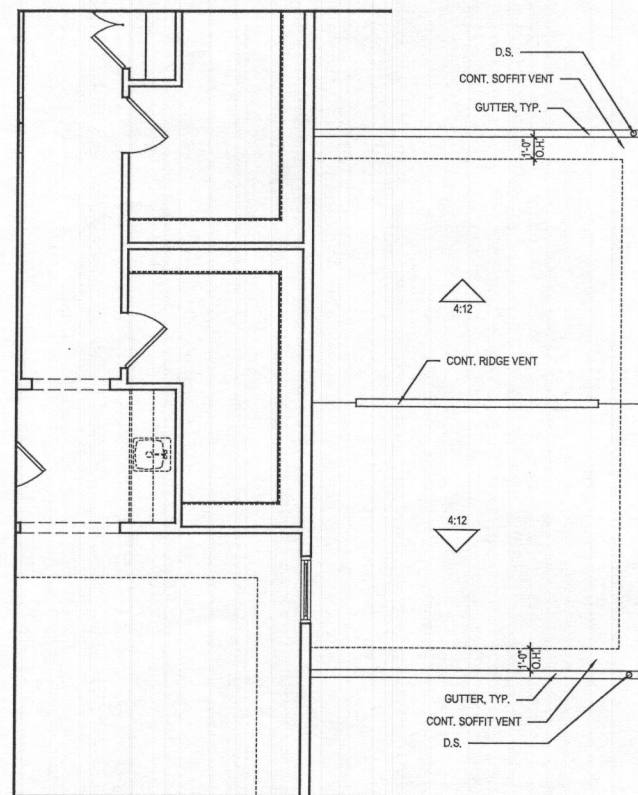

3 PART. SECOND FLOOR PLAN w/ OPT. 263102 - ONE CAR GARAGE  
 A-401 SCALE: 1/4"=1'-0" ELEV. 1 - SHOWN  
 TOL081a\_A401.DWG

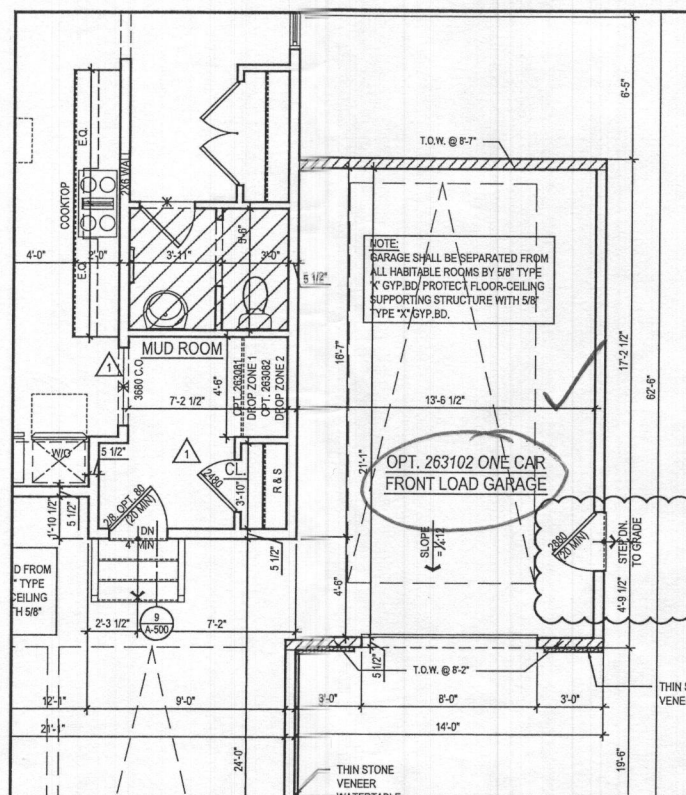

2 PART. FIRST FLOOR PLAN w/ OPT. 263102 - ONE CAR GARAGE  
 A-401 SCALE: 1/4"=1'-0" ELEV. 1 - SHOWN  
 TOL081a\_A401.DWG

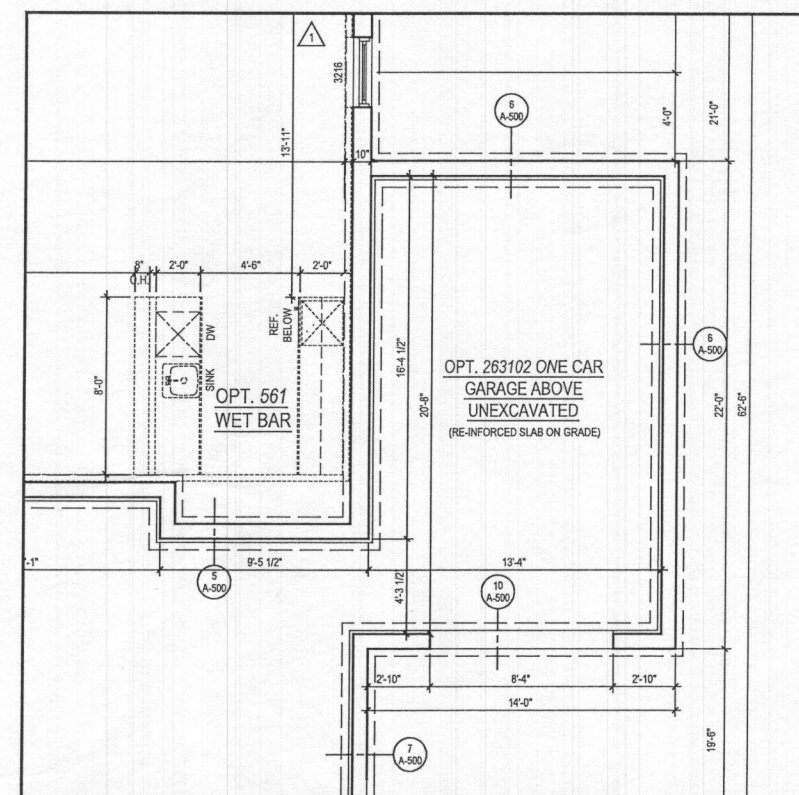

1 PART. BASEMENT FLOOR PLAN w/ OPT. 263102 - ONE CAR GARAGE  
 A-401 SCALE: 1/4"=1'-0" ELEV. 1 - SHOWN  
 TOL081a\_A401.DWG

ARCHITECT:

8521 Leesburg Pike  
 Suite 700 | Vienna, VA 22182  
 P: 571.830.1800 | F: 571.830.1801  
 www.lessarddesign.com

SEAL & SIGNATURE:

OWNER:

TOLL BROTHERS  
 19775 BELMONT EXECUTIVE PLAZA  
 ASHBURN, VA 20147  
 P: 571.251.8068  
 CONTACT: CHRISTINA LEMLEY  
 clemley@tollbrothers.com

PROJECT NAME: MARYLAND

SHEET TITLE: PARKHURST OPTIONS

ISSUE / REVISION		
NO.	DESCRIPTION	DATE
1	BID SET	05.29.19
2	PERMIT SET	06.19.19
3	100 NEW STANDARDS	09.16.19
4	MR #220241	12.11.20

PROJECT No: TOL081a  
 DRAWN BY: AC/BN  
 CHECKED BY: AP  
 PLOT DATE: Jan 20, 2021  
 FILE NAME: TOL081a\_A401.dwg

**A-401**

Plot By: anak  
 File No: TOL081a\_A401.dwg

**GENERAL PLAN NOTES**


- A. ALL WOOD STUD PARTITIONS NOT DIMENSIONED ARE TO BE 3 1/2" FOR INTERIOR AND 5 1/2" FOR EXTERIOR WALLS UNLESS OTHERWISE NOTED.
- B. ALL INTERIOR DIMENSIONS ARE TO FACE OF STUDS.
- C. ALL EXTERIOR DIMENSIONS ARE TO FACE OF STUDS.
- D. ALL DIMENSIONS GOVERN OVER SCALE.
- E. ALL SMOKE DETECTORS ARE TO BE WIRED IN SUCH A MANNER THAT ACTIVATION OF ONE WILL ACTIVATE THEM ALL.
- F. ENCLOSED ACCESSIBLE SPACE UNDER STAIRS SHALL HAVE WALLS AND SOFFITS PROTECTED ON ENCLOSED SIDE WITH 1/2" GYPSUM BOARD.
- G. ALL WINDOWS SIZE ARE NOTED IN FEET + INCHES AS MEASURED FROM SASH TO SASH.
- H. REFER TO ELEVATIONS FOR WINDOW HEAD HEIGHTS.
- I. ALL DOORS ARE TO BE 6'-8" HIGH UNLESS OTHERWISE NOTED.
- J. WASHER ALWAYS TO BE ON LEFT SIDE OF DRYER.
- K. DISHWASHER ALWAYS TO BE ON RIGHT SIDE OF SINK.




**5 PART. LEFT ELEV.**  
A-407 SCALE: 1/4"=1'-0"  
w/ OPT. 263073 MULTI-GEN. SUITE  
w/ COVID OUTDOOR LIVING @ WALKOUT CONDITION




**4 REAR ELEVATION**  
A-407 SCALE: 1/4"=1'-0"  
w/ OPT. 263073 MULTI-GEN. SUITE  
w/ COVID OUTDOOR LIVING @ WALKOUT CONDITION

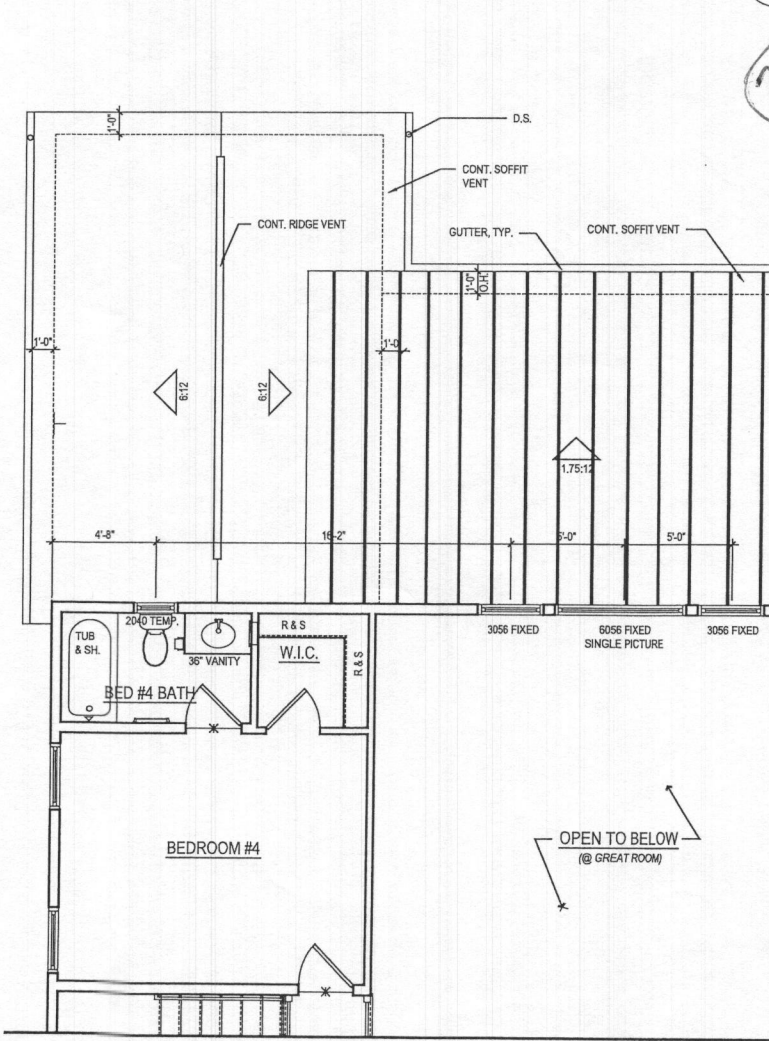

**3 PART. SECOND FLOOR PLAN**  
A-407 SCALE: 1/4"=1'-0"  
w/ OPT. 263073 MULTI-GEN. SUITE  
w/ COVID OUTDOOR LIVING @ WALKOUT CONDITION

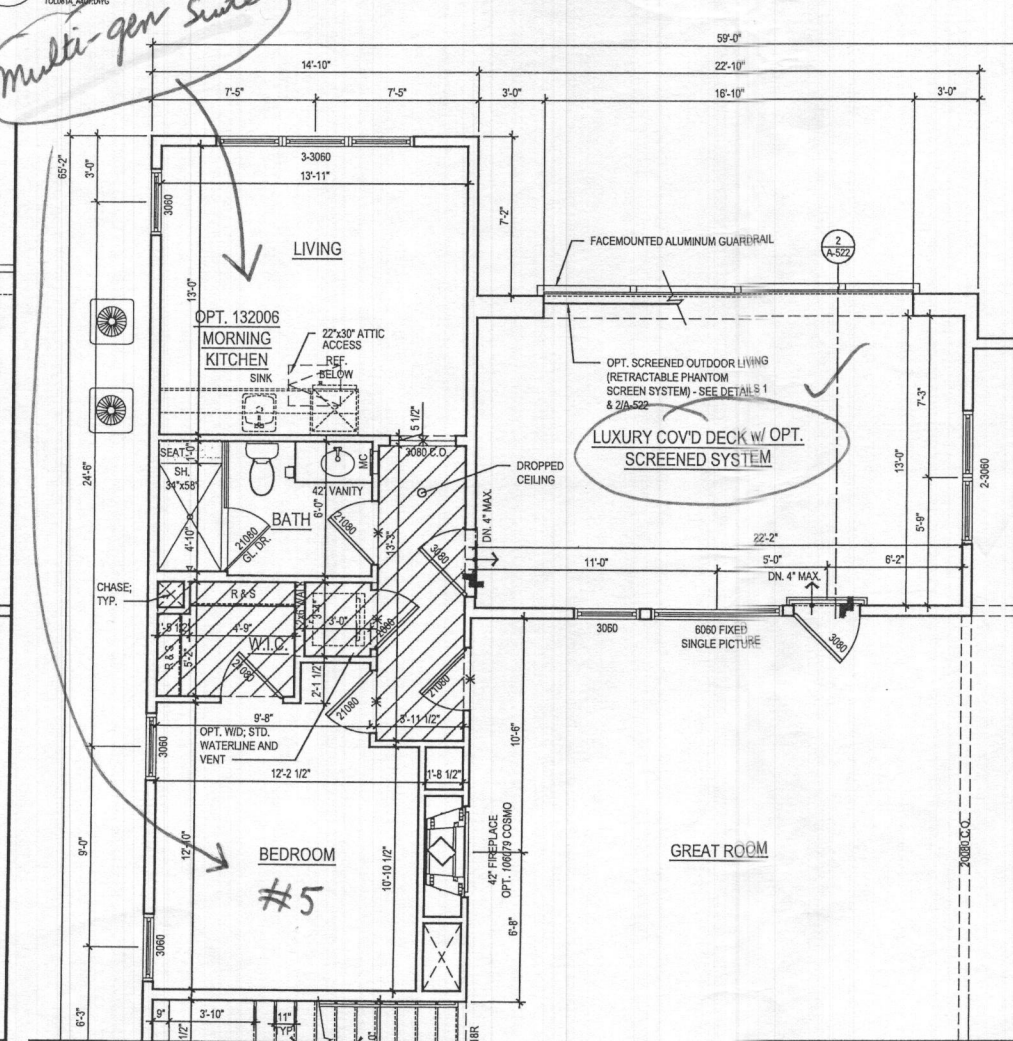

**2 PART. FIRST FLOOR PLAN**  
A-407 SCALE: 1/4"=1'-0"  
w/ OPT. 263073 MULTI-GEN. SUITE  
w/ COVID OUTDOOR LIVING @ WALKOUT CONDITION

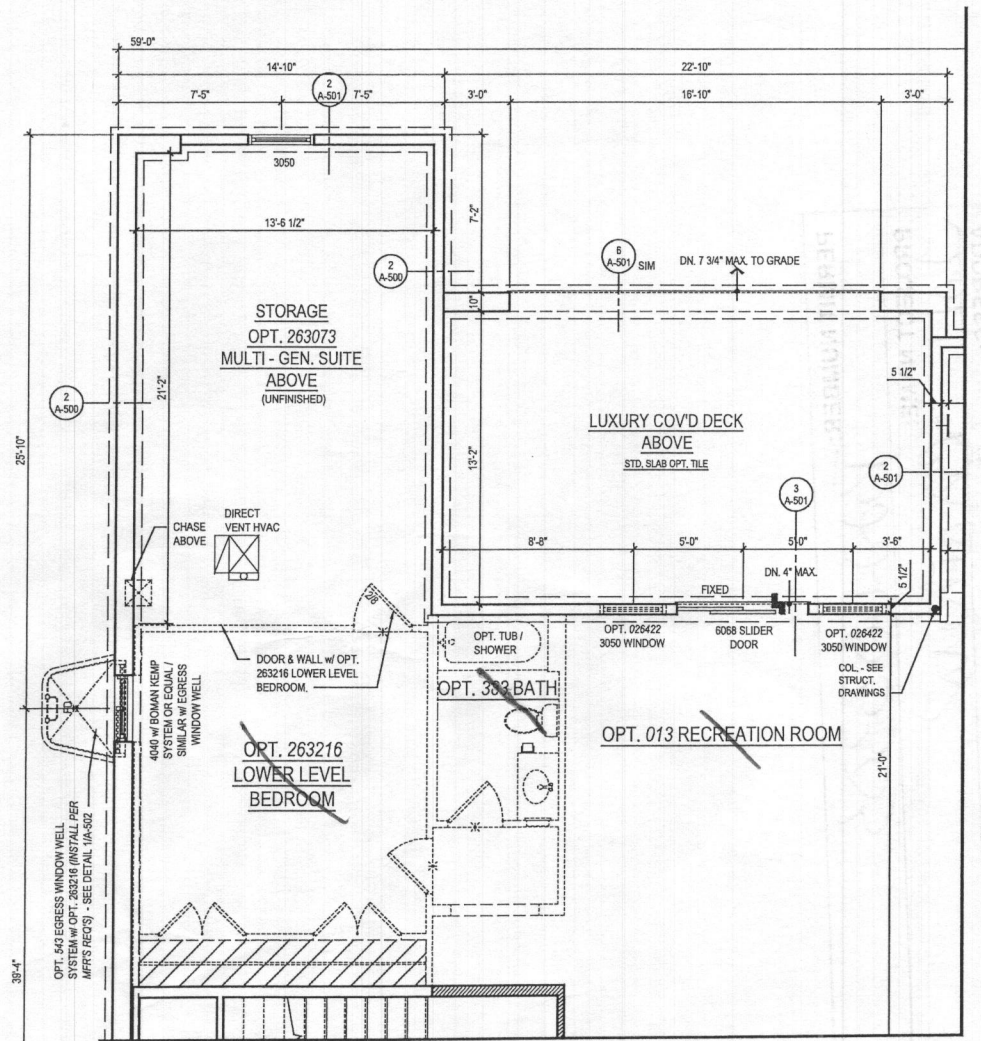

**1 PART. BASEMENT PLAN**  
A-407 SCALE: 1/4"=1'-0"  
w/ OPT. 263073 MULTI-GEN. SUITE  
w/ COVID OUTDOOR LIVING @ WALKOUT CONDITION

ARCHITECT:  
**lessard DESIGN**  
8521 Leesburg Pike  
Suite 700 | Vienna, VA 22182  
P: 571.830.1800 | F: 571.830.1801  
www.lessarddesign.com

SEAL & SIGNATURE:  
  
OWNER:  
**TOLL BROTHERS**  
19775 BELMONT EXECUTIVE PLAZA  
ASHBURN, VA 20147  
P: 571.291.8068  
CONTACT: CHRISTINA LEMLEY  
demley@tollbrothers.com

PROJECT NAME: **MARYLAND PARKHURST OPTIONS**  
SHEET TITLE: **PARKHURST OPTIONS**  
ISSUE / REVISION  
NO. DESCRIPTION DATE  
1 BID SET 05.29.19  
2 PERMIT SET 06.19.19  
3 MD NEW STANDARDS 09.16.19  
4 MR #220241 12.11.20  
PROJECT No: TOL081a  
DRAWN BY: AC/RM  
CHECKED BY: AP  
PLOT DATE: Jan. 20, 2021  
FILE NAME: TOL081a\_A407.dwg  
**A-407**

File No: TOL081a\_A407.dwg  
Plot By: anahk