

Maura J. Rossman, M.D., Health Officer

Bureau of Environmental Health
8930 Stanford Boulevard, Columbia, MD 21045
Main: 410-313-2640 | Fax: 410-313-2648
TDD 410-313-2323 | Toll Free 1-866-313-6300
www.hchealth.org
Facebook: www.facebook.com/hocohealth

RECEIPT DATE: 5/18/23 ONSITE SEWAGE DISPOSAL SYSTEM P 574133

APPROVAL DATE: 7/27/23 PERMIT: REPAIR A

PROPERTY ADDRESS: 971 Old Woodbine Road

SUBDIVISION: LOT: TAX ID: 04 316274

CONTRACTOR: Fogles Septic Clean Inc. EMAIL: kim@foglesinc.com

CONTRACTOR ADDRESS: 580 Obrecht Road, Sykesville, MD 21784 PHONE: 410-795-5670

PROPERTY OWNER: Dennis and Joy Southerland EMAIL:

OWNER ADDRESS: 971 Old Woodbine Road, Woodbine, MD 217997 PHONE:

SEPTIC TANK SIZE (GALLONS): TANK MANUFACTURER:

PUMP MODEL: Existing PUMP SIZE PUMP TANK CAPACITY:


DISTRIBUTION SYSTEM: [X] GRAVITY [ ] PRESSURE DOSED BEDROOMS: 3 APPLICATION RATE: 0.6

Table with 2 columns: Field Name and Value. Fields include TRENCHES (Linear feet required: 125', Inlet depth: 4', Trench width: 3', Maximum bottom depth: 10', Minimum space between trenches: 10', Effective area beginning depth: 7'), LOCATION (Per approved site plan...), and NOTES (Install according to plan).

ISSUED BY: Ryan Rappaport ISSUE DATE: 7/25/23 EXPIRATION DATE: 7/25/24

- NOTE: CONTRACTOR MUST SCHEDULE A PRE-CONSTRUCTION INSPECTION PRIOR TO BEGINNING ANY INSTALLATION
NOTE: CONTRACTOR MUST SCHEDULE AN INSPECTION AND GAIN APPROVAL OF ALL COMPONENTS PRIOR TO COVERING
NOTE: STONE MUST BE APPROVED BY HEALTH DEPARTMENT AND GRAVEL TICKET MUST BE AVAILABLE FOR REVIEW.
NOTE: WATERTIGHT TANKS REQUIRED
NOTE: ALL PARTS OF SEPTIC SYSTEM SHALL BE AT LEAST 100 FEET DOWNGRADIENT FROM ANY WATER WELL
NOTE: MANHOLE RISERS REQUIRED ON ALL SEPTIC TANKS AND PUMP CHAMBERS
NOTE: AN ELECTRICAL PERMIT IS REQUIRED FOR INSTALLATION OF ANY ELECTRICAL COMPONENTS OF THE SYSTEM
[ ] ELECTRICAL PERMIT ISSUED E N/A
NOTE: MDE RECOMMENDS SEPTIC TANKS, BAT, AND OTHER PRETREATMENT UNITS BE PUMPED AT A FREQUENCY ADEQUATE TO ENSURE THAT SOLIDS ARE NOT DISCHARGED TO THE DISPOSAL AREA

NEITHER THE HOWARD COUNTY COUNCIL NOR THE HEALTH DEPARTMENT IS RESPONSIBLE FOR THE SUCCESSFUL OPERATION OF ANY SYSTEM.
PERMITTEE RESPONSIBLE FOR OBTAINING FINAL APPROVAL ON THIS PERMIT.
CALL 410-313-1771 TO SCHEDULE INSPECTIONS.

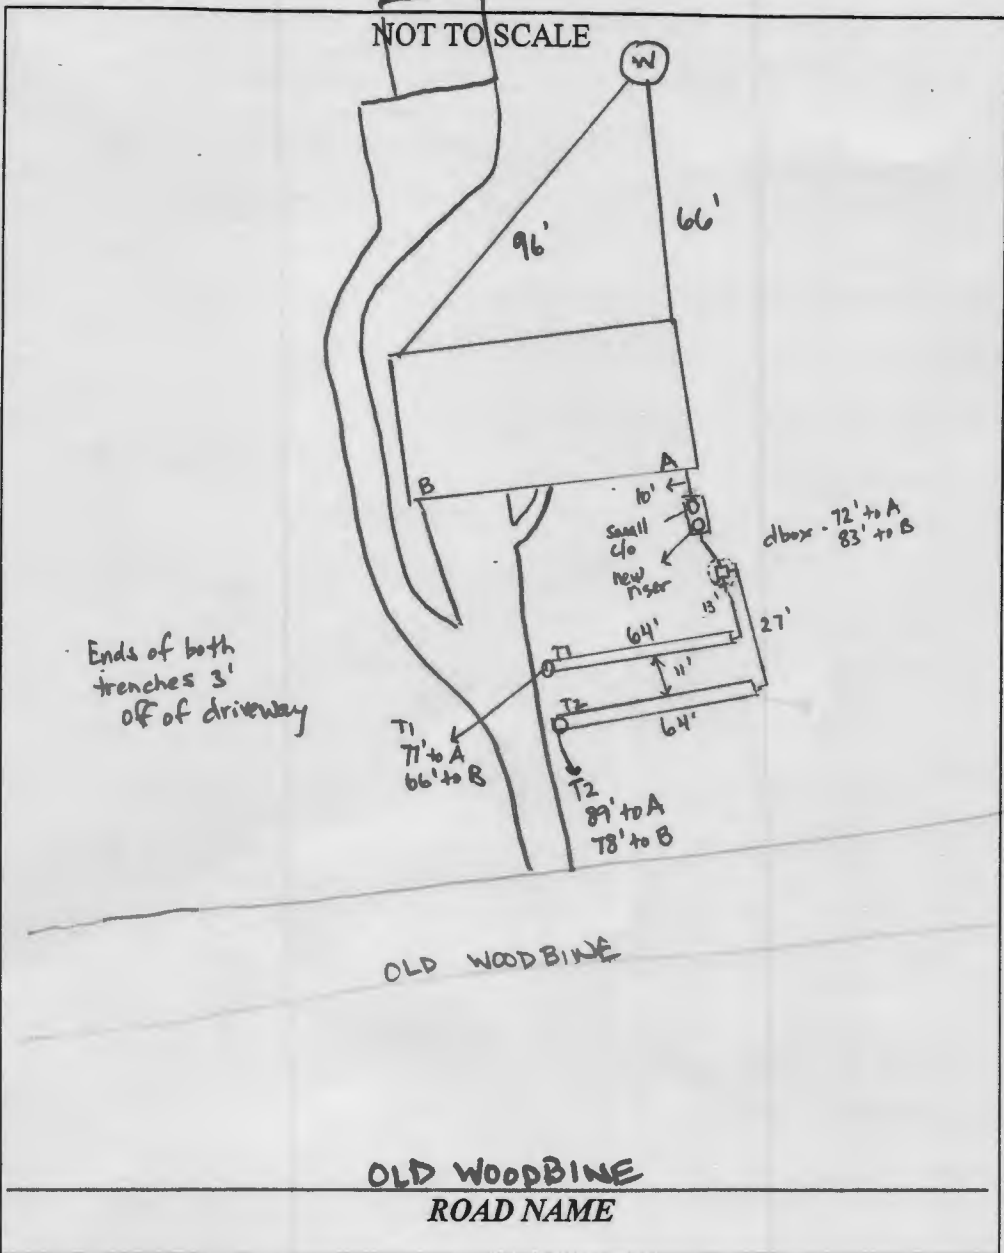

TRENCH/DRAINFIELD DATA		
WIDTH	INLET	BOTTOM
3	4'	10'
NUMBER OF TRENCHES		2
TOTAL LENGTH		128'
ABSORPTION AREA		384 sq ft + sidewall
DISTRIBUTION BOX LEVEL		yes
DISTRIBUTION BOX BAFFLE		yes
DISTRIBUTION BOX PORT		yes
		riser

SEPTIC TANK DATA	
SEPTIC TANK 1 LEVEL	
MANUFACTURER	Existing
CAPACITY	GAL
SEAM LOC	
TANK LID DEPTH	
BAFFLES	
BAFFLE FILTER	
MANHOLE LOC	
6" PORT LOC	
WATERTIGHT TEST	
SLOTTED	
DATE ON LID	
PUMP/SEPTIC TANK LEVEL	
MANUFACTURER	
CAPACITY	GAL
SEAM LOC	
TANK LID DEPTH	
BAFFLES	
BAFFLE FILTER	
MANHOLE LOC	
6" PORT LOC	
WATERTIGHT TEST	
SLOTTED	
DATE ON LID	

PRE-CONSTRUCTION:

---



---



---



---

INSTALLATION: 7/27/23 - site inspect on contractor onsite system installation complete, new riser added to the back end of the septic tank, contractor replaced 4" baffle on back end of the septic tank, 2 trenches @ 64' each installed, stone ok, geotextile fabric in place, inlet 4", trench width 3', observation pipes installed at the end of both trenches, d box levelers ok and a riser will be added on top of the d box, soil consistent with perc data, drywell lid crushed then filled in with clean fill dirt, both the septic tank & drywell were pumped out before installation started. ok to backfill. (R)

trenches = 11' ETE

FINAL INSPECTOR

R. Rappaport

DATE OF APPROVAL

7/27/23

Approved Septic System Plan  
Howard County Health Department

Signature: [Handwritten Signature]


7/25/23

630

Case

Emailed to Kevin Wolfe  
@HCHD on 7-12-23

971 Old Woodbine Rd  
Woodbine, MD 21777

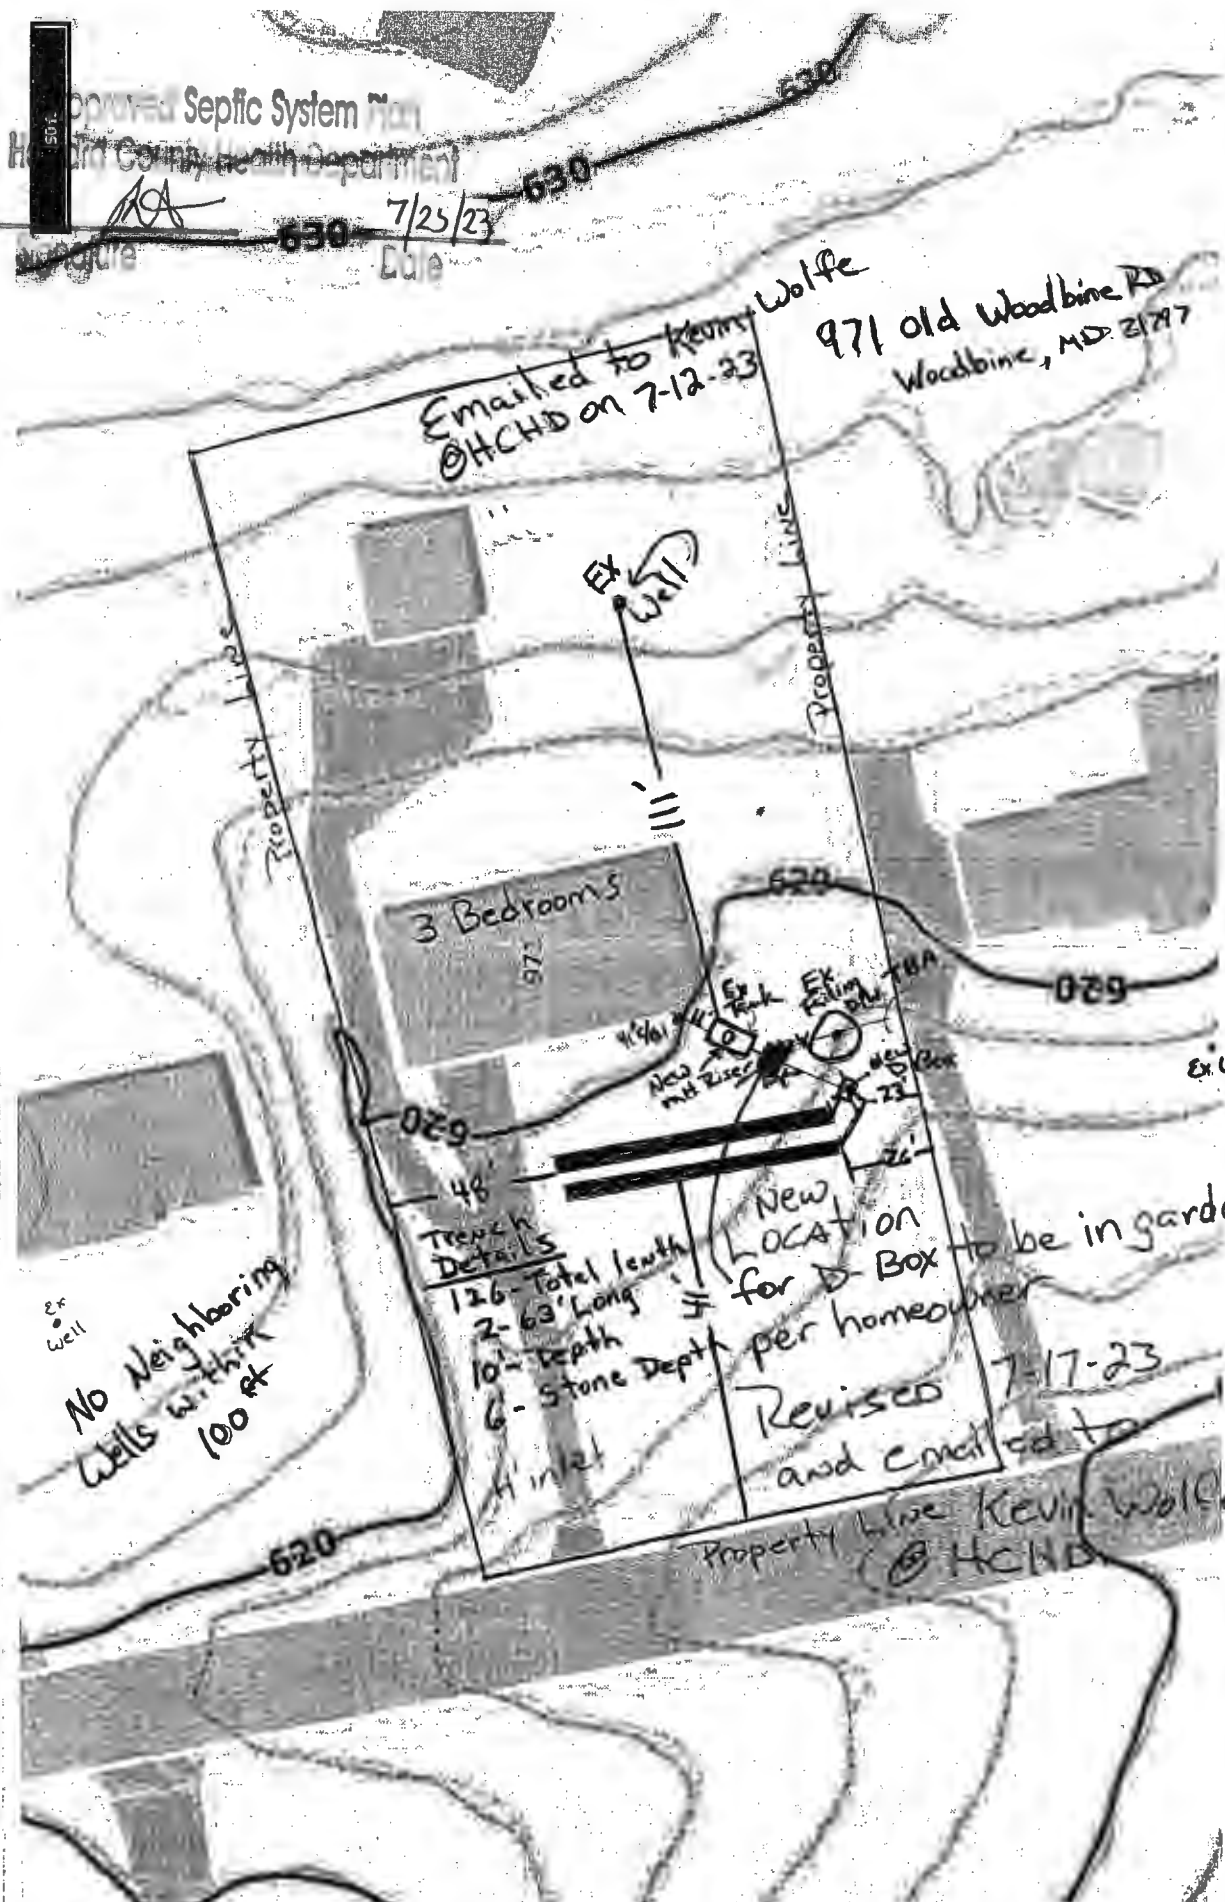

No Neighboring  
Wells within  
100 ft

Trench  
Details  
126- Total length  
2- 63' Long  
10'- Depth  
6'- Stone Depth  
4' Inlet

New  
LOCATION  
for D-Box  
per homeowner  
Revised 7-17-23  
and emailed to

Property Line Kevin Wolfe  
@HCHD



**Bureau of Environmental Health**  
 8930 Stanford Blvd | Columbia, MD 21045  
 410.313.2640 - Voice/Relay  
 410.313.2648 - Fax  
 1.866.313.6300 - Toll Free

Maura J. Rossman, M.D., Health Officer

**INFORMATION FORM - SEPTIC SYSTEM REPAIR/UPGRADE**

**Reason for Request:**

- Failing System
- System relocation for proposed addition
- System upgrade for proposed addition
- Inadequate treatment zone
- Collapsed septic tank
- Collapsed drywell

**Has the septic tank been pumped within the last month?**

Yes Date pumped: \_\_\_\_\_  
 No (our notes state new homeowner had another company pump, not sure when)  
 (Fogle's last pumped in 2020 and noted failing drywell)

**Was a visual inspection of the septic tank and/or drain fields conducted?**

Yes ? Explain observation: \_\_\_\_\_  
 No \_\_\_\_\_

**Existing system design**

- Drywell
- Trench
- Mound
- Unknown
- Other: \_\_\_\_\_

**Was a visual inspection of the sewage line conducted?**

Yes  
 No  
**Blockage Leading to the field**  
 Yes Explain \_\_\_\_\_  
 No \_\_\_\_\_

**Is discharge surfacing on the ground?**

Yes ?  
 No

**Additional Comments:**

2020 - Fogle's observed failing drywell (surfacing?) ask @ perc on 6/15/23.

\*For REPAIRS, are the owners proposing, or do they plan to add in the future any additions or modifications to the property, i.e. pools, living space additions, garages, etc? This information must be disclosed at the time of this application. The Health Department will not be able to accommodate requests in the field for property modifications unrelated to the repair request. Such requests may require an additional fee, testing, and submittal of a Percolation Certification Plan, if the property does not meet current Code and Regulations.

Septic Contractor: Fogle's Septic Clean, Inc.

Contractor's Phone: 410-795-5670

Contractor's Address: 580 Obrecht Rd Sykesville, MD 21784

Property Address: 971 Old Woodbine Rd

County File: \_\_\_\_\_

Subdivision: Woodbine, MD

Lot: \_\_\_\_\_ Year Built: \_\_\_\_\_

Owner's Name: \_\_\_\_\_

Existing bedrooms: ~~2~~ 3

Name of previous owners: \_\_\_\_\_

Existing bedrooms: \_\_\_\_\_

Proposed bedrooms: \_\_\_\_\_

\*A Sanitarian will be in contact within three business days, depending upon the urgency of the situation, to coordinate the scheduling/review of the repair or upgrade.

\*Prior to scheduling inspections, scaled plans should be submitted to clarify the nature of the addition.\*

Print out a copy of Real Property Data via Dept. of Taxation website \_\_\_\_\_ Indexed file found \_\_\_\_\_

If soil/site conditions are limited and sewer and/or Metro District status is not conducive to connection, the Sanitarian may recommend pursuit of Emergency Sewer Extension or Emergency Metro District Inclusion. The Owner should contact the Bureau of Utilities for details.

No permit is to be issued nor inspection to be scheduled without prior fee collection at the office unless an emergency exists.

The contractor is to notify the office of the emergency as soon as possible.

2/2020