

# APPLICATION

A 1968

SEWAGE DISPOSAL TESTING

P \_\_\_\_\_

STATE OF MARYLAND - DEPARTMENT OF HEALTH AND MENTAL HYGIENE

HOWARD COUNTY HEALTH DEPARTMENT  
ENVIRONMENTAL HEALTH SERVICES

DISTRICT 5

P. O. BOX 476, ELLICOTT CITY, MARYLAND 21043  
TELEPHONE: 465-5000, EXT. 356

DATE 3/18/74

*3/27/74  
9:30  
4/18/74  
9:30*

TO: THE COUNTY HEALTH OFFICER  
ELLICOTT CITY, MARYLAND

I, HEREBY, APPLY FOR THE NECESSARY TEST IN ORDER TO CONSTRUCT (OR RECONSTRUCT) A SEWAGE DISPOSAL SYSTEM.

PROPERTY OWNER Dr. S. Fred Singer

ADDRESS \_\_\_\_\_ PHONE \_\_\_\_\_

Any questions call:  
Mrs. Louise Adams  
531-5458

PROPERTY LOCATION:

SUBDIVISION \_\_\_\_\_ LOT NO. \_\_\_\_\_

ROAD AND DESCRIPTION Brooks Road off Rt. 108

SIZE OF LOT 60.28 acres 25 acres TYPE BLDG. 4

NUMBER OF BEDROOMS  
(Single Fmly. Dwlg.)

IF NOT SINGLE RESIDENCE DESCRIBE \_\_\_\_\_

THE SYSTEM INSTALLED UNDER THIS APPLICATION IS ACCEPTABLE ONLY UNTIL PUBLIC FACILITIES BECOME AVAILABLE.

SIGNATURE OF APPLICANT /s/ Mrs. Louise Adams

APPROVED BY \_\_\_\_\_ FOR \_\_\_\_\_ DATE \_\_\_\_\_

(KIND OF SYSTEM)

REJECTED BY \_\_\_\_\_ FOR \_\_\_\_\_ DATE \_\_\_\_\_

(KIND OF SYSTEM)


HOLD PENDING FURTHER TESTS BH DATE 3/27/74

REASONS FOR REJECTION OR HOLDING 3/27/74 - Clay & Underground Water

# THIS IS NOT A PERMIT

15000

15000

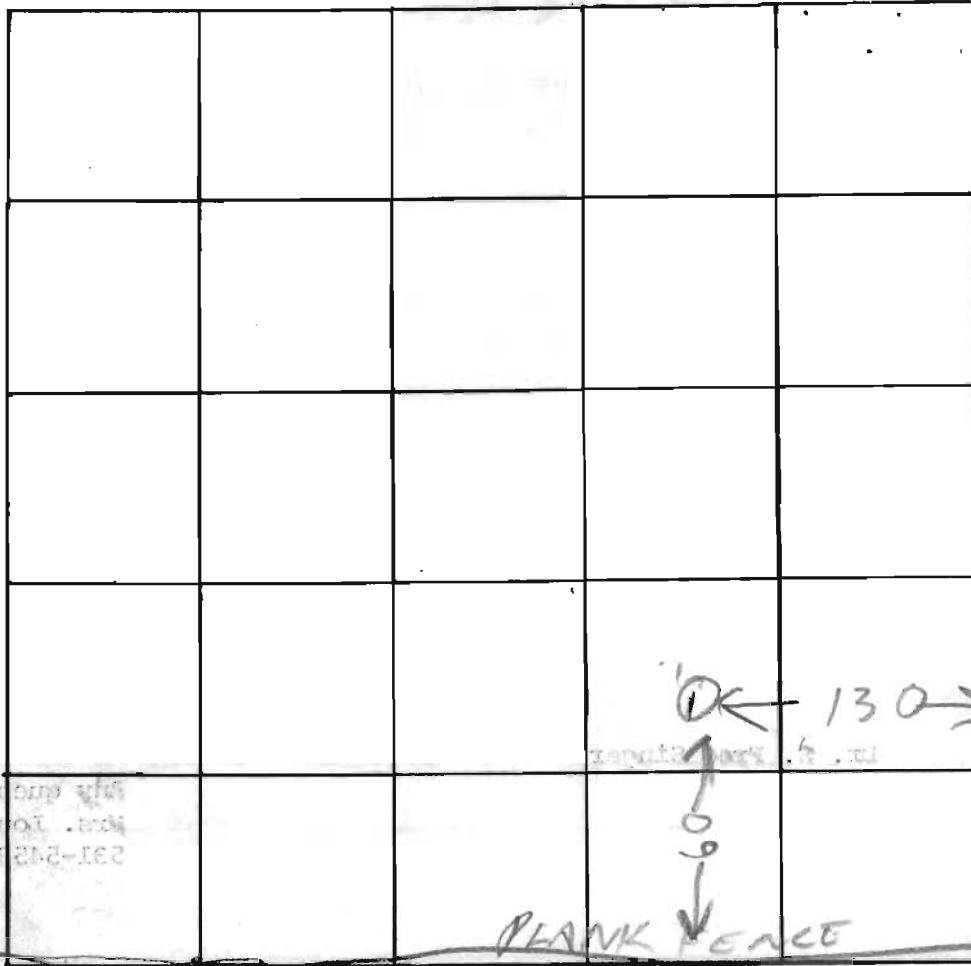

2ND PART OF LOT TESTED

WIRE FENCE

130

10

PLANK FENCE

INDICATE NORTH. - NAME ADJOINING ROADWAY AS BASE LINE.

DEAD END BROOKS RD

DATE	TEST NO.	DEPTH	PRE-WET		TEST - 1" DROP		TIME
			START	STOP	START	STOP	
3/27/44	1	about 9	Failed		Water		

REMARKS \_\_\_\_\_

TYPE OF SOIL \_\_\_\_\_

TESTED BY \_\_\_\_\_ ALSO PRESENT: \_\_\_\_\_

# APPLICATION

A 19668

## SEWAGE DISPOSAL TESTING

P \_\_\_\_\_

STATE OF MARYLAND - DEPARTMENT OF HEALTH AND MENTAL HYGIENE

HOWARD COUNTY HEALTH DEPARTMENT  
ENVIRONMENTAL HEALTH SERVICES

DISTRICT 5

P. O. BOX 476, ELLICOTT CITY, MARYLAND 21043  
TELEPHONE: 465-5000, EXT. 356

DATE 3/18/74

TO: THE COUNTY HEALTH OFFICER  
ELLICOTT CITY, MARYLAND

I, HEREBY, APPLY FOR THE NECESSARY TEST IN ORDER TO CONSTRUCT (OR RECONSTRUCT) A SEWAGE DISPOSAL SYSTEM.

PROPERTY OWNER Dr. S. Fred Singer

ADDRESS \_\_\_\_\_ PHONE \_\_\_\_\_

Any questions call:  
Mrs. Louise Adams  
531-5458

PROPERTY LOCATION:

SUBDIVISION \_\_\_\_\_ LOT NO. \_\_\_\_\_

ROAD AND DESCRIPTION Brooks Road off Rt. 108

SIZE OF LOT 60.28 acres TYPE BLDG. 4

NUMBER OF BEDROOMS  
(Single Fmly. Dwlg.)

IF NOT SINGLE RESIDENCE DESCRIBE \_\_\_\_\_

THE SYSTEM INSTALLED UNDER THIS APPLICATION IS ACCEPTABLE ONLY UNTIL PUBLIC FACILITIES BECOME AVAILABLE.

SIGNATURE OF APPLICANT /s/ Mrs. Louise Adams

APPROVED BY \_\_\_\_\_ FOR \_\_\_\_\_ DATE \_\_\_\_\_

(KIND OF SYSTEM)

REJECTED BY \_\_\_\_\_ FOR \_\_\_\_\_ DATE \_\_\_\_\_


(KIND OF SYSTEM)

HOLD PENDING FURTHER TESTS \_\_\_\_\_ DATE \_\_\_\_\_

REASONS FOR REJECTION OR HOLDING \_\_\_\_\_

# THIS IS NOT A PERMIT

FENCE

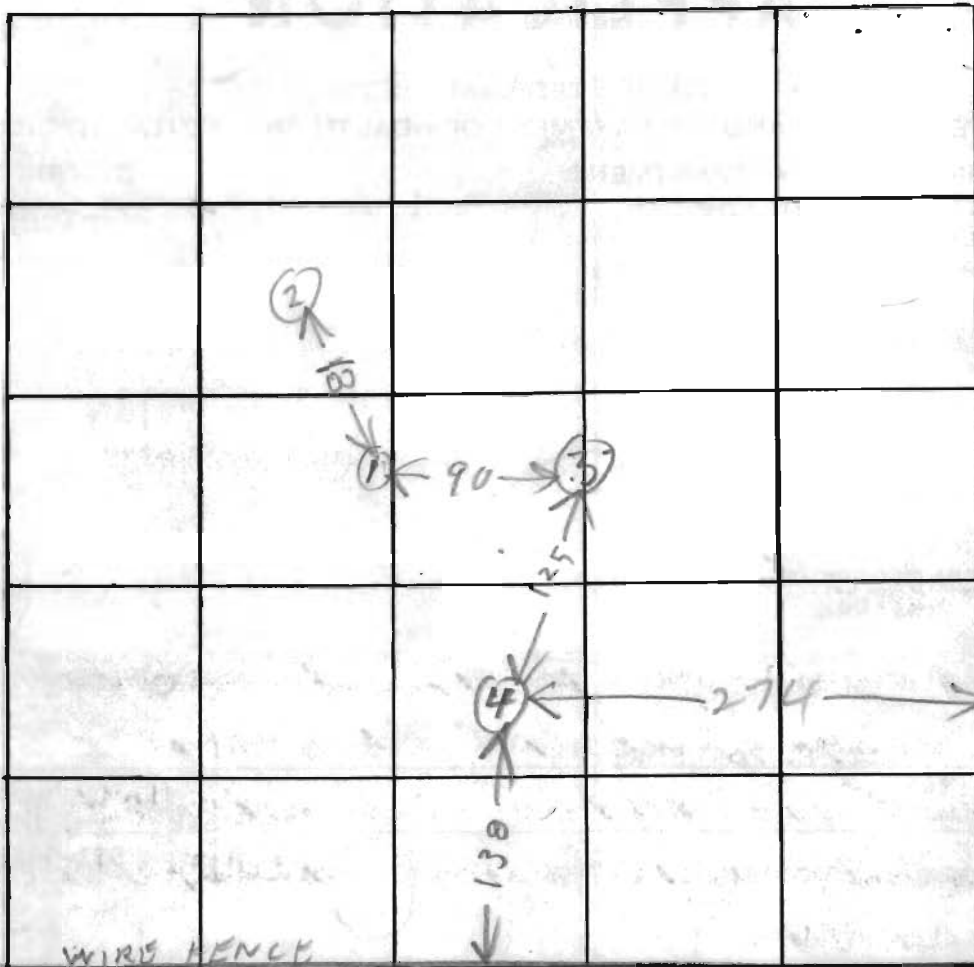

1st part  
of lot  
tested  
46  
3  
138

Holes  
must be  
certified  
if any  
pass test  
Lot not  
staked off  
very well

WOODS

WIRE FENCE

INDICATE NORTH. - NAME ADJOINING ROADWAY AS BASE LINE.

13' Brook St Rd

DATE	TEST NO.	DEPTH	PRE-WET		TEST - 1" DROP		TIME
			START	STOP	START	STOP	
3/27/74	1	10	ALL CLAY				
	2	10 1/2	ALL CLAY				
	3	10	TOP 7 FT CLAY BOT 3 FT SAND WATER COMES IN AT 9 FT				
	4	12	TOP 6 FT CLAY BOT 6 FT SAND UNDERGROUND WATER 12 FT				
3/27/74	5	12	WATER	12 FT	Seepage	2 for Location	

REMARKS Lot is almost level

TYPE OF SOIL

TESTED BY R H & F S

ALSO PRESENT: Fryock 3/27/74

4-12' holes  
w/ 10,000 ft.  
*Preliminary*

# APPLICATION

A 1968

P \_\_\_\_\_

## SEWAGE DISPOSAL TESTING

STATE OF MARYLAND - DEPARTMENT OF HEALTH AND MENTAL HYGIENE

HOWARD COUNTY HEALTH DEPARTMENT  
ENVIRONMENTAL HEALTH SERVICES  
P. O. BOX 476, ELLICOTT CITY, MARYLAND 21043  
TELEPHONE: 465-5000, EXT. 356

DISTRICT 5

DATE 11/26/74

*11/27/74  
9:30*

TO: THE COUNTY HEALTH OFFICER  
ELLICOTT CITY, MARYLAND

I, HEREBY, APPLY FOR THE NECESSARY TEST IN ORDER TO CONSTRUCT (OR RECONSTRUCT) A SEWAGE DISPOSAL SYSTEM.

PROPERTY OWNER Dr. S. Fred Singer

Any questions call:

ADDRESS \_\_\_\_\_ PHONE Mrs. Louise Adams

531-5458

PROPERTY LOCATION:

286-2336

SUBDIVISION \_\_\_\_\_ LOT NO. \_\_\_\_\_

ROAD AND DESCRIPTION Brooks Road off Rt. 108

SIZE OF LOT 8.114 acres TYPE BLDG. 3 or 4

NUMBER OF BEDROOMS

IF NOT SINGLE RESIDENCE DESCRIBE \_\_\_\_\_ (Single Fmly. Dwllg.)

THE SYSTEM INSTALLED UNDER THIS APPLICATION IS ACCEPTABLE ONLY UNTIL PUBLIC FACILITIES BECOME AVAILABLE.

SIGNATURE OF APPLICANT /s/ Mrs. Louise Adams

APPROVED BY \_\_\_\_\_ FOR \_\_\_\_\_ DATE \_\_\_\_\_

(KIND OF SYSTEM)


REJECTED BY H. H. Zepp FOR any system DATE 11/27/74

(KIND OF SYSTEM)

HOLD PENDING FURTHER TESTS \_\_\_\_\_ DATE \_\_\_\_\_

REASONS FOR REJECTION OR HOLDING insufficient perc.

# THIS IS NOT A PERMIT

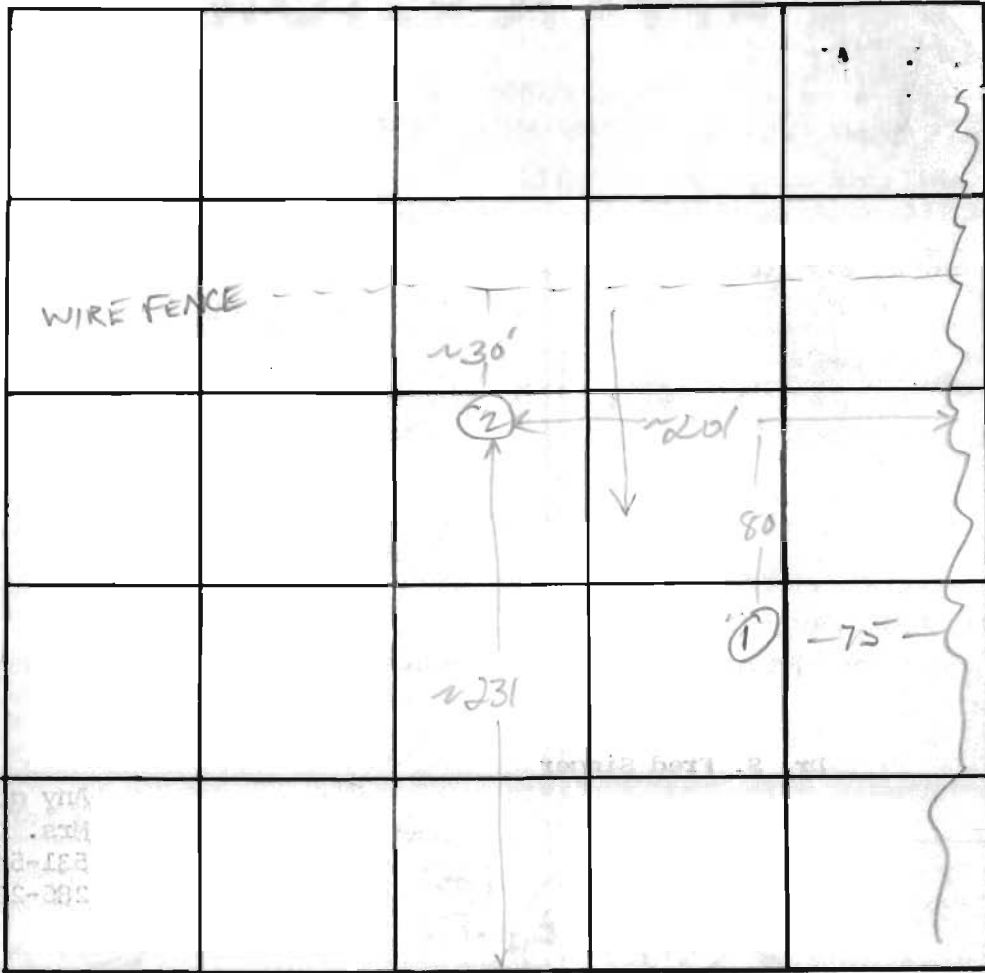

INDICATE NORTH. - NAME ADJOINING ROADWAY AS BASE LINE.



Brooks RD → Bt 108

DATE	TEST NO.	DEPTH	PRE-WET		TEST - 1" DROP		TIME
			START	STOP	START	STOP	
11/27/74	1	5	9:42	9:53	9:53		pulled peg
	1-A	11 1/2	9:43	10:00	10:00		pulled peg
	2	5	10:07	10:23	10:23		pulled peg @ 10:37
	2-A	12	10:07				10:31 pulled peg

REMARKS Area uphill from these tests had been tested previously and found unsuitable

TYPE OF SOIL clay then wet loam.


TESTED BY WNZ ALSO PRESENT: L. Adams, Fyock

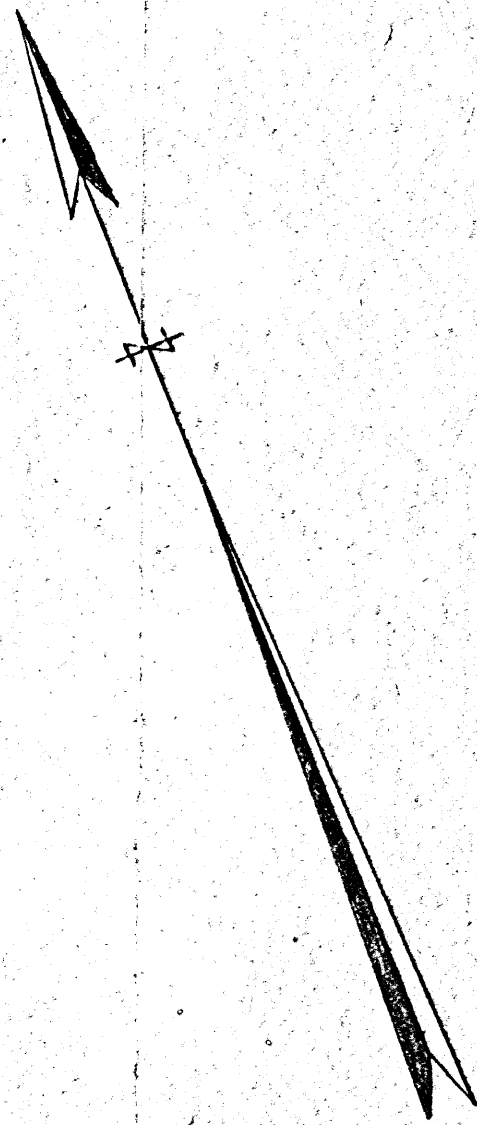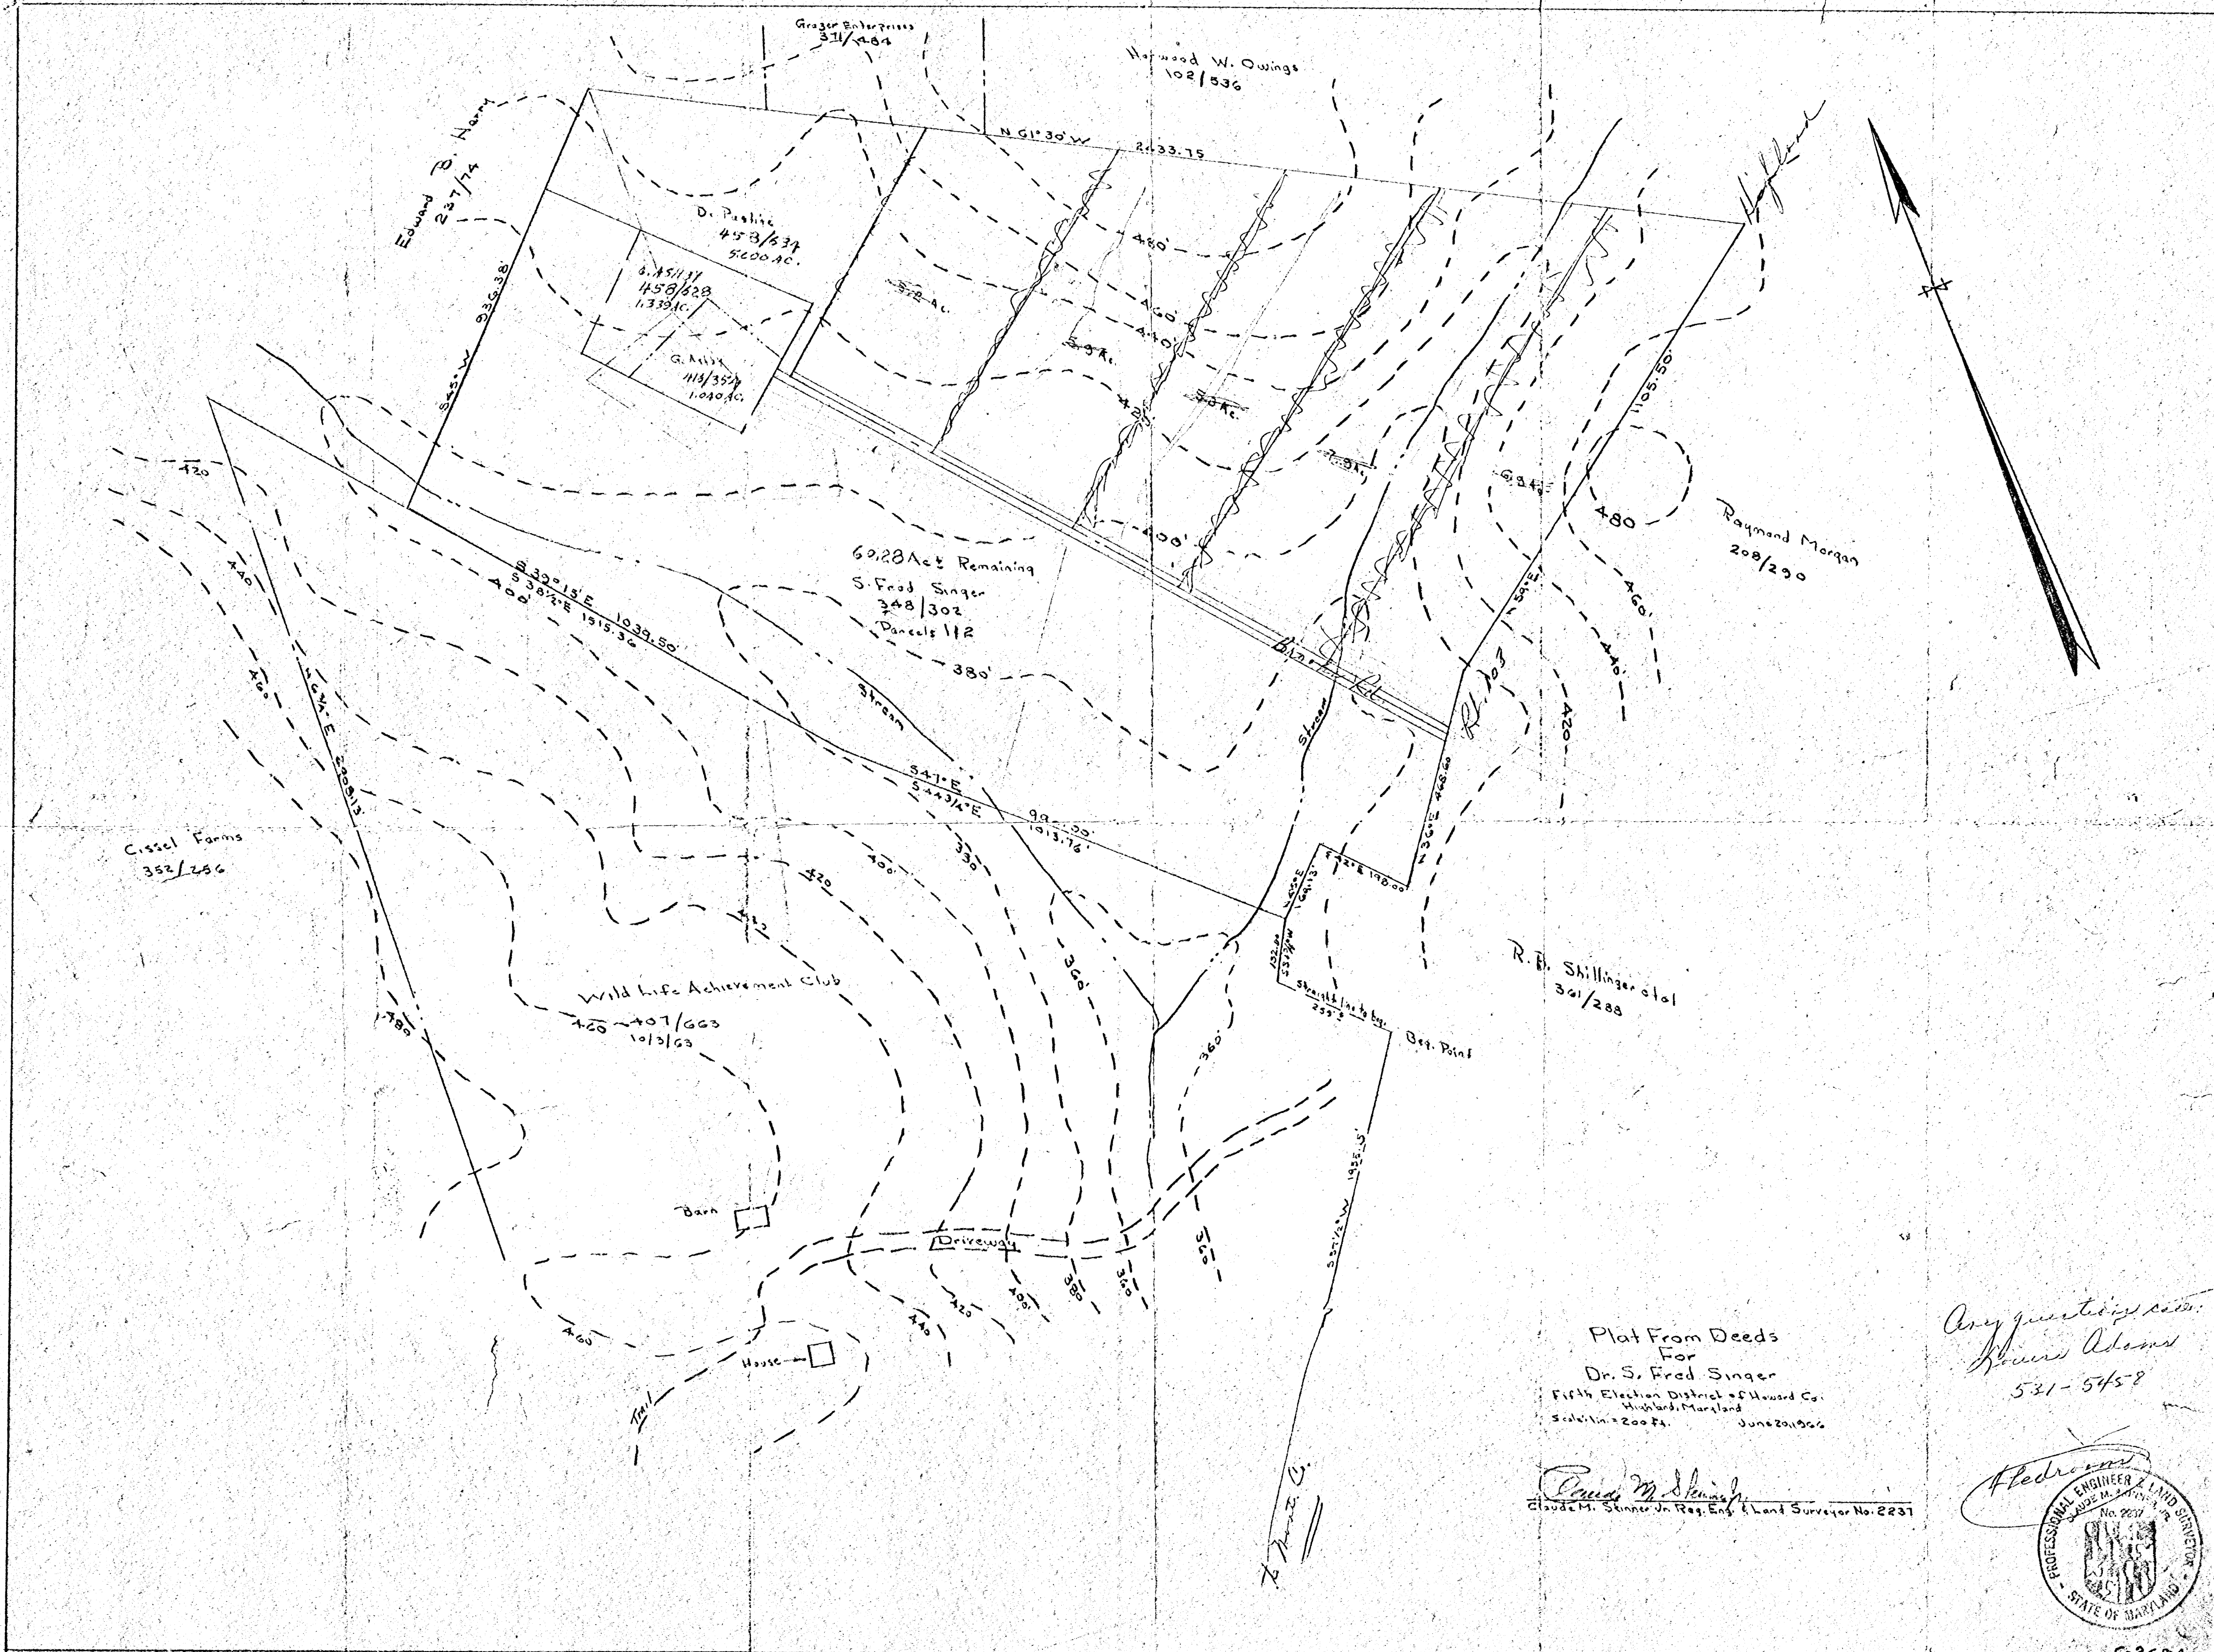

Plat From Deeds  
 For  
 Dr. S. Fred Singer  
 Fifth Election District of Howard Co.  
 Highland, Maryland  
 Scale 1" = 200 Ft. June 20, 1966

Any questions call:  
 Bruce Adams  
 531-5458

*Claude M. Skinner*  
 Claude M. Skinner Jr. Reg. Eng. & Land Surveyor No. 2231

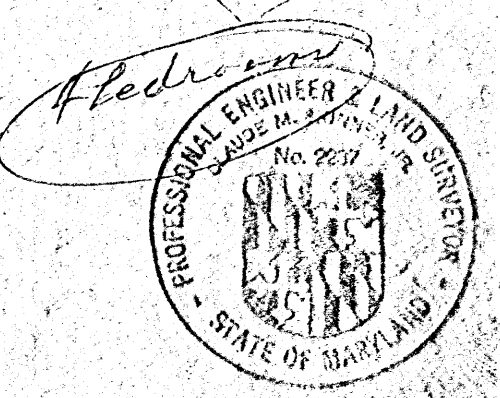

George ASHBY

Dear Mr Ashby

On 3/24/74 Percolation tests  
were Run on the 13.361 Ac Lot  
of the S. Fred Singer Property  
on Brooks Road. The tests  
indicated that the lot is  
unsuitable for building  
because of the Clay soil  
and underground water

Very truly yours  
Raymond Hodges

June 18, 1974

TO WHOM IT MAY CONCERN:

This is to certify that a standard percolation test was run on the Dr. S. Fred Singer property, Brooks Road off Rt. 108 on March 27, 1974. This parcel of land which is 13.361 acres, failed to pass the percolation test and therefore is non-buildable until public sewers become available.

Very truly yours,

Palmer F. Wine, Director  
Environmental Health

PFW:jr

Thomas &  
Mills - Brooks Rd.  
13+ acres

(Mr. Fred Singer)

133  
134  
135  
136

Thomas & Mills

12500 Ivory Feed

Samuel, Mr.

2084

For  
Relief

Faint vertical text, possibly a list or index.