
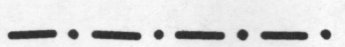
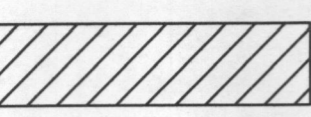
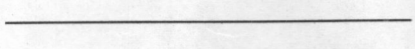

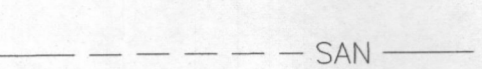
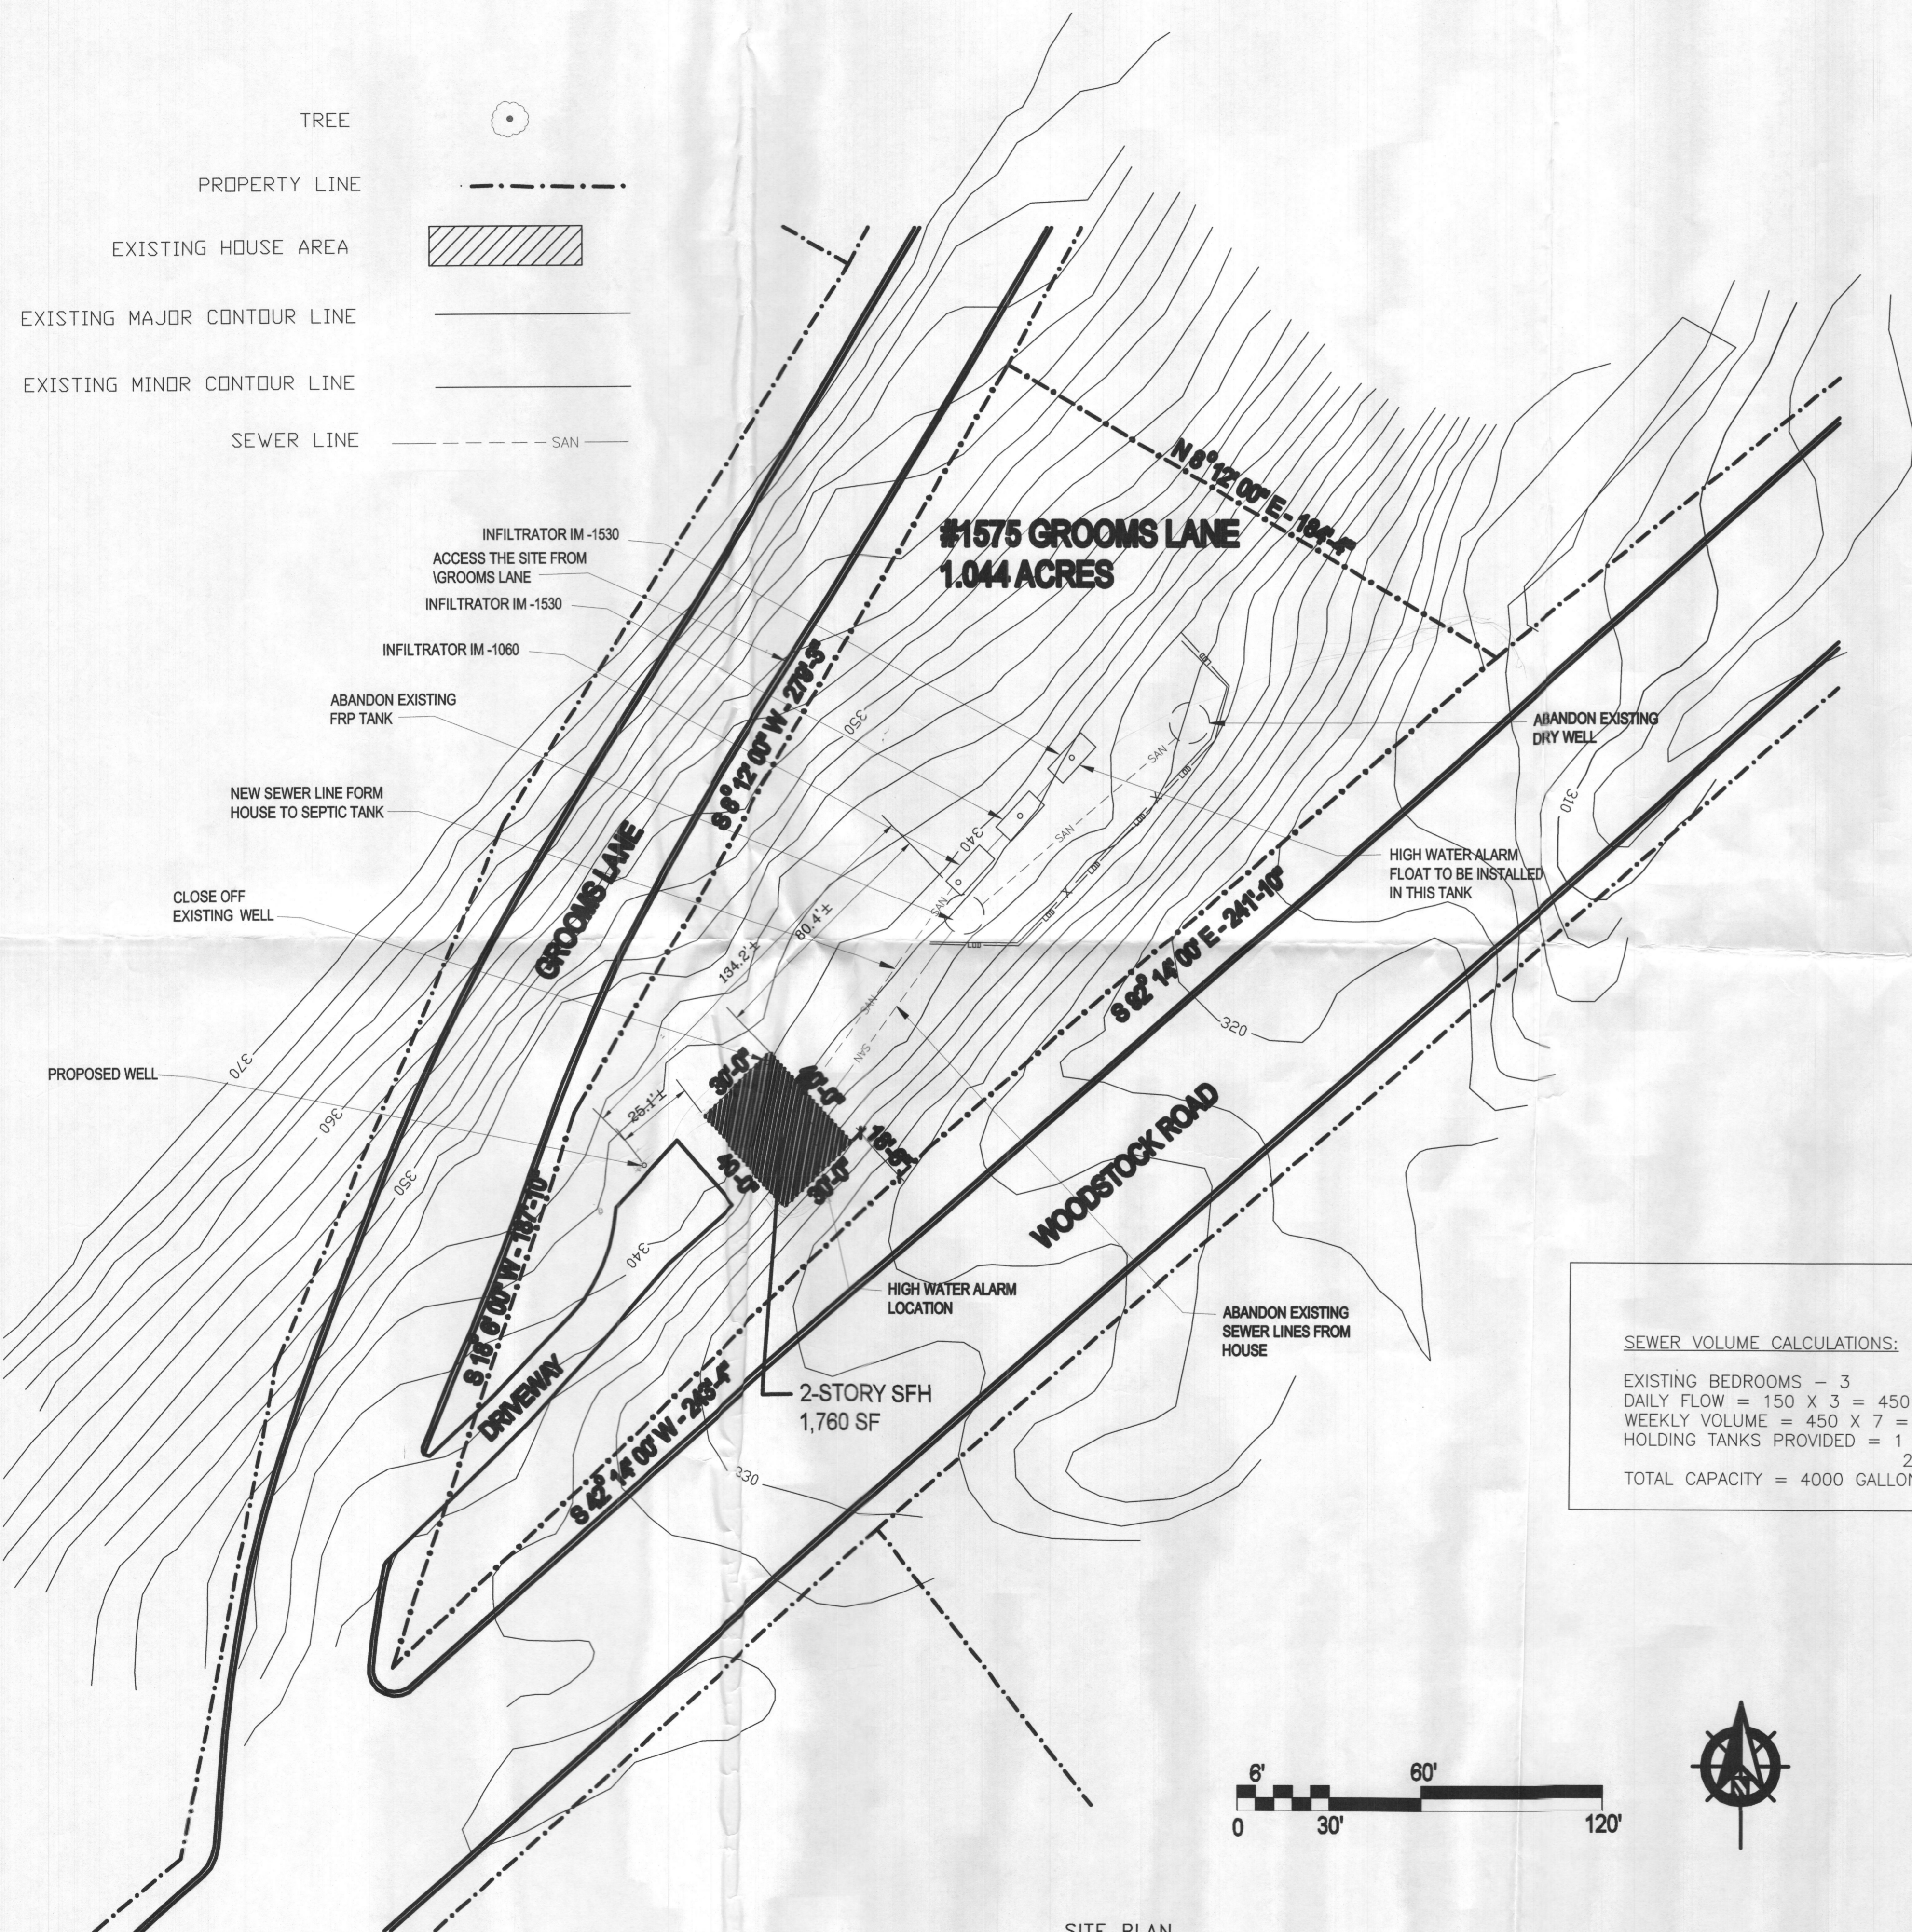


- TREE 
- PROPERTY LINE 
- EXISTING HOUSE AREA 
- EXISTING MAJOR CONTOUR LINE 
- EXISTING MINOR CONTOUR LINE 
- SEWER LINE 




SEWER VOLUME CALCULATIONS:
 EXISTING BEDROOMS - 3
 DAILY FLOW = 150 X 3 = 450 GALLON
 WEEKLY VOLUME = 450 X 7 = 3150 GALLON
 HOLDING TANKS PROVIDED = 1 - 1000 GALLONS AND
 2 - 1500 GALLONS
 TOTAL CAPACITY = 4000 GALLONS

- GENERAL NOTES:**
1. TOPOGRAPHY AND PLANIMETRIC LOCATIONS SHOWN HEREON ARE FIELD RUN 2' CONTOUR INTERVAL.
 2. UTILITY LOCATIONS SHOWN HEREON ARE BASED ON FIELD OBSERVATIONS AND AVAILABLE RECORDS. THEIR LOCATIONS ARE CONSIDERED APPROXIMATE AND MUST BE VERIFIED BY THE APPROPRIATE UTILITY PROVIDED AND LOCATED BY TEST PITTING PRIOR TO ANY CONSTRUCTION OR ENGINEERING DESIGN.
 3. THE CONTRACTOR SHALL INSTALL SILT FENCE AS SHOWN ON PLAN AROUND THE LOD LINES. THE CONTRACTOR SHALL MAINTAIN THE SILT FENCE DURING THE CONSTRUCTION.
 4. THERE ARE TWO EXISTING TANKS ON THE PROPERTY. THE CONTRACTOR REMOVE ALL LIQUID AND SEWER FROM THE TANKS AND ABANDON THESE TANKS AS IT WITH TOP CAPPED. ALL UNDERGROUND SEWER LINES FROM THE HOUSE TO THE TANK SHALL ALSO BE ABANDONED. ALL TANKS AND SEWER LINE ABANDON PROCEDURE SHALL MEET THE HOWARD COUNTY REQUIREMENTS.
 5. THERE IS EXISTING WELL UNDER THE HOUSE AS LOCATED ON THE PLAN. THE CERTIFIED WELL CONTRACTOR CLOSE OFF THE WELL PER COUNTY REQUIREMENTS AND STANDARDS.
 6. THE WELL DRILLER CONTRACTOR DRILL A NEW WELL AS SHOWN ON PLAN. NEW WELL SHALL MEETS THE MINIMUM REQUIREMENTS OF SET BACKS AND OTHER COUNTY STANDARDS. RECONNECT WELL WITH EXISTING WATER TREATMENT FACILITY INSIDE THE HOUSE.
 7. THE CONTRACTOR SHALL NOTIFY THE FOLLOWING AGENCIES AT LEAST (5) WORKING DAYS PRIOR TO THE START OF WORK:
 7.1. HOWARD COUNTY DEPARTMENT OF PUBLIC WORKS
 7.2. HOWARD COUNTY HEALTH DEPARTMENT
 7.3. HOWARD COUNTY CONSTRUCTION INSPECTIONS AND ENFORCEMENT
 8. THE CONTRACTOR SHALL NOTIFY "MISS UTILITY" AT 1-800-257-7777 AT LEAST 48 HOURS PRIOR TO ANY EXCAVATION WORK BEING DONE.
 9. CONTRACTOR SHALL USE THE DIRT FROM THE EXCAVATION OF THE BASEMENT AS REQUIRED ALONG THE SITE AREA.
 10. THE CONTRACTOR SHALL MAINTAIN POSITIVE DRAINAGE.
 11. CONTRACTOR SHALL STABILIZE ALL DISTURBED AREAS BY THE END OF EACH WORKING DAY IF THE RUNOFF FROM THE DISTURBED AREAS ARE NOT DIRECTED TO ANY APPROVED SEDIMENT CONTROL MEASURE.
 12. THERE IS NO WETLAND, FLOOD PLAIN, RAP WITHIN THE PROJECT LIMIT.
 13. THE CONTRACTOR SHALL PROVIDE SOD ON DISTURBED AREA AFTER ALL CONSTRUCTION DONE.
 14. HOLD A PRE-CONSTRUCTION CONFERENCE WITH THE HOWARD COUNTY HEALTH DEPARTMENT PRIOR TO THE START OF THE HOLDING TANK INSTALLATION.
 15. MOBILIZE THE EQUIPMENT AND MATERIAL NECESSARY TO COMPLETE THE PROPOSED HOLDING TANK INSTALLATION.
 16. PUMP OUT THE EXISTING SEPTIC TANK AND ABANDON IT IN PLACE AT THE START OF THE PROPOSED WORK.
 17. SUPPLY AND INSTALL A NEW SEWER LINE FROM THE EXTERIOR OF THE FOUNDATION WALL TO THE PROPOSED HOLDING TANK LOCATION USING 4 INCH SCH40 PVC PIPE AND FITTINGS.
 18. SUPPLY AND INSTALL TWO INFILTRATOR IM-1530 1,500-GALLON SEPTIC TANKS AND ONE INFILTRATOR EM-1060 1,000-GALLON SEPTIC TANK.
 19. SUPPLY AND INSTALL A 24" IN DIAMETER MANHOLE RISER WITH SAFETY LID TO GRADE ON EACH OF THE NEW HOLDING TANK.
 20. CONNECT THE NEW SEPTIC TANKS TO THE NEW SEWER LINE AND CONNECT THE THREE NEW TANKS IN SERIES USING 4 INCH CH4D PVC PIPE AND FITTINGS.
 21. SUPPLY AND INSTALL A FLOAT TREE AND HIGH WATER ALARM FLOAT IN THE LAST TANK IN SERIES.
 22. SUPPLY AND INSTALL CONDUIT FROM THE LAST TANK IN SERIES TO THE EXTERIOR OF THE HOUSE FOR THE WIRING OF HIGH WATER ALARM.
 23. SUPPLY AND INSTALL A SJE RHOMBUS HIGH-WATER ALARM PANEL.
 24. WIRE FROM THE HIGH-WATER ALARM FLOAT TO THE HIGH-WATER ALARM PANEL.
 25. BACKFILL ALL PROPOSED WORK WITH ON-SITE MATERIALS FROM THE EXCAVATION AFTER INSPECTION BY THE HOWARD COUNTY HEALTH DEPARTMENT.
 26. SPREAD ALL EXCESS SOIL SPOILS FROM THE PROPOSED WORK ON SITE IN THE AREA OF THE PROPOSED WORK. MACHINE GRADE ALL DISTURBED AREAS FROM THE PROPOSED WORK.
 27. FILL THE EACH NEWLY INSTALLED HOLDING TANKS TO A MINIMUM OF 2/3 OF THE TANK CAPACITY. TAKE A MEASUREMENTS FROM THE TOP OF THE TANK TO THE WATER LEVEL IN THE TANK AFTER FILLED. REMEASURE THE WATER LEVEL IN THE TANKS 24 HOURS LATER TO TEST FOR WATER TIGHTNESS.

MISS UTILITY
 CALL "MISS UTILITY" AT 1-800-257-7777, 48 HOURS PRIOR TO THE START OF WORK. THE EXCAVATOR MUST NOTIFY ALL PUBLIC UTILITY COMPANIES WITH UNDER GROUND FACILITIES IN THE AREA OF PROPOSED EXCAVATION AND HAVE THOSE FACILITIES LOCATED BY THE UTILITY COMPANIES PRIOR TO COMMENCING EXCAVATION. THE EXCAVATOR IS RESPONSIBLE FOR COMPLIANCE WITH REQUIREMENTS OF CHAPTER 36A OF THE MONTGOMERY COUNTY CODE.

PROFESSIONAL CERTIFICATION.
 I HEREBY CERTIFY THAT THESE DOCUMENTS WERE PREPARED OR APPROVED BY ME, AND THAT I AM DULY LICENSED ENGINEER UNDER THE LAWS OF THE STATE OF MARYLAND, LICENSE NUMBER 23081, EXPIRATION DATE: 04/2017

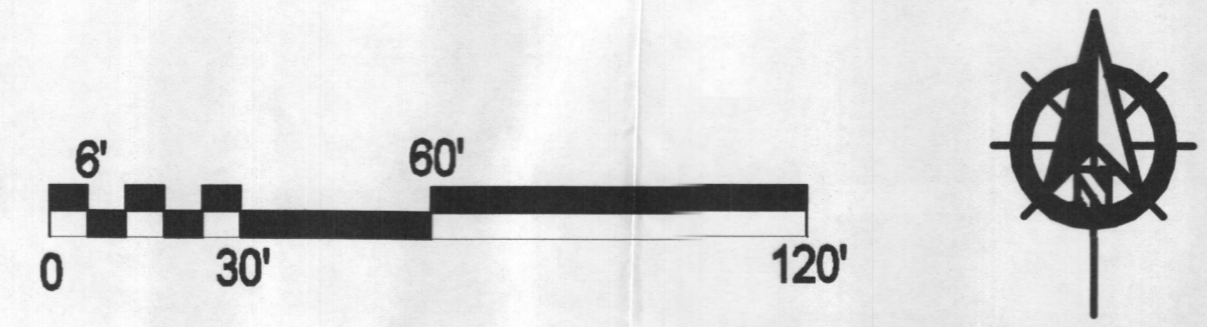


SITE PLAN
 SCALE: 1" = 30'

	INITIALS	DATE	1575 GROOMS LANE WOODSTOCK MD 21163 PARCEL: 0012 DISTRICT 03, Ac No.: 286487 HOWARD COUNTY, MD MY HOME PLUS LLC PHONE NO: 443-465-8027	C2
DRAWN	SP	02-02-17		
DESIGN	VD	02-02-17		
CHECKER	PP	02-02-17		
A-E MANAGER	AA	02-02-17		
SITE PLAN				
ARENCO, LLC				
ARCHITECTURAL ENGINEERING CONSULTANTS				
526 RAMBLING SUNSET CIRCLE, MOUNT AIRY, MARYLAND 21771				
240-418-1389 prafulp@arenco-llc.com				
CM			SCALE	
PM			1"=30'	
	WORK REQUEST #	SHEET	DRAWING NO.	
	16-247	02 OF 02	16-247-02	

MY HOME PLUS LLC

1575 GROOMS LANE

WOODSTOCK MD 21163

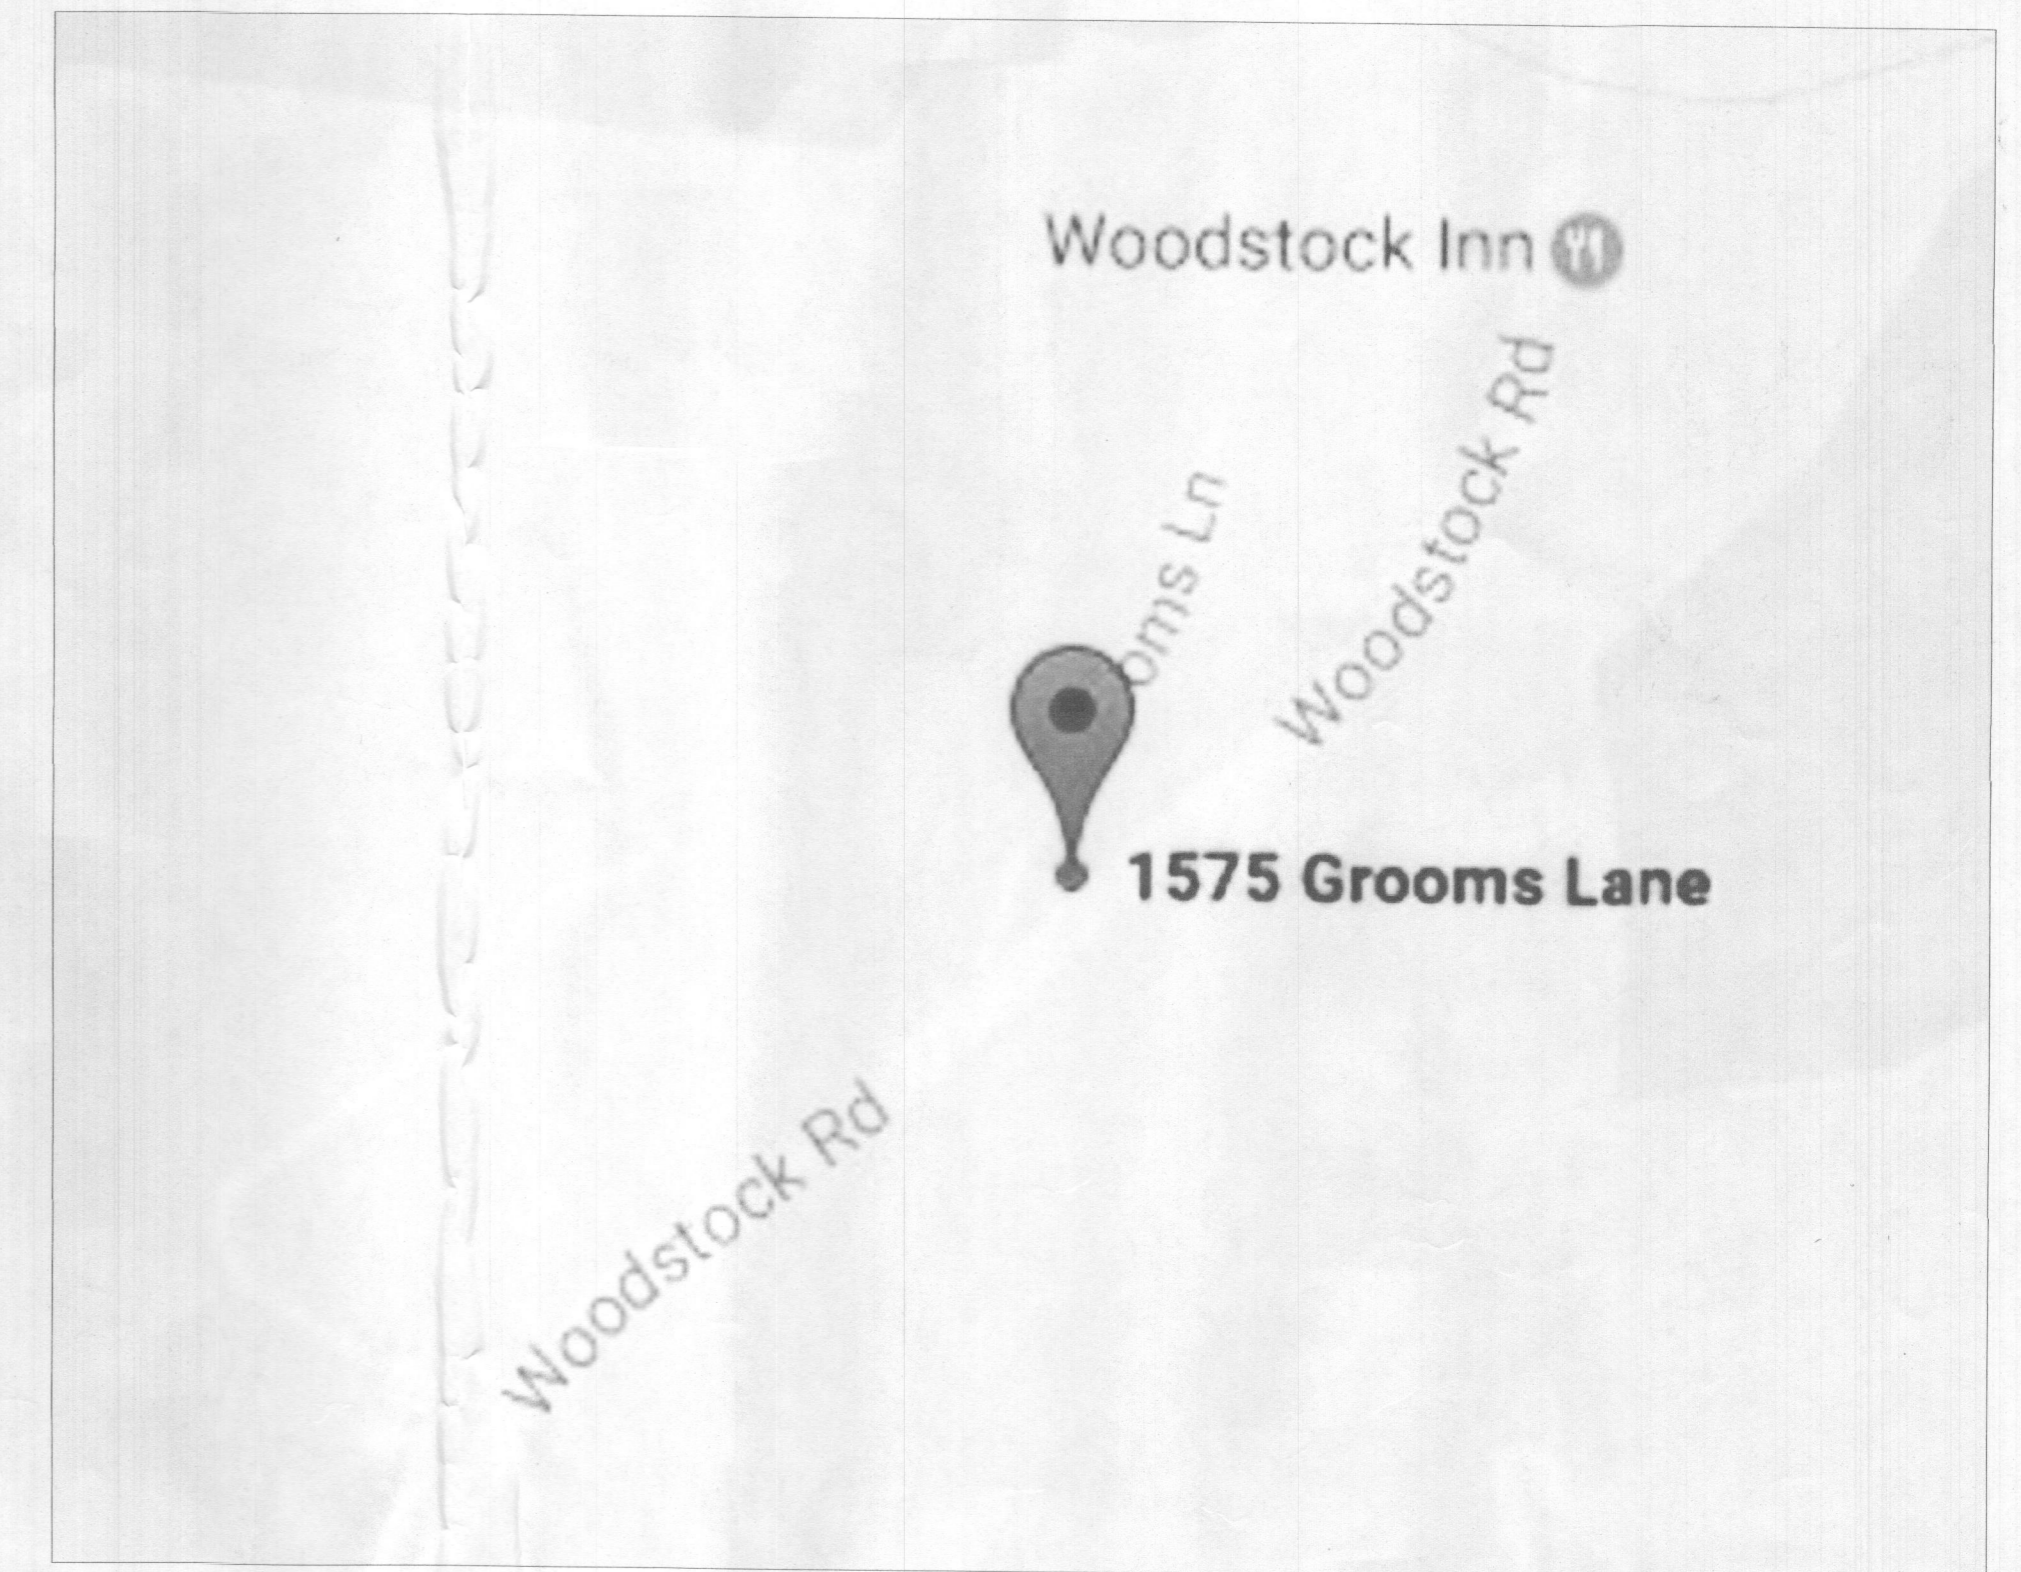

APPLICABLE CODES

BUILDING CODES

Building Code -
2015 International Building Code - Adopted / Amended by Howard County
(Effective Date: June 9, 2015)

One & Two Family Dwelling Code -
2015 International Residential Code - Adopted / Amended by Howard County
(Effective Date: June 9, 2015)

Mechanical Code -
2015 International Mechanical Code - Adopted / Amended by Howard County
(Effective Date: June 9, 2015)

Energy Code -
2015 International Energy Conservation Code - Adopted / Amended by Howard County
(Effective Date: June 9, 2015)

Life Safety -
The Life Safety Code - 2015 Edition - Adopted / Amended by Howard County
(Effective Date: June 9, 2015)

Plumbing Code -
2009 National Standard Plumbing Code - Adopted / Amended by Howard County
(Effective Date: May 4, 2010)

Electrical Code -
2014 National Electric Code with Local Amendments (NFPA 70) as Adopted by Howard County
(Effective Date: June 9, 2015)

Fuel Gas -
2009 National Fuel Gas Code (NFPA 54) - Adopted / Amended by Howard County
(Effective Date: May 4, 2010)

Property Maintenance -
2006 International Property Maintenance Code - Adopted / Amended by Howard County
(Effective Date: January 2, 2007)

PROPERTY INFORMATION:
1575 GROOMS LANE
MAP - 0011
GRID - 0013
PARCEL - 0012
SUBDIVISION - 0000
BLOCK -
LOT -
PLAT No. -
LEGAL DES - 1.044 ACRES
1575 GROOMS LN - WOODSTOCK
PRIMARY STRUCTURE BUILT - 1920
PROPERTY LANE AREA - 1.0400 AC
DEED REFERENCE - 18880 / 00148

DRAWING INDEX

- C1 COVER SHEET
- C2 SITE PLAN

SCOPE OF WORK

- ABANDON EXISTING SEPTIC TANKS AND EXISTING SEWER LINES FROM HOUSE TO TANKS.
- CLOSE EXISTING WELL INSIDE THE HOUSE.
- DRILL NEW WELL ON FRONT SIDE OF THE HOUSE.
- INSTALL NEW ONE SEPTIC TANK AND TWO HOLDING TANKS WITH NEW SEWER LINES FORM HOUSE TO TANKS.


KEY PLAN

SCALE: 1" = 500'-0"

Approved Septic System Plan
Howard County Health Department
Signature: [Signature] Date: 4/12/17

**Tank locations may need to move to achieve >1% fall and <3' max earth cover over tanks.*

House + well locations not accurate

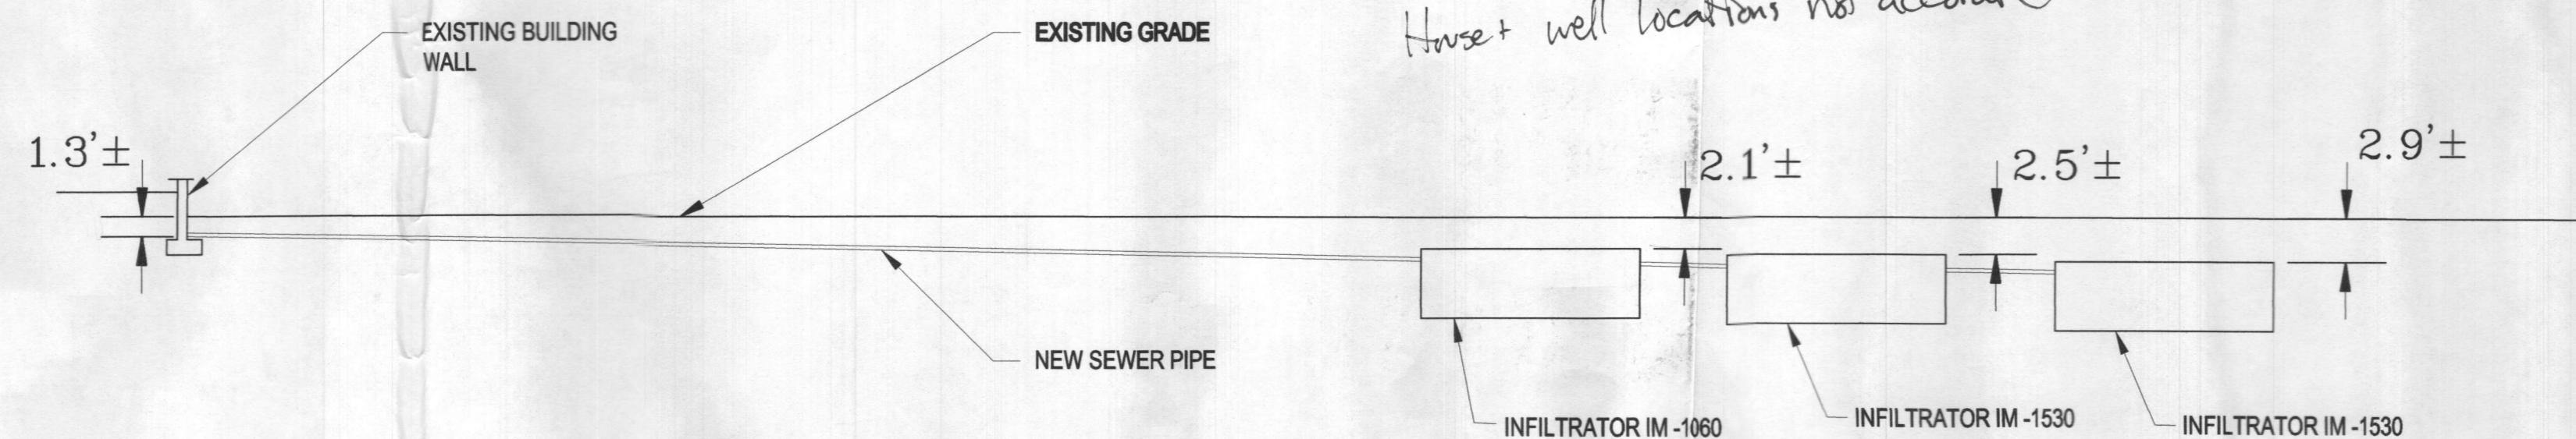

HYDRAULIC PROFILE

SCALE: 1" = 10'-0"

PROFESSIONAL CERTIFICATION.

I HEREBY CERTIFY THAT THESE DOCUMENTS WERE PREPARED OR APPROVED BY ME, AND THAT I AM DULY LICENSED ENGINEER UNDER THE LAWS OF THE STATE OF MARYLAND, LICENSE NUMBER 23081, EXPIRATION DATE: 04/2017



	INITIALS	DATE	1575 GROOMS LANE WOODSTOCK MD 21163 PARCEL: 0012 DISTRICT 03, Ac No.: 286487 HOWARD COUNTY, MD MY HOME PLUS LLC PHONE NO: 443-465-8027	C1
DRAWN	SP	02-02-17		
DESIGN	VD	02-02-17		
CHECKER	PP	02-02-17		
A-E MANAGER	AA	02-02-17		
			COVER SHEET	
			ARENCO, LLC	
			ARCHITECTURAL ENGINEERING CONSULTANTS 526 RAMBLING SUNSET CIRCLE, MOUNT AIRY, MARYLAND 21771 240-418-1389 prafulp@arenco-llc.com	
CM			SCALE AS SHOWN	
PM			WORK REQUEST # 16-247	SHEET 01 OF 02 DRAWING NO. 16-247-01