
 WATER WELL ABANDONMENT SEALING REPORT FORM

SUBMIT COPIES OF COMPLETED FORM TO:

- * COUNTY ENVIRONMENTAL AGENCY (contact MDE, WMA if address needed)
- * WELL OWNER
- * MDE, WATER MANAGEMENT ADMINISTRATION, WELL PROGRAM

Handwritten initials and date: 11/12/22

DATE WELL ABANDONED: NOVEMBER 4, 2022 (month/day/year)

* PERMIT NUMBER OF ABANDONED WELL (if any) _____

* PERMIT NUMBER OF REPLACEMENT WELL: _____

* PERSON ABANDONING WELL: FRANK SUGLTON


WELL DRILLER'S LICENSE NUMBER: WRD 046

CIRCLE: MWD / MSD / MGD

* OWNER'S NAME: LYLE RESCOTT

SITE LOCATION MAP

* WELL LOCATION:
 COUNTY: HOWARD
 NEAREST TOWN: MARRIOTTSVILLE
 TAX MAP _____ BLOCK _____ PARCEL _____
 SUBDIVISION: _____
 SECTION: _____ LOT: _____
 STREET ADDRESS: 1945 MAINT VIEW RD

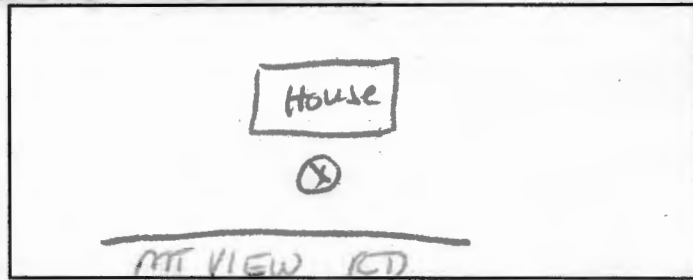

Well 1 of 2
 LATITUDE 39.317788
 LONGITUDE 76.940039

LOG OF SEALING MATERIAL

* TYPE OF WELL BEING ABANDONED:
 DRILLED _____ JETTED _____
 BORED _____ HAND DUG _____
 OTHER (specify) _____

MATERIAL	FEET	
	FROM	TO
GRAVEL	400	102
BENTONITE	102	1
DIRT	1	0

* USE CODE:
 DOMESTIC _____ MUNICIPAL/PUBLIC _____
 IRRIGATION _____ INDUSTRIAL _____
 TEST/OBSERVATION _____ GEOTHERMAL _____

VOLUME OF MATERIAL USED
250 # Bentonite 1.5 Tons Gravel

* TYPE OF CASING:
 STEEL _____ PLASTIC _____
 CONCRETE _____ OTHER (specify) _____

SIZE OF CASING: 6 INCHES IN DIAMETER

DEPTH OF WELL: 400 FEET DEEP

WAS ANY CASING REMOVED? YES NO

If yes, length removed, in feet: 3

WAS CASING RIPPED OR PERFORATED? _____ YES NO

SIGNATURE: George F. Easterday LICENSE# 040

Pursuant to § 10-624 of the State Govt. Article of the Maryland Code, personal info requested on this form is used in processing this form pursuant to COMAR 26.04.04. Failure to provide the info may result in this form not being processed. You have the right to inspect, amend, or correct this form. The Maryland Department of the Environment is subject to the Maryland Public Information Act. This form may be made available on the Internet via MDE's website and is subject to inspection or copying, in whole or in part, by the public and other governmental agencies, if not protected by federal or State Law.

MWD / MSD / MGS 11-11-22
 CIRCLE ONE DATE

WATER WELL ABANDONMENT-SEALING REPORT FORM

APR 4/17/0

SUBMIT COPIES OF COMPLETED FORM TO:

- * COUNTY ENVIRONMENTAL AGENCY (contact MDE, WMA if address needed)
- * WELL OWNER
- * MDE, WATER MANAGEMENT ADMINISTRATION, WELL PROGRAM

DATE WELL ABANDONED: NOVEMBER 4 2022 (month/day/year)

* PERMIT NUMBER OF ABANDONED WELL (if any) _____

* PERMIT NUMBER OF REPLACEMENT WELL: _____

* PERSON ABANDONING WELL: FRANK SINGLETON


WELL DRILLER'S LICENSE NUMBER: WPD 046

CIRCLE: MWD / MSD / MGD

* OWNER'S NAME: LYLE RESCOTT

SITE LOCATION MAP

* WELL LOCATION:
 COUNTY: HOWARD
 NEAREST TOWN: MARRIOTTSVILLE
 TAX MAP _____ BLOCK _____ PARCEL _____
 SUBDIVISION: _____

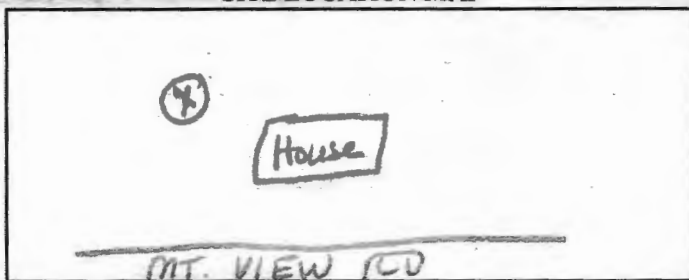

SECTION: _____ LOT: _____

STREET ADDRESS: 1945 MOUNT VIEW RD

Well 2 of 2

LATITUDE 39.318198

LONGITUDE 76.940002

LOG OF SEALING MATERIAL

MATERIAL	FEET	
	FROM	TO
GRAVEL	320	137
BENTONITE	137	1
DIRT	1	0

VOLUME OF MATERIAL USED

300# Bentonite 1 ton Gravel

* TYPE OF WELL BEING ABANDONED:

- DRILLED _____ JETTED _____
- _____ BORED _____ HAND DUG _____
- _____ OTHER (specify) _____

* USE CODE:

- DOMESTIC _____ MUNICIPAL/PUBLIC _____
- _____ IRRIGATION _____ INDUSTRIAL _____
- _____ TEST/OBSERVATION _____ GEOTHERMAL _____

* TYPE OF CASING:

- STEEL _____ PLASTIC _____
- _____ CONCRETE _____ OTHER (specify) _____

SIZE OF CASING: 6 INCHES IN DIAMETER

DEPTH OF WELL: 320 FEET DEEP

WAS ANY CASING REMOVED? YES NO

If yes, length removed, in feet: 3

WAS CASING RIPPED OR PERFORATED? _____ YES NO

SIGNATURE-MASTER WELL DRILLER OR SUPERVISING SANITARIAN LICENSE# George F. Easton 040

CIRCLE ONE MWD / MSD / MGS DATE 11-11-23

Pursuant to § 10-624 of the State Govt. Article of the Maryland Code, personal info requested on this form is used in processing this form pursuant to COMAR 26.04.04. Failure to provide the info may result in this form not being processed. You have the right to inspect, amend, or correct this form. The Maryland Department of the Environment is subject to the Maryland Public Information Act. This form may be made available on the Internet via MDE's website and is subject to inspection or copying, in whole or in part, by the public and other governmental agencies, if not protected by federal or State Law.

