

PERMIT

SEWAGE DISPOSAL SYSTEM

MARYLAND STATE DEPARTMENT OF HEALTH

HOWARD COUNTY
BUREAU OF ENVIRONMENTAL HEALTH
992-2330

INDEXED

ELLICOTT CITY

DISTRICT 5th

DATE 5/3/85

P 35402

A 34843

5-16-85
Approved
SAB

5/16/85
2 Dept
A.M. - P.M.

05-383994

United General Contractors

IS PERMITTED TO INSTALL X ALTER

ADDRESS _____ PHONE 854-6561

SUBDIVISION Allnutt Farms II ROAD 13455 Allnutt Lane LOT 11

PROPERTY OWNER ~~Frank & Kathleen Caviak~~ Harvard

ADDRESS _____

IF GARBAGE GRINDER IS USED INCREASE SEPTIC TANK CAPACITY BY 50% AND ABSORPTION AREA BY 22%.

GARBAGE GRINDER? YES _____ NO X

SEPTIC TANK CAPACITY 1250 GALLONS NUMBER OF BEDROOMS 4

TRENCHES - 180 sq. ft. per bedroom. Trench to be 2 feet wide. Inlet 3 feet below original grade. Effective area begins at 3 feet below original grade. 6 feet of stone below distribution pipe. LOCATION: Start first trench 125 feet from the front lot line and 90 feet from the left lot line as seen when facing the property from Allnutt Lane. Run Trench(s) along level ground in either direction. NOTE: No trench to exceed 100 feet in length. If more than one trench used, a distribution box is required. Call for inspection of trench(s) before and after gravel is installed. Provide 6" - 8" diameter cleanout and cap to grade or above on septic tank.

PLANS APPROVED BY 5 C. Williams DATE 5/6/85

COVER NO WORK UNTIL INSPECTED AND APPROVED.

NEITHER THE HOWARD COUNTY COUNCIL NOR THE HEALTH DEPARTMENT IS RESPONSIBLE FOR THE SUCCESSFUL OPERATION OF ANY SYSTEM.

NOTE: IF TRENCH IS USED CALL FOR INSPECTION BEFORE AND AFTER PLACING GRAVEL IN TRENCH.

NOTE: NO DRY WELL SHALL EXCEED 15 FOOT IN DIAMETER. NO ABSORPTION TRENCH TO EXCEED 100 FEET IN LENGTH.

NOTE: ALL PIPE FROM HOUSE TO SEPTIC TANK MUST BE CAST IRON OR SCHEDULE 40 PVC OR ABS.

PERMIT VOID AFTER THREE YEARS.


NOTE: INSTALL STAND PIPE ON SEPTIC TANK AND DRY WELL. STAND PIPES MUST BE 6 INCHES IN DIAMETER CAST IRON, CONCRETE OR TERRA COTTA, OR PVC OR ABS ACCEPTED. IF TOP OF SEPTIC TANK IS DEEPER THAN 3 FEET MANHOLE TO GRADE REQUIRED.

***INSTALLER IS RESPONSIBLE FOR OBTAINING FINAL APPROVAL ON THIS PERMIT**

*CALL 992-2330 FOR INSPECTION OF SEPTIC SYSTEMS.

EH - 2-1082

A 34843

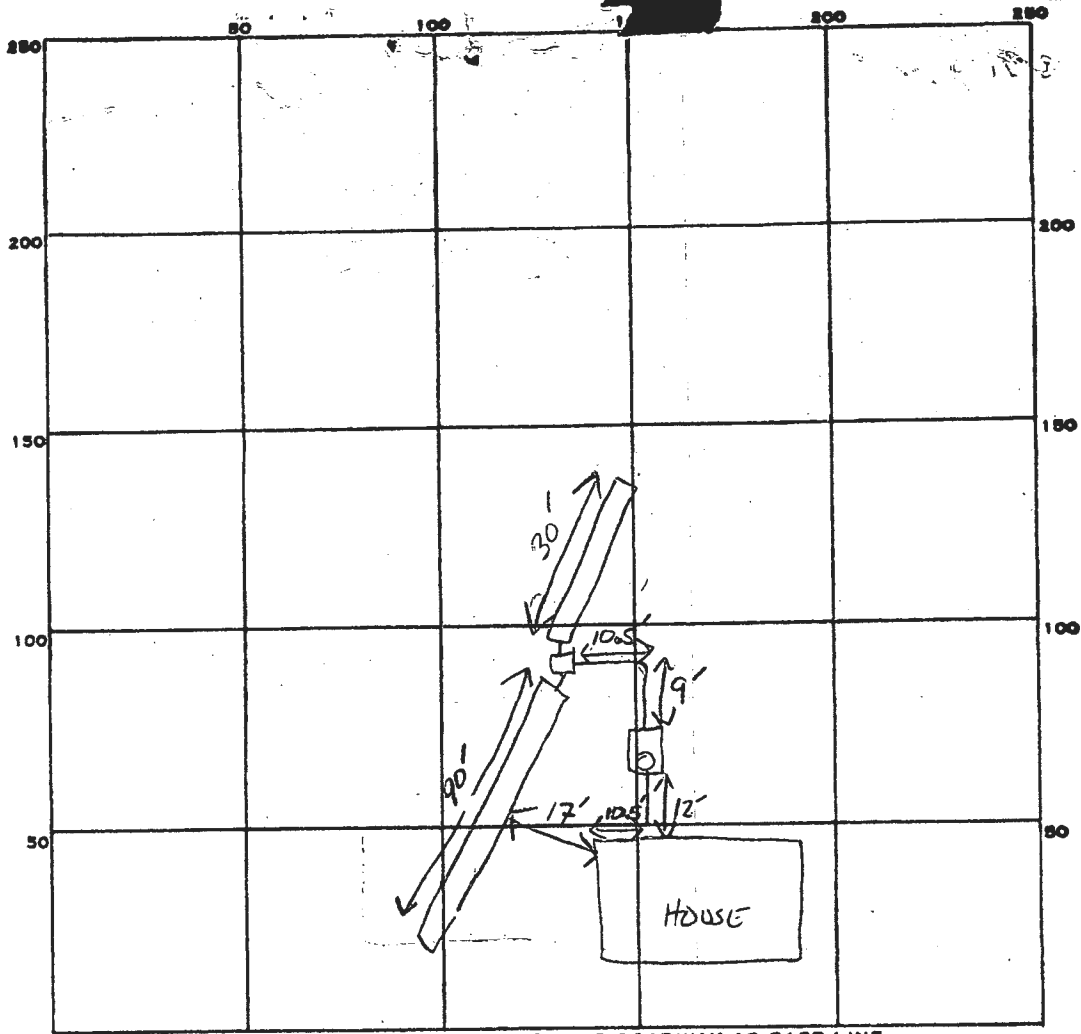

INDICATE NORTH. - NAME ADJOINING ROADWAY AS BASE LINE.

ALLIOTT LA.

380
 4
 720
 120
 720
 6
 12

PERMIT CARD

SEPTIC TANK, LEVEL 1500 GAL

CLEANOUTS 1ST

DISTRIBUTION BOX, LEVEL

TILE FIELD, DEPTH 9' FT. TRENCH WIDTH 2' FT. INLET 3'

GRAVEL DEPTH 6 FT TOTAL LENGTH #1 30" #2 90 FT. TOTAL = 120

NUMBER OF TRENCHES 2 TOTAL BOTTOM AREA 720

120
 6
 720

SEEPAGE PITS, INSIDE DIAMETER FT. DEPTH BELOW INLET FT.

ABSORBENT AREA 720 SQ. FT.

REMARKS 5-16-85 OK TO COVER 1ST TRENCH + ADD STONE TO #2 AS WORK CONTINUES, STAY