

APPLICATION

A _____

P _____

SEWAGE DISPOSAL TESTING

STATE OF MARYLAND - DEPARTMENT OF HEALTH AND MENTAL HYGIENE

HOWARD COUNTY HEALTH DEPARTMENT
ENVIRONMENTAL HEALTH SERVICES
P. O. BOX 476, ELLICOTT CITY, MARYLAND 21043
TELEPHONE: 465-5000, EXT. 356

DISTRICT Fifth

DATE 9/9/76

TO: THE COUNTY HEALTH OFFICER
ELLICOTT CITY, MARYLAND

I, HEREBY, APPLY FOR THE NECESSARY TEST IN ORDER TO CONSTRUCT (OR RECONSTRUCT) A SEWAGE DISPOSAL SYSTEM.

PROPERTY OWNER Mr. and Mrs. Smith W. Allnutt, Jr.

ADDRESS 13288 Highland Road
Highland, Maryland 20777 PHONE 988-9303

PROPERTY LOCATION:

SUBDIVISION H1 - Land Farm Estates LOT NO. 112

ROAD AND DESCRIPTION Road A

SIZE OF LOT 0.99 Ac TYPE BLDG. 3 or 4 bedroom
NUMBER OF BEDROOMS

IF NOT SINGLE RESIDENCE DESCRIBE _____

THE SYSTEM INSTALLED UNDER THIS APPLICATION IS ACCEPTABLE ONLY UNTIL PUBLIC FACILITIES BECOME AVAILABLE.

SIGNATURE OF APPLICANT /s/ Margaret G. Allnutt


APPROVED BY _____ FOR _____ DATE _____
(KIND OF SYSTEM)

REJECTED BY _____ FOR _____ DATE _____
(KIND OF SYSTEM)

HOLD PENDING FURTHER TESTS _____ DATE _____

REASONS FOR REJECTION OR HOLDING _____

THIS IS NOT A PERMIT

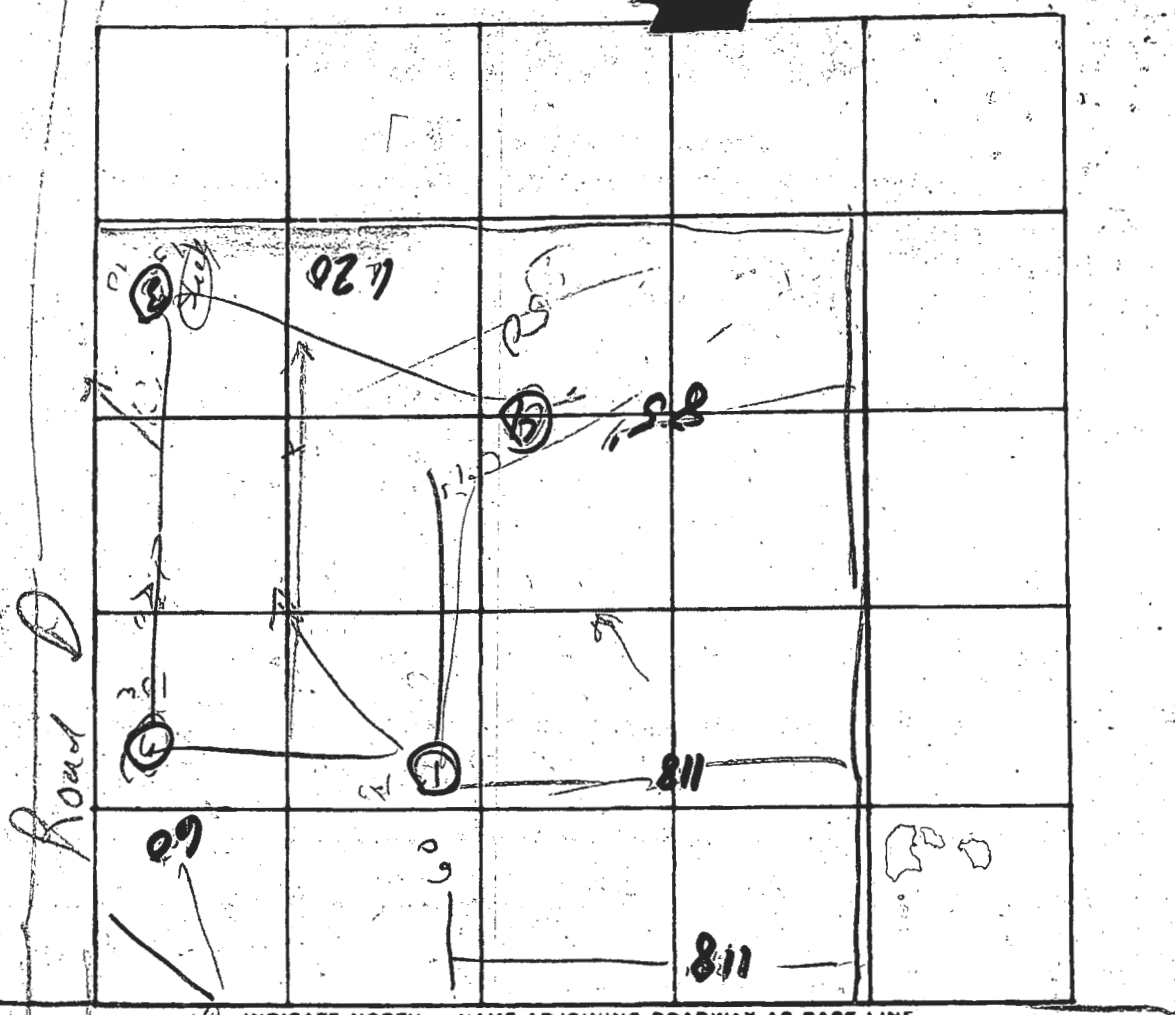

INDICATE NORTH. - NAME ADJOINING ROADWAY AS BASE LINE.

①
Clay 5
Sand 13
②
Clay 8
Sand 13
③
Clay 5
Clay Sand 5
Sand 13

④
Clay 5
Sandy 12

DATE	TEST NO.	DEPTH	PRE-WET		TEST - 1" DROP		TIME
			START	STOP	START	STOP	
10/6/40	3s	4'	200	F ₂ 4			
	d	13'	204	205	205	206	1
	10	5	1410	1412	1412	1414	2
	d	13	1410	1411	1411	1414	3
	2s	7	1415	1421	1421	1427	6
	2d	15	1415	1416	1416	1420	4
	4	12	Visual				
	3s	5'	249			250	1

REMARKS Generally sandier and consistent clay
 TYPE OF SOIL thick in spots
 TESTED BY Prof R. Bergap ALSO PRESENT: Kellerman