


<p>A DESIGN BY</p> <p>MCWHORTER CONSTRUCTION</p> <p>DESIGN • BUILD • REMODEL</p> <p>ALLEN@MCWHORTERCONSTRUCTION.NET</p> <p>(407) 947-9933</p>	<p>Title 2ND FLOOR PLAN</p>		<p><small>DRAWINGS, RENDERINGS, PHOTOS OR ANY OTHER VISUAL DOCUMENTS PROVIDED BY MCWHORTER OUTDOOR LIVING TO THE HOMEOWNER ARE NOT INTENDED TO REPRESENT THE DETAILS OF THE ACTUAL FINISHED PRODUCT. DRAWINGS ARE FOR CONCEPTUAL USE ONLY. ROOF PITCHES, GRADERS (BOTH EXISTING AND PROPOSED), COLORS AND ALL OTHER FINISHES AND DETAILS ARE NOT TO BE CONSIDERED EXACT IN THE RENDERINGS AND ARE SUBJECT TO CHANGE.</small></p> <p><small>DRAWINGS, RENDERINGS AND PHOTOS ARE THE PROPERTY OF MCWHORTER OUTDOOR LIVING AND CANNOT BE REPRODUCED OR USED IN ANY WAY WITHOUT THE WRITTEN CONSENT OF MCWHORTER OUTDOOR LIVING LLC.</small></p>
	<p>View</p>	<p>Drawn By</p>	
<p>Scale</p>			

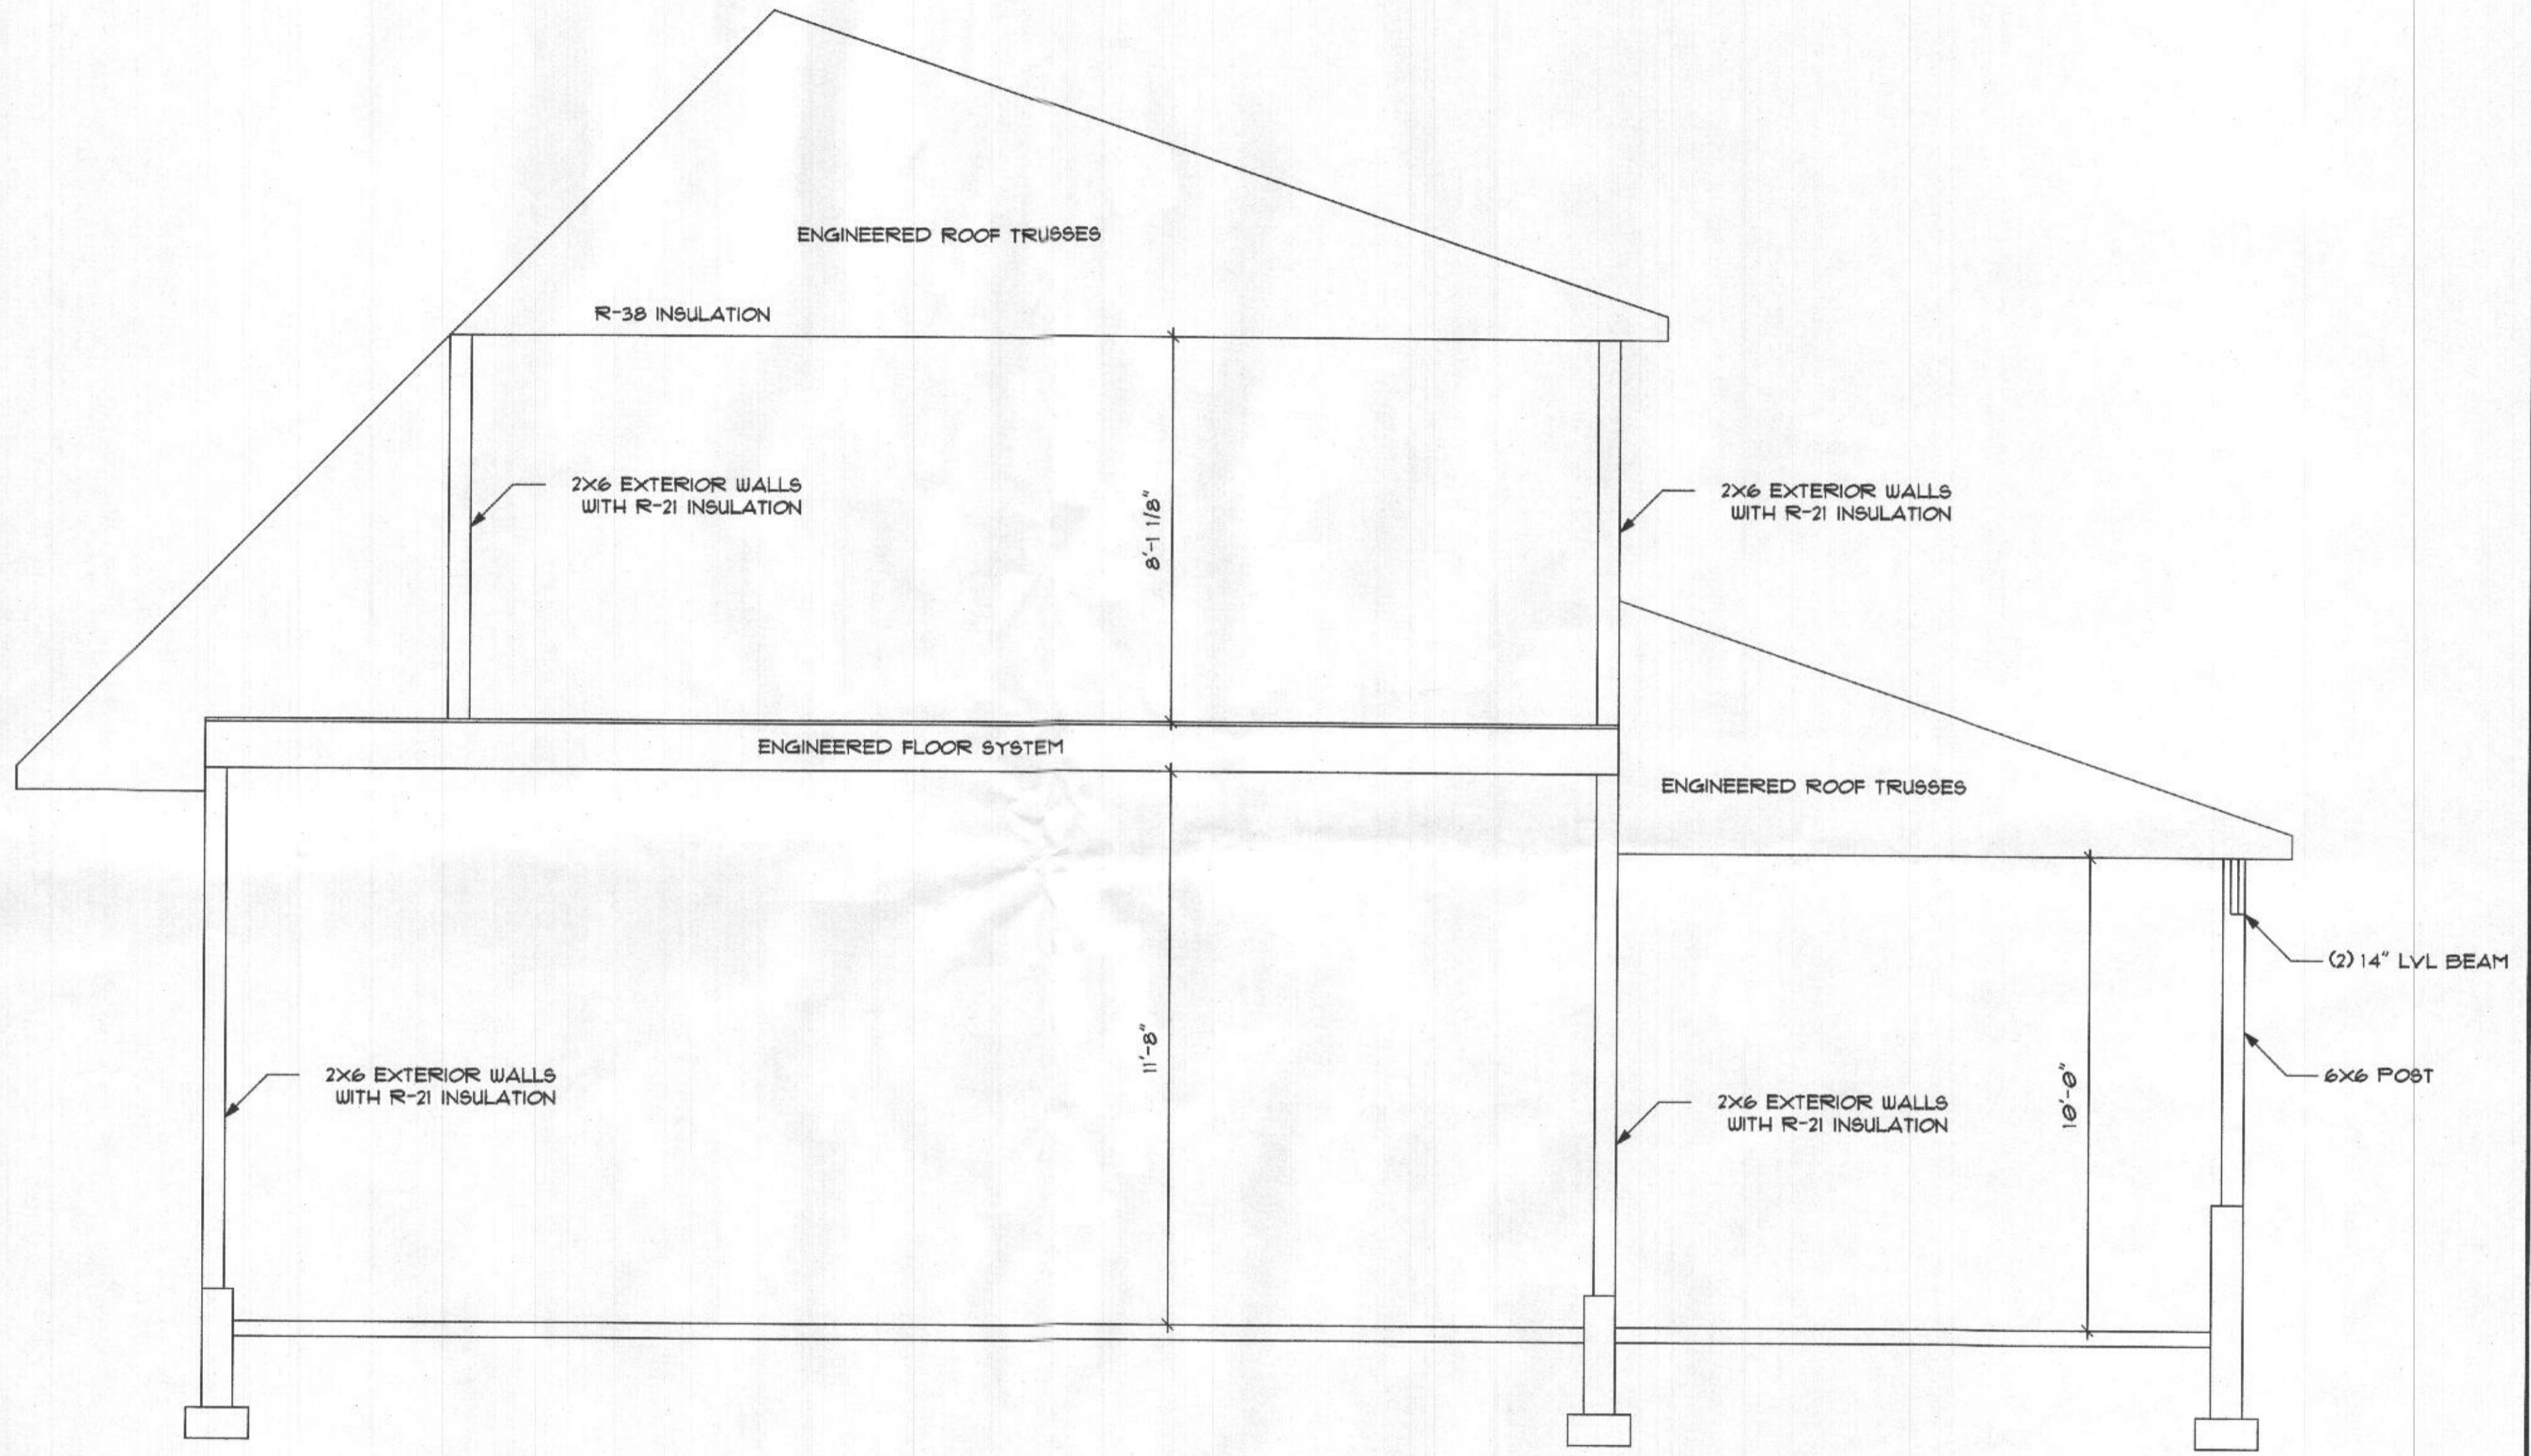

A DESIGN BY

MCWHORTER
 CONSTRUCTION
 design • build • remodel
 SALEM@MCWHORTERCONSTRUCTION.NET
 (503) 584-5843


SECTION VIEW

View: _____ Drawn By: _____ Date: _____

Scale: _____


DRAWINGS, RENDERINGS, PHOTOS OR ANY OTHER VISUAL DOCUMENTS PROVIDED BY MCWHORTER OUTDOOR TO THE HOMEOWNER ARE NOT INTENDED TO REPRESENT THE DETAILS OF THE ACTUAL FINISHED PRODUCT. DRAWINGS ARE FOR CONCEPTUAL USE ONLY. ROOF PITCHES, GRADES (SLOPE), FINISHES AND PROPOSED COLORS AND ALL OTHER FINISHES AND DETAILS ARE NOT TO BE CONSIDERED EXACT IN THE RENDERINGS AND ARE SUBJECT TO CHANGE.

DRAWINGS, RENDERINGS AND PHOTOS ARE THE PROPERTY OF MCWHORTER OUTDOOR LIVING AND CANNOT BE REPRODUCED OR USED IN ANY WAY WITHOUT THE WRITTEN CONSENT OF MCWHORTER OUTDOOR LIVING LLC.

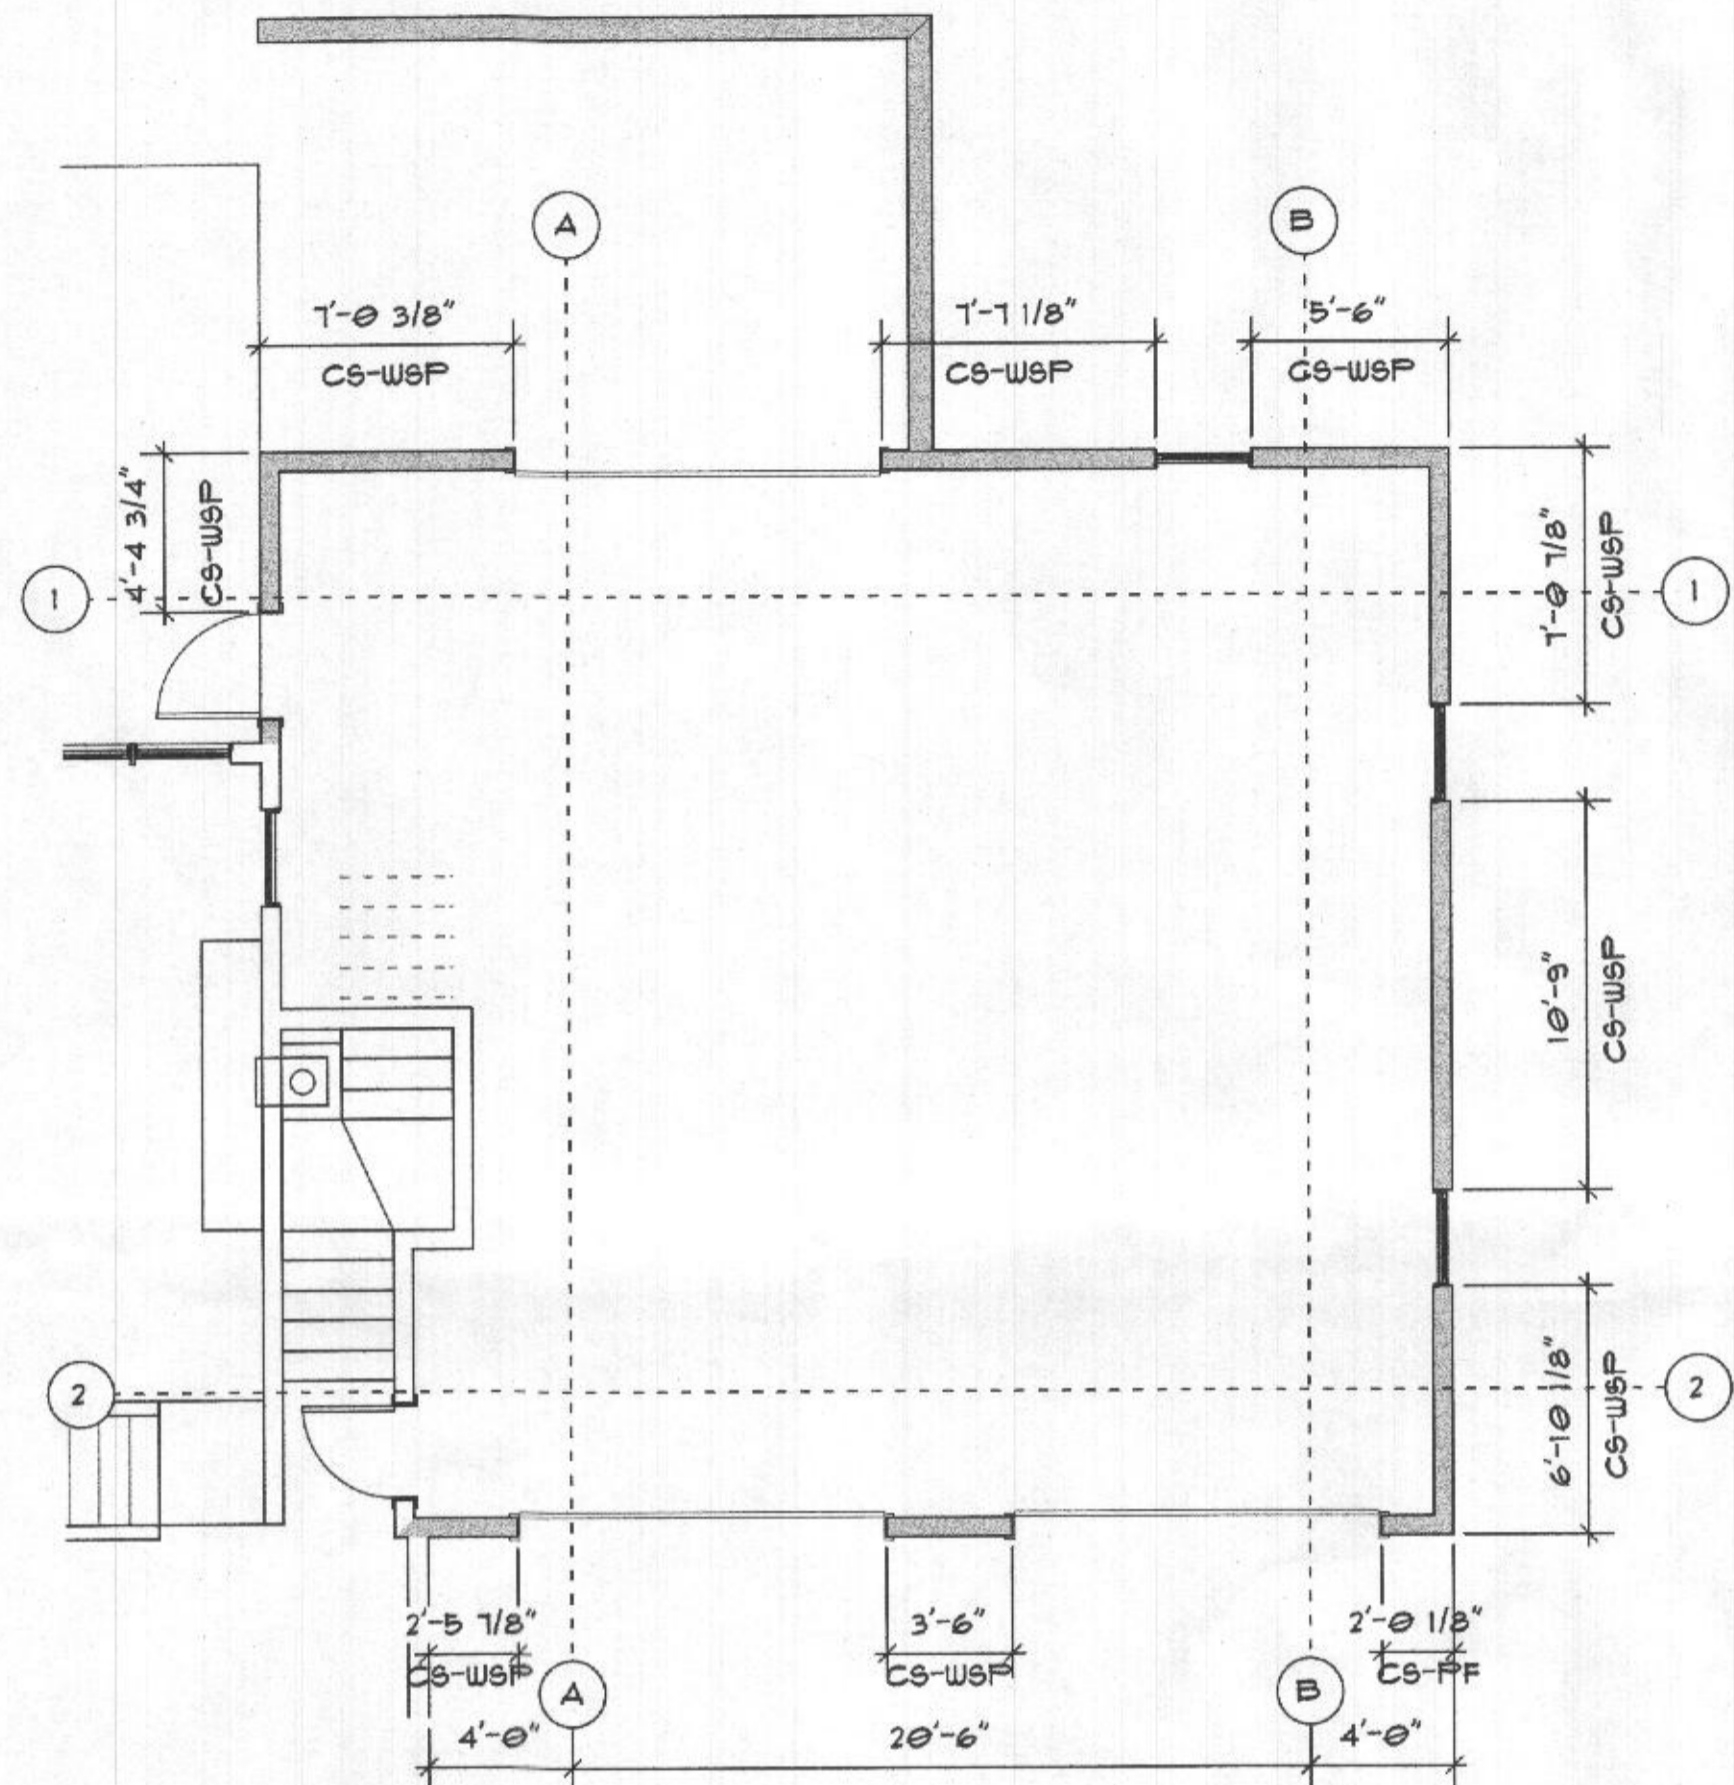

FIRST FLOOR CALCULATIONS

BRACED WALL LINE	WALL PANEL TYPE	NET REQUIRED WALL BRACING FT.	ACTUAL PROVIDED WALL BRACING FT.
A	CS-WSP	2.88'	4.08'
B	CS-WSP	4.12'	12.50'
1	CS-WSP	4.55'	6.67'
2	CS-WSP	4.55'	6.00'

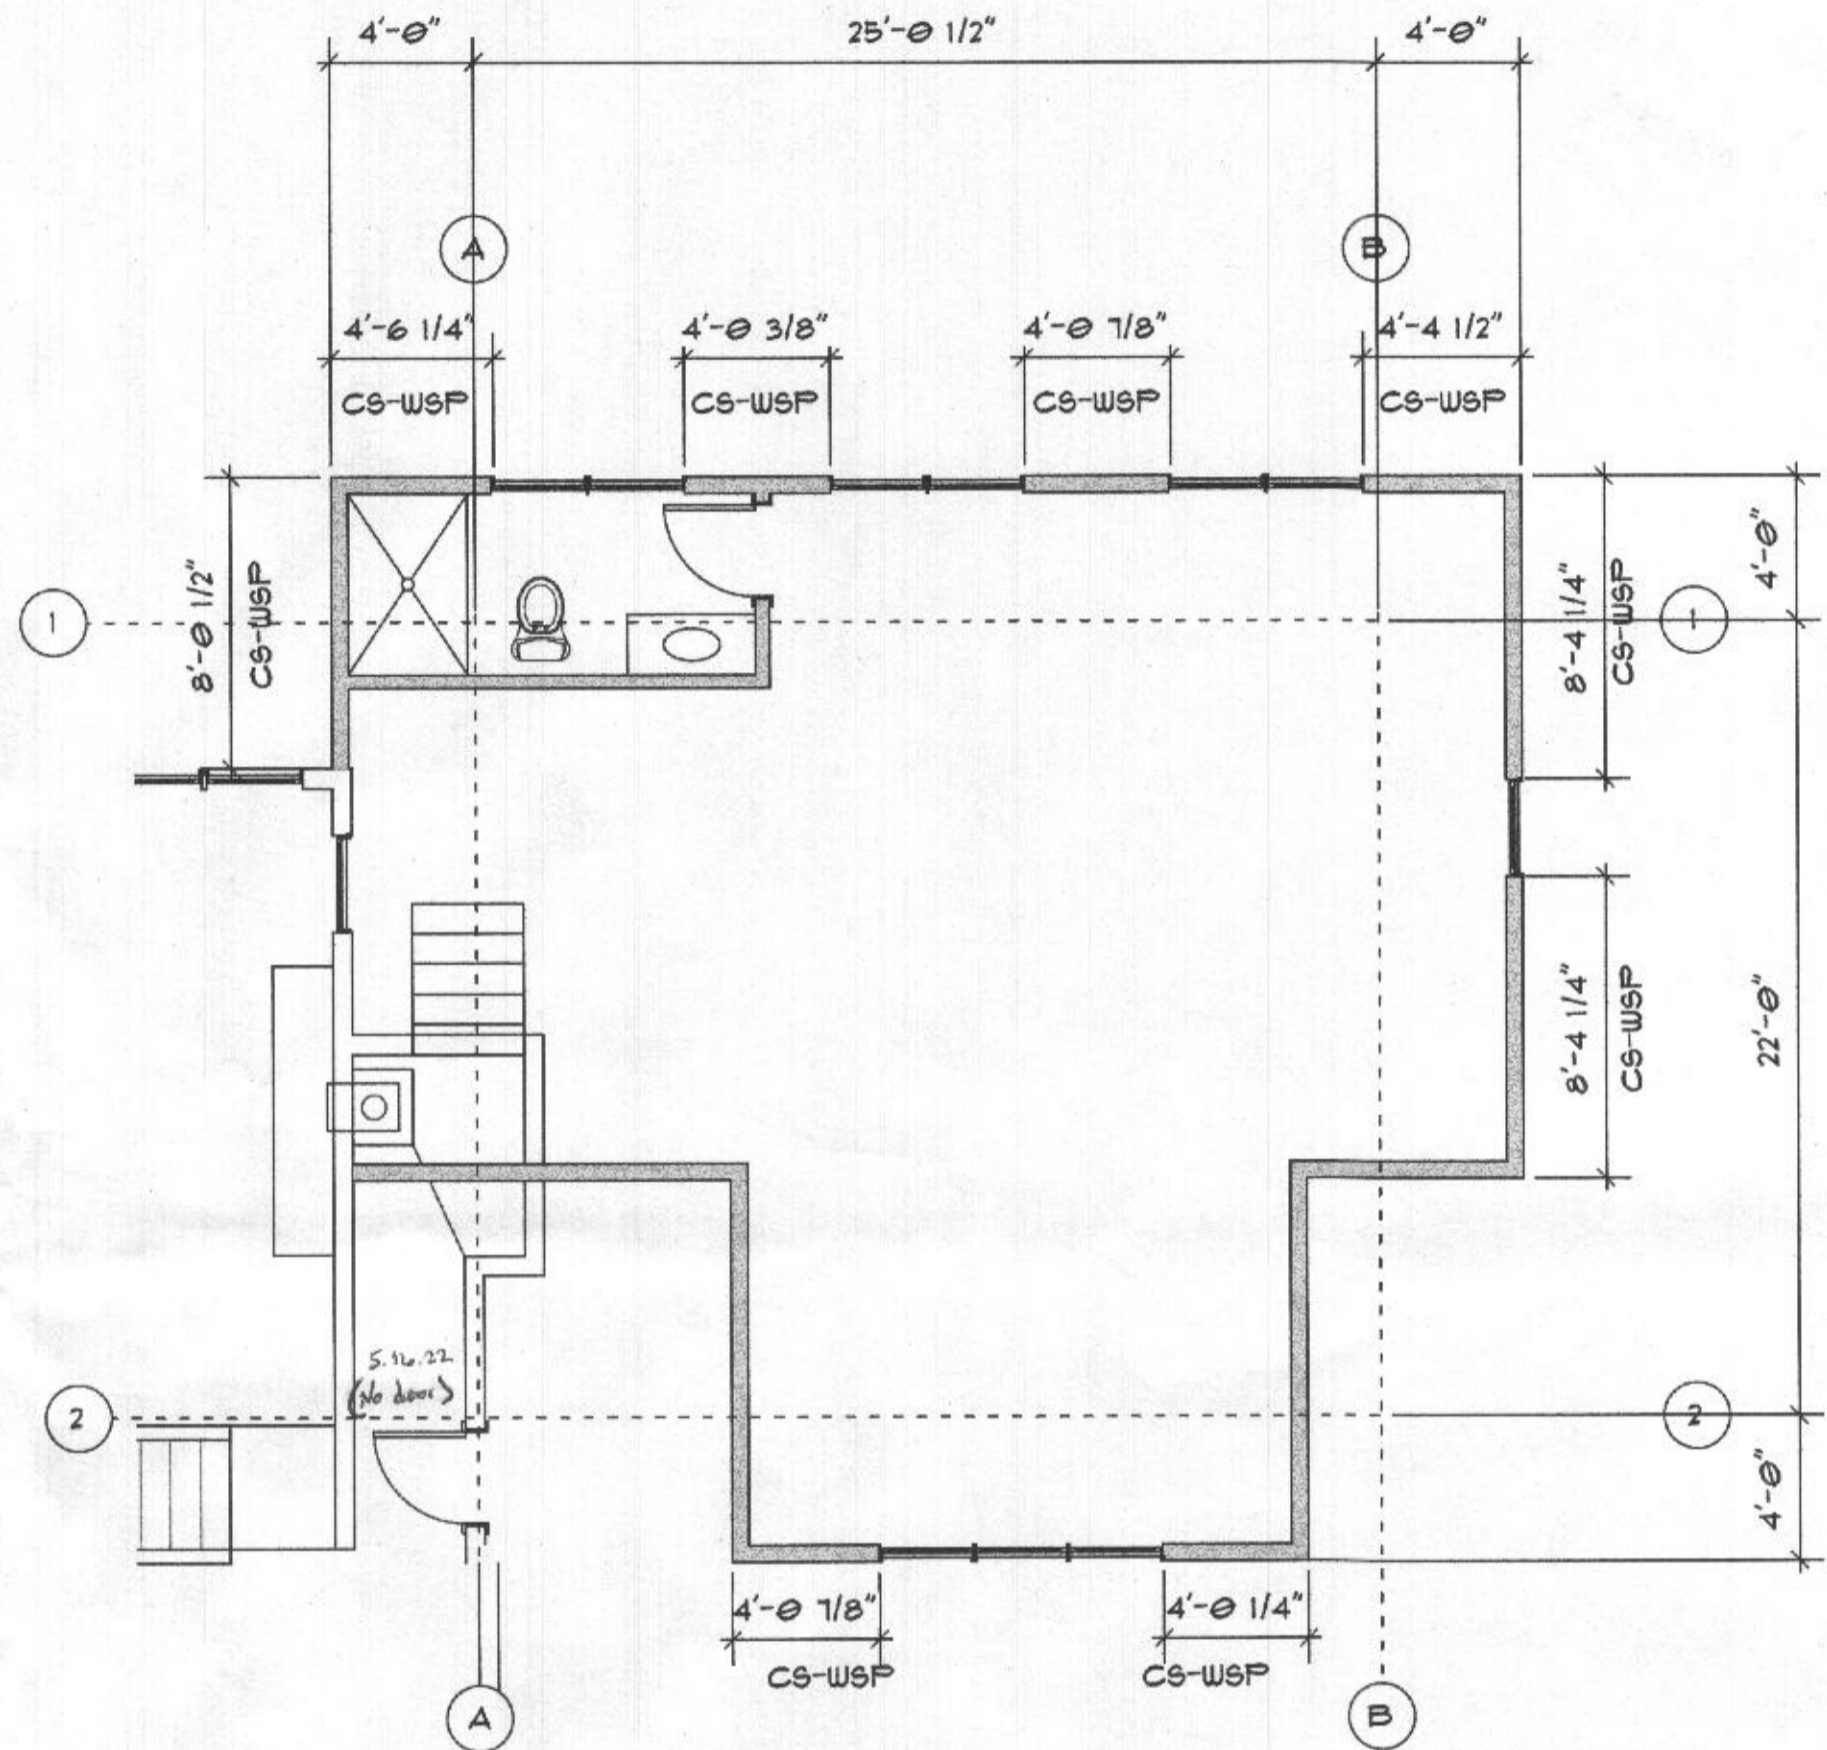

SECOND FLOOR CALCULATIONS

BRACED WALL LINE	WALL PANEL TYPE	NET REQUIRED WALL BRACING FT.	ACTUAL PROVIDED WALL BRACING FT.
A	CS-WSP	3.65'	14.00'
B	CS-WSP	4.12'	12.50'
1	CS-WSP	4.21'	7.83'
2	CS-WSP	4.21'	7.83'

A DESIGN BY

MCWHORTER CONSTRUCTION
 design • build • remodel
 345.992.3333
 WWW.MCWHORTERCONSTRUCTION.NET
 (410) 584-9905

Title: **WALL BRACING PLAN**

View: _____ Date: _____

Drawn By: _____

Scale: _____

DRAWINGS, RENDERINGS, PHOTOS OR ANY OTHER VISUAL DOCUMENTS PROVIDED BY MCWHORTER OUTDOOR TO THE HOMEOWNER ARE NOT INTENDED TO REPRESENT THE DETAILS OF THE ACTUAL FINISHED PRODUCT. DRAWINGS ARE FOR CONCEPTUAL USE ONLY. ROOM FINISHES, GRADES (BOTH EXISTING AND PROPOSED), COLORS AND ALL OTHER FINISHES AND DETAILS ARE NOT TO BE CONSIDERED EXACT IN THE RENDERINGS AND ARE SUBJECT TO CHANGE.

DRAWINGS, RENDERINGS AND PHOTOS ARE THE PROPERTY OF MCWHORTER OUTDOOR LIVING AND CANNOT BE REPRODUCED OR USED IN ANY WAY WITHOUT THE WRITTEN CONSENT OF MCWHORTER OUTDOOR LIVING LLC.