

Approved 2/10/84
Stayer
P 33330

PERMIT

SEWAGE DISPOSAL SYSTEM

MARYLAND STATE DEPARTMENT OF HEALTH*

A 32320

HOWARD COUNTY
BUREAU OF ENVIRONMENTAL HEALTH
992-2330

INDEX

ELLICOTT CITY
DISTRICT 5th

DATE Oct 11, 1983

Handwritten notes:
4/11/83
A.M. 10/17/83
as per as per
10/10/83
10:30 H
2/10/84 - A.S.A.P.

05-360781

Robert L. Orndorff

IS PERMITTED TO INSTALL ALTER

ADDRESS 7469 Flamewood Drive, Clarksville, Md. 21029 PHONE 776-0444

SUBDIVISION (Technick) ROAD 7191 Brooks Road - LOT 2
(off Route 108)

PROPERTY OWNER Wayne Sternberger

ADDRESS 7326 Better Hours Court, Columbia, Maryland 21045 Phone: 992-7002

IF GARBAGE GRINDER IS USED INCREASE SEPTIC TANK CAPACITY BY 50% AND ABSORPTION AREA BY 22%.

GARBAGE GRINDER? YES NO

SEPTIC TANK CAPACITY 1000 GALLONS NUMBER OF BEDROOMS 3

DEEP TRENCHES - 158 sq. ft. one sidewall area per bedroom. Ditch is to be 2 ft. wide, 6 ft. deep, with inlet at 3 ft. below original ~~xxxxxx~~ grade and filled with 3 ft. of stone. Length of the ditch depends on the number of sq. ft. needed. Start the ditch at perc hole #11 and run it along level ground toward perc hole #9. Perc hole #11 is located 130 ft. from the back lot line and 40 ft. from the right lot line as seen when facing the lot from Brooks Road. Perc hole #9 is located 130 ft. from the back lot line and 90 ft. from the right lot line as seen when facing the lot from Brooks Road. The back lot line is the 140.77 ft. lot line.

BUILDING PERMIT SIGNED AND RETURNED

BLDG. PERMIT SIGNED AND RETURNED

BLDG. PERMIT SIGNED AND RETURNED

102905-80044669-46 PROpane TANK

800124655
6/13/2000

8/29/99

ENLARGE MASTER BEDROOM

Serial # 56056
2 Story Addition

PLANS APPROVED BY Raymond Hodges DATE 1/10/83

COVER NO WORK UNTIL INSPECTED AND APPROVED.

NEITHER THE HOWARD COUNTY COUNCIL NOR THE HEALTH DEPARTMENT IS RESPONSIBLE FOR THE SUCCESSFUL OPERATION OF ANY SYSTEM.

NOTE: IF TRENCH IS USED CALL FOR INSPECTION BEFORE AND AFTER PLACING GRAVEL IN TRENCH.

NOTE: NO DRY WELL SHALL EXCEED 15 FOOT IN DIAMETER. NO ABSORPTION TRENCH TO EXCEED 100 FEET IN LENGTH.

NOTE: ALL PIPE FROM HOUSE TO SEPTIC TANK MUST BE CAST IRON OR SCHEDULE 40 PVC OR ABS.

PERMIT VOID AFTER THREE YEARS.


NOTE: INSTALL STAND PIPE ON SEPTIC TANK AND DRY WELL. STAND PIPES MUST BE 6 INCHES IN DIAMETER. CAST IRON, CONCRETE OR TERRA COTTA, OR PVC OR ABS ACCEPTED. IF TOP OF SEPTIC TANK IS DEEPER THAN 3 FEET MANHOLE TO GRADE REQUIRED.

***INSTALLER IS RESPONSIBLE FOR OBTAINING FINAL APPROVAL ON THIS PERMIT**

*CALL 992-2330 FOR INSPECTION OF SEPTIC SYSTEMS.

EH - 2-1082

A 32320

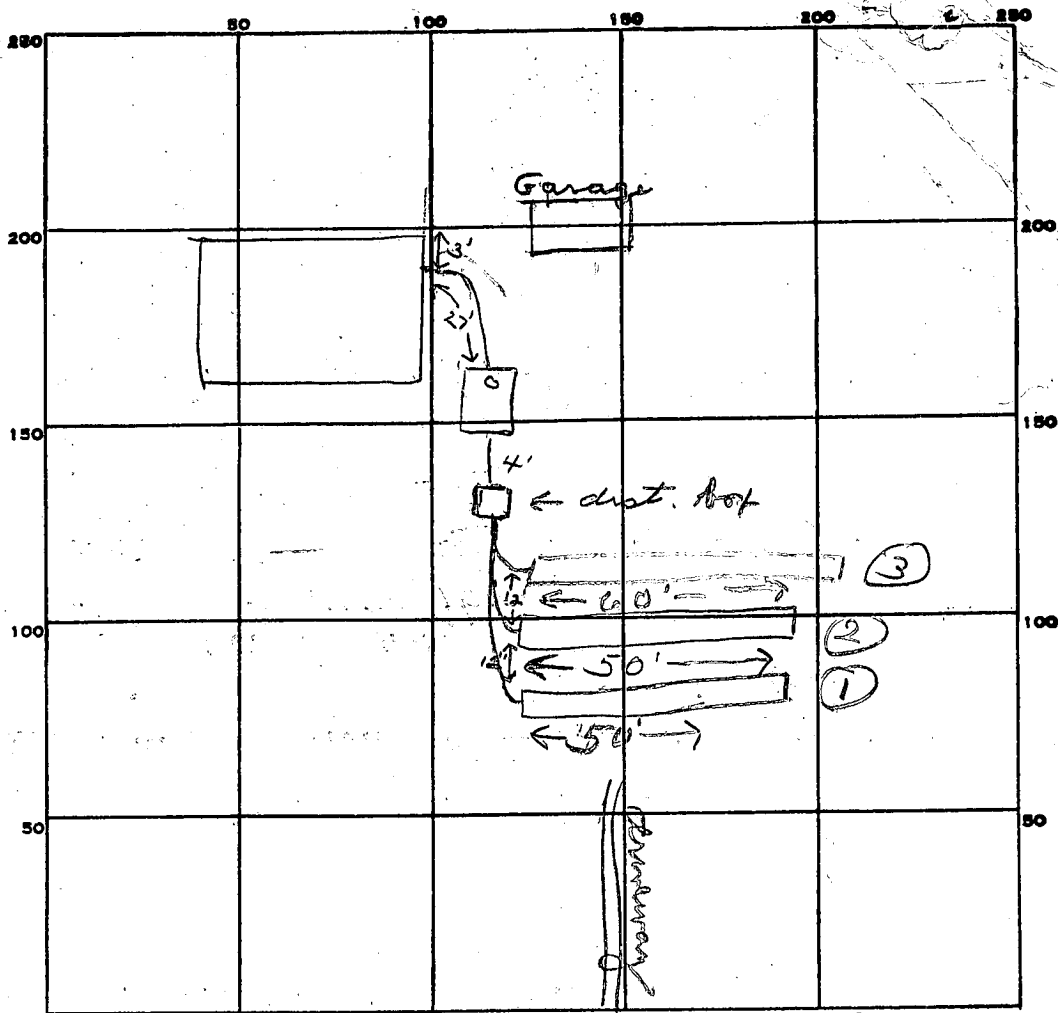

INDICATE NORTH. - NAME ADJOINING ROADWAY AS BASE LINE.

158
3
474

PERMIT CARD

Brooks Rd.

SEPTIC TANK, LEVEL

CLEANOUTS ST

DISTRIBUTION BOX, LEVEL

TILE FIELD, DEPTH 6 FT. TRENCH WIDTH 2 FT.

AND RETURNED
BUILDING PERMIT SIGNED

GRAVEL DEPTH 3 IN. TOTAL LENGTH 160 FT.

NUMBER OF TRENCHES 3 TOTAL BOTTOM AREA 480

SEEPAGE PITS, INSIDE DIAMETER _____ FT. DEPTH BELOW INLET _____ FT.

ABSORBENT AREA 480 SQ. FT.

REMARKS 10/17/83 OK to add stone in two trenches. JS
10/18/83 OK to add stone in #3 trench JS
10/18/83 OK to cover work to Dust. Box. JS
2/10/84 OK to cover all work. JS

DATE SYSTEM APPROVED 2/10/84

INSPECTOR Stayer