

Name of Requestor: Wayne Bennett
Street Address: 6910 Haviland mill Rd
City, State, Zip: Clarksville MD 21029
Date: 9/24/21

Amendment, Permit # B14000233

Ms. Debbie Whalen
Division of Plan Review
Department of Inspections, Licenses and Permits
Howard County Government
3430 Court House Dr
Ellicott City, MD 21043

Dear Ms. Whalen:

I am requesting to amend Permit # B14000233 at
6910 Haviland mill Rd Clarksville MD to
(Site Address)
add a 12' x 8' Deck at the rear of the house

Enclosed:

- Fee: \$25.00 - UL#1350
- Plot Plans
- Sets of Construction Drawings
- Other: _____

If there is anything we can do to assist you, please let me know.


Sincerely,

Name: Wayne Bennett

Title: Owner

Phone and/or Email: 443-250-6777 Strongfit@aol.com

CC: Health
D+Z

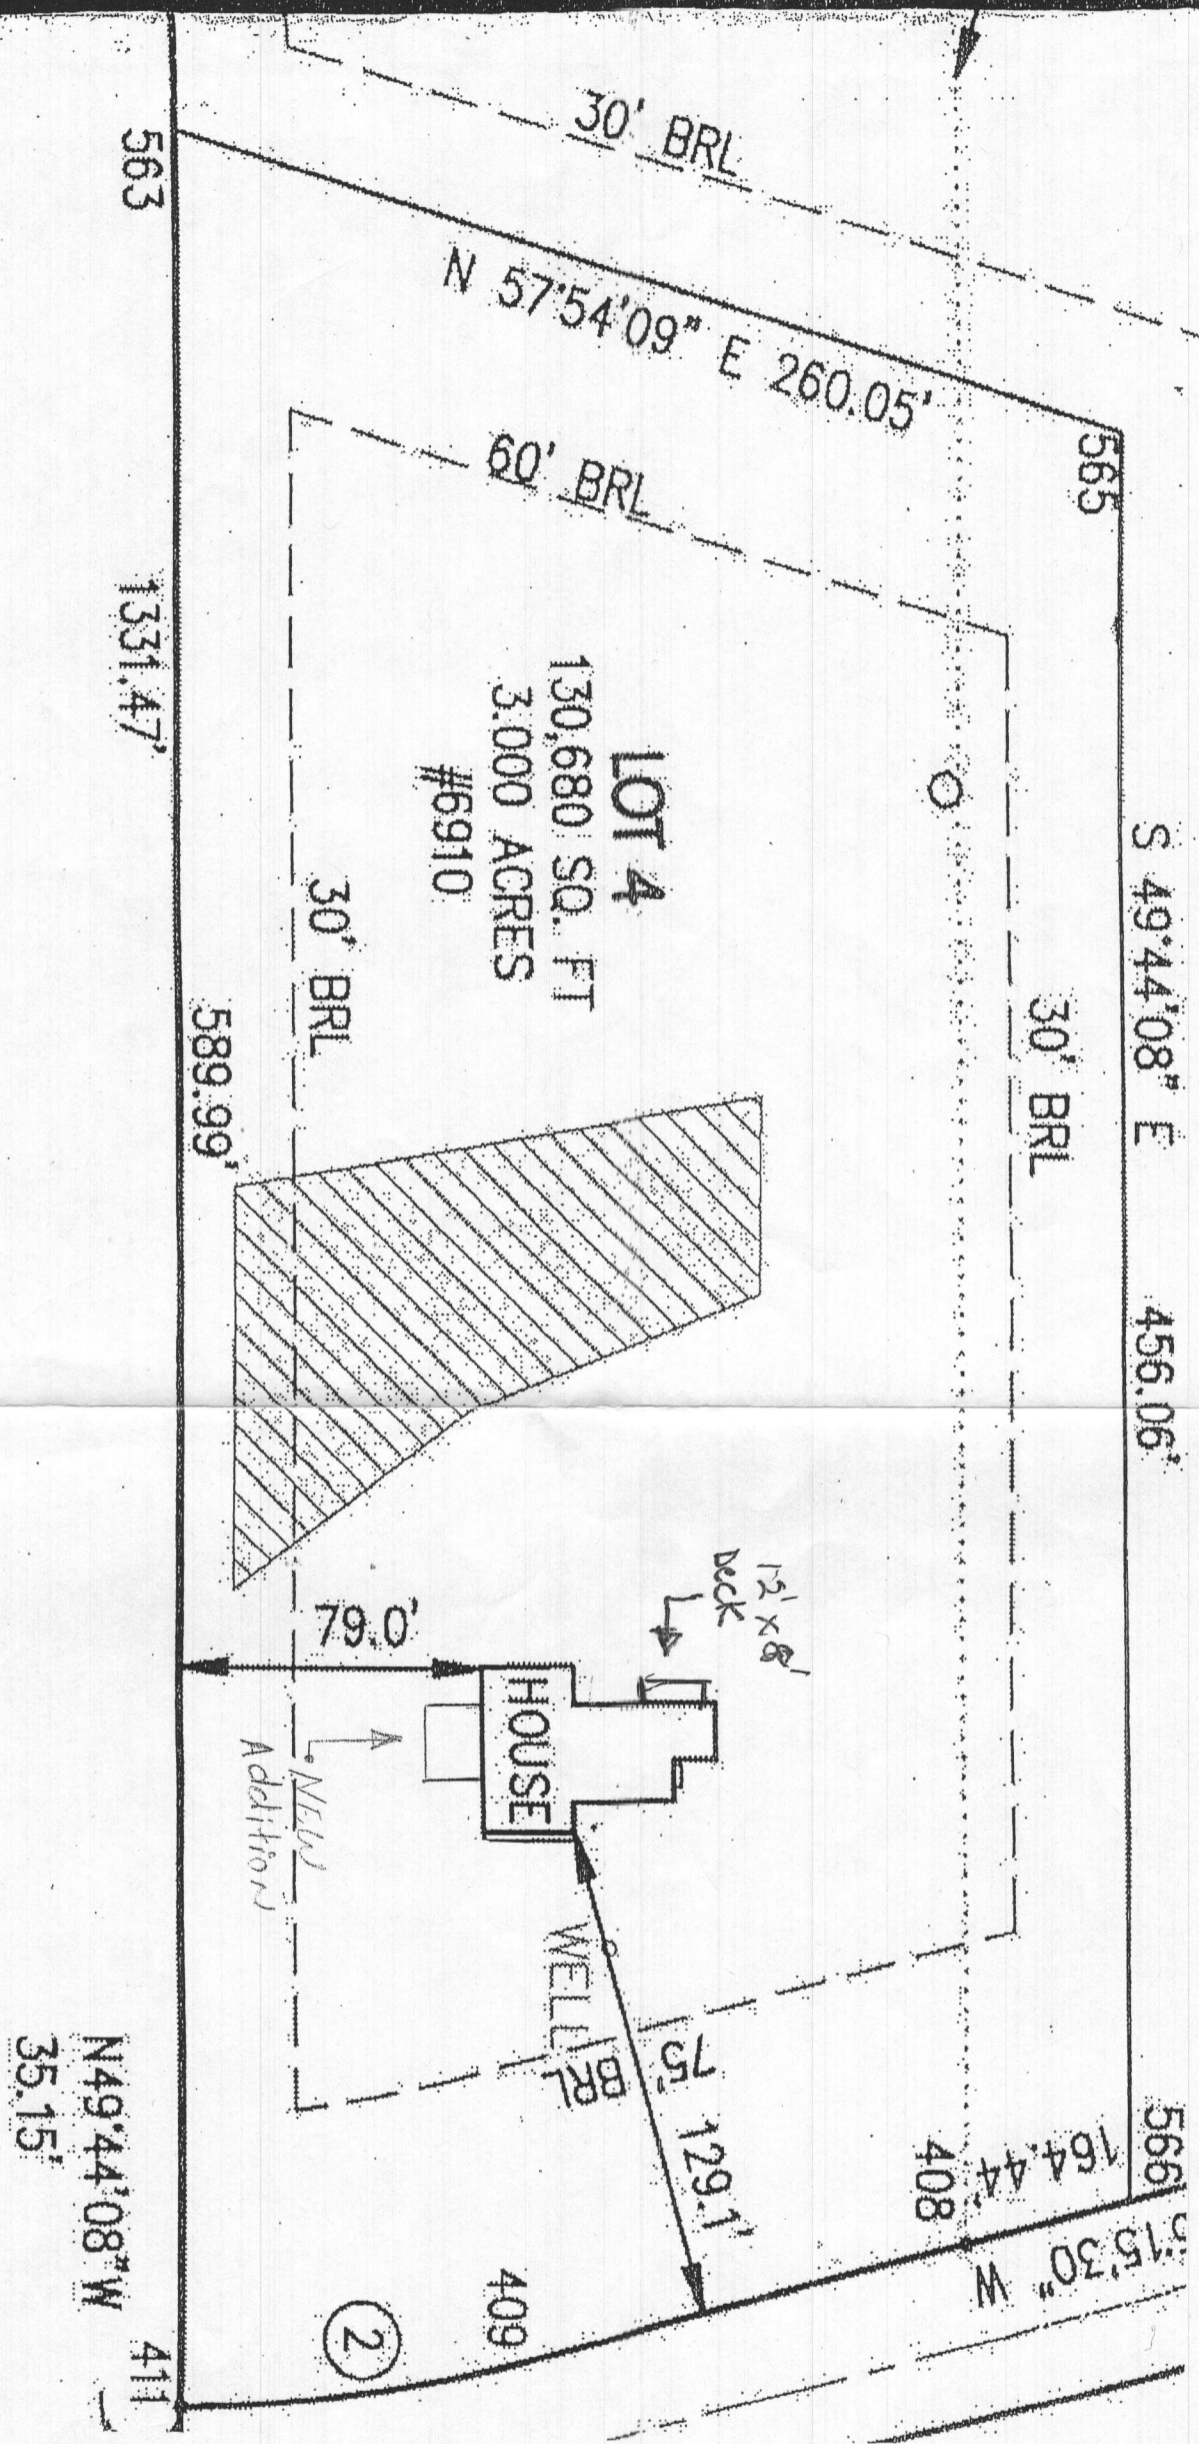

Approved
 Amendment
 R/E 10/18/2021

REVISED
 Date: 9/27/21
 314000233
 Comments: ADD 12x8 Deck

3/15/5

