

*File review required
Public w/ps MRE*

Record Detail * (This section is required.)

Permit Type Building/Residential/Misc/Pool Spa
Permit Number B23004475
Opened Date 11/09/2023
Description of Work SFD / Install 7'10" X 7'10" hot tub on existing paver patio.

[check spelling](#)

Address * (This section is required.)

Search Reset Clear Get Parcel & Owner

Street # 10805 Street Name HILLTOP Street Type LN
 Unit Type --Select-- Unit # X Coordinate -76.88707 Y Coordinate 39.20121
 City COLUMBIA State MD Zip Code 21044 Primary Yes

Parcel * (This section is required.)

Search Reset Clear Get Address & Owner

| GIS ID * | Parcel | Parcel Area | Land Value | Improved Value | Exemption Value | Plan Area |
|----------|--------|-------------|------------|----------------|-----------------|-----------|
| 863834 | 237 | 22476 | 270700 | 515300 | 244600 | COLUMB |

Legal Description
 IMPSLOT 2 22,476 SQ[]10805 HILLTOP LN[]CLARYS DISC1V RSB CEDABB

[check spelling](#)

| Block | Lot | Census Tract | Council Dist | Inspection Dist | Supervisor Dist | Map # | DAP Zone |
|-------|-----|--------------|--------------|-----------------|-----------------|-------|----------|
| | 2 | 605601 | 4 | | | | |

Plan Area State Tax Id 1405419786 Subdivision Name
Section Area Tax Map 35
Grid Zoning District R-20 ADC Map 4934-J8
SDP No. Final Plan No. WP File No.
Record Plat No. 11769 **WS Contract No.** **FDP No.** Primary Yes
Owner Occupied Yes No **Year Built** 1996 **Historic District** Yes No
Historic District Registry No. **Stat Area** 5-12A **Flood Plain** Yes No
Building No

Owner * (This section is required.)

Search Reset Clear

Name *
 BELLAGAMBA CRISTIAN A
Address Line 1
 10805 HILLTOP LN
Address Line 2
Address Line 3

Mail City COLUMBIA **Mail State** MD **Mail Zip Code** 21044
Phone 443-745-3644 **Primary** Yes
E-mail c.a.bellagamba@gmail.com
Cell Number **Fax Number**

Professionals (This section is not required.)

License # *
 0
License Type *
 Home Owner
Primary
 Yes

Business Name
 HOMEOWNER
First Name
 CRISTIAN
Address Line 1
 10805 HILLTOP LANE
Address Line 2

City
 COLUMBIA
Phone 1
 443-745-3644
E-mail
 c.a.bellagamba@gmail.com

Middle Name
 A
State
 MD
ZIP Code
 21044

Phone 2

Fax

Applicant (This section is not required.)

Search As Owner As Lic. Prof As Contact

Type *
 Applicant
Relationship
 Applicant
Primary
 Yes

First Name
 Cristian
Full Name
 Cristian Bellagamba
Organization Name

Street Address
 10805 Hilltop Lane
Address Line 2

City
 Columbia
Phone
 443-745-3644
E-mail *
 c.a.bellagamba@gmail.com

MI

State
 MD
Zip Code
 21044

Cell

Fax

Addtl Info

Est Construction Cost *
 17000
Construction Type
 -Select-

Housing Units *
 0

Number of Buildings *
 0

Public Owned
 No

POOL INFORMATION

MISCELLANEOUS POOL INFORMATION

Capital Project-No Fee *
 Yes No

Capital Project Number

Fee Exempt *
 Yes No

Water Supply *
 Public

Sewage Disposal *
 Public

Existing Use *
 SFD

Type of Pool or Spa *
 Hot Tub

Pool Safety Device *
 Automatic Pool Cover

Electrical Permit Number

Expiration Date

Related Records

Showing 1-2 of 2

| Permit Number | Record Type Alias | Status | Number | Street Name | Opened Date | Description |
|---------------|---|-------------------|--------|-------------|-------------|--|
| B23004475 | Residential Pool or Spa Permit | Review In Process | 10805 | HILLTOP | 11/09/2023 | SFD / Install 7'10" X 7'10" hot tub on existing paver patio. |
| E23006056 | Residential Electrical Miscellaneous Permit | Issued | 10805 | HILLTOP | 11/08/2023 | Installation of hot tub; Install car charger in garage |

SEWER INSTALLATION RECORD

Application No. 2-96-239
 Date Applied 8-18-95
 Date Sewer Acct. _____

Acct. No. 65-59-9280 S/Add Info. _____
 W/Add Info. _____ (Circle One)

W&S Contract No. 34-3409-D
 Rebate Contract _____

| | | | | |
|-------------------------------|---------------------------|---------------------|-----------|---|
| Street <u>Hilltop Lane</u> | House No. <u>10805</u> | Lot No. <u>2</u> | Block No. | Subdivision <u>Clary's Discovery</u> |
|-------------------------------|---------------------------|---------------------|-----------|---|

| | | |
|--------------------------------|--|---|
| Type of Property <u>SFD</u> | Town or Vicinity (and Zip Code) <u>Clary's Discovery</u> <u>21034</u> | Applicant <u>Michael Piau</u> Address _____ Phone No. _____ |
|--------------------------------|--|---|

| | | |
|--------------------------|----------------------|---------------------|
| Control No. <u>17532</u> | Size S.H.C. <u>4</u> | Acct. Control _____ |
|--------------------------|----------------------|---------------------|

Type of Installation:

Future
 Capital Project
 Utilities
 Dev. Agreement
 ADO No.

| | |
|----------------------|---------------|
| Depth of Sewer _____ | Lateral _____ |
|----------------------|---------------|

Length of Conn. from DH MH _____

Plugged Sewer Information:

Control No. 17532

WATER INSTALLATION RECORD

Application No. 1-96-235

Acct. Control

Date Applied 8-10-95

Type of Installation:

Date Water Acct. _____

Future Capital Project Utilities Dev. Agreement ADO No.

Applicant **Michael Pfau**
Address

Size Tap

Size Meter


Phone No.

3/4"

5/8"

Date of Tap _____
 Length of Connection _____
 Diameter _____
 Kind of Pipe _____
 Size of Conn. & Cock _____
 Meter Skat
 Make 95 55 98 77
 Number 12-14-95
 Date of Meter Setting _____
 Meter Location Pit Inside
 Location left side of house

SKETCH

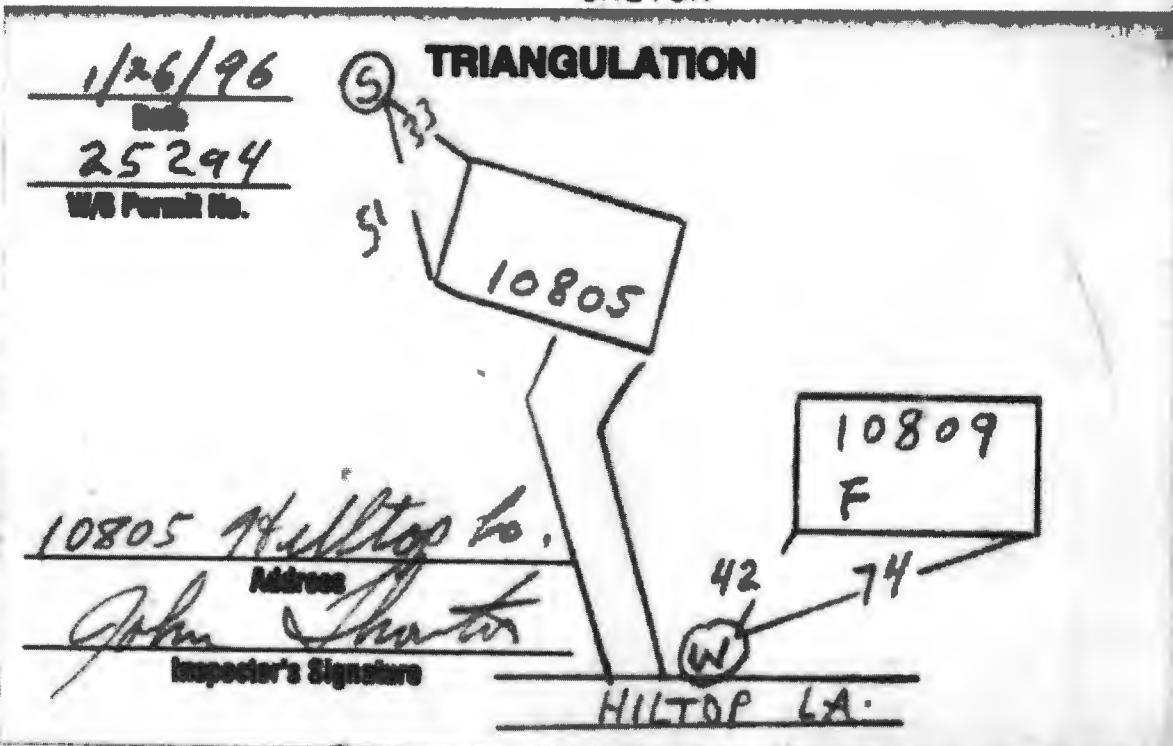

Reading: 0

Meter B. Jones Remote _____

Installed By _____