

JDS

HOME IMPROVEMENT

" WHERE QUALITY AND CRAFTSMANSHIP ARE THE
CORNERSTONE OF EVERY JOB"

20113 WOODFIELD ROAD, GAITHERSBURG MD 20882

(202)-604-8829

JORDAN@JDSHOMEIMPROVEMENT.COM

05/20/2022

Howard County Maryland
Permit Center

To Whom it May Concern

This is a request for a Revision to Permit B21003688

I am Jordan Jones owner of JDS Home Improvement LLC, Maryland Home Improvement License
Number: 94098. We currently have an Approved Permit, B21003688,

To Cut a New Opening for a 4' x 4', Egress window with new structural header and Well w/
ladder & Cap in an existing finished basement wall.

The Client has requested we change the permit to be (3) Egress Windows to replace (3) existing
basement Windows, on the opposite side of the house,

No Structural changes to the (3) existing windows, same header to remain in place as well as
being above grade & No wells will be needed.

Sincerely

Jordan Jones

5/20/22

✓ pd \$25.00
#2098

RECEIVED

MAY 24 2022

LICENSES & PERMITS
DIVISION

PRESERVATION PARCEL A


REVISED

Date: 5/24/22

Comments: Ba1003688

10' Wide Tree Maintenance Easement

(3) NEW ABOVE GRAPE EGRESS WINDOWS

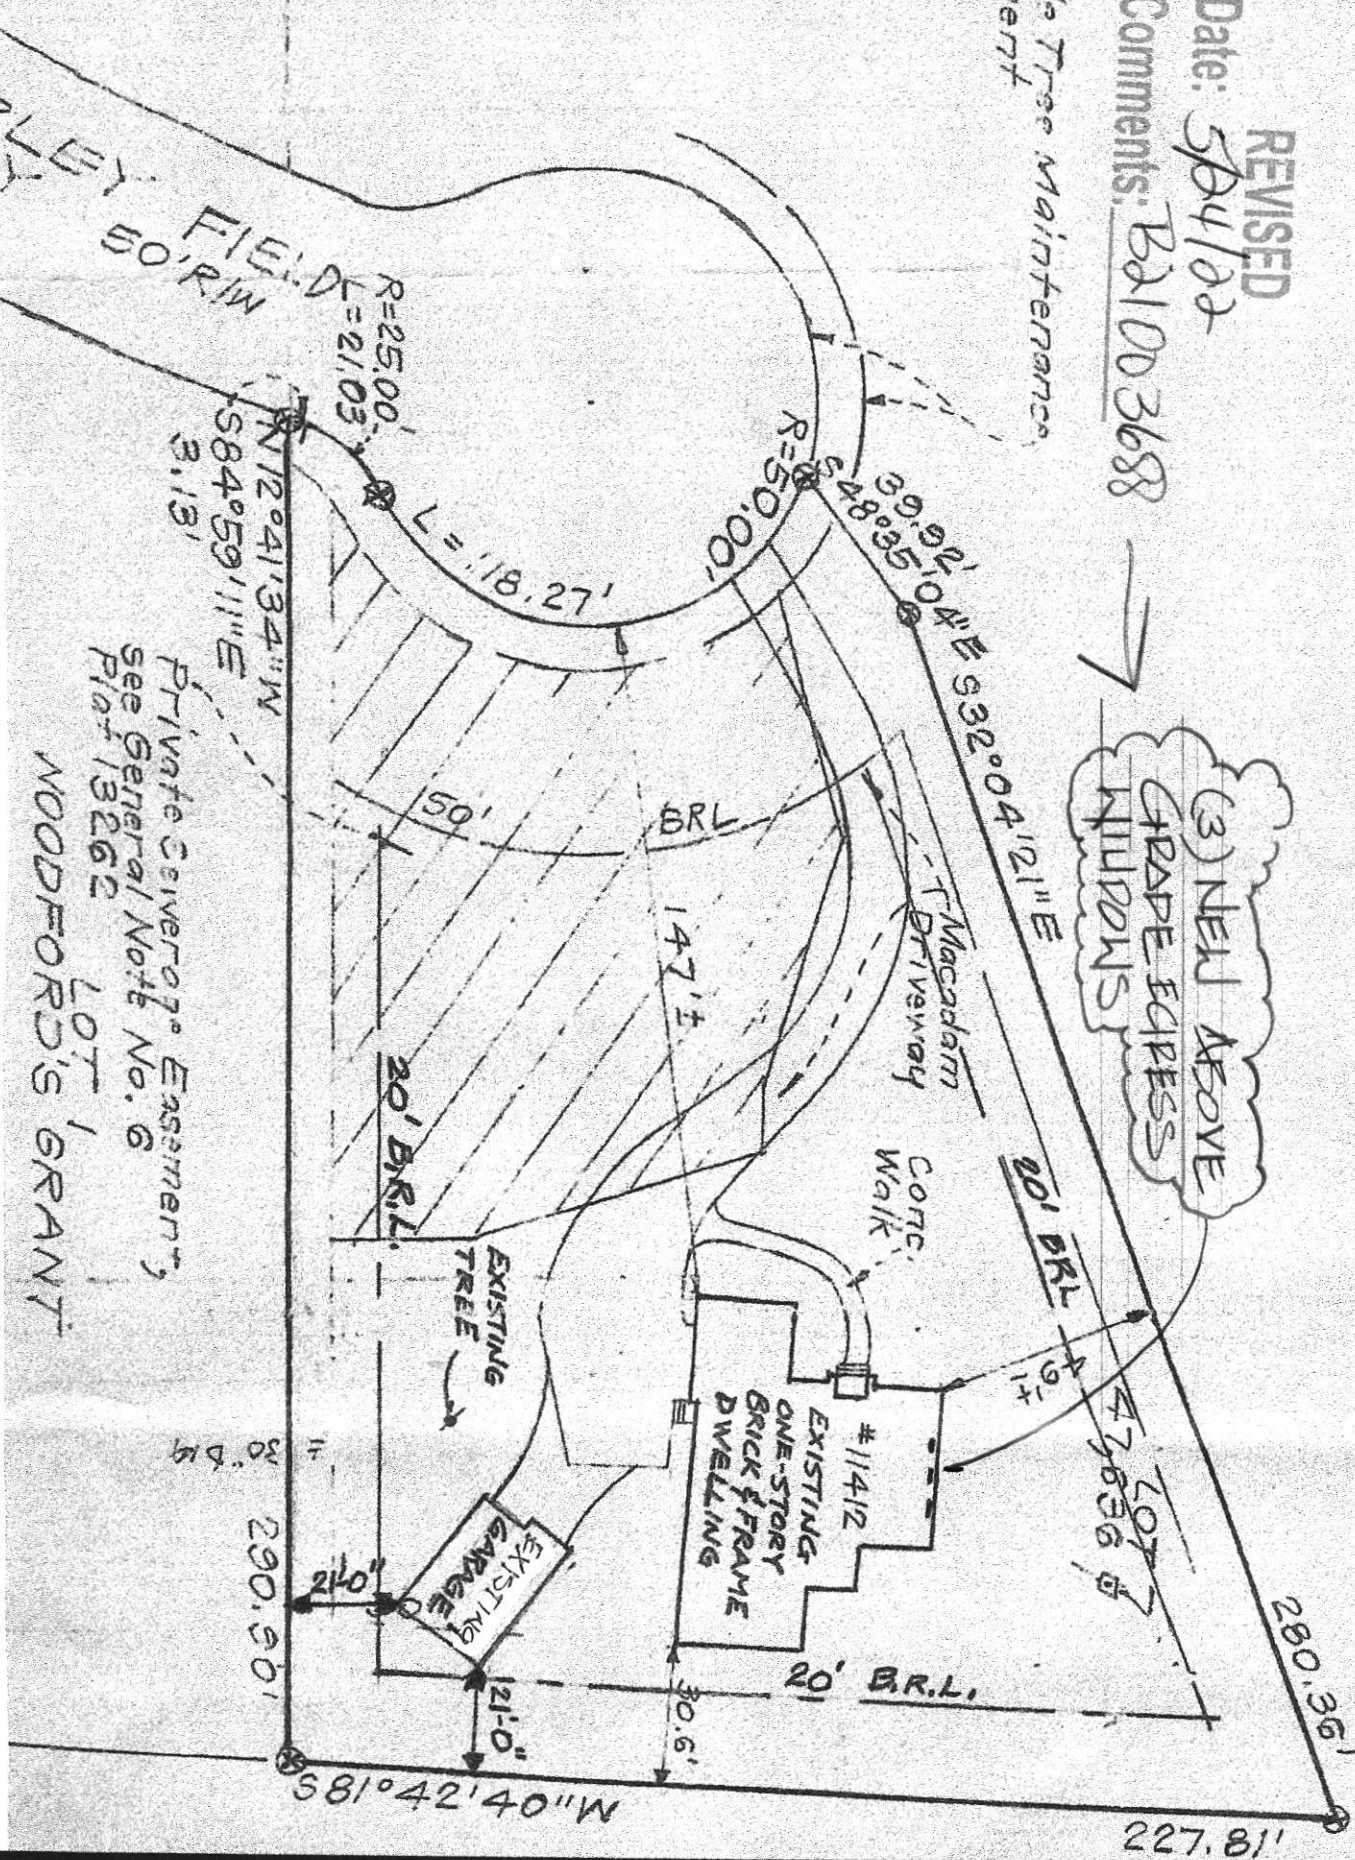

142 BARLEY FIELD WAY, MARIOTT'S VILLE MD 2104

(3) NEW ABOVE GRAPE EGRESS WINDOWS

USING (3) EXISTING WINDOW OPENINGS
 EXISTING WINDOW HEADERS
 TO REMAIN UNCHANGED
 CUT DOWN FOR
 (3) NEW 28" X 46"
 "MIDAL" EGRESS WINDOWS
 FRAME AS NEEDED FOR WINDOW
 FINISHED SILL HEIGHT NOT TO
 EXCEED 44" ABOVE FINISHED FLOOR

REVISED
 Date: 5/24/22
 Comments: B21003688
 Add (3) egress windows
 in Basement to replace
 (3) existing windows



Health Dept

REV. NO.	DATE	COMMENTS
DESIGNER:	CHARLES WEST	
PO BOX	80	
GERRARDSTOWN	WV 25420	
Office:	304-229-2414	
Cell:	301-938-0413	
NAME		
ADDRESS		
LIT / BLOCK		
SECTION		
SHEET NO.	Page 1	
SCALE	1/8" = 1'-0"	
DRAWN BY	C WEST	
DATE	05/17/2022	

David Palmer
 11412 Barley Field Way
 Martinsville Md

DESIGNER: CHARLES WEST
 PO BOX 80
 GERRARDSTOWN WV 25420
 Office: 304-229-2414
 Cell: 301-938-0413

CWEST
 DESIGNER

SHEET NO.
 Page 1
 SCALE
 1/8" = 1'-0"
 DRAWN BY
 C WEST
 DATE
 05/17/2022

