

Bureau of Environmental Health

8930 Stanford Boulevard, Columbia, MD 21045

Main: 410-313-2640 Fax: 410-313-2648

TDD 410-313-2323 | Toll Free 1-866-313-6300

www.hchealth.org

Facebook: www.facebook.com/hchealth

Twitter: HowardCoHealthDep

Maura J. Rossman, M.D., Health Officer

ASdelolo

APPLICATION

FOR PERCOLATION TESTING AND SITE EVALUATION

PROPERTY LOCATION

SUBDIVISION/PROPERTY NAME

PROPERTY ADDRESS 7600 PINEHILL SUITE 100 FULTON 20759

TAX ACCOUNT # 25-364614 TAX MAP 0241 GRID 0114 PARCEL 0165 LOT NO. PROPOSED LOT SIZE (ACRES) .99

ZONING CATEGORY TIER

PROPERTY OWNER(S) ITI'S INSAL CONSULTING, LLC. 3300 WILDS

DAYTIME PHONE CELL 410-661-6619 EMAIL INFO@DMO.BUILD.COM

MAILING ADDRESS 1370'S PINEHILL SUITE 100 FULTON 20759

APPLICANT CHRISTINA PLUMMER, MGR. RELATIONSHIP TO OWNER: CONTRACTOR

DAYTIME PHONE 410-761-6906 CELL EMAIL CHRISTINA@PLUMMERHOME.COM

MAILING ADDRESS 8152 VETERANS HWY. WILMINGTON, MD 21165

I HEREBY APPLY FOR THE NECESSARY TESTING/EVALUATION PRIOR TO ISSUANCE OF SEWAGE DISPOSAL SYSTEM PERMIT(S):

PROPERTY:

SUBDIVISION: NUMBER OF LOTS INCLUDING RESIDUE: SUBDIVISION CLASSIFICATION (PER DEPT. OF PLANNING AND ZONING) MAJOR MINOR CONSTRUCT NEW OSDS ON UNDEVELOPED LOT REPAIR OR REPLACE FAILING OSDS UPGRADE EXISTING OSDS

BUILDING:

RESIDENTIAL WITH EXISTING OR PROPOSED BEDROOMS IN THE COMPLETED STRUCTURE COMMERCIAL (PROVIDE DETAIL OF TYPE OF USE AND NUMBERS OF EMPLOYEES, CUSTOMERS ON ACCOMPANYING PLAN)

IS THE PROPERTY WITHIN 2500 FEET OF ANY RESERVOIR?

YES NO

AS APPLICANT, I UNDERSTAND THE FOLLOWING:

- THIS APPLICATION IS VALID FOR TWO(2) YEARS FROM DATE OF FEE PAYMENT AND APPROVAL IS BASED UPON HEALTH OFFICER SIGNATURE OF A PERC CERTIFICATION PLAN PRIOR TO EXPIRATION OF THIS PERMIT. THE APPLICATION FEE IS NON-REFUNDABLE THIS APPLICATION MUST BE ACCOMPANIED BY ALL APPLICABLE FEES AND A SUITABLE SITE PLAN IN ORDER TO BE PROCESSED THIS IS A PUBLIC DOCUMENT

I declare and affirm that to the best of my knowledge, the information contained herein is correct. I declare that I am the owner of the property or duly authorized to make this application on behalf of the owner. I agree to comply with all applicable state and county regulations.

By signature of this application, I hereby grant Howard County Health Department officials the right to enter onto the property for the purpose of inspecting the property as directly related to the requested permit/service.


Signature of Applicant

11/29/24

SIGNATURE OF APPLICANT

DATE

Recheck basic well

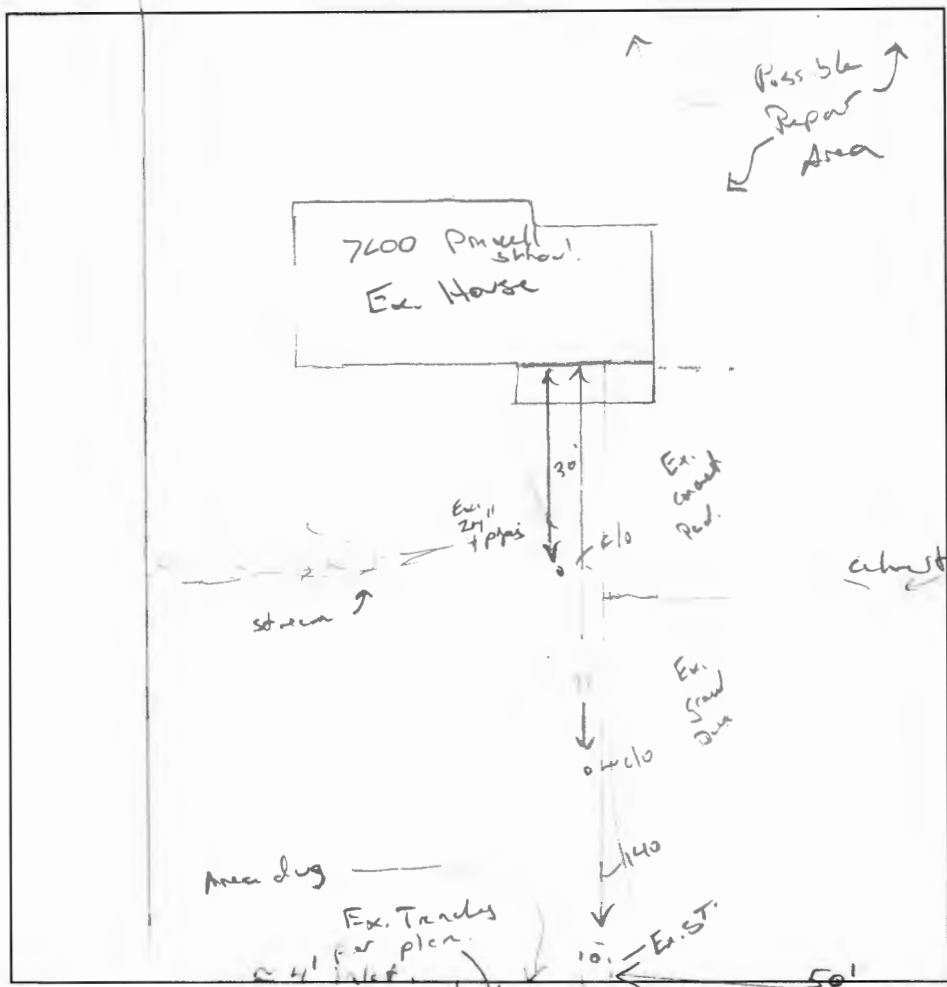

Possible Repair Area

check Pipe

Ex. Drilled well (No Test)

DATE	TEST #	DEPTH	START	BREAK T' DROP	STOP 2" DROP	TIME OF 2ND INCH	P/F/H
5/16/2021			Pondell School Rd				

REMARKS see attached memo

SANITARIAN K. W. St BACKHOE _____ OTHERS _____

TEST HOLES USED IN SDA _____ AVG. PERC TIME _____ SQ. FT/BR _____

TRENCH WIDTH _____ INLET DEPTH _____ MAX. BOT DEPTH _____ EFFECTIVE SW _____

FILE INQUIRY NOTES

7600 Pindell School Road

DATE	RESULTS OF REVIEW FOR FILE
5/16/2024	<p>Arrived for perc / site evaluation. Contractor had dug up areas beyond ex. septic tank. Looking for tanks. We were able to find ex. tanks per as built (1972, P17663) 2x 80' tanks inlet approx 4' below grade. Depth unknown. However, abs hole was dug by Scordina plumbing prior to my arrival to the site approx 10' below ex. tanks 10' deep, br/yl sch → 4', water table just below that. Soil profile not taken as hole collapsed @ 4.5' so contractor started to backfill.</p> <p>Site is limited w/ restrictions to stream, high water table limited area, will set back etc.</p> <p>Explained situation to Aaron Childs (current LLC owner of property) that no surface discharge was evident. And Scordina plumbing proposed to install new plumbing from ex. S.T. into tanks, install new dist. box, and remove old arcing pipe in tanks replace w/ sch etc. Nothing more could be done unless they wanted to dig a new location for perc / pump.</p> <p>Aaron decided to proceed w/ pipe repair. w/ Scordina Plumbing</p> <p>Explained to Scordina we would need plan to show and explain what is to be done before we can issue permit (pm)</p>

