



Bureau of Environmental Health

8930 Stanford Boulevard, Columbia, MD 21045

Main: 410-313-2640 | Fax: 410-313-2648

TDD 410-313-2323 | Toll Free 1-866-313-6300

www.hchealth.org

Facebook: www.facebook.com/hocohealth

Twitter: HowardCoHealthDep

Maura J. Rossman, M.D., Health Officer

SEWAGE DISPOSAL SYSTEM SPECIFICATIONS WORKSHEET

Address: 1901 Old Annapolis Road

Subdivision: Sartorio Property Lot: 5

Initial system: Application rate: 1.2 Effective area beginning depth: 4 Bottom maximum depth: 8

1st Replacement: Application rate: 1.2 Effective area beginning depth: 4 Bottom maximum depth: 8

2nd Replacement: Application rate: 1.2 Effective area beginning depth: 4 Bottom maximum depth: 8

Design Flow = 150 gallons per day per bedroom

Design flow ÷ application rate = square footage of drainfield required

Linear length of trench required = drainfield square footage x sidewall reduction percentage ÷ trench width

Sidewall reduction credit formula:

(W + 2) / (W + 1 + 2D) x 100 = Percent of length of standard trench where W=trench width and D= depth between effective area beginning depth and trench bottom.

Standard design requirements:

- All trenches must be equal length unless low pressure dosed
All trenches must be on contour
Minimum trench spacing: 10' for all trenches utilizing sidewall reduction credit. Additional spacing may be necessary for any trench using over 3.5' of effective sidewall. In those cases, the spacing formula is 2D +W up to a maximum spacing of 18'.
Minimum trench spacing for trenches with no sidewall credit (bottom area only) is 6' for a 2' wide trench and 9' for a 3' wide trench (spacing is measured edge to edge)
Maximum trench length is 100'
Maximum pipe depth is 4'


















Additional requirements:


Approved: Hank Oswald Date: 1/2/19

Perc Cent signed 1/2/05

SOILS LEGEND		
SYMBOL	NAME / DESCRIPTION	SOIL GROUP
GIB2	Glenns loam, 8 to 8 percent slopes, moderately eroded	B
MtB2	Fr. Aky cherty loam, 8 to 8 percent slopes, moderately eroded	A

— = proposed
— =

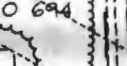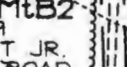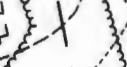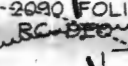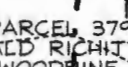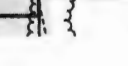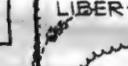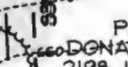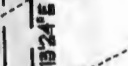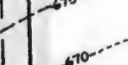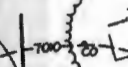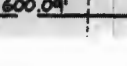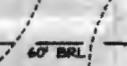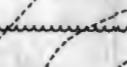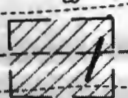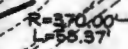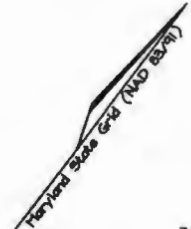

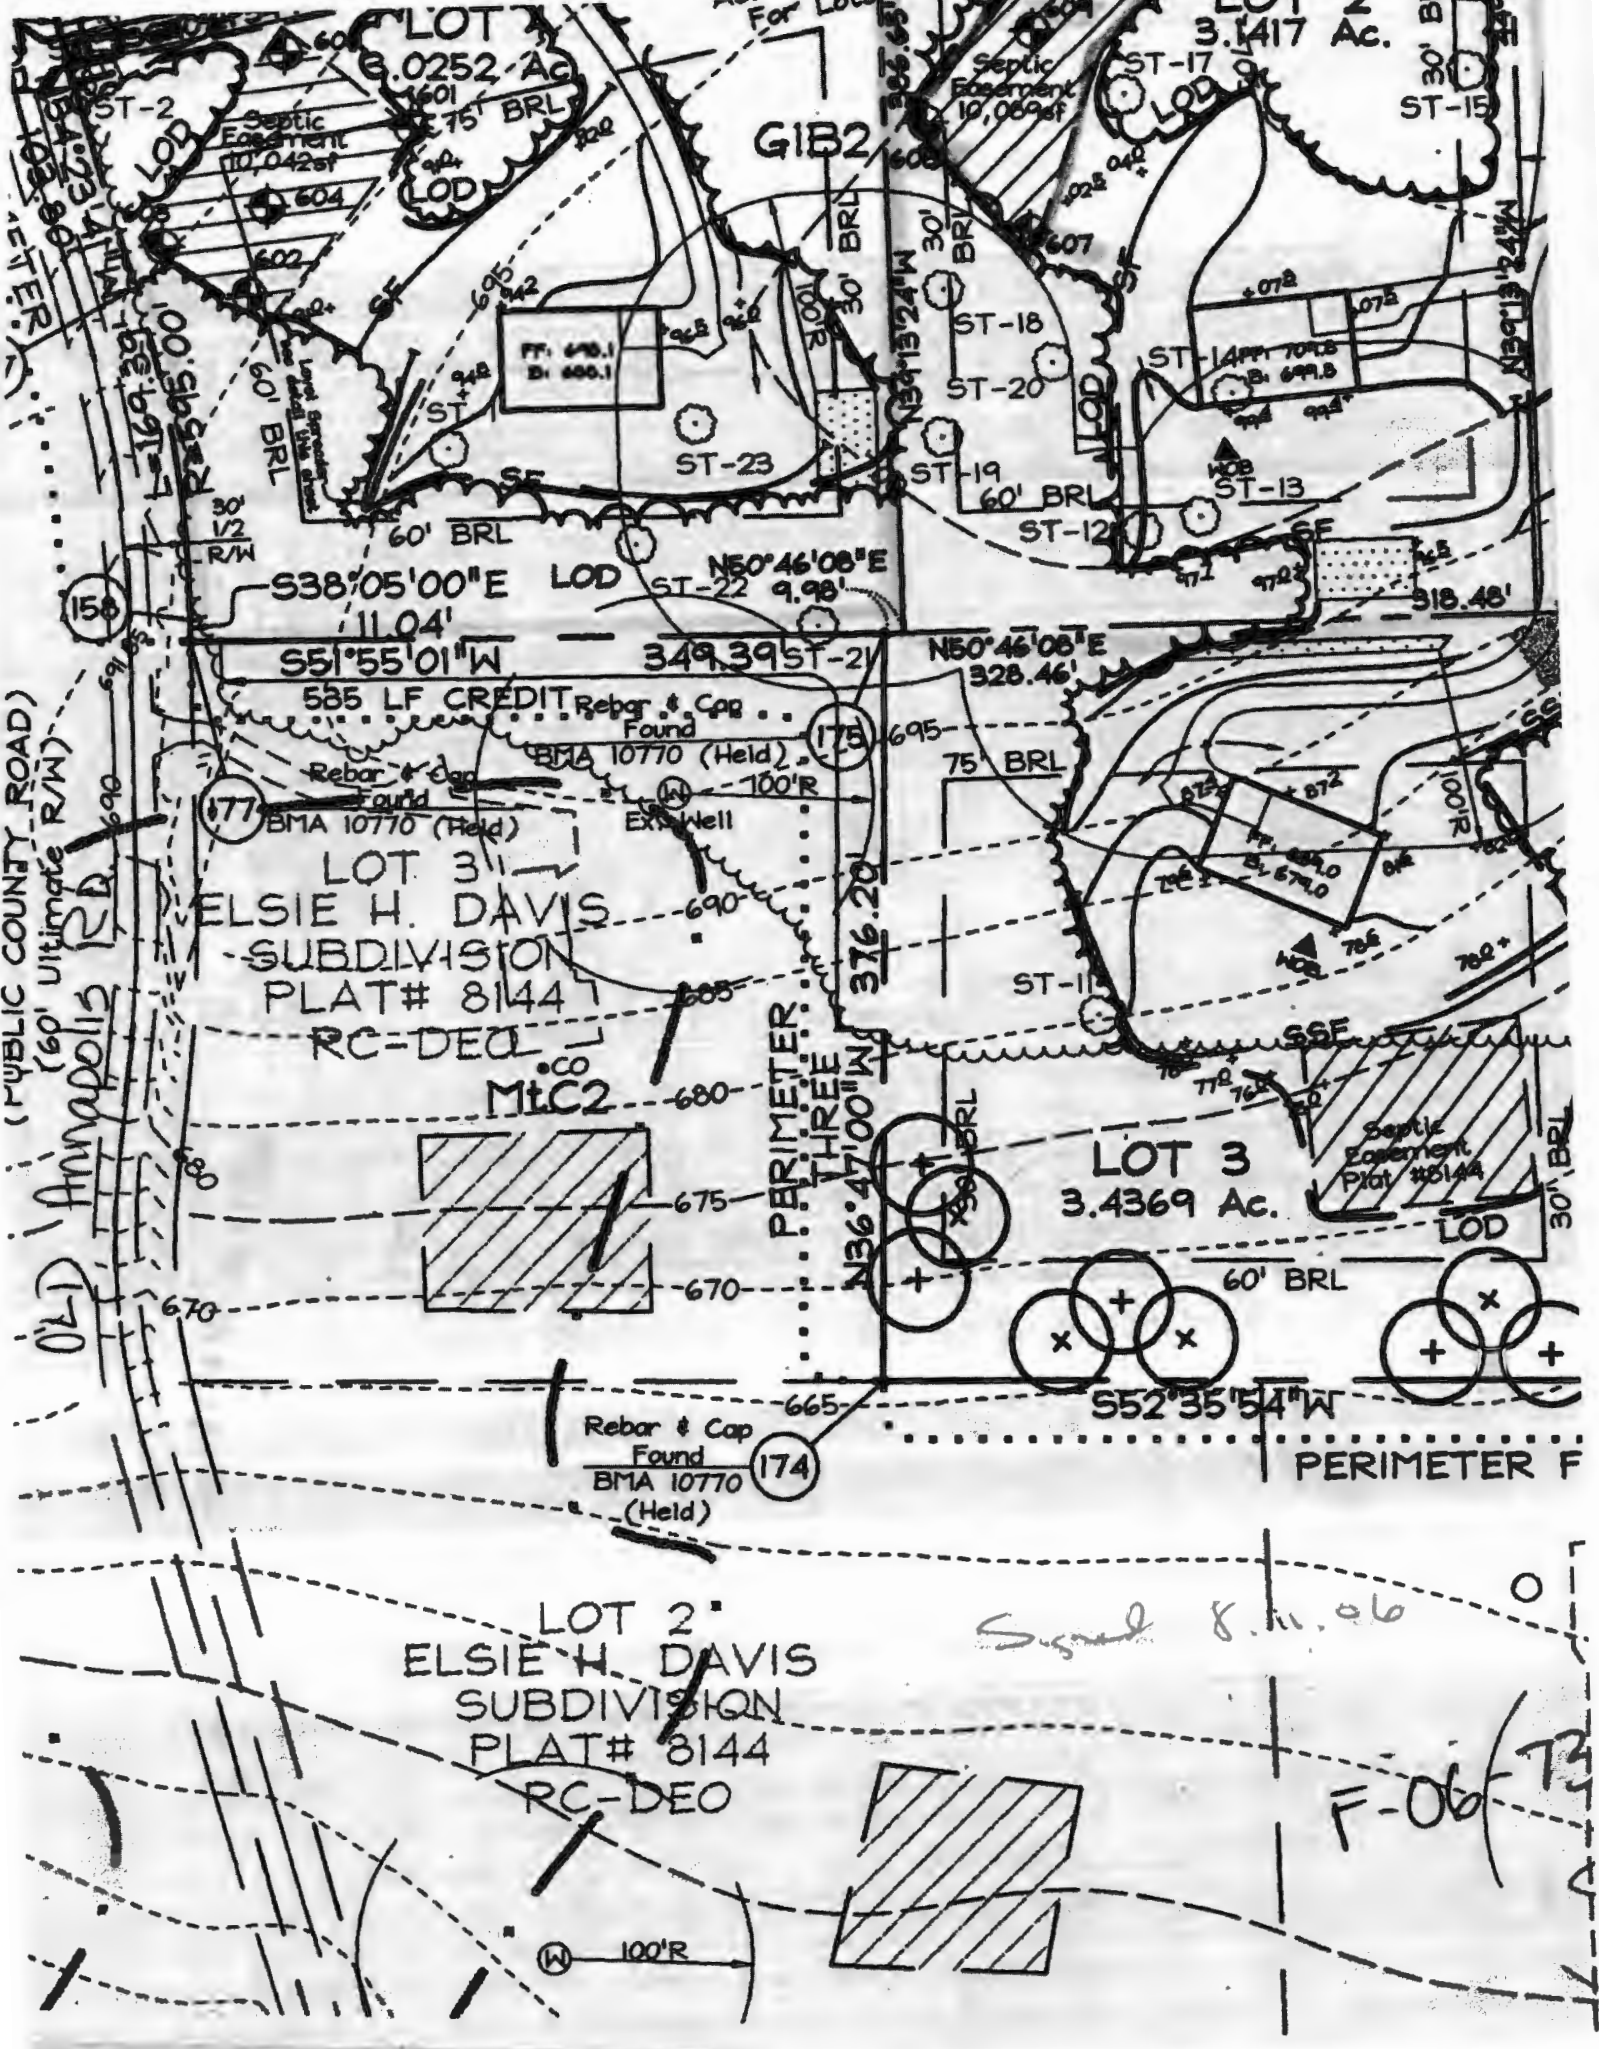

LOT 2
3.0252 Ac.
75' BRL
LOD

LOT 2
3.1417 Ac.
30' BR

GIB2

OLD Annapolis Rd.
(60' ultimate R/W)
PUBLIC COUNTY ROAD

LOT 3
ELSIE H. DAVIS
SUBDIVISION
PLAT# 8144
RC-DEO
MTC2

LOT 3
3.4369 Ac.
LOD

LOT 2
ELSIE H. DAVIS
SUBDIVISION
PLAT# 8144
RC-DEO

158

177

175

174

100'R

S38°05'00"E LOD 11.04'

S51°55'01"W 349.39'

ST-21

N50°46'08"E 328.46'

PERIMETER THREE
N36°47'00"W 376.20'

S52°35'54"W

PERIMETER F

Rebar & Cap Found
BMA 10770 (Held)

BMA 10770 (Held)
Rebar & Cap Found

535 LF CREDIT

BMA 10770 (Held)
Rebar & Cap Found

Ex. Well

Septic Easement
Plat #8144

Septic Easement
10,069sf

Septic Easement
10,069sf

FF: 698.1
B: 680.1

FF: 704.8
B: 699.8

FF: 694.0
B: 679.0

ST-18

ST-20

ST-19

ST-12

ST-14

ST-17

ST-15

ST-23

ST-22

ST-11

ST-16

ST-10

60' BRL

30' BRL

30' BRL

60' BRL

60' BRL

30' V2 R/W

30' V2 R/W

Signal 8.11.06


F-06-73

A/P 603
 Brown
 L
 Pink/Brown
 Sil
 Yellow/Brown
 Sil w/
 10%
 Saprolite

602
 Brown
 L
 Red/Orange
 Brown
 Sil w/
 10%
 SAP
 Yellow/Brown
 Sil
 15-20%
 Sap

600
 Brown
 L
 Yellow/Brown
 Sil
 w/ 10%
 Saprolite

601
 Brown
 L
 Yellow/Brown
 Red
 Sil w/
 15%
 Saprolite

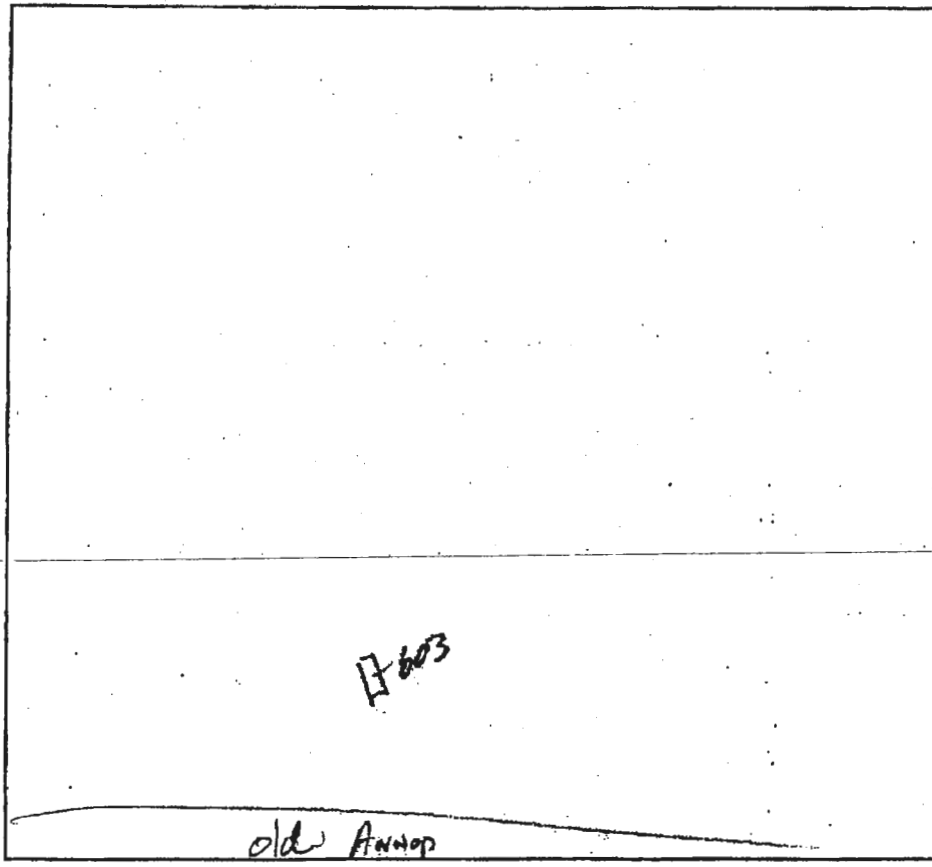

DATE	TEST #	DEPTH	START	BREAK 1' DROP	STOP 2' DROP	TIME OF 2nd INCH	P/F/H
12/14/04	603	4' / 13'	8:50	8:52	8:55	3min	P
	600	3 1/2' / 13'	8:57	9:00	9:04	4	P
	604	- / 13'	-	-	-	ok	P
	602	4 1/2' / 12 1/2'	9:05	9:08	9:11	3min	P
	601	4 1/2' / 10'	9:13	9:15	9:19	4min	P

604
 Brown
 L
 Yellow/Brown
 Sil
 w/ 20%
 Saprolite

REMARKS _____

SANITARIAN KJB BACKHOE Justin OTHERS Chuck, Tim, Zuck

TEST HOLES USED IN SDA _____ AVG. PERC TIME _____ SQ. FT/BR _____

TRENCH WIDTH _____ INLET DEPTH _____ MAX. BOT DEPTH _____ EFFECTIVE S/W _____