

A/P

21

Red Brown
SCL
3'
Schist @
5'
10-20%
small
Red Brown
yellow
F Sh
much
Mica
↓
13'


23

Red Brown
SCL
3'
Red Brown
F Sh
Silty
much
Mica
5-10% small
↓
13'

24

Red Brown
SCL
2.5'
Red Brown
SCL
much
Mica
3.5'

Red Brown
F Sh
much
Mica
Silty
↓
13'

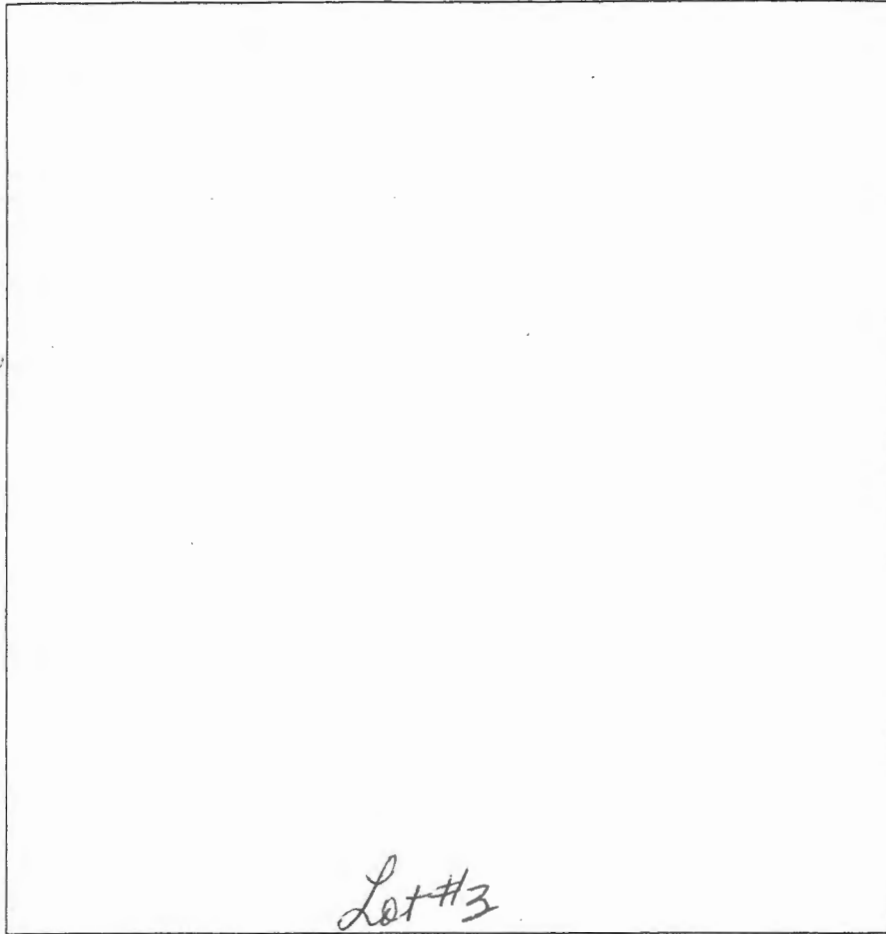

DATE	TEST #	DEPTH	START	BREAK 1" DROP	STOP 2" DROP	TIME OF 2ND INCH	P/F/H
3-20-13	21	4/13	10:24	10:26	10:29	3min	P
3-20-13	23	7/13	10:31	10:34	10:40	6min	P
3-20-13	24	5/13	10:34	10:37	10:40	3min	P
3-20-13	22	5/13	10:43	10:46	10:54	8min	P
3-20-13	25	7/13	Visual Soil				F
3-20-13	26	7/14	10:59	11:13	11:30	17min	P
3-20-13	19	5.5/13.5	11:10	11:15	11:21	6min	P

REMARKS

Lots # 5-6

SANITARIAN DB + RB BACKHOE Darius OTHERS _____
 TEST HOLES USED IN SDA _____ AVG. PERC TIME _____ SQ. FT/BR _____
 TRENCH WIDTH _____ INLET DEPTH _____ MAX. BOT DEPTH _____ EFFECTIVE SW _____

22

Red Brown
Silty
much
Mica
SCL
3'
Medium
SCL
much
Mica
Red Brown
Yellow
5'
H2O @ Red
Brown
11'
26-30%
SCL
yellow
Schist
↓
13'
Lamy
SCL
25'

Red Brown
SCL
Heavy
6'
Red Brown
Medium
SCL
10-20%
Schist
↓
10'
H2O @
11'
13'

26

Red Brown
SCL
5-10%
Red Brown
yellow
F Sh
much
Mica
Silty
↓
14'