

Maura J. Rossman, M.D., Health Officer

MEMORANDUM

Sent via email to jespo47@gmail.com

TO: Joseph Esposito

FROM: Kevin M. Wolf, LEHS, REHS/RS, Supervisor 
Groundwater Mgmt. Sec.
Well & Septic Program

DATE: September 23, 2021

RE: 11493, 11489 Frederick Road
Ellicott City, MD 21042
M. 16 P. 198/144 17, 293SF/2.06AC
(Demolition of existing houses, return to grass land)

This is to advise that the Howard County Health Department recommends issuance of the demolition permit for the above referenced property.


The existing drilled wells (tags unknown) that were utilized for the above referenced properties were located and sealed by Andrew Houseman (MSD224) on 9/10/2021. The well abandonment reports were received by our office and reviewed for compliance.

The existing septic systems that served the houses consisted of a concrete septic tank and trenches. Both were pumped out and collapsed by Fogle's on 9/9/2021 respectively. Proper documentation was submitted to our office for record of confirmation.

Future plans to rebuild on the subject property will require a percolation certification plan and the development of a private well system.

IF ANY WELL OR SEPTIC COMPONENTS ARE FOUND DURING SITE WORK, YOU MUST NOTIFY THIS OFFICE IMMEDIATELY!!

KMW
Cc: File

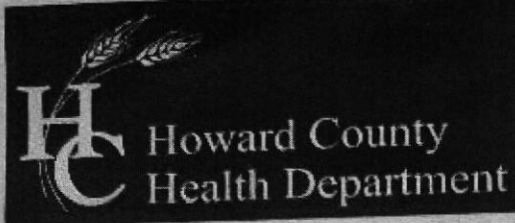

Bureau of Environmental Health
 8930 Stanford Boulevard, Columbia, MD 21045
 Main: 410-313-2640 | Fax: 410-313-2648
 TDD 410-313-2323 | Toll Free 1-866-313-6300
 www.hchealth.org
 Facebook: www.facebook.com/hocohealth
 Twitter: HowardCoHealthDep

Maura J. Rossman, M.D., Health Officer

DEMOLITION REQUEST FORM

Information of Property to be Demolished:

RAVI + UMA ANADA KRISHNAU 11489 FREDERICK RD. ELLICOTT CITY, 21042
 Current Owner's Name Property Address

Subdivision (if applicable) _____ Lot # 6

All Prior Owners' Names (if requested or known) _____ Tax Map _____ Parcel # 03-281698 Tax ID # _____

UNSAFE ABANDONED STRUCTURE
 Purpose/Reason for Demolition

UNKNOWN
 Future plans of property after demo (i.e. subdivision, parking lot, re-build new house, etc...)

If a subdivision, SDP# _____ Has the structure(s) been deemed unsafe by DILP YES NO

UTILITY RECORDS:

Property currently connected to public water YES NO

Property currently connected to public sewer YES NO

Does the property currently have any wells and/or septic systems YES NO

→ Explain: HAS WELL + SEPTIC

*Note: Any wells and/or septic systems that are to remain may require an approved percolation certification plan under Howard County Code Sec. 3.805
 *Note: Any septic systems that are to be abandoned must be done by a septic contractor with documentation of the process
 *Note: All abandoned wells are to be sealed by a well driller licensed by the Maryland State Board of Well Drillers (MSBWD) 26.04.04.11 Abandonment Standards D (3)

COMMENTS:

JOSEPH ESPOSITO 410-375-9067
 Applicant's Name (please print) Applicant's Phone #

JESPO47@EMMIL.COM _____
 Applicant's Email Applicant's Fax #

[Signature] 09/20/21
 Applicant's Signature Date



Bureau of Environmental Health
 8930 Stanford Boulevard, Columbia, MD 21045
 Main: 410-313-2640 | Fax: 410-313-2648
 TDD 410-313-2323 | Toll Free 1-866-313-6300
 www.hchealth.org
 Facebook: www.facebook.com/hocohealth
 Twitter: HowardCoHealthDep

Maura J. Rossman, M.D., Health Officer

DEMOLITION REQUEST FORM

Information of Property to be Demolished:

RAVI + UMA ANADA KRISHNAU
 Current Owner's Name

11489 FREDERICK RD. ELLICOTT CITY, 21042
 Property Address

Subdivision (if applicable)

6
 Lot #

All Prior Owners' Names (if requested or known)

Tax Map 03-281698 Parcel # Tax ID #

UNSAFE ABANDONED STRUCTURE
 Purpose/Reason for Demolition

UNKNOWN
 Future plans of property after demo (i.e. subdivision, parking lot, re-build new house, etc...)

If a subdivision, SDP# _____ Has the structure(s) been deemed unsafe by DILP YES NO

UTILITY RECORDS:

Property currently connected to public water YES NO

Property currently connected to public sewer YES NO

Does the property currently have any wells and/or septic systems YES NO

→ Explain: HAS WELL + SEPTIC

*Note: Any wells and/or septic systems that are to remain may require an approved percolation certification plan under Howard County Code Sec. 3.805

*Note: Any septic systems that are to be abandoned must be done by a septic contractor with documentation of the process.

*Note: All abandoned wells are to be sealed by a well driller licensed by the Maryland State Board of Well Drillers (D&E) 26.04.04.11 Abandonment Standards D (3)

COMMENTS:

JOSEPH ESPOSITO
 Applicant's Name (please print)

410-375-9067
 Applicant's Phone #

JEPO47@GMAIL.COM
 Applicant's Email

Applicant's Fax #

[Signature]
 Applicant's Signature

09/20/21
 Date

WATER WELL ABANDONMENT-SEALING REPORT FORM

SUBMIT COPIES OF COMPLETED FORM TO:

- * COUNTY ENVIRONMENTAL AGENCY (contact MDE, WMA if address needed)
- * WELL OWNER
- * MDE, WATER MANAGEMENT ADMINISTRATION, WELL PROGRAM

DATE WELL ABANDONED: 9-10-21 (month/day/year)

* PERMIT NUMBER OF ABANDONED WELL (if any) — No tag —

* PERMIT NUMBER OF REPLACEMENT WELL: — —


* PERSON ABANDONING WELL: Andrew Houseman WELL DRILLER'S LICENSE NUMBER: 224

CIRCLE: MWD / MSD / MGD

* OWNER'S NAME: Ravi Anandakrishnan

SITE LOCATION MAP

* WELL LOCATION:
COUNTY: Howard
NEAREST TOWN: Ellicott City
TAX MAP 0016 BLOCK 0015 PARCEL 0198
SUBDIVISION: _____
SECTION: 88 LOT: _____
STREET ADDRESS: 11483 Frederick Rd

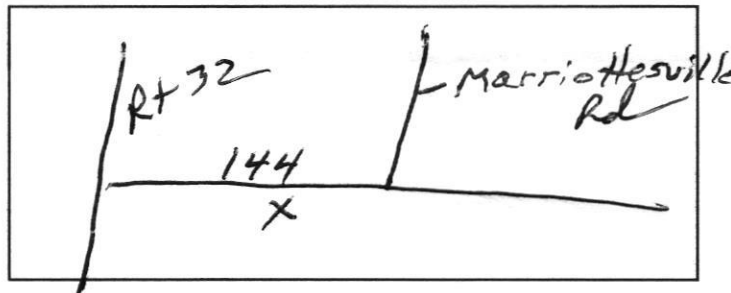

LATITUDE 3 9.291395

LONGITUDE 7 6.910674

LOG OF SEALING MATERIAL

MATERIAL	FEET	
	FROM	TO
<u>Bentonite</u>	<u>50</u>	<u>0</u>
VOLUME OF MATERIAL USED		
<u>Bentonite 750 lbs</u>		

* TYPE OF WELL BEING ABANDONED:

- DRILLED JETTED
 BORED HAND DUG
 OTHER (specify) _____

* USE CODE:

- DOMESTIC MUNICIPAL/PUBLIC
 IRRIGATION INDUSTRIAL
 TEST/OBSERVATION GEOTHERMAL

* TYPE OF CASING:

- STEEL PLASTIC
 CONCRETE OTHER (specify) _____

SIZE OF CASING: 6 INCHES IN DIAMETER

DEPTH OF WELL: 50 FEET DEEP

WAS ANY CASING REMOVED? YES NO

If yes, length removed, in feet: _____

WAS CASING RIPPED OR PERFORATED? YES NO

SIGNATURE-MASTER WELL DRILLER OR SUPERVISING SANITARIAN LICENSE#

Andrew R. Houseman

224

MWD / MSD / MGS
CIRCLE ONE

9-10-21

DATE

Pursuant to § 10-624 of the State Govt. Article of the Maryland Code, personal info requested on this form is used in processing this form pursuant to COMAR 26.04.04. Failure to provide the info may result in this form not being processed. You have the right to inspect, amend, or correct this form. The Maryland Department of the Environment is subject to the Maryland Public Information Act. This form may be made available on the Internet via MDE's website and is subject to inspection or copying, in whole or in part, by the public and other governmental agencies, if not protected by federal or State Law.

 WATER WELL ABANDONMENT-SEALING REPORT FORM

SUBMIT COPIES OF COMPLETED FORM TO:

- * COUNTY ENVIRONMENTAL AGENCY (contact MDE, WMA if address needed)
- * WELL OWNER
- * MDE, WATER MANAGEMENT ADMINISTRATION, WELL PROGRAM

DATE WELL ABANDONED: 9-10-21 (month/day/year)

* PERMIT NUMBER OF ABANDONED WELL (if any) no fees

* PERMIT NUMBER OF REPLACEMENT WELL: _____


* PERSON ABANDONING WELL: Andrew Houseman WELL DRILLER'S LICENSE NUMBER: 224

CIRCLE: MWD/MSD/MGD

* OWNER'S NAME: Ravi Anandakrishnan

SITE LOCATION MAP

* WELL LOCATION:
 COUNTY: Howard
 NEAREST TOWN: Ellicott City
 TAX MAP 0016 BLOCK 0021 PARCEL 6144
 SUBDIVISION: _____
 SECTION: 93 LOT: _____
 STREET ADDRESS: 114 Frederick Rd

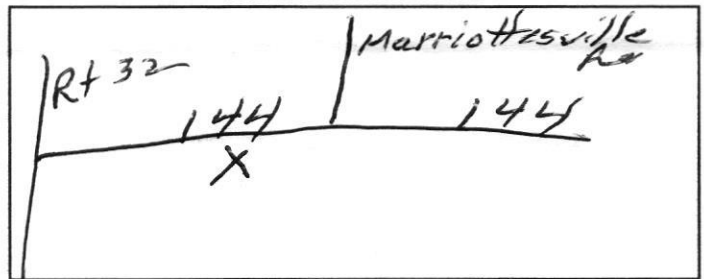

LATITUDE 3 9.291475

LONGITUDE 7 6.910809

LOG OF SEALING MATERIAL

MATERIAL	FEET	
	FROM	TO
<u>Bentonite</u>	<u>35</u>	<u>0</u>
VOLUME OF MATERIAL USED		
<u>Bentonite 600 lbs</u>		

* TYPE OF WELL BEING ABANDONED:

- DRILLED JETTED
- BORED HAND DUG
- OTHER (specify) _____

* USE CODE:

- DOMESTIC MUNICIPAL/PUBLIC
- IRRIGATION INDUSTRIAL
- TEST/OBSERVATION GEOTHERMAL

* TYPE OF CASING:

- STEEL PLASTIC
- CONCRETE OTHER (specify) _____

SIZE OF CASING: 6 INCHES IN DIAMETER

DEPTH OF WELL: 35 FEET DEEP

WAS ANY CASING REMOVED? YES NO

If yes, length removed, in feet: _____

WAS CASING RIPPED OR PERFORATED? YES NO

SIGNATURE-MASTER WELL DRILLER OR SUPERVISING SANITARIAN LICENSE#

[Handwritten Signature]

224 MWD MSD MGS
 CIRCLE ONE

9-10-21 DATE

Pursuant to § 10-624 of the State Govt. Article of the Maryland Code, personal info requested on this form is used in processing this form pursuant to COMAR 26.04.04. Failure to provide the info may result in this form not being processed. You have the right to inspect, amend, or correct this form. The Maryland Department of the Environment is subject to the Maryland Public Information Act. This form may be made available on the Internet via MDE's website and is subject to inspection or copying, in whole or in part, by the public and other governmental agencies, if not protected by federal or State Law.

Fogle's Septic Clean Inc.

Fogle's Portable Toilets • Fogle's Well Drilling LLC • Fogle's Excavating, LLC



September 13, 2021

Howard Co Dept of Environmental Health
8930 Stanford Blvd
Columbia, Md 21045

To Whom it may concern,


On September 9, 2021 Fogle's Septic Clean Inc, has pumped, crushed and filled in 2 old septic tanks located at 11489 & 11493 Frederick Rd for Eesposito Company Inc. See attached drawings.

If you have any questions please call me at the office 410-795-5670.

Sincerely,

A handwritten signature in cursive script that reads "Kurt Cassell".


Kurt Cassell
Fogle's Septic Clean, Inc.

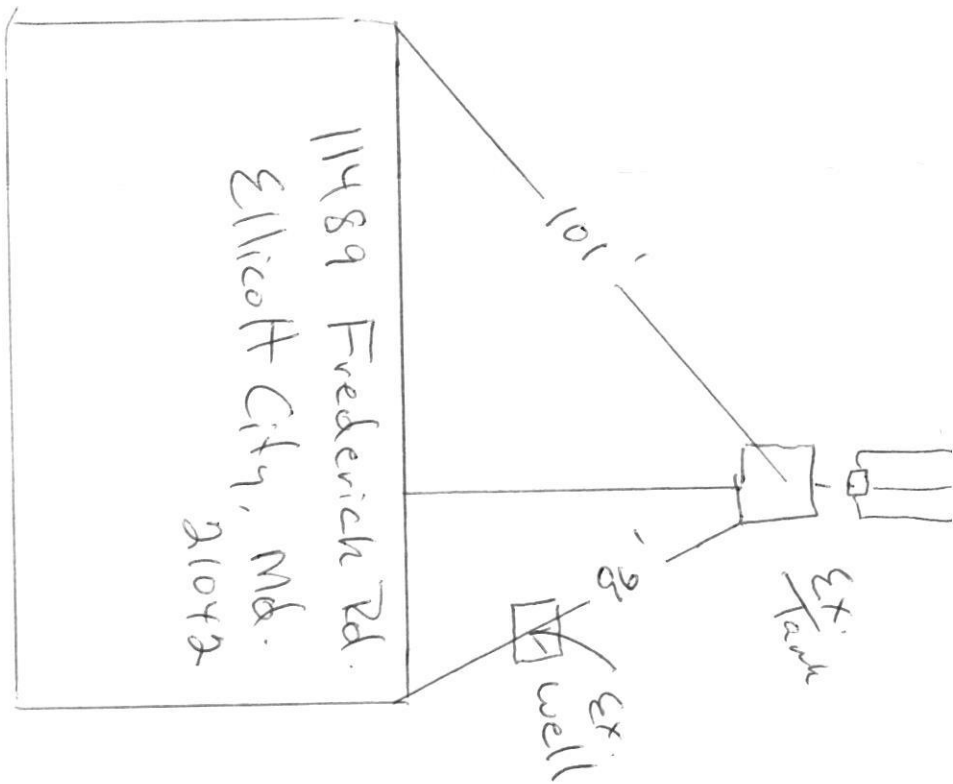

Frederick Rd

Well

11493 Frederick Rd.
Ellicott City, Md.
21042

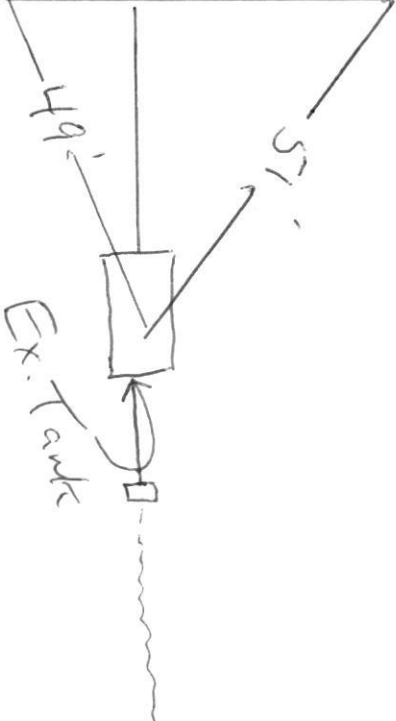

Frederick Rd