

2/18/64  
H.G. 1/6/64

8/11/64

07912  
06397

# PERMIT

SEWAGE DISPOSAL SYSTEM

MARYLAND STATE DEPARTMENT OF HEALTH

HOWARD COUNTY

ELLICOTT CITY

DISTRICT

DATE

1-9-64

INDEXED

*G. ...*

*Abroad Plumbing & Heating*

IS PERMITTED TO INSTALL  ALTER

ADDRESS

PHONE

A SEWAGE DISPOSAL SYSTEM LOCATED AT

*Trindolph Rd approx 1/2 mile from Greenbridge Rd on right hand side*

SUBDIVISION

ROAD

*1507 Trindolph Rd*

PROPERTY OWNER

*Hickman, E. J.*

ADDRESS

SPECIFICATIONS

*for 3 bedrooms*

DRAIN FIELD  DEPTH *3 1/2* FEET, BOTTOM AREA *300* SQ. FT.

SEEPAGE PITS \_\_\_\_\_ ABSORBENT SIDEWALL AREA \_\_\_\_\_ SQ. FT.

SEPTIC TANK CAPACITY *750* GALLONS

FOR GARBAGE GRINDER, INCREASE DISPOSAL AREA 25% & TANK CAPACITY 50%

OTHER

*Run trenches parallel with Trindolph Rd. Place system 175 to 255 ft. from front lot line and 120 to 200 ft from left lot line as shown on facing lot from Trindolph Rd*

PLANS APPROVED BY

*D. W. Morgan*

DATE

*3-13-63*


FILL SEPTIC TANK AND DISTRIBUTION BOX WITH WATER BEFORE CALLING FOR AN INSPECTION. COVER NO WORK UNTIL INSPECTED AND APPROVED.

NEITHER THE HOWARD COUNTY COMMISSIONERS NOR THE HEALTH DEPARTMENT IS RESPONSIBLE FOR THE SUCCESSFUL OPERATION OF ANY SYSTEM.

BOG. PERMIT SIGNED AND RETURNED *12/10/63*  
*Serial # 91240*  
*Enclosed Paid*

06397

A# 06397

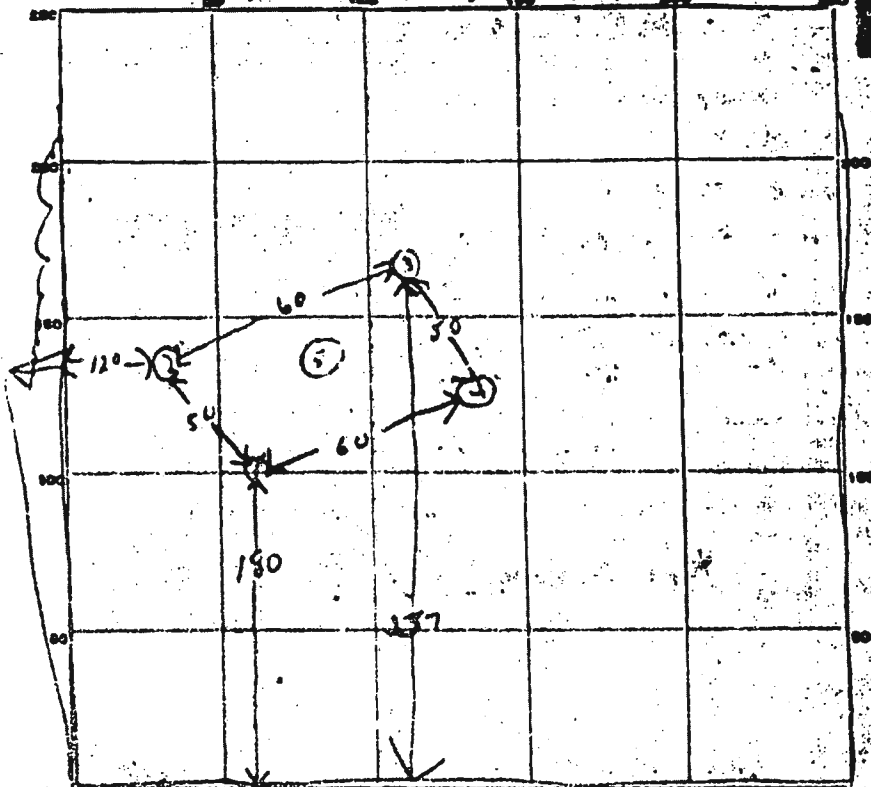

To Highway - Tradeoff mark

DATE	TEST NO.	DEPTH	PRE-WET		TEST - 1" DROP		TIME	
			START	STOP	START	STOP		
3/13/63	1	3	1228	1235	1235	1252	17 min	
	2	3	1233	1238	1238	1247	9 min	
	3	3	1240	1244	1244	1255	11 min	
	4	3	1244	1247	1247	1251	4 min	
	5	8 9	did not test - 9 min in ground no ground water					


10 1/4  
min  
drop

SOIL AUGER FINDING

TESTED BY: W. J. 3/13/63

REMARKS: trunks to be parallel to Tradeoff Ad.

ALSO PRESENT: J. L. ... LOT NO. \_\_\_\_\_

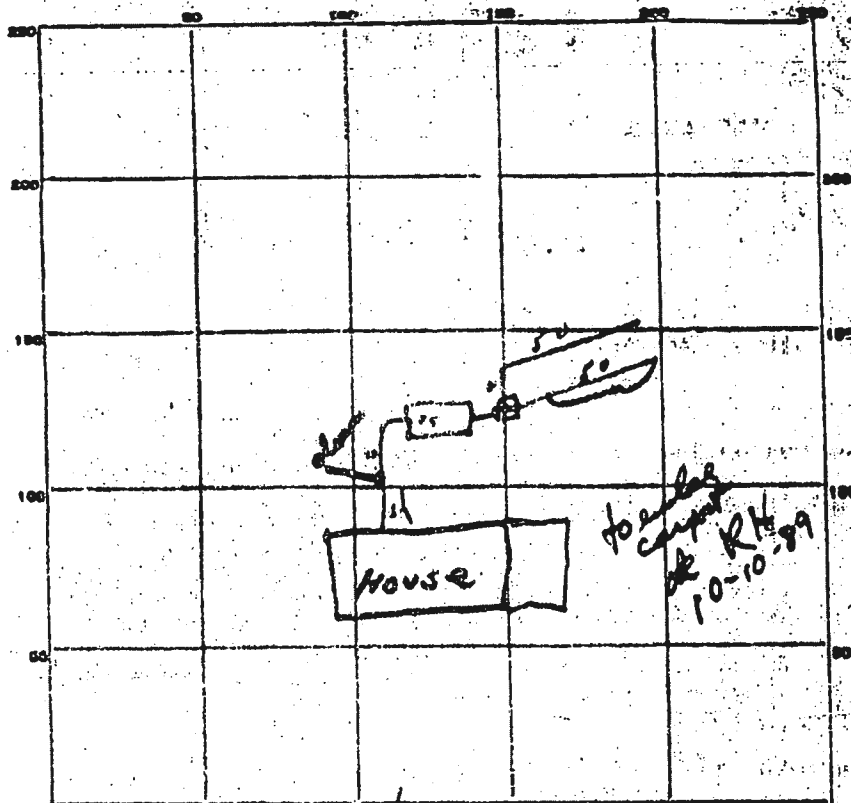

INDICATE NORTH - NAME ADJOINING ROADWAY AS BASE LINE.

*Hershey Rd*

PERMIT CARD \_\_\_\_\_

SEPTIC TANK, LEVEL 511

CLEANOUTS OK

DISTRIBUTION BOX, LEVEL 015

TILE FIELD, DEPTH 3 1/2 FT. TRENCH WIDTH 2 FT.

GRAVEL DEPTH 11 IN. TOTAL LENGTH 100 FT.

NUMBER OF TRENCHES 1 TOTAL BOTTOM AREA 300 sq ft

SEEPAGE PITS, INSIDE DIAMETER \_\_\_\_\_ FT. DEPTH BELOW INLET \_\_\_\_\_ FT.

ABSORBENT AREA \_\_\_\_\_ SQ. FT.

REMARKS \_\_\_\_\_

\_\_\_\_\_  
 \_\_\_\_\_  
 \_\_\_\_\_  
 \_\_\_\_\_

DATE SYSTEM APPROVED 2/18/64

INSPECTOR *W. Henry*