

A/P

#19

Red Brown
Black
Magnes
Deposits
Heavy
Sch
5.0

Red Brown
Yellow
Medium
Sh
Much
mica
↓
13.5

#20

Red Brown
Sch
3


Red Brown
FSL
Much
mica
Silty
10

Red Brown
Much
mica
FSL
14

#18

Red Brown
& Sch
Much mica
Medium
3

Red Brown
Yellow
FSL
White
Schist @
7

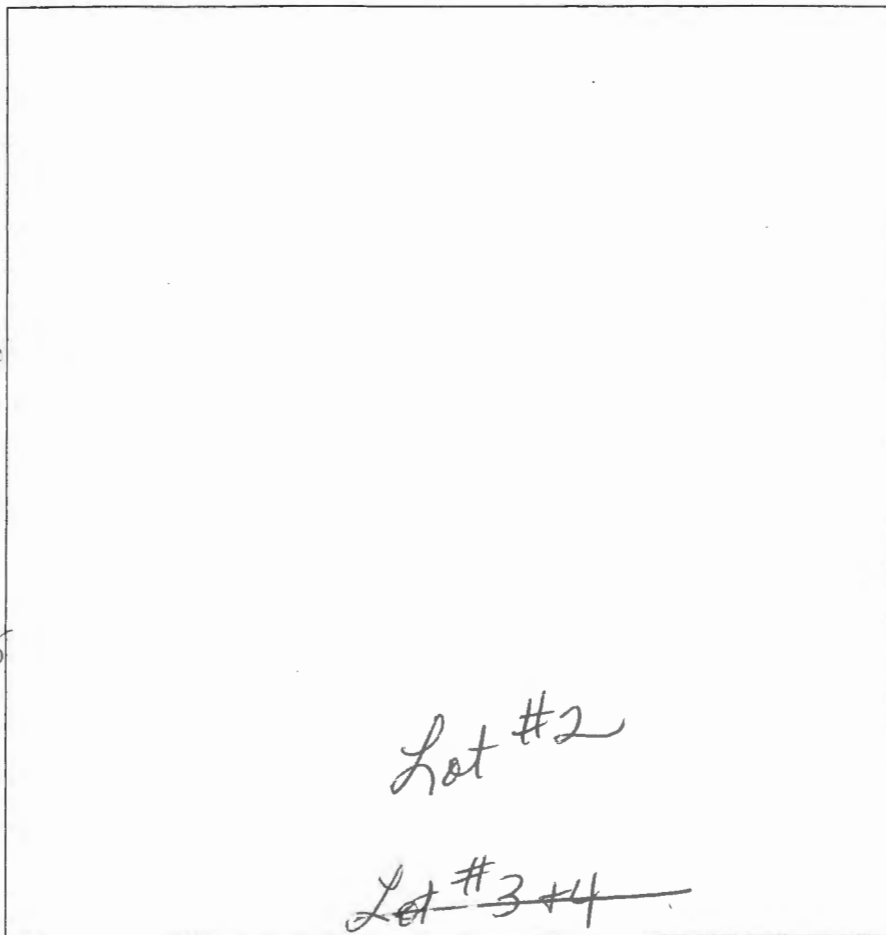

#17

Red Brown
Sch
3

Schist @
6-10-20%
5-10% P4

Red Brown
Yellow
FSL
↓
14

#16

Red Brown
Micaeous
Sch
Heavy 3'

Red Brown
Yellow
FSL
H2O
11'

12'

DATE	TEST #	DEPTH	START	BREAK 1" DROP	STOP 2" DROP	TIME OF 2ND INCH	P/F/H
3-20-13	19	5.5 / 13.5	11:10	11:15	11:21	6 min	P
3-20-13	20	4 / 14	11:23	11:28	11:36	8 min	P
3-20-13	18	5 / 14	11:27	11:30	11:35	5 min	P
3-20-13	17	4.5 / 14	11:39	11:41	11:48	7 min	P
3-20-13	16	5 / 10	11:48	11:50	11:52	7 min	P (marginal)

REMARKS Lots #4 & 5

SANITARIAN DB + RB BACKHOE Rennie OTHERS _____

TEST HOLES USED IN SDA _____ AVG. PERC TIME _____ SQ. FT/BR _____

TRENCH WIDTH _____ INLET DEPTH _____ MAX. BOT DEPTH _____ EFFECTIVE SW _____

#14